

BIOSCIENCES / BIOTECHNOLOGY BUILDING ARKANSAS STATE UNIVERSITY

Large Scale Culture Facility

INDEX TO DRAWINGS -

SHEET NO. FINISH SCHEDULE, DOOR SCHEDULE, VISUAL DOOR TYPES, HOLLOW METAL FRAME SCHEDULE, DETAILS REFLECTED CEILING PLAN, DETAILS LAB EQUIPMENT PLAN, LAB EQUIPMENT SCHEDULE **FOUNDATION PLAN** FIRST FLOOR PLAN - LIGHTING E2.2A FIRST FLOOR PLAN - POWER E2.3A FIRST FLOOR PLAN - SYSTEMS E2.11A **ROOF PLAN - POWER** FIRST FLOOR MECHANICAL ROOM PLAN - POWER E3.2A E501A PANEL SCHEDULES MECHANICAL M2.1A **FIRST FLOOR PLAN - PLUMBING** M2.2A **SECOND FLOOR PLAN - PLUMBING** M2.3A THIRD FLOOR PLAN - PLUMBING M2.4A FOURTH FLOOR PLAN - PLUMBING M2.5A FIRST FLOOR PLAN - HVAC DUCTWORK **SECOND FLOOR PLAN - HVAC DUCTWORK** M2.6A M2.7A THIRD FLOOR PLAN - HVAC DUCTWORK M2.8A FOURTH FLOOR PLAN - HVAC DUCTWORK M2.9A FIRST FLOOR PLAN - HVAC PIPING **SECOND FLOOR PLAN - HVAC PIPING** THIRD FLOOR PLAN - HVAC PIPING M2.12A FOURTH FLOOR PLAN - HVAC PIPING FIRST FLOOR MECHANICAL ROOM PLAN M3.1A M5.3A **HVAC DETAILS - 3** PLUMBING RISER DIAGRAMS M6.2A M8.2A **MECHANICAL SCHEDULES - 2** PLUMBING FP2.1A **FIRST FLOOR PLAN - FIRE PROTECTION**

THE FOLLOWING DRAWINGS ARE TO BECOME A PART OF THE BIOSCIENCES/BIOTECHNOLOGY BUILDING, ARKANSAS STATE UNIVERSITY CONTRACT. ALL PROVISIONS AND REQUIREMENTS OF THE SPECIFICATIONS AND DRAWINGS ISSUED NOVEMBER 7,2002 WITH ARCHITECTS COMMISSION NO.10301 ARE PART OF THESE DOCUMENTS AND APPLY TO THE LARGE SCALE CULTURE FACILITY.






eľ	0	X	y	/	C	0	V	e	b	a	8	e	
	***************************************												501

EPOXY FLOORING TURN UP WALL CONTINUOUS FOR COVE BASE

		L	ARGE SCALE	CULTURE FACILITY FINISH	SCHE	DULE
ROOM NO.	ROOM NAME	FLOOR	BASE	WALLS	CEILING HEIGHT	CEILING
A100	CORRIDOR	1/4" TROWELED EPOXY	INTERGRAL 4" EPOXY	EPOXY PAINTED CONCRETE BLOCK	10'-0"	EPOXY PANTED GYP. BOARD ON SUSPENSION GRID
A101	GOWNING ROOM	1/4" TROWELED EPOXY	INTERGRAL 4" EPOXY	EPOXY PAINTED CONCRETE BLOCK	10'-0"	EPOXY PANTED GYP. BOARD ON SUSPENSION GRID
A102	OFFICE	1/4" TROWELED EPOXY	INTERGRAL 4" EPOXY	EPOXY PAINTED CONCRETE BLOCK	10'-0"	EPOXY PANTED GYP. BOARD ON SUSPENSION GRID
A103	CLEAN CAGE WASH	1/4" TROWELED EPOXY	INTERGRAL 4" EPOXY	EPOXY PAINTED CONCRETE BLOCK	10'-0"	EPOXY PANTED GYP. BOARD ON SUSPENSION GRID
A104	FEED/BEDDING STORAGE	1/4" TROWELED EPOXY	INTERGRAL 4" EPOXY	EPOXY PAINTED CONCRETE BLOCK	10'0"	EPOXY PANTED GYP. BOARD ON SUSPENSION GRID
A105	JANITOR	1/4" TROWELED EPOXY	INTERGRAL 4" EPOXY	EPOXY PAINTED CONCRETE BLOCK	10'-0"	EPOXY PANTED GYP. BOARD ON SUSPENSION GRID
A106	EQUIPMENT ROOM	1/4" TROWELED EPOXY	INTERGRAL 4" EPOXY	EPOXY PAINTED CONCRETE BLOCK	11'-0"	EPOXY PANTED GYP. BOARD ON SUSPENSION GRID
A107	SURGERY PREP	1/4" TROWELED EPOXY	INTERGRAL 4" EPOXY	EPOXY PAINTED CONCRETE BLOCK	10'0"	EPOXY PANTED GYP. BOARD ON SUSPENSION GRID
A108	CORRIDOR	1/4" TROWELED EPOXY	INTERGRAL 4" EPOXY	EPOXY PAINTED CONCRETE BLOCK	10'-0"	EPOXY PANTED GYP. BOARD ON SUSPENSION GRID
A109	DIRTY CAGE WASH	1/4" TROWELED EPOXY	INTERGRAL 4" EPOXY	EPOXY PAINTED CONCRETE BLOCK	10'-0"	EPOXY PANTED GYP. BOARD ON SUSPENSION GRID
A110	SURGERY ROOM	1/4" TROWELED EPOXY	INTERGRAL 4" EPOXY	EPOXY PAINTED CONCRETE BLOCK	10'-0"	EPOXY PANTED GYP. BOARD ON SUSPENSION GRID
A117	HOLDING ROOM	1/4" TROWELED EPOXY	INTERGRAL 4" EPOXY	EPOXY PAINTED CONCRETE BLOCK	10'-0"	EPOXY PANTED GYP. BOARD ON SUSPENSION GRID
A118	HOLDING ROOM	1/4" TROWELED EPOXY	INTERGRAL 4" EPOXY	EPOXY PAINTED CONCRETE BLOCK	10'-0"	EPOXY PANTED GYP. BOARD ON SUSPENSION GRID

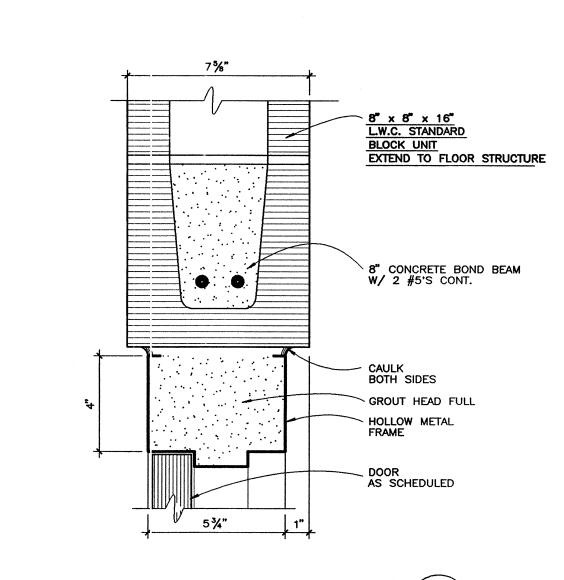

FILL CELLS WITH CONC. AND REINF. — SEE STRUCT.

8" x 8" x 16"

LW.C. STANDARD

BLOCK UNIT

EXTEND TO ROOF OR FLOOR

STRUCTURE AT RATED WALLS

JAMB ANCHORS-3 MIN. PER SIDE

SCALE: 3" = 1'-0"

5¾"

head


CAULK BOTH SIDES -

HOLLOW METAL FRAME

DOOR AS SCHEDULED

<u>jamb</u>

		D	OOR				DETAILS				
OPNG NMBR.	TYPE	NUMBER	THRESH	FRAME	FRAME DEPTH	HEAD	JAMB	SILL	LBL	HDWE	DOOR LOCATION ROOM NAMES
273	D	PAIR		HM-7	5 3/4"	1/A003.1	2/A003.1	_	20 MIN.	A1	CORRIDOR A100
274	D	SINGLE		HM-4	5 3/4"	1/A003.1	2/A003.1			A2	GOWNING ROOM A101
275	D	SINGLE	_	HM-14	5 3/4"	1/A003.1	2/A003.1	_		A4	OFFICE A102
276	N	SINGLE	_	HM-13	5 3/4"	1/A003.1	2/A003.1	-		A3	CLEAN CAGE WASH A103
277	D	SINGLE	_	HM-4	5 3/4"	1/A003.1	2/A003.1	_		A2	GOWNING ROOM A101
278	N	SINGLE	_	HM-13	5 3/4"	1/A003.1	2/A003.1			A3	FEED/BEDDING STORAGE A104
279	D	SINGLE	_	HM-4	5 3/4"	1/A003.1	2/A003.1	-		A2	JANITOR A105
280	D	SINGLE		HM-4	5 3/4"	1/A003.1	2/A003.1	-		A4	EQUIPMENT ROOM A106
281	D	SINGLE		HM-4	5 3/4"	1/A003.1	2/A003.1	_		A2	SURGERY PREP A107
282	D	SINGLE		HM-4	5 3/4"	1/A003.1	2/A003.1			A2	SURGERY ROOM A110
283	D	SINGLE		HM-4	5 3/4"	1/A003.1	2/A003.1	-		A2	SURGERY ROOM A110
284	D	PAIR		HM-7	5 3/4"	1/A003.1	2/A003.1	-		A5	DIRTY CAGE WASH A109
285	N	SINGLE		HM-13	5 3/4"	1/A003.1	2/A003.1	_		A3	HOLDING ROOM A112
286	N	SINGLE		HM-13	5 3/4"	1/A003.1	2/A003.1			A3	HOLDING ROOM A114
287	N	SINGLE		HM-13	5 3/4"	1/A003.1	2/A003.1	_		A3	PROCEDURE ROOM A113
288	N	SINGLE		HM-13	5 3/4"	1/A003.1	2/A003.1			А3	HOLDING ROOM A115
289	N	SINGLE		HM-13	5 3/4"	1/A003.1	2/A003.1	_		А3	PROCEDURE ROOM A116
290	N	SINGLE		HM-13	5 3/4"	1/A003.1	2/A003.1	-		А3	HOLDING ROOM A117
291	N	SINGLE	****	HM-13	5 3/4"	1/A003.1	2/A003.1	_		A3	HOLDING ROOM A118

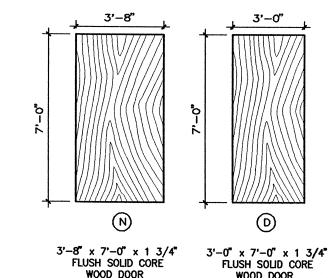


N	(
3'-8" x 7'-0" x 1 3/4" FLUSH SOLID CORE WOOD DOOR	3'-0" x 7'-0" x 1 3/4" FLUSH SOLID CORE WOOD DOOR
	PROVIDE 20 MIN. LABEL WHERE SCHEDULED

visual door types SCALE: 1/4" = 1'-0"

					SCALE: 17	/4 = 1-0
6'-0" 5'-8"	2" +	4'-0" 3'-8" 2" 2"	# *	6'-4" 6'-0" 2"	† 2"	3'-4" 3'-0" 2"
3'-0" 2'-6" 2" 2" 3 A004	2" "4" 10 1 1 1 1 1 1 1 1 1 1 1 1 1 1 1 1 1 1	HM-13	74"		7:-4"	HM-4

hollow metal frame schedule SCALE: 1/4" = 1'-0"

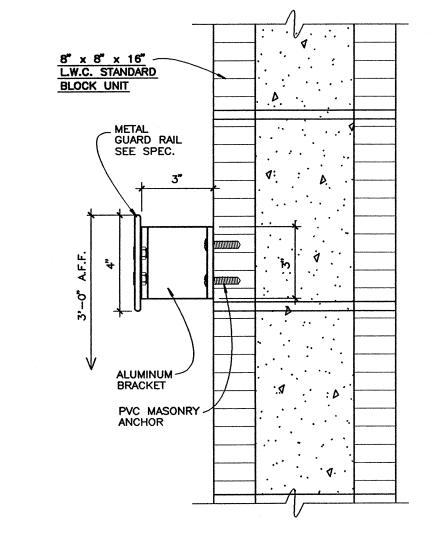

detail at guard rail

Date: October 1, 200

REGISTERED ARCHITECTS C13

FINISH SCHEDULE DOOR SCHEDULE VISUAL DOOR TYPE HOLLOW METAL FRAM

Commission Number 10301

REGISTERED ARCHITECTS C13


LARGE SCALE CULTURE FACILITY FLOOR PLAN


demolition plan


SCALE: 1/4" = 1'-0" Commission Number 00000 A100

Date: March 3, 2005

BLOWN CELLULOSE INSULATION - 2x4 WOOD STUDS AT 1'-4" O.C. 2 2X4'S jamb detail 1x BLOCKING SOUND INSULATING STRIP 2 2X4'S jamb detail head detail

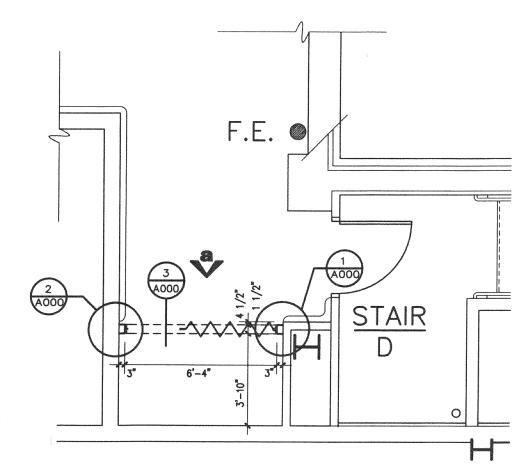


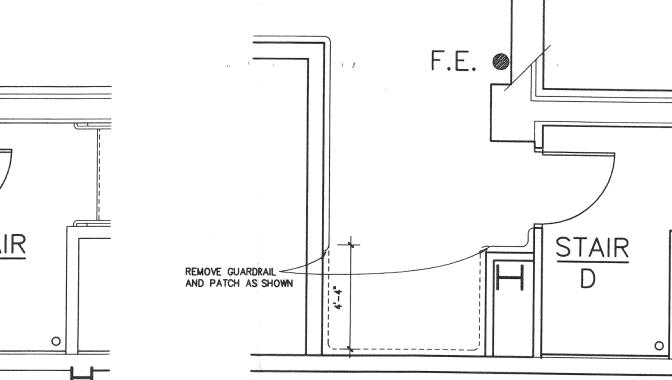

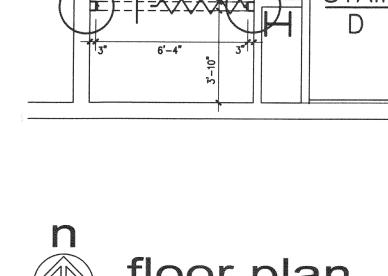





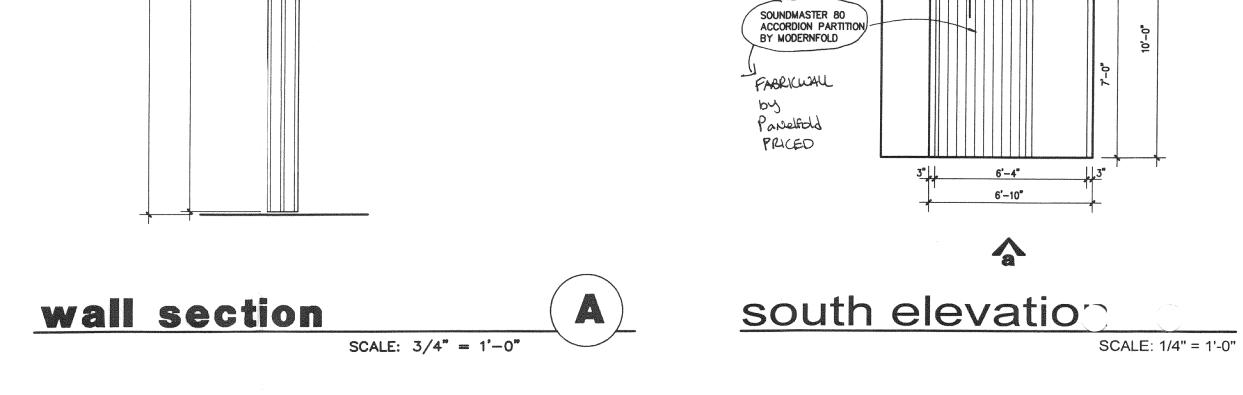

WOOD BLOCK OUT

W/ GRULS ON BOTH SIDES

FIBERGLASS BATT.


1/2" GYP. BOARD EACH SIDE

APPROX. 18"X10"
AIR_TRANSFER

(2) 2x10 HEAD BEAM W/ 1/2" SPACER

-1X WOOD TRIM FOLDING DOOR TRACK



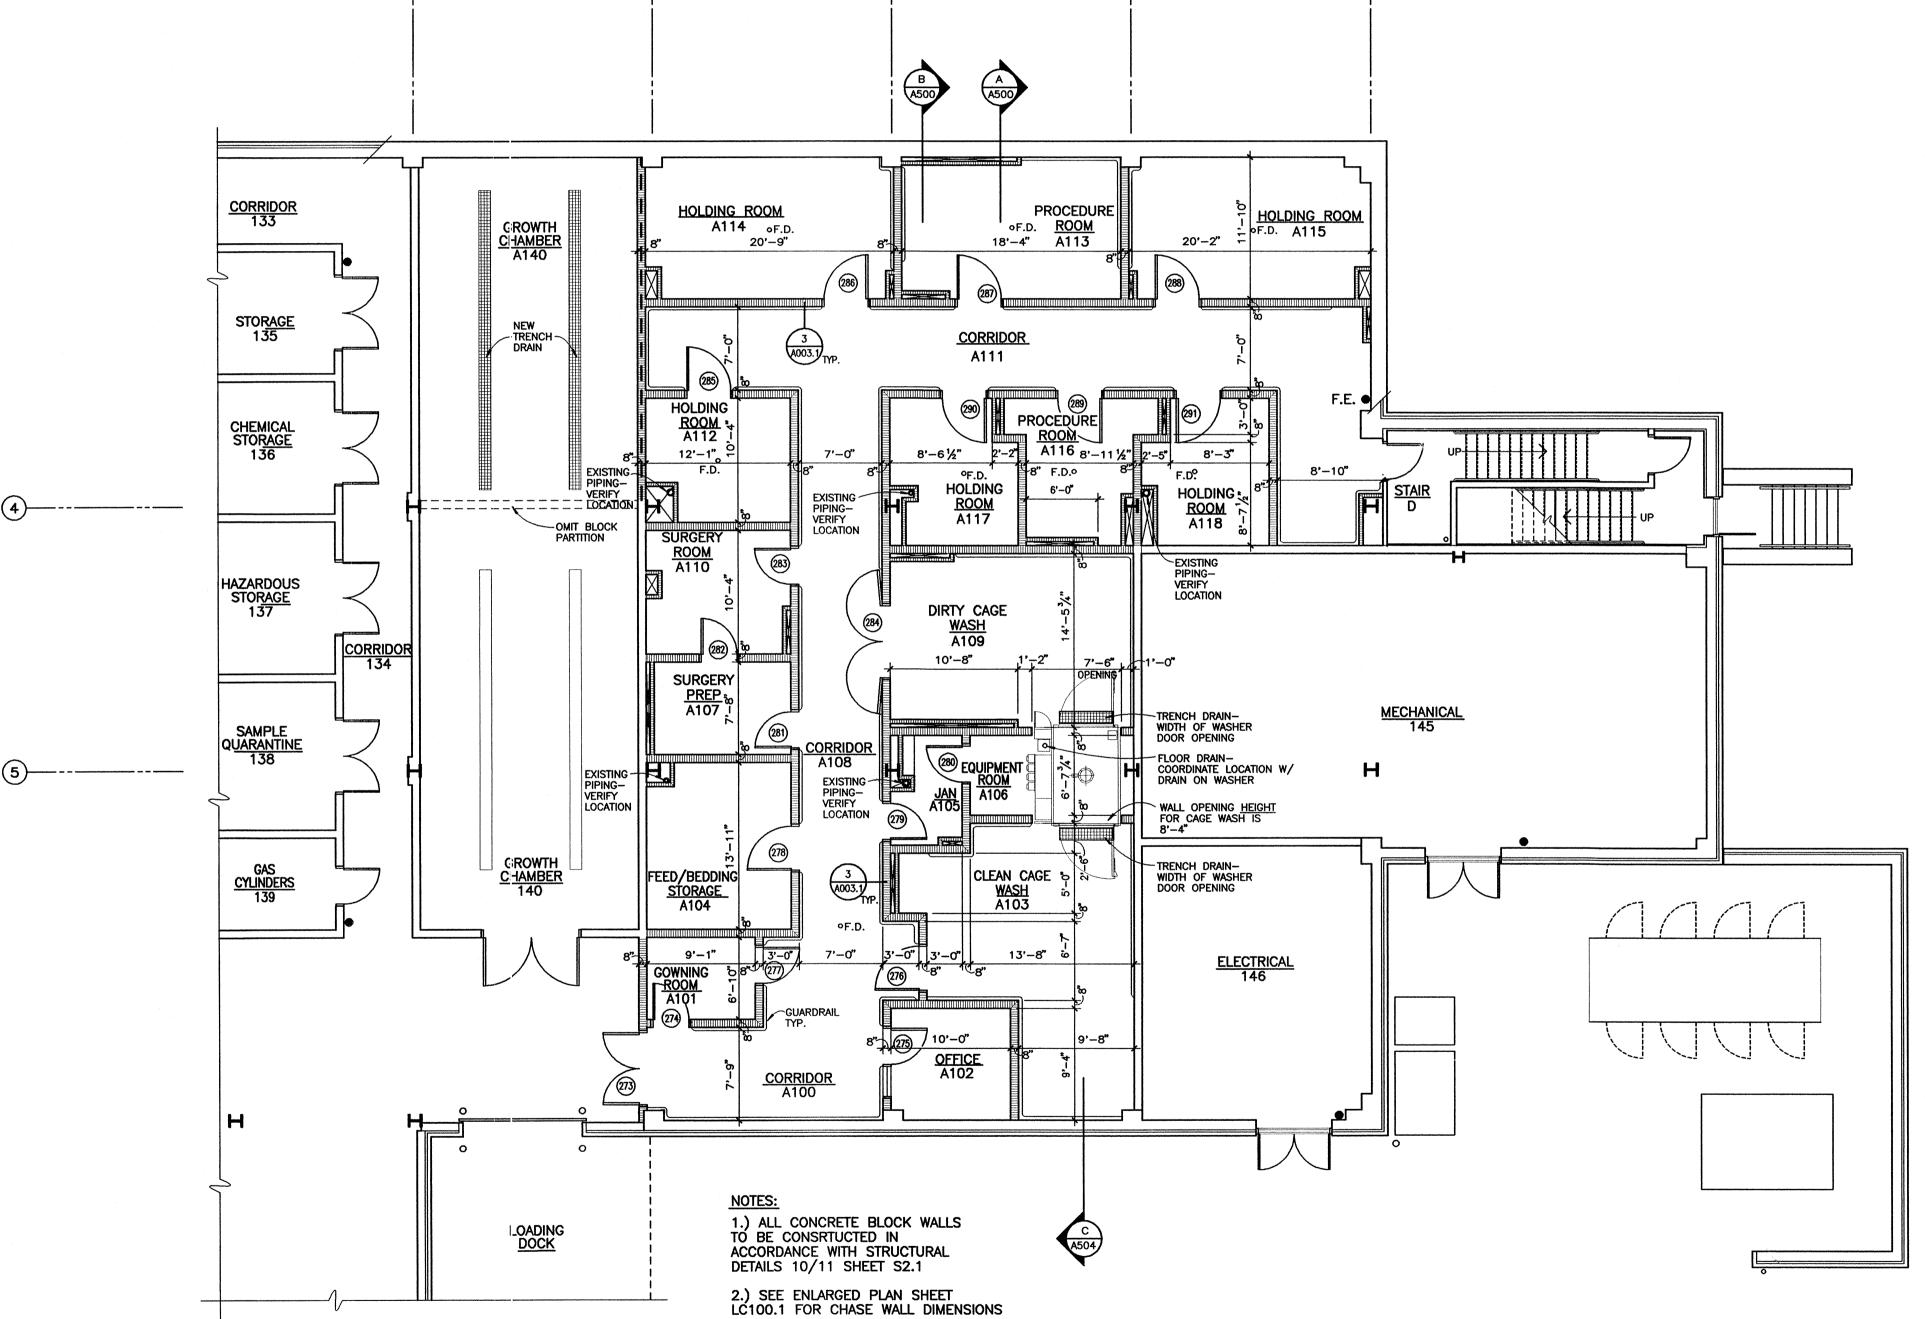

n large scale culture facility floor plan

| SCALE: 1/8" = 1'-0"


LARGE SCALE
CULTURE FACILIT
FLOOR PLAN

Commission Number A100.

Date: October 1, 20

Commission Numb 10301

Date: October 1, 200

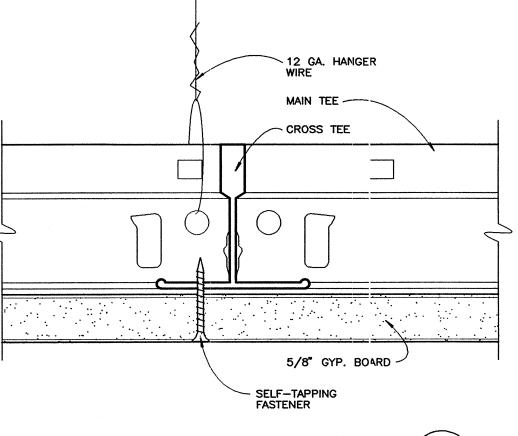


grid detail


SCALE: FULL




12 GA. HANGER WIRE

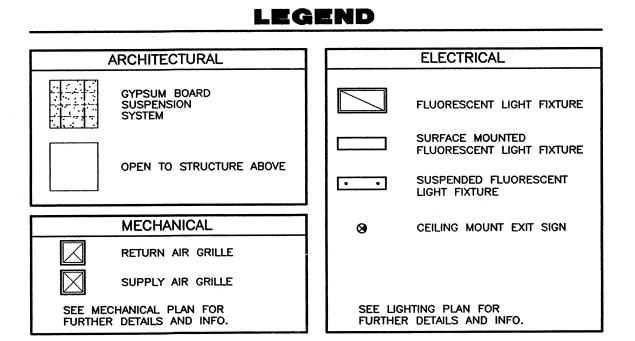

control joint

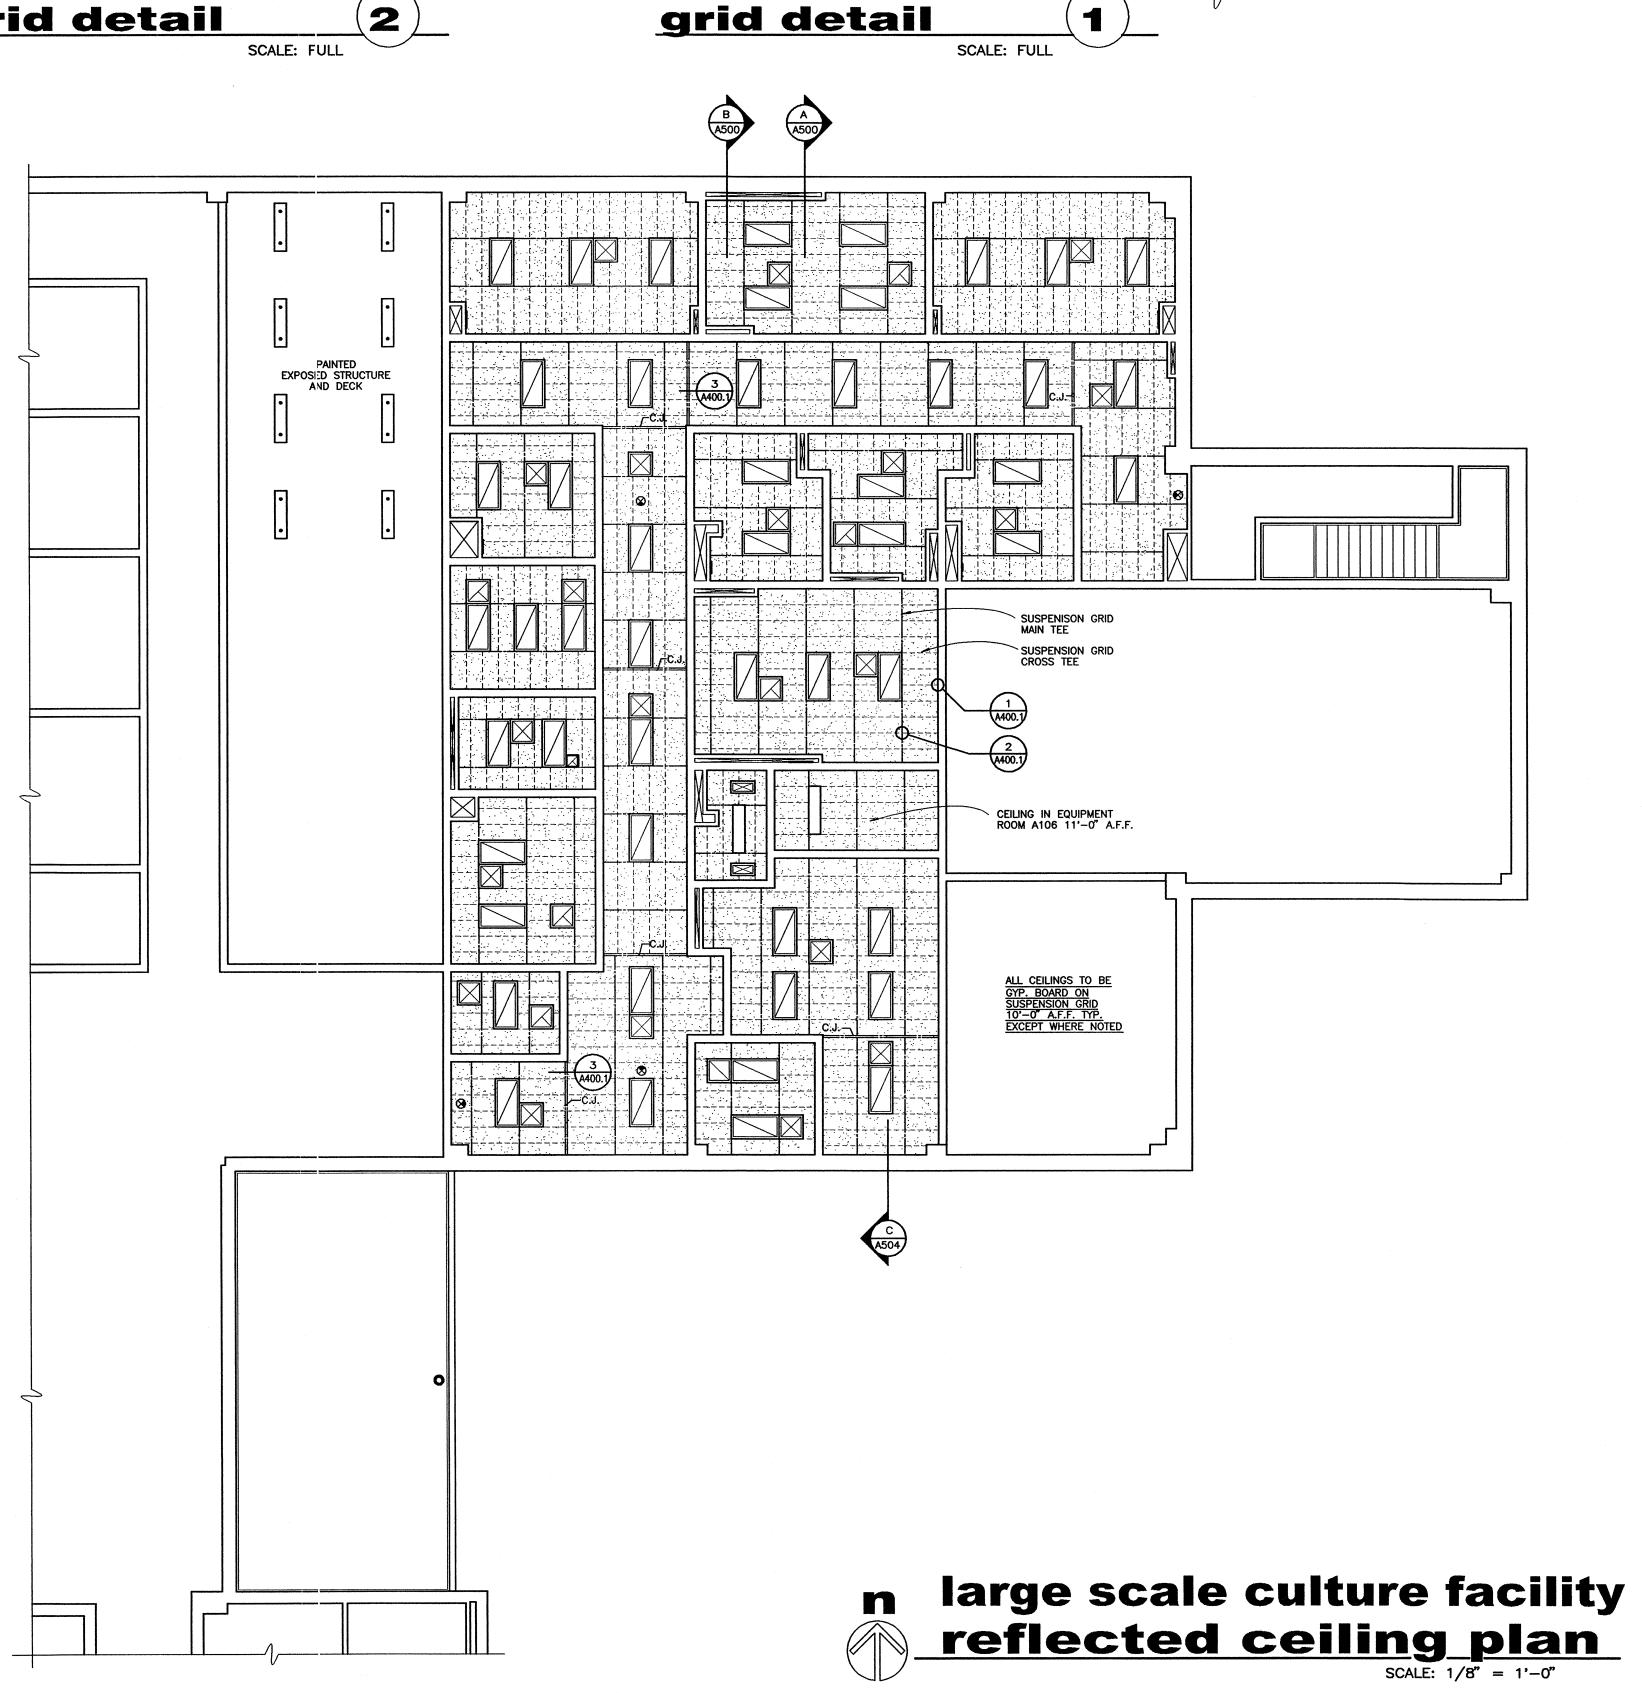

KEY	QUANTITY	LAB EQUIPMENT SCHEDULE DESCRIPTION	* EQUIPMENT ELEVATION #
A	2	BOOT RACKS - MODEL 3BW-51649. RACKS ARE PVC COATED AND EACH RACK HOLDS (4) PAIR OF BOOTS.	4
В	1	STAINLESS STEEL MOBILE BENCH. 48"x18"x18"	5
С	1	STAINLESS STEEL, WALL MOUNTED, ADJUSTABLE SHELF UNITS. THREE TIER 60"WIDE X 12" DEEP X 48" TALL. MANUF. BY ASBEKA.	4
D	1	PLASTIC LAMINATE CABINET WITH METAL NARCOTICS LOCKER 24"x 31 5/8"x 14". MANUF. BY TMI	1
E	2	TWO COMPARTMENT STAINLESS STEEL SCULLERY SINK 60"x30"x36" BY ASBEKA. INCLUDES (1)PR511-110-WSA FIXTURE BY WATERSAVER AND (2)B-3912 TWIST WASTE VALVES BY T&S BRASS.	3/13
F	3	5 TIER STAINLESS STEEL WALL MOUNT ADJUSTABLE SHELVING WITH OPEN MESH SHELVES. 36"x12"x84" BY ASBEKA.	2
G	2	STAINLESS STEEL MOBILE TABLE WITH SHELF 36" x24" x36"	8/20
н	5	5 TIER STAINLESS STEEL WALL MOUNT ADJUSTABLE SHELVING WITH SOLID SHELVES. 36"×18"×84" BY ASBEKA.	6/7
J	1	5 TIER STAINLESS STEEL WALL MOUNT ADJUSTABLE SHELVING WITH SOLID SHELVES. 30"x18"x84" BY ASBEKA.	6
к	1	CUBE TRUCK WITH LID. MODEL 3BW-30929 20 CUBIC FOOT/600 POUND CAPACITY TRUCK AND MODEL 3BW-30935 LID. BY RUBBERMAID.	N/A
L	3	5 TIER STAINLESS STEEL WALL MOUNT ADJUSTABLE SHELVING WITH SOLID SHELVES. 36"x12"x84" BY ASBEKA.	9/11/14
<u></u> М	1	MODEL 4600 CAGE AND RACK WASHER BY STERIS.	N/A
N	1	7'-8" STAINLESS STEEL BASE CABINETS WITH STAINLESS STEEL COUNTERTOPS. INCLUDES A STAINLESS DOUBLE BOWL SINK, FLOOR MOUNTED/FOOT OPERATIONAL FIXTURE, MODEL L182-8VBWSA AND L3050RCP BY WATERSAVER, SINGLE SELF CLOSING VALVE, AND (2)9690 STAINLESS STEEL STRAINERS.	10
0	1	THREE COMPARTMENT SCULLERY SINK 127"x30"x36" BY ASBEKA. WITH (1) PR511-110-WSA FIXTURE BY WATERSAVER AND (3) B-3912 WASTE VALVES BY T&S BRASS	12
P	4	STAINLESS STEEL WALL CABINET WITH GLASS DOORS. 36"x30"x14"	10/18/19/2
Q	1	MODEL 102765 IMPERIAL 58 FLAT TOP OPERATING TABLE ON HYDRAULIC BASE. BY SUBURBAN SURGICAL COMPANY.	N/A
R	2	48" STAINLESS STEEL BASE AND WALL UNIT WITH STAINLESS STEEL BOWL SINK BY ASBEKA. INCLUDES (1) L411VB—BH FIXTURE BY WATERSAVER AND (1) 9690 STAINLESS STEEL STRAINER.	15
s	2	STAINLESS STEEL WALL CABINET WITH GLASS DOORS. 24"x30"x14"	15
Т	1	36" STAINLESS STEEL BASE AND WALL UNIT WITH STAINLESS STEEL BOWL SINK BY ASBEKA. INCLUDES (1) L411VB—BH FIXTURE BY WATERSAVER AND (1) 9690 STAINLESS STEEL STRAINER.	16
U	1	STAINLESS STEEL MOBILE TABLE WITH SHELF 72"x36"x36"	17
V	1	STAINLESS STEEL MOBILE TABLE WITH SHELF 72"x36"x30"	18
W	2	6' BAKER BIOLOGICAL SAFETY CABINET	N/A
Х	1	36" STAINLESS STEEL BASE CABINET BY ASBEKA.	19

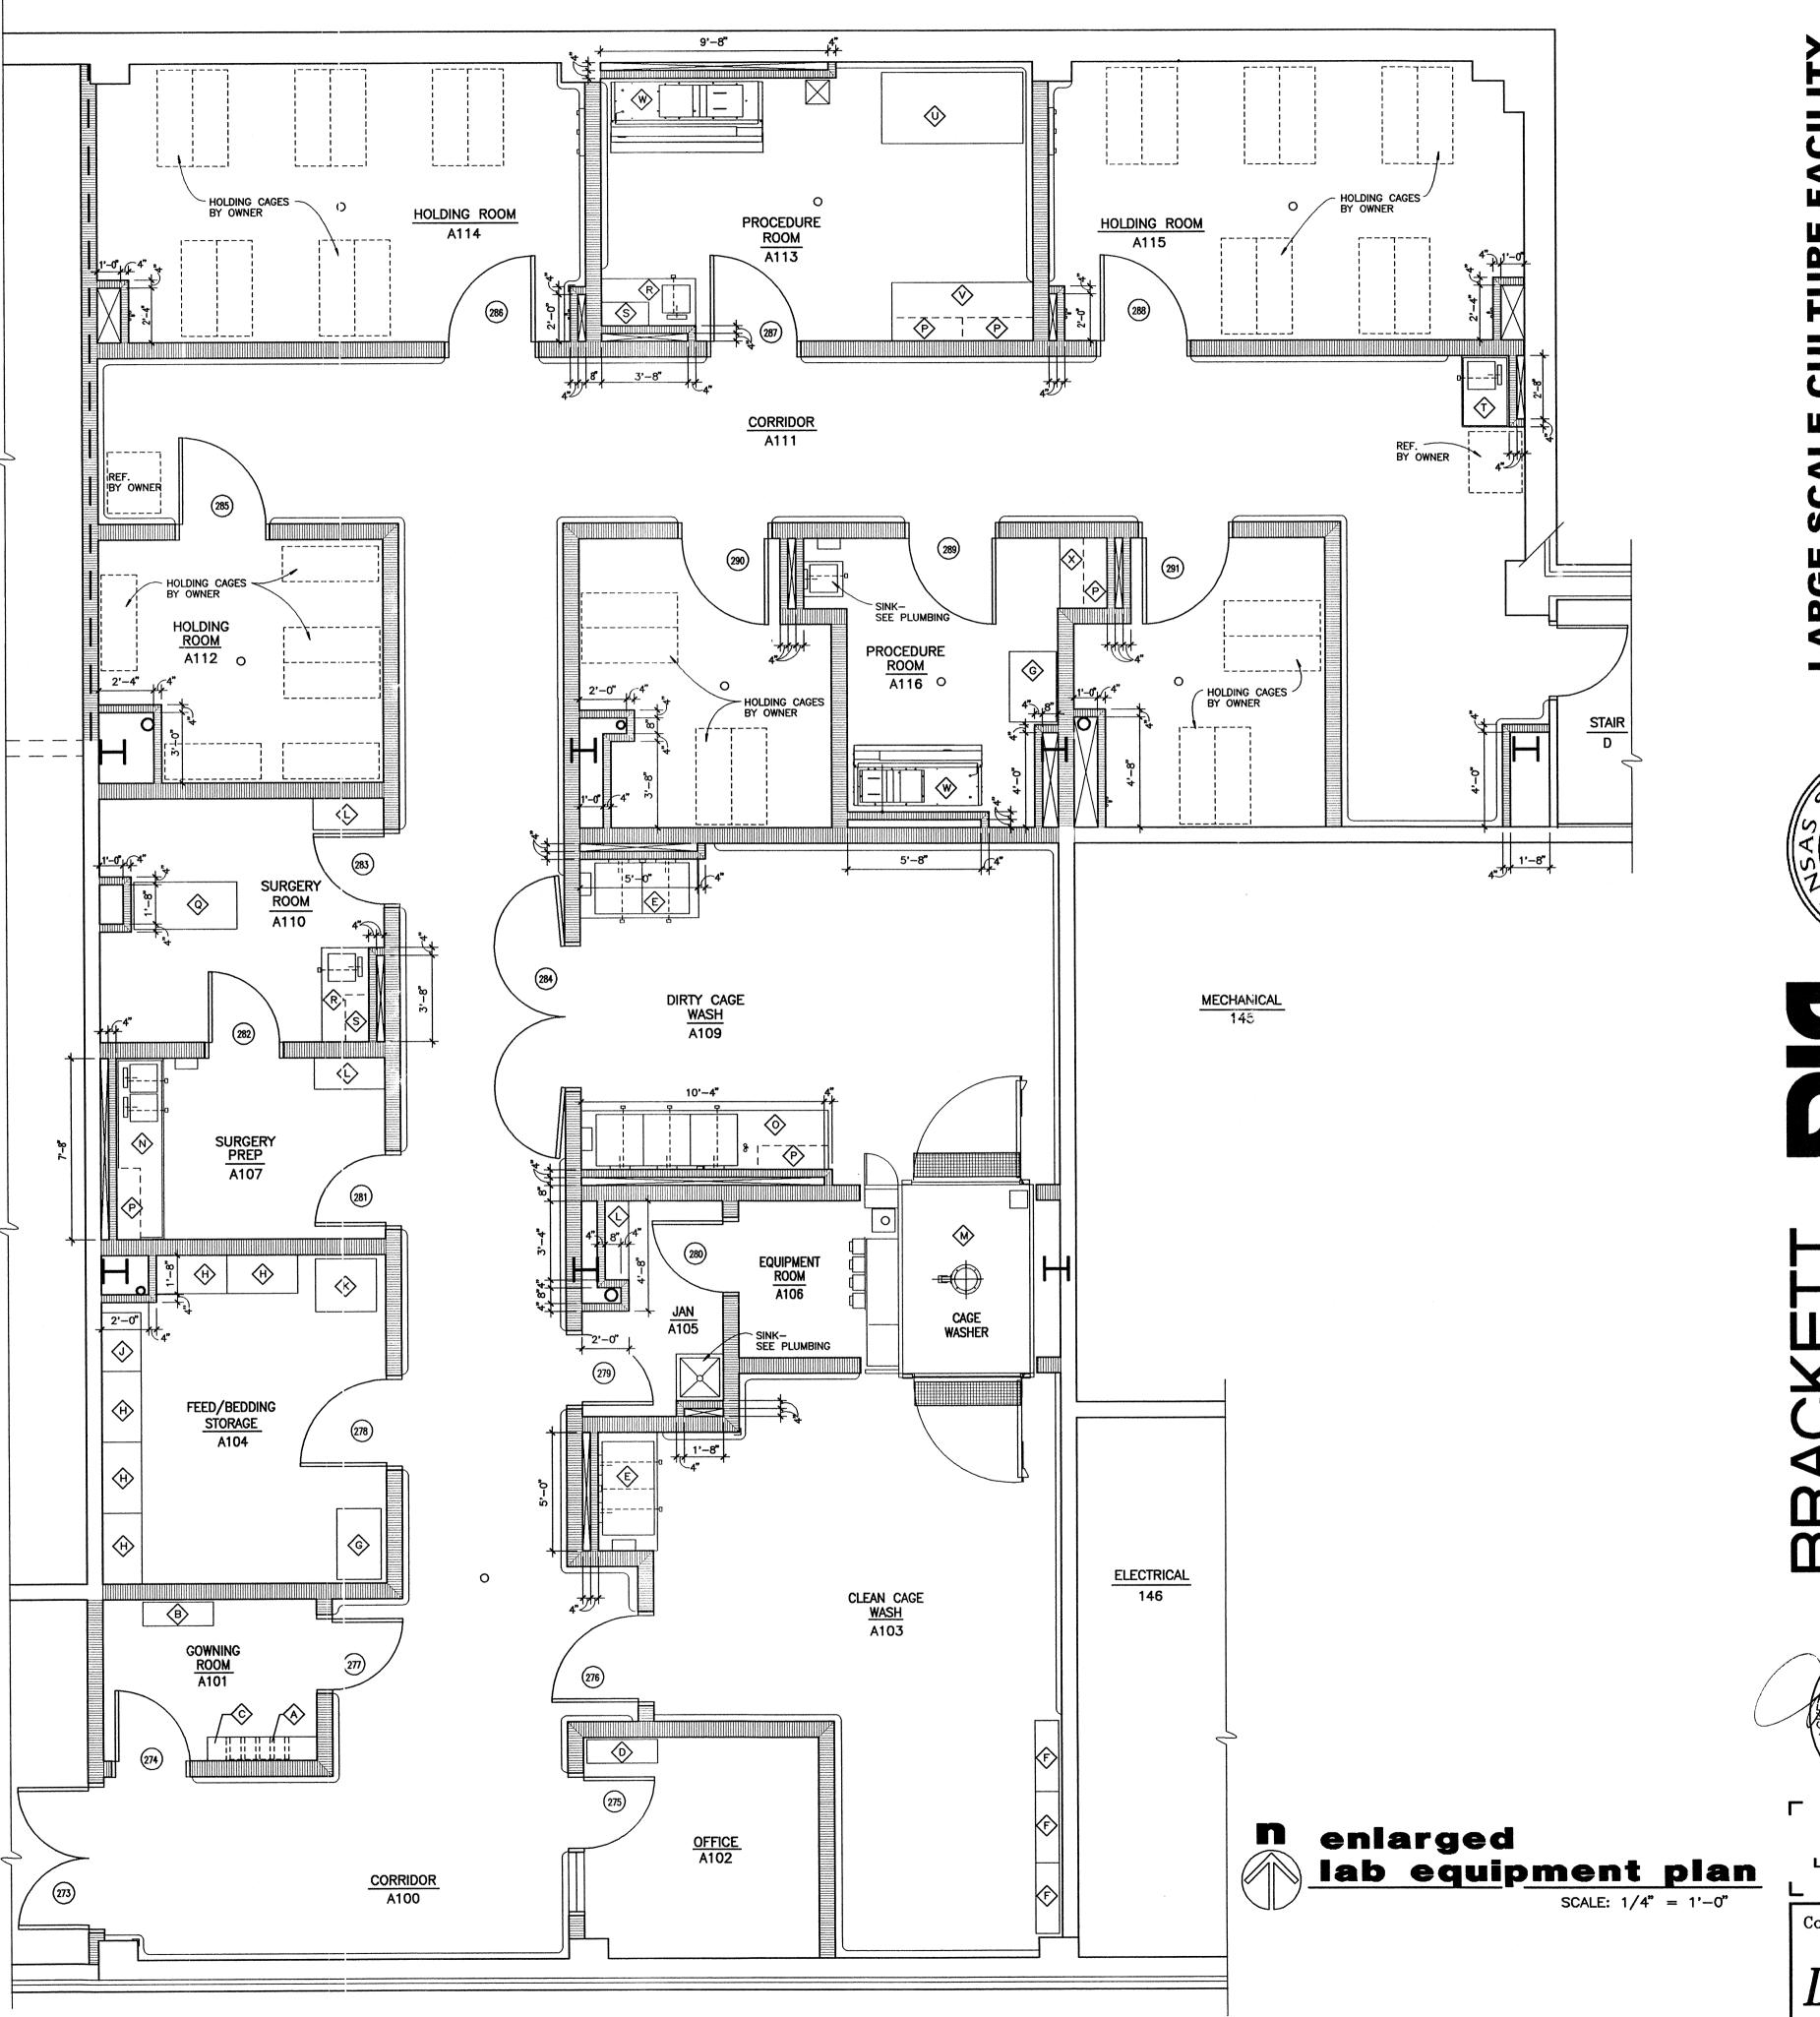

BIOSCIENCES / BIOTECHNOLOGY BUILDING
ARKANSAS STATE UNIVERSITY

RACKELL ENNERICH


REGISTERED ARCHITECTS
C13
ARKANSAS

LARGE SCALE CULTURE FACILITY LAB EQUIPMEMT PLAN

Commission Numb

Date: October 1, 200

Date: October 1, 2

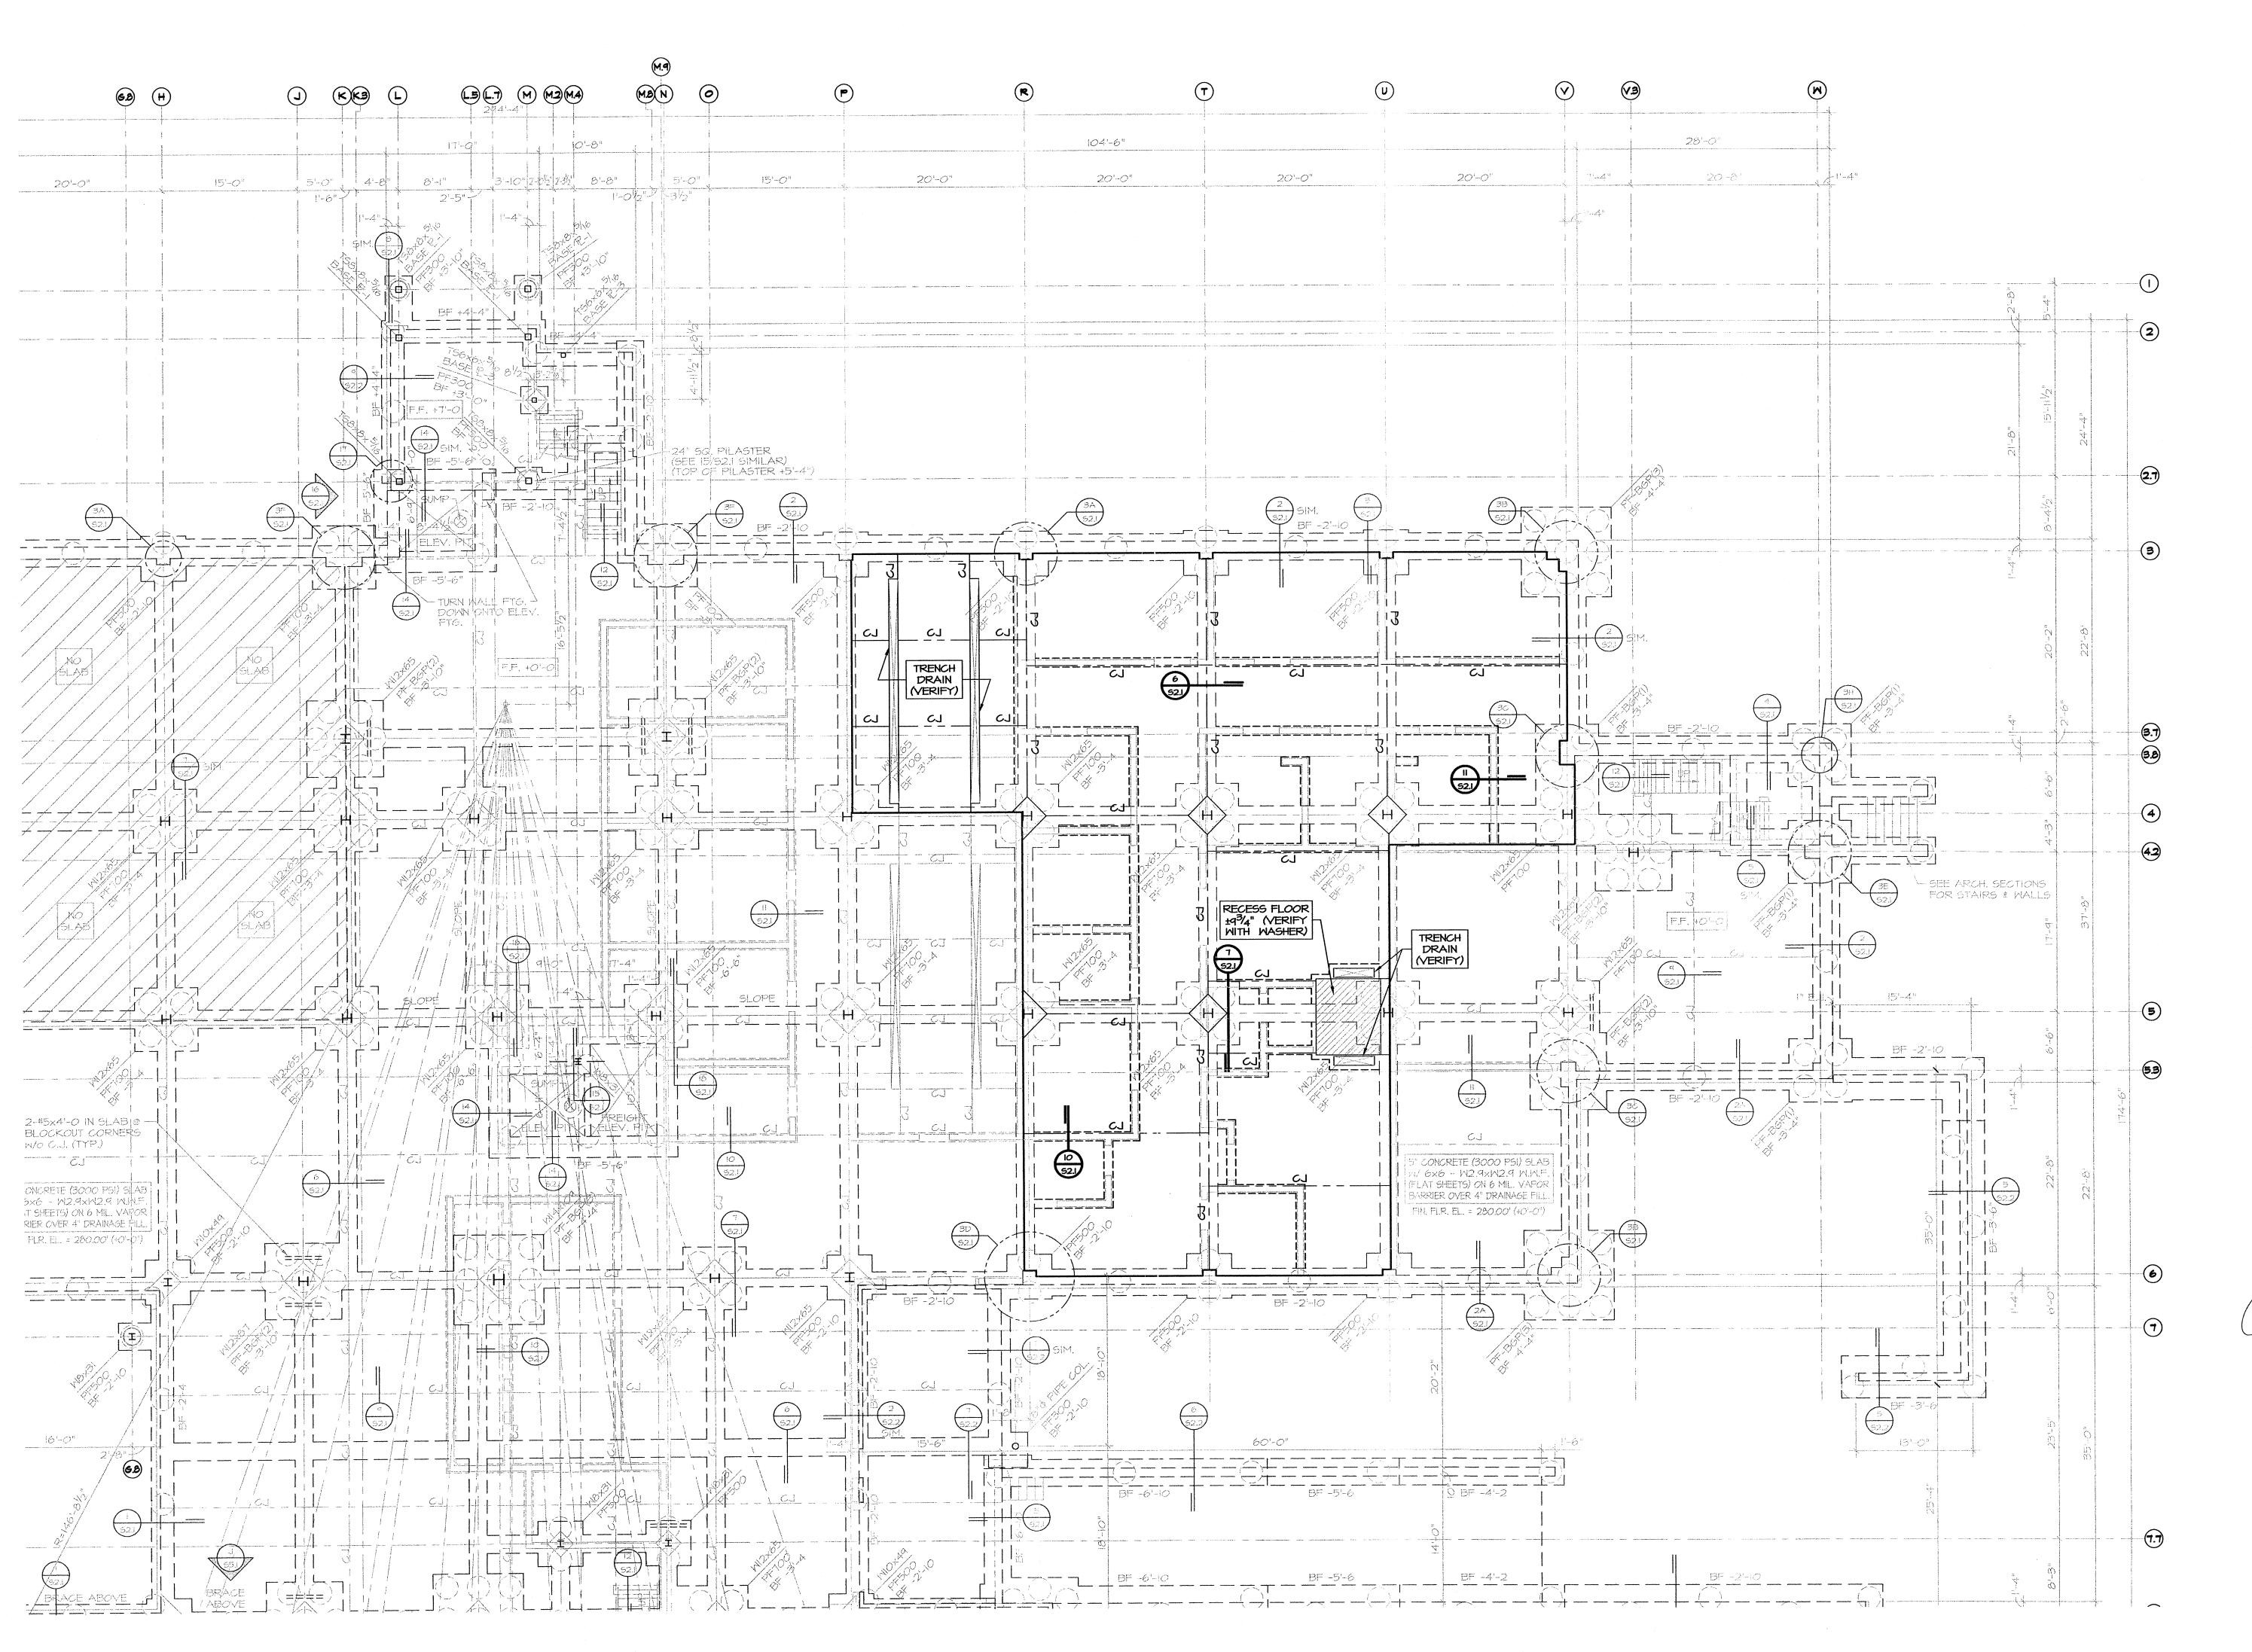


LARGE SCALE **CULTURE FACILI FLOOR PLAN**

Commission Num

Date: October 1, 20

2 OCTOBER 1, 2003

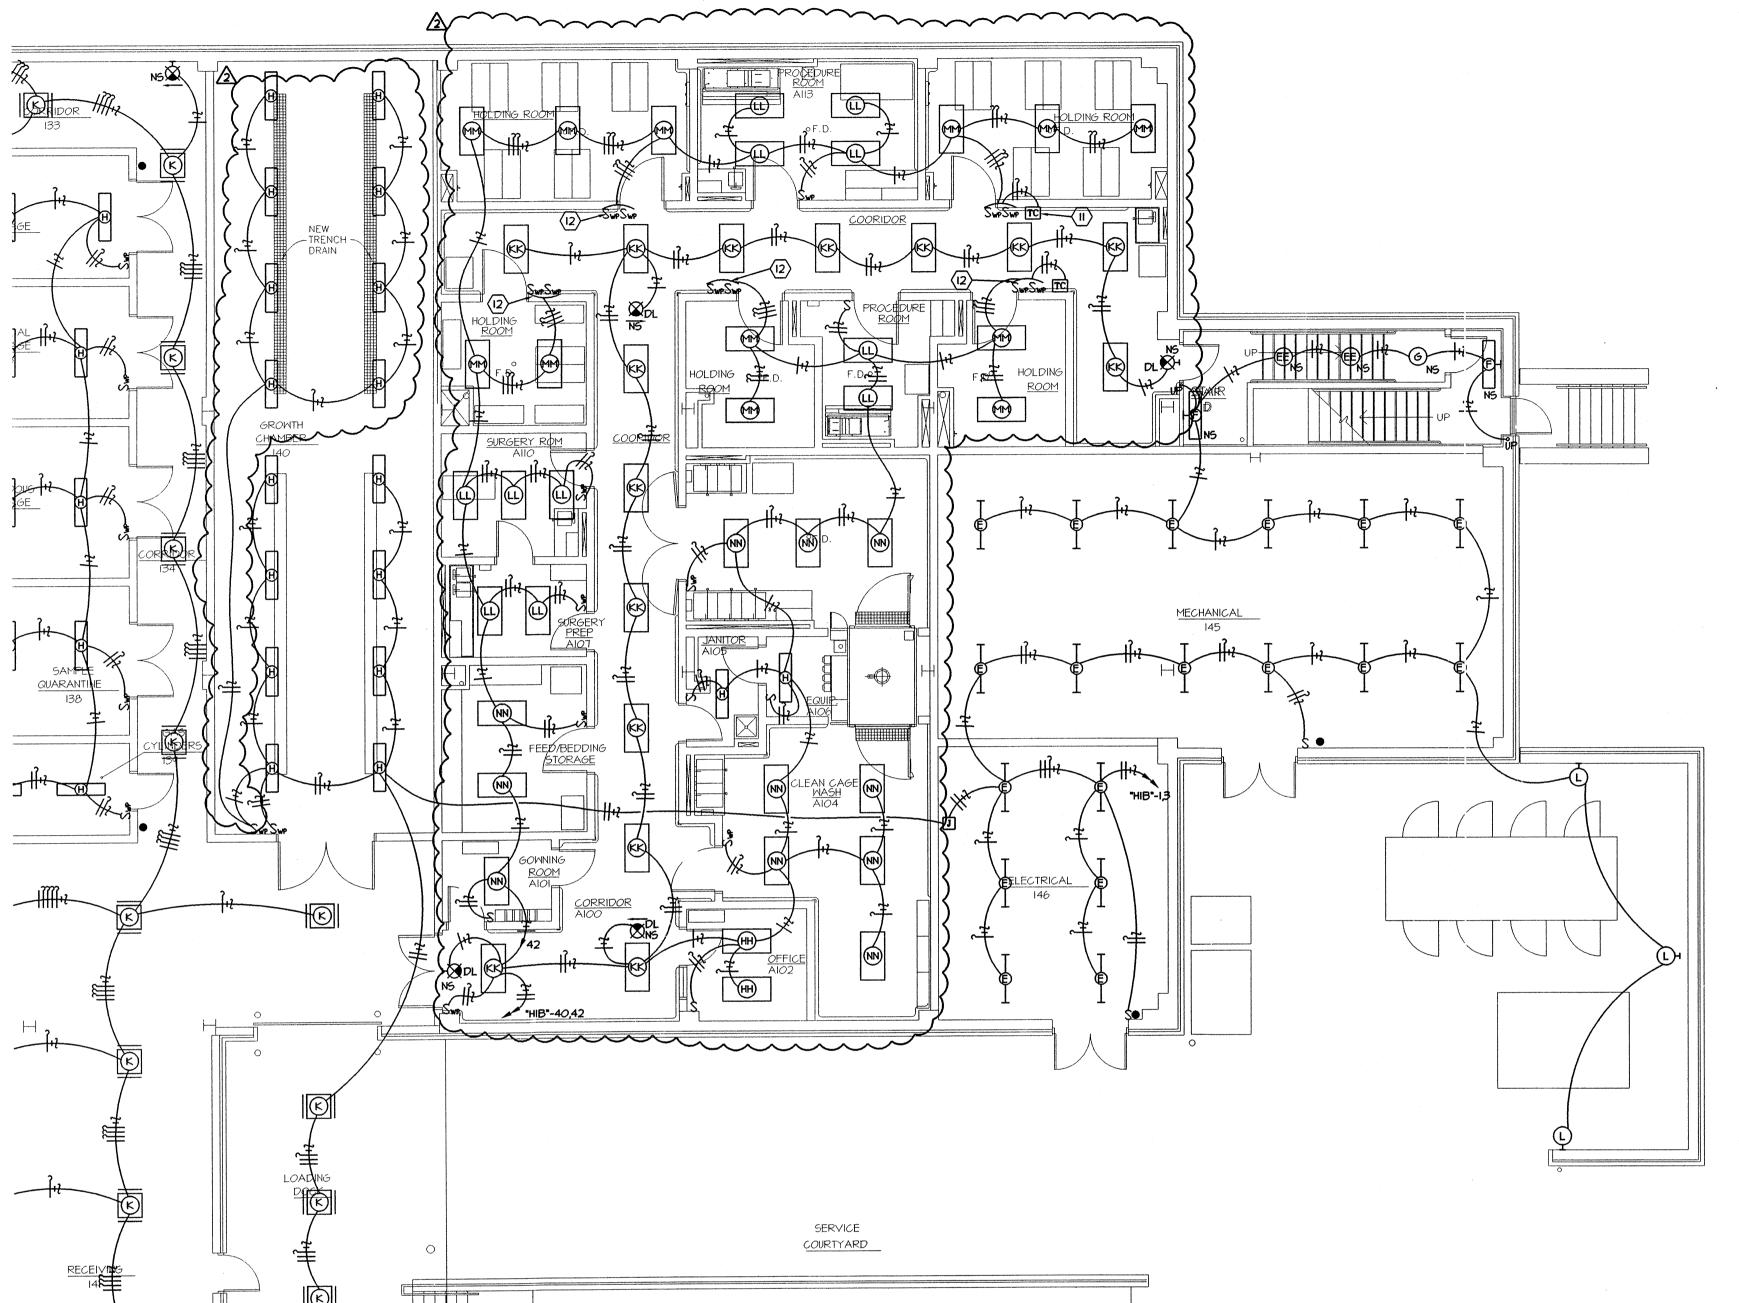


KEYED ELECTRICAL NOTES

- 2 PROVIDE AND INSTALL LUTRON #NF-10-277 SLIDE DIMMER SMITCH.
- (4) ROUTE 3#12, I#12-EG, IN 1/2" CONDUIT UP TO TORK #2104 PHOTOCELL, CONDUIT MOUNTED
- PROVIDE AND INSTALL LUTRON #GRX-3106-A-WH GRAFIK EYE PRESET DIMMING CONTROL UNIT IN WALL AT 48" AFF TO CENTER (REQUIRES 4-GANG X 3-1/2" DEEP JUNCTION BOX).
- PROVIDE AND INSTALL LUTRON #NTGRX-45-WH, ENTRY STATION AT 48" AFF TO CENTER IN SINGLE GANG X 3-1/2" DEEP JUNCTION BOX.


- (D) INSTALL SEMINAR #107 DIMMING SYSTEM COMPONENTS ON 5'-0" W X 3'-0" H X 3/4" PLYWOOD BOARD.
- ROUTE THROUGH TORK #7102-FLI FLUSH MOUNTED WITH LOCK AND KEY TIME CLOCK, FOR DAY/NIGHT CYCLE CONTROL OF LIGHTING IN HOLDING ROOMS (VERIFY EXACT HOURS OF ON/OFF OPERATION WITH OWNER).
- FIRST SMITCH TO CONTROL 2 OUTBOARD LAMPS OF FIXTURES IN ROOM, SECOND SMITCH TO CONTROL

(PROVIDE AND INSTALL PRESCOLITE #TT4WH (4'-0" LONG), 2 CIRCUIT TRACK, #TT14 (2 CIRCUIT, 90° FITTING), #TT8WH (8'-0" LONG) 2 CIRCUIT TRACK, AND #TT13WH 2 CIRCUIT OUTLET BOX FEED CONNECTOR). SURFACE MOUNT WHERE SHOWN AND SUPPORT FROM STRUCTURE ABOVE CEILING. INSTALL FIXTURES ON
	AND SUPPORT FROM STRUCTURE ABOVE CEILING. INSTALL FIXTURES ON ALTERNATING TRACK CIRCUITS.

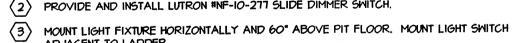

- ON ROOF. COORDINATE LOCATION WITH POSSIBLE LIGHT SOURCE CONFLICT.
- 6 PROVIDE AND INSTALL LUTRON #HP2, 277V DIMMING MODULE.
- PROVIDE AND INSTALL LUTRON #NGRX-PB POWER BOOSTER, SURFACE MOUNTED IN 2 GANG X 3-1/2" DEEP JUNCTION BOX.
- (9) STRIP FIXTURES TO BE MOUNTED IN RECESS COVE ABOVE LOUVER (PROVIDED BY ARCHITECT).



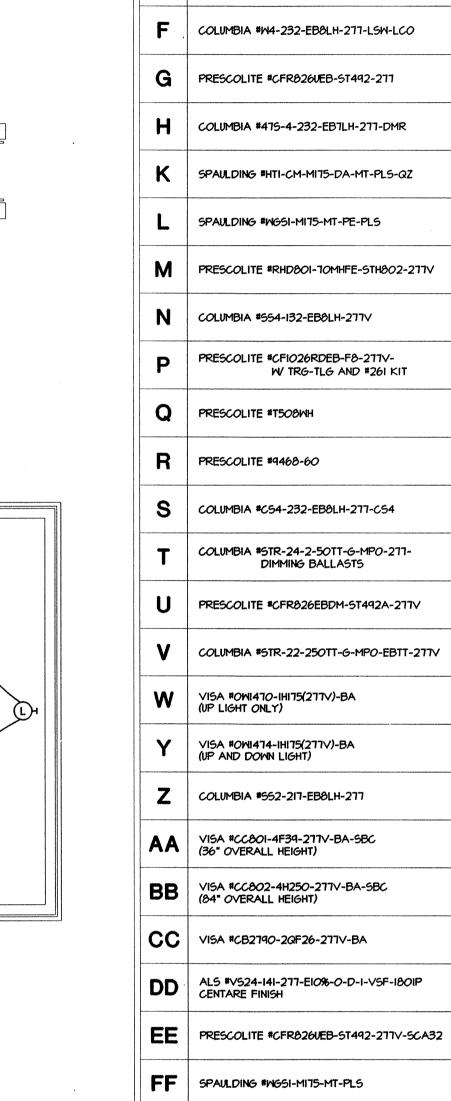

GG APPLETON #VXIO756

PRESCOLITE #EVDE-I-R-A-W

TYPE | MANUFACTURER CAT. NO.

COLUMBIA #STR-24-2-50TT-G-MPO-EBTT-277V

COLUMBIA #4PS-24-432-G-FS-AI2.I25-2EBLH-277

COLUMBIA #4PS-24-332-G-FS-AI2.I25-2EBLH-277

COLUMBIA #4PS-24-232-G-FS-AI2.I25-2EBLH-277

COLUMBIA #C54-232-EB8LH-277-C5WG4-KHC

ENCLOSED AND GASKETED HH COLUMBIA #4P5-24-432-F-F5-AI2.I25-E2BLH-277 RECESSED 2' X 4' FLUORESCENT FLANGED, PRISMATIC LENS 4-F32T8/SPX4I **KK** | COLUMBIA #WLT-24-232-F-FS-AI2.I25-EB8I-277V 277∨ 2-F32T8/SPX4I RECESSED 2' X 4' FLUORESCENT FLANGED, PRISMATIC LENS RECESSED 2' X 4' FLUORESCENT FLANGED, PRISMATIC LENS, COLUMBIA #WLT-24-432-F-FS-AI2.I25-EB8-277V 277∨ 4-F32T8/SPX4I (GASKETED) (I BALLAST)

277

277

RECESSED 2' X 4' FLUORESCENT FLANGED, PRISMATIC LENS, MM | COLUMBIA #WLT-24-332-F-F5-AI2.125-EB82-277V 3-F32T8/SPX4I 277∨ (GASKETED) (2 BALLAST) NN | COLUMBIA #WLT-24-332-F-F5-A12.125-EB81-277V 277∨ 3-F32T8/SPX4I (GASKETED) (I BALLAST)

LIGHT FIXTURE SCHEDULE

4-F50BX/SPX4I/RS

4-F32T8/SPX4I

3-F32T8/SPX4I

2-F32T8/SPX4I

2-F32T8/SPX4I/RS

2-F32T8/SPX4I

2-F26DBX/T4/SPX4I

2-F32T8/5PX4I

1-70W ED 17 MH

I-F32T8/5PX4I

2-F26DBX/T4/SPX4I

4-F50BX/SPX4I/RS

4-F50BX/SPX4I/RS

2-F17T8/SPX4I

4-F39/36BX/5PX4I

4-250W MH

6-F32T8/SPX4I/RS

2-F17T8/SPX41/RS

1-175W ED-17 MH

1 - 60W.AI9IF

277 2-F26DBX/T4/5PX4I

277

277

2' X 4' RECESSED INDIRECT FLUORESCENT FIXTURE

2' X 4' FLUORESCENT LAY-IN, PRISMATIC LENS, 4 LAMP

2' X 4' FLUORESCENT LAY-IN, PRISMATIC LENS, 3 LAMP

2' X 4' FLUORESCENT LAY-IN, PRISMATIC LENS, 2 LAMP

4' WALL MOUNTED FLUORESCENT FIXTURE (MOUNTING HEIGHT AS NOTED ON PLANS)

8" DIA. OPEN RECESSED COMPACT FLUORESCENT CAN FIXTURE

EXTERIOR WALL PACK MOUNTED AT 12'-O" AFG W/ "PE" CELL

4' STAGGERED STRIP FIXTURE MOUNTED IN METAL CEILING RECESSED COVE

SURFACE MOUNTED FLUORESCENT FIXTURE, GASKETTED

SURFACE OR CONDUIT MOUNTED AT 12'-O" AFF θ W X 14"L PRISMATIC LENS

8" DIA. OPEN RECESSED EXTERIOR SOFFIT LIGHT

IO" DIA. RECESSED LENSED GASKETED PRISMATIC FLUORESCENT CAN FIXTURE

TRACK MOUNTED GIMBAL FIXTURE

SURFACE MOUNTED INCANDESCENT FIXTURE

SURFACE MOUNTED STRIP FIXTURE W/ 1-1/2" SPACER

2 LUTRON #FDB-2243-277-2 (DIMMING BALLAST)

 δ^{\bullet} DIA. RECESSED COMPACT FLUORESCENT CAN W DIMMING BALLASTS

2' X 2' RECESSED INDIRECT FLUORESCENT FIXTURE

MALL MOUNTED AT 24" ABOVE 2ND FLOOR LINE (BALLAST ABOVE 1ST FLOOR CEILING)

WALL MOUNTED AT 24" ABOVE 2ND FLOOR LINE

PENDANT MOUNTED 2 ARM, 2 BOWL INDIRECT (MODIFIED PENDANT)

COVE LIGHT MOUNTED AT 7'-2" AFF TO BOTTOM

RECESSED 8" DIAMETER COMPACT FLUORESCENT

EXTERIOR WALL PACK MOUNTED AT 12'-O" AFF

STAGGERED STRIP FIXTURE MOUNTED IN METAL CEILING RECESS

PENDANT MOUNTED 4 ARM, 4 BOWL INDIRECT (MODIFIED PENDANT)

(BALLAST ABOVE IST FLOOR CEILING

277 2-F26DBX/T4/SPX4I/RS | WALL MOUNTED SCONCE, MOUNTED @ 7'-6" AFF

(15'-0"L X 8"H) FACIA.

WITH 32 DEGREE SLOPE ADAPTER

SURFACE MOUNTED INSIDE MECH DUCT.

2' X 4' RECESSED INDIRECT FLUORESCENT FIXTURE WITH

4' FLUORESCENT STRIP FIXTURE W WIREGUARD, CHAIN HUNG AT 10'-0" AFF

RECESSED 2' X 4' FLUORESCENT FLANGED, PRISMATIC LENS, PRESCOLITE #DMX-I-R-A-W 277 LED W UNIT SINGLE FACE EXIT SIGN PRESCOLITE #DMX-2-R-A-W 277 DOUBLE FACE EXIT SIGN LED W UNIT


LED W UNIT

SINGLE FACE EXIT SIGN (DAMP LOCATION)

LARGE SCALI CULTURE FACIL FLOOR PLAN

Commission Num

neers a division of TME, Inc. E2.21

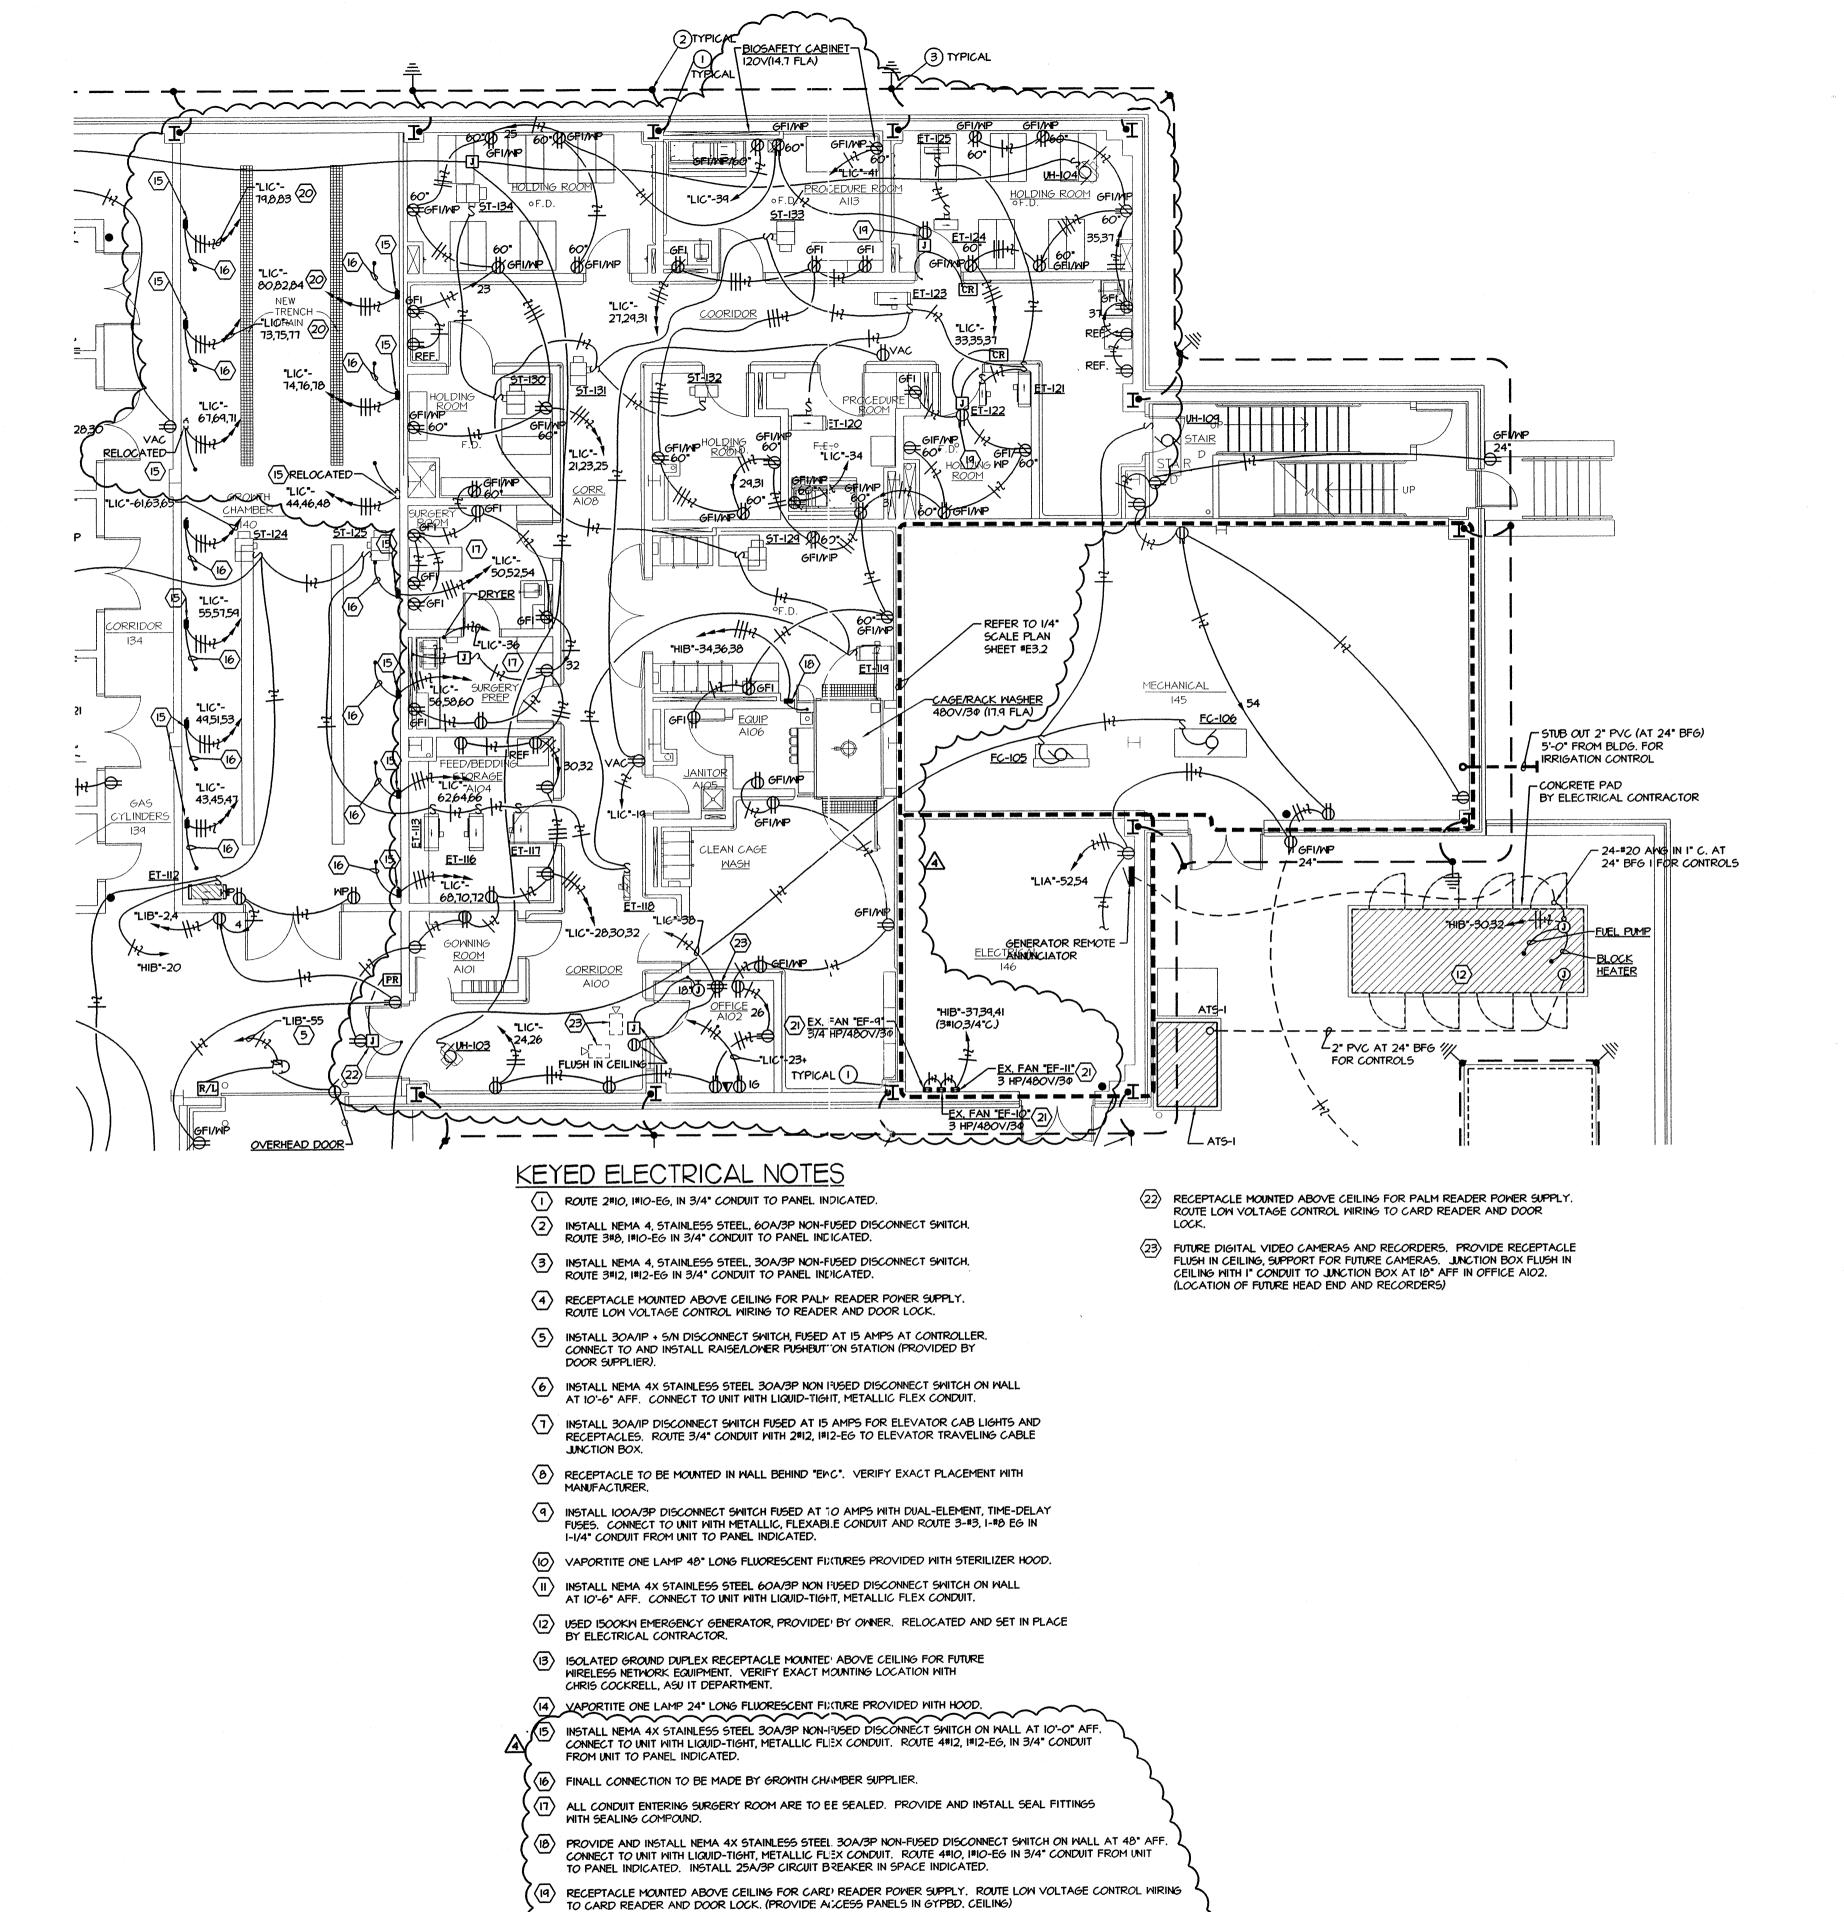

PROVIDE AND INSTALL 20A/3P CIRCUIT BREAKER IN SPACE OF EXISTING PANEL.


EXHAUST FAN DISCONNECT SWTICH, REFER TO ROOF PLAN, SHEET E2.IIA FOR LOCATIONS.

PROVIDE AND INSTALL NEMA SIZE #O STARTER WITH H-O-A SWITCH, RED/GREEN PILOT LIGHT, START/STOP PUSH BUTTON, OVERLOAD RELAYS AND CONTROL TRANSFORMER: FOR EACH EXHAUST FAN INDICATED. PROVIDE (2) N.O., (2) N.C. AUXILIARY CONTACTS AND NEMA I ENCLOSURE. ROUTE 3#10, I#10-EG, IN 3/4" CONDUIT UP TO ASSOCIATED

4 OCTOBER 1, 2003

Commission Num


Date: October 1, 2

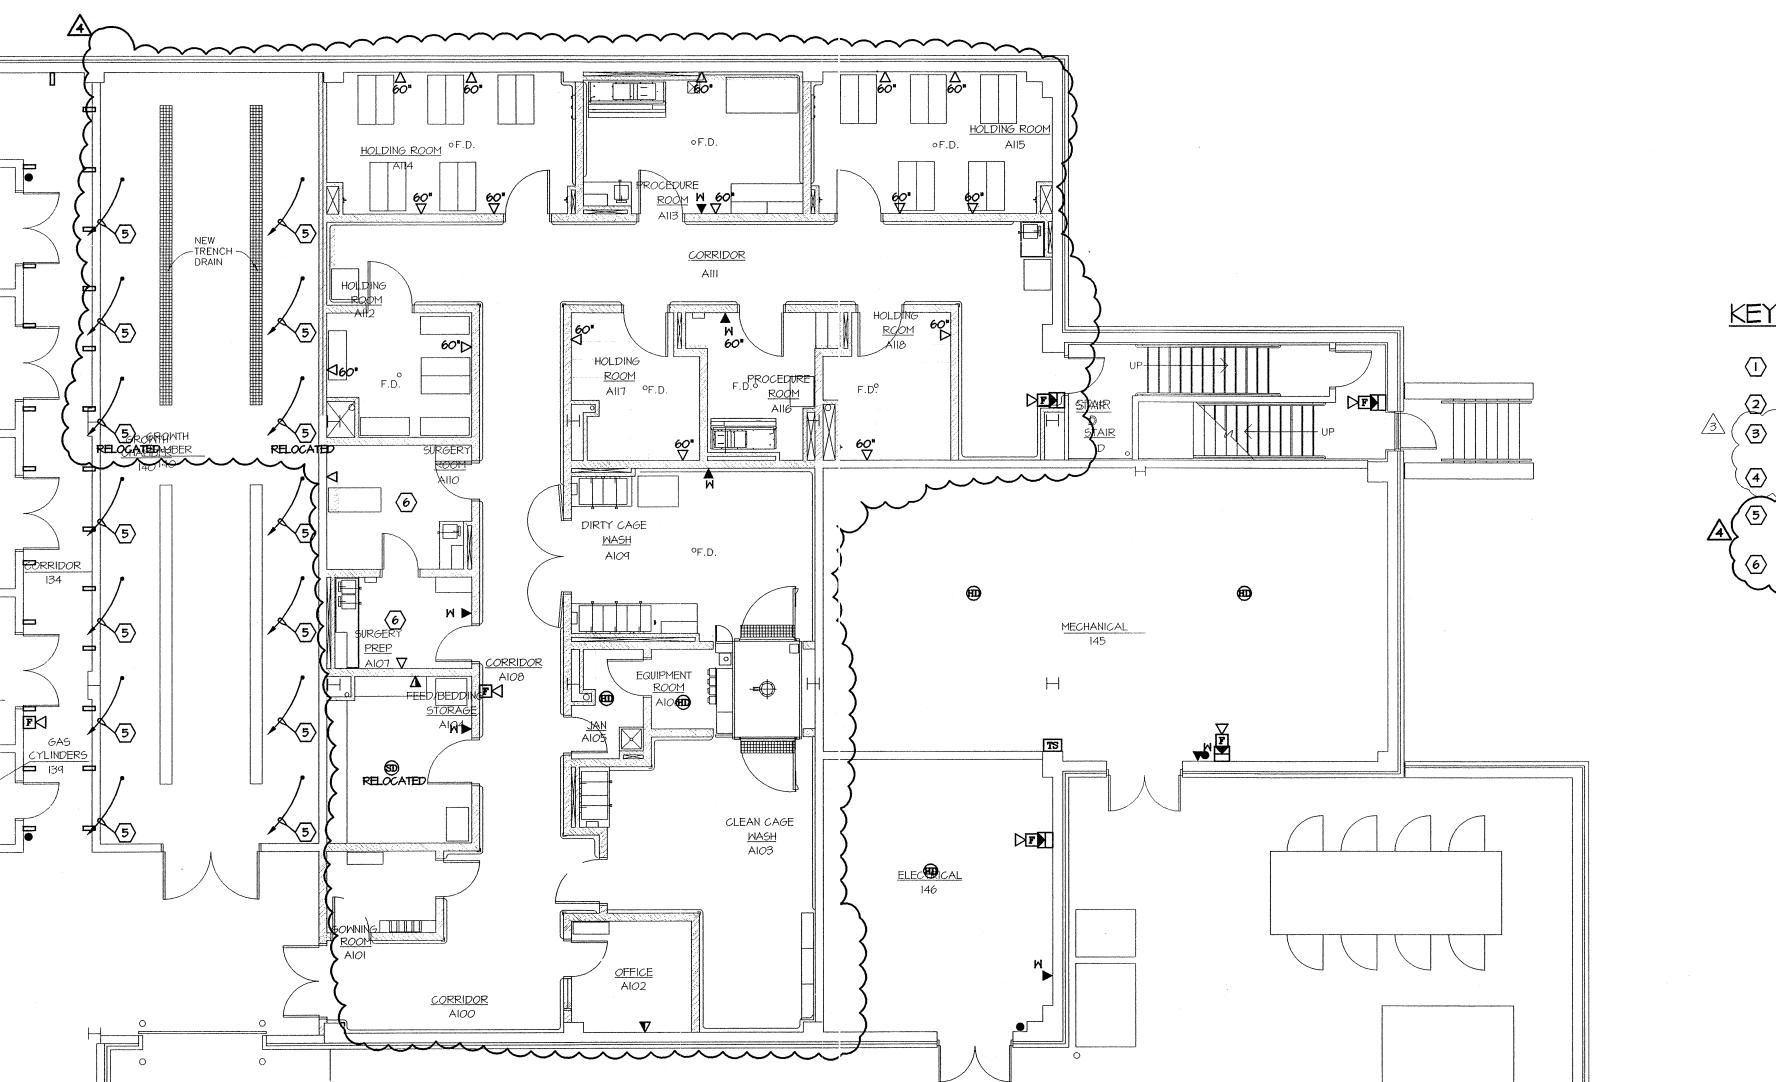


KEYED ELECTRICAL NOTES

- ROUTE 3/4" CONDUIT WITH DEDICATED PHONE LINE TO TELEPHONE TERMINAL BOARD FOR ELEVATOR CAB PHONES.
- 2 DEVICES WALL MOUNTED AT 6'-0" ABOVE ELEVATOR PIT FLOOR.
- DATA OUTLET IN SINGLE GANG BOX ABOVE CEILING FOR FUTURE WIRELESS, NETWORK ACCESS EQUIPMENT. VERIFY EXACT LOCATION WITH CHRIS COCKRELL OF ASU IT DEPARTMENT.
- PROVIDE SEPARATE CABLE MANAGEMENT HOOKS IN CORRIDORS
 FOR TELEPHONE, DATA, AND FIRE ALARM WIRING.

 5 ROUTE 3/4" CONDUIT TO ABOVE ACCESSIBLE LAY-IN CEILING AT DOUBLE DOOR #55 IN CORRIDOR #II2. PROVIDE PULL STRING
- ALL CONDUIT ENTERING SURGERY ROOM ARE TO BE SEALED. PROVIDE AND INSTALL SEAL FITTINGS W SEALING COMPOUND

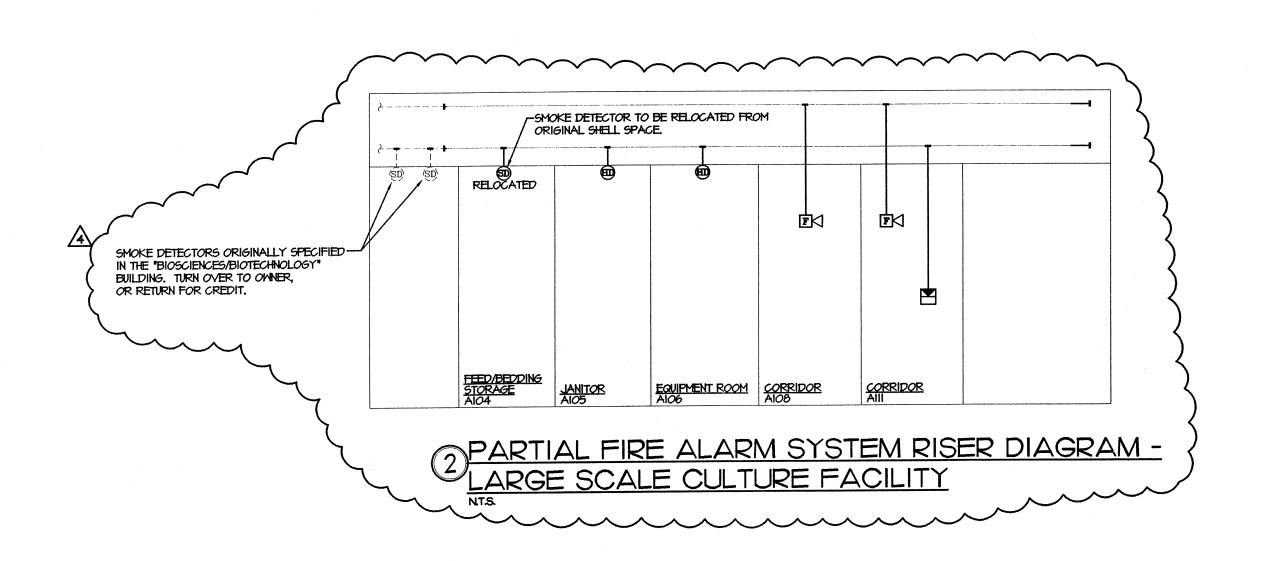


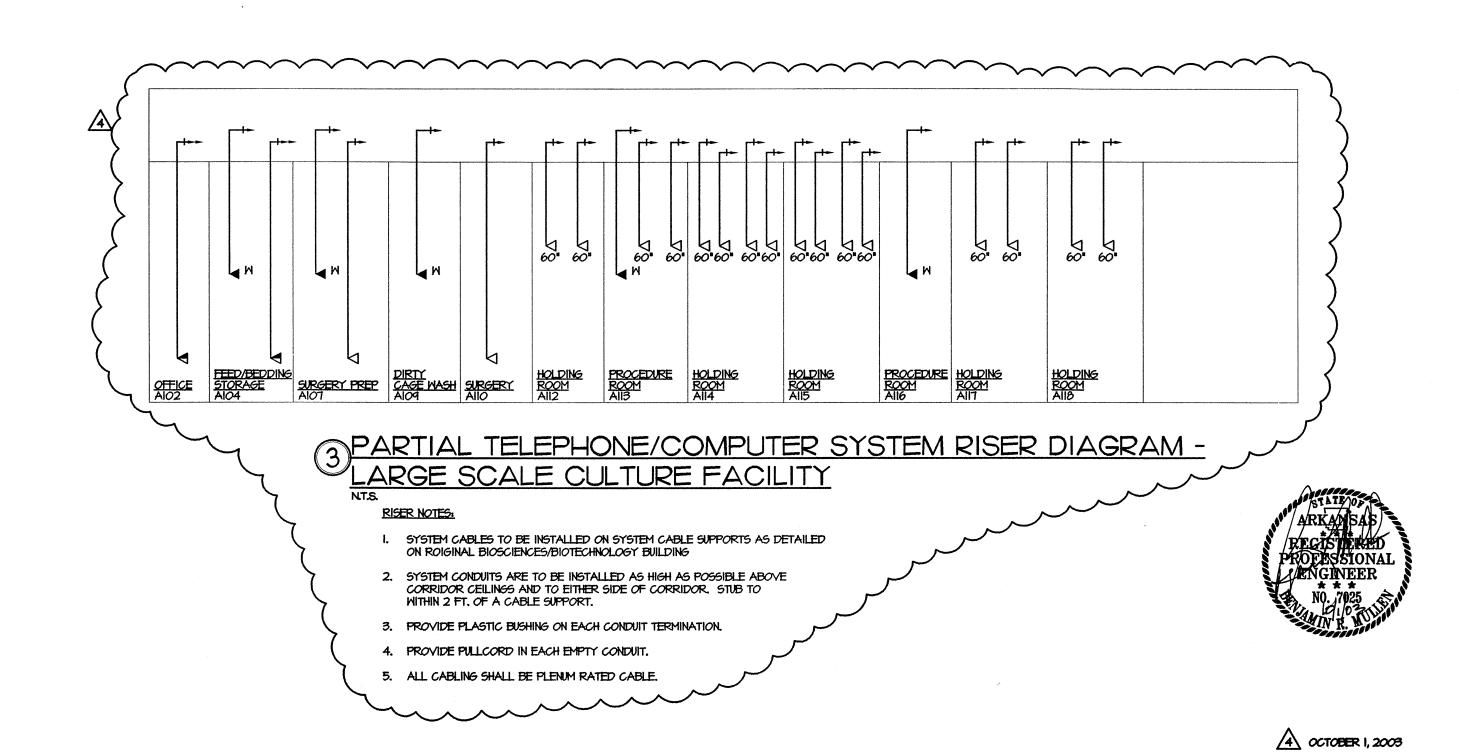


n large scale culture facility floor plan - systems

Consulting Engineers
a division of TME, Inc. 5800 EVERGREEN DRIVE, SUITE A LITTLE ROCK, ARKANSAS 72205-1757 Phone: (501) 666-6776 Fax: (501) 663-8888 SCALE: 1/8" = 1'-0"

Date: October 1, 2

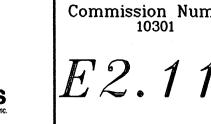



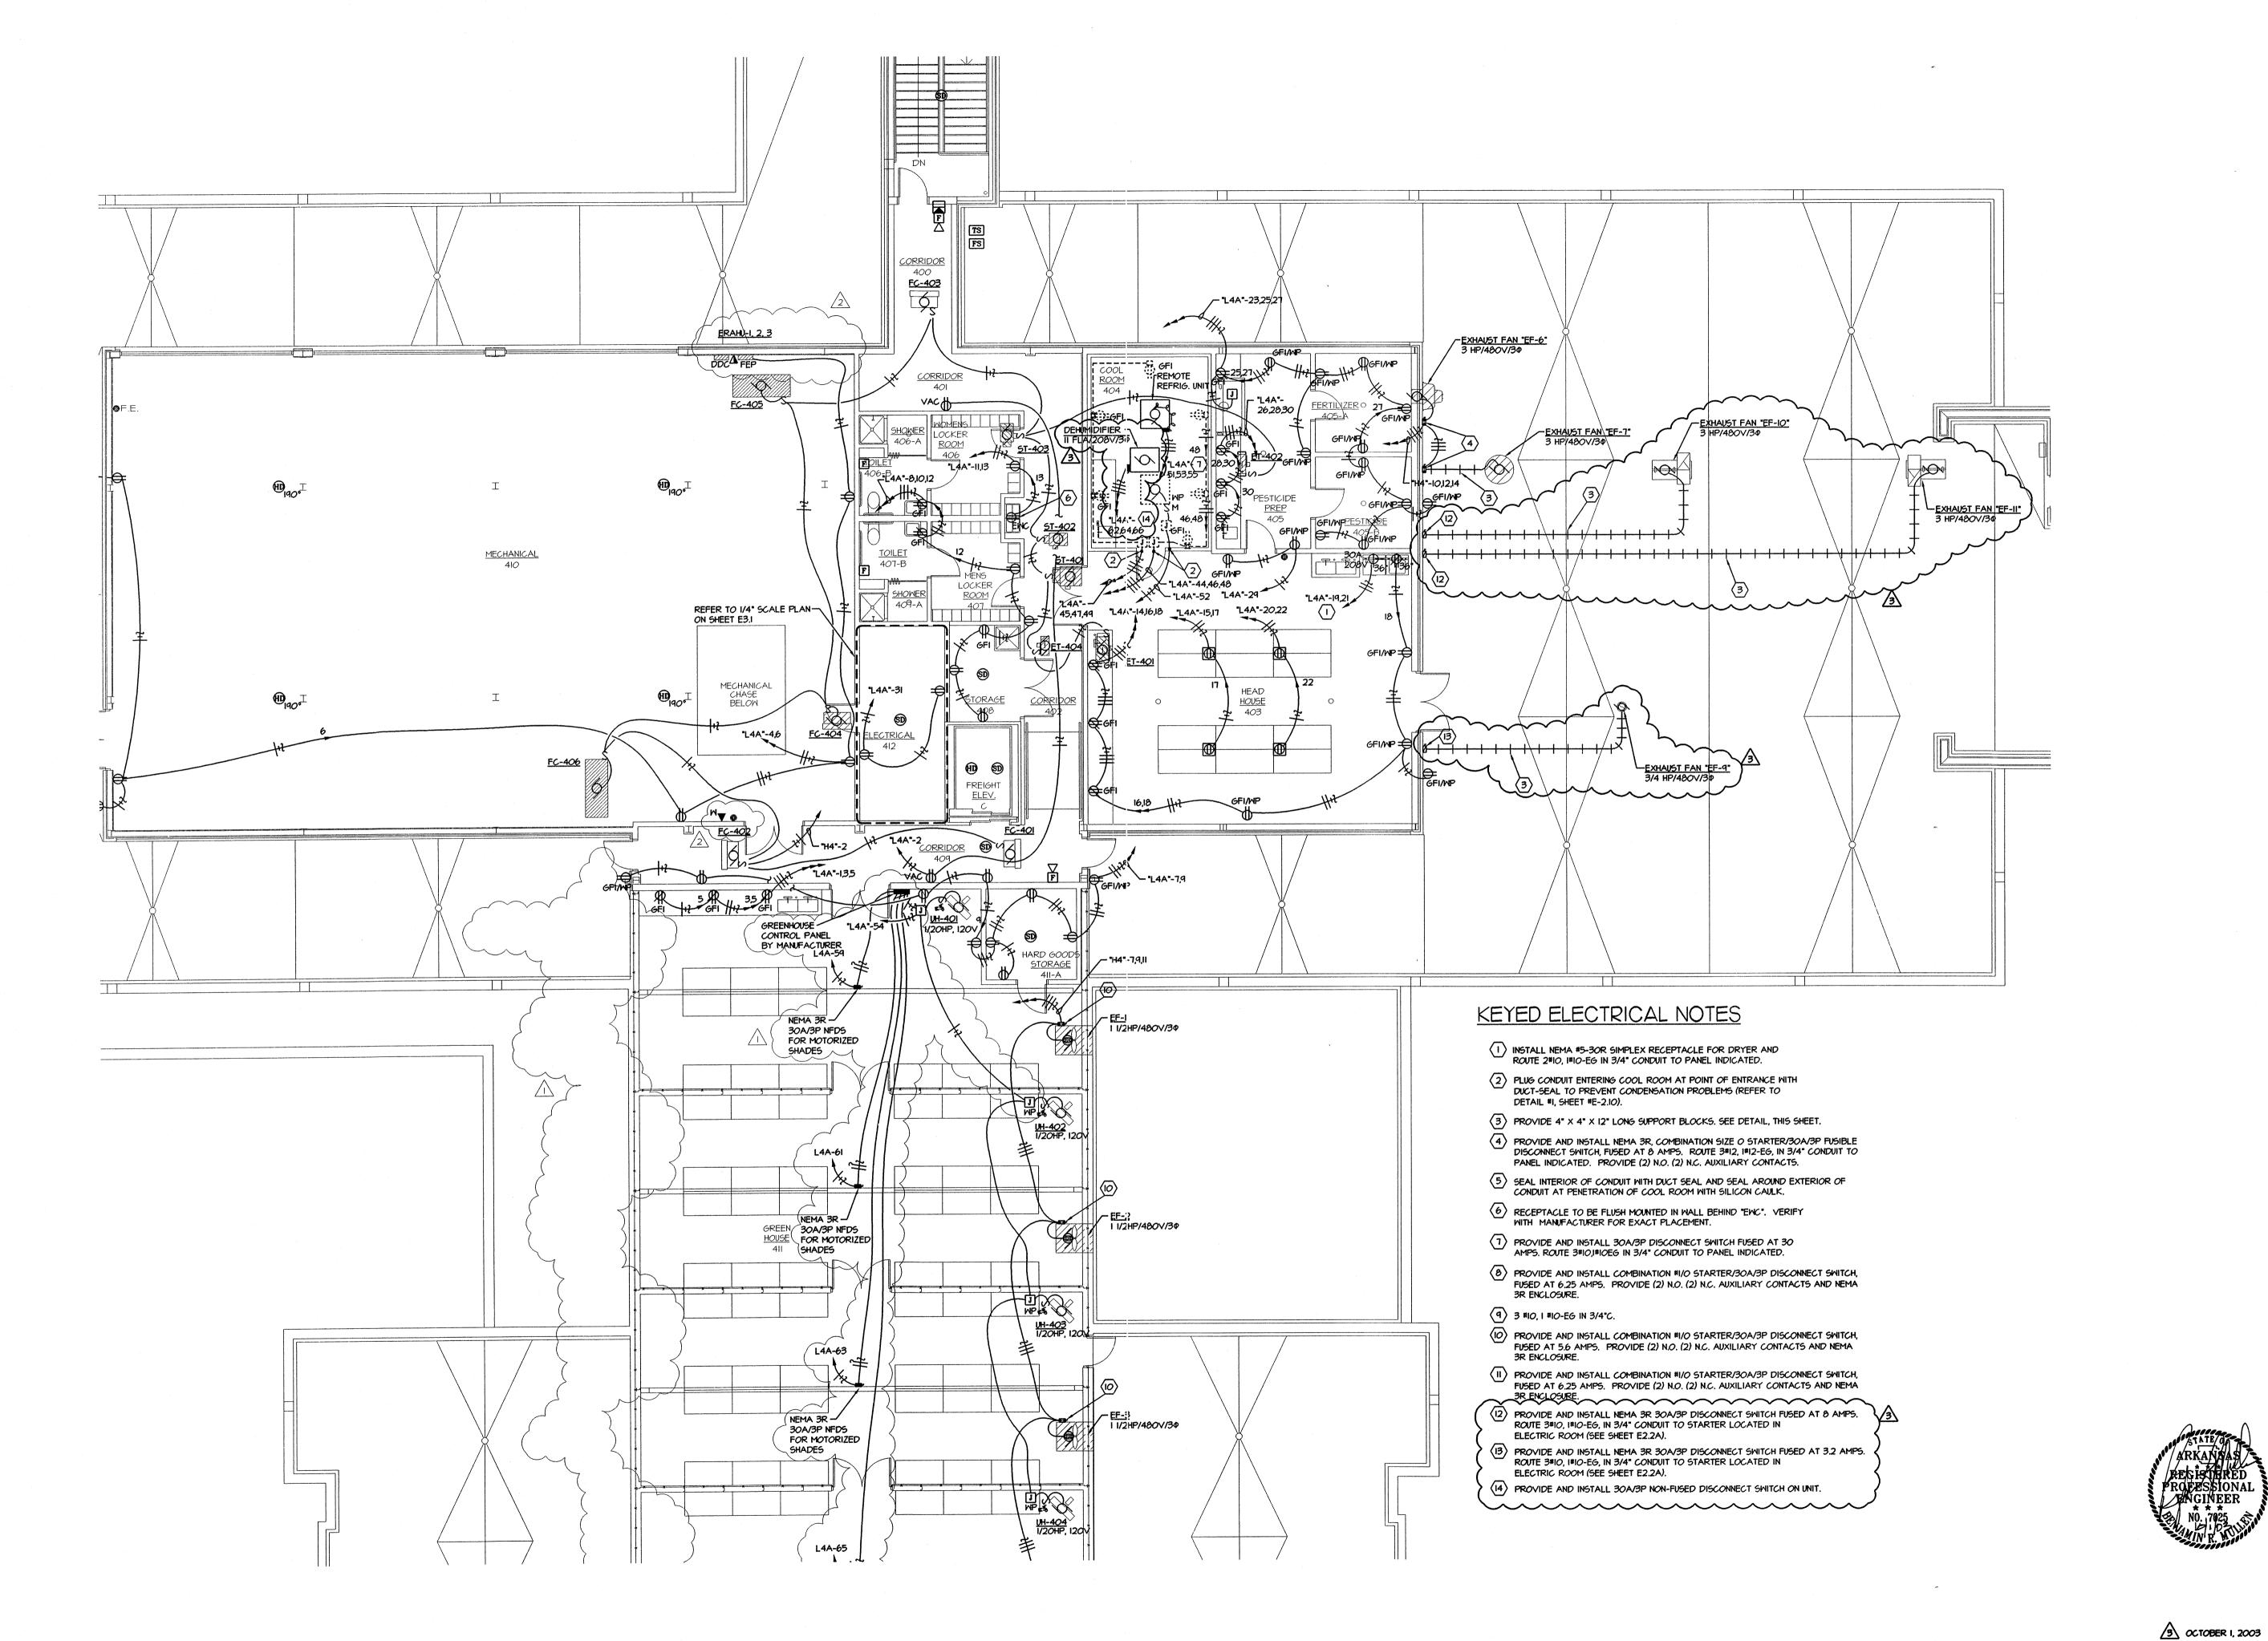

n partial roof plan -

power


SCALE: 1/8" = 1'-0"

Commission Num 10301

Date: October 1, 2

Consulting Engineers

a division of TME, Inc. Phone: (501) 666-6776 Fax: (501) 663-8888

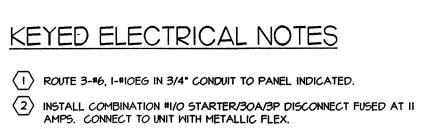

3 INSTALL 30 AMP/3P DISCONNECT SWITCH FUSED AT II AMPS. CONNECT UNIT WITH METALLIC FLEX.

PROVIDE (2) SEPARATE SERVICES FOR FIRE PUMP CONTROLLER

<u>SERVICE #1</u>: (EMERGENCY) ROUTE TO TO AMP/3P BREAKER AT

EMERGENCY GENERATOR. <u>SERVICE #2</u>: (NORMAL POWER) ROUTE TO

LOAD SIDE TERMINALS OF PAD MOUNTED TRANSFORMER. BOTH SERVICES TO BE ENCASED IN CONCRETE.

5) INSTALL COMBINATION #1/O STARTER/30A/3P DISCONNECT SWITCH FUSED AT IS AMPS. CONNECT TO UNIT WITH METALLIC FLEX.

CONTROL PANEL

"HIP"-23,25,27

2 "LIC"-13,15,17

7 SETS OF (4" CONDUIT)-

4"HIB"-14,16,18

P-3 7 1/2HP/480V/30 -

-BOILER "B-3" (IO)
2 @ 2 HP/480V/30

SERVICE COURTYARD

BRACKET

STATION

-7 SETS OF (4" CONDUIT)

MAIN SWITCHBOARD "MSWBD" -

P-2 7 1/2HP/480V/30 -

MECHANICAL

(6) INSTALL COMBINATION #1/O STARTER/30A/3P DISCONNECT SWITCH FUSED AT 8 AMPS. CONNECT TO UNIT TO WITH METALLIC FLEX.


PROVIDE COMBINATION #1/O STARTER/30A/IP NON-FUSED DISCONNECT SWITCH WITH "HOA" SWITCH, OVERLOAD RELAY, PILOT LIGHTS (I GREEN, I RED) AND (2) N.O., (2) N.C. AUXILIARY CONTACTS

(8) PROVIDE AND INSTALL SQUARE "D" #SKR3RH5 PUSH BUTTON ON STAINLESS STEEL COVER MOUNTED IN WATER-TIGHT, SURFACE MOUNTED TYPE "F5" BOX AT 48" A.F.G. PROVIDE SQUARE "D" *K6 PAD LOCK
COVER (WITH MASTER LOCK) AND SQUARE "D" *KN399 LEGEND PLATE
(REFER TO APPROPRIATE DETAIL FOR ADDITIONAL REQUIREMENTS) THIS


 3/4" CONDUIT TO BOILER MASTER CONTROL PANEL FOR INTERLOCK
WIRING FOR BOILER EMERGENCY SHUT-DOWN. (10) CONTRACTOR TO CHANGE VOLTAGE CONNECTIONS FROM 230V TO 480V/30 IN BOILER.

PROVIDE COMBINATION #1/O STARTER/30A/3P DISCONNECT SWITCH (FUSED AT 6.25 AMPS). PROVIDE H-O-A SWITCHM OVERLOAD RELAY, PILOT LIGHTS (I RED, I GREEN), AND (2) N.O., (2) N.C. AUXILIARY CONTACTS.

REMOVE EXISTING ISA/3P BREAKER ON CIRCUIT MADE SPARE BY REMOVAL OF HOUSE PUMP

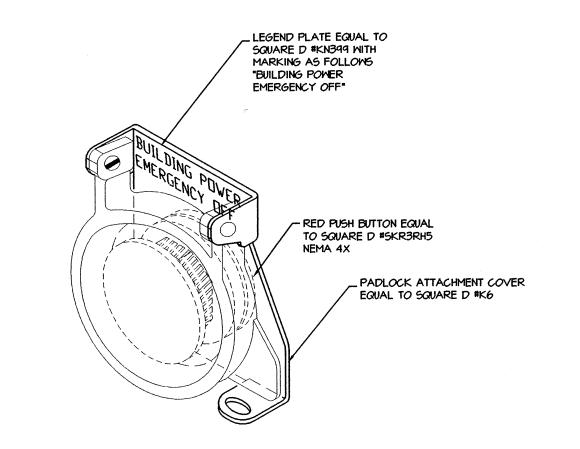

EMERGENCY PUSH BUTTON FOR SHUNT TRIP MAIN NOT TO SCALE

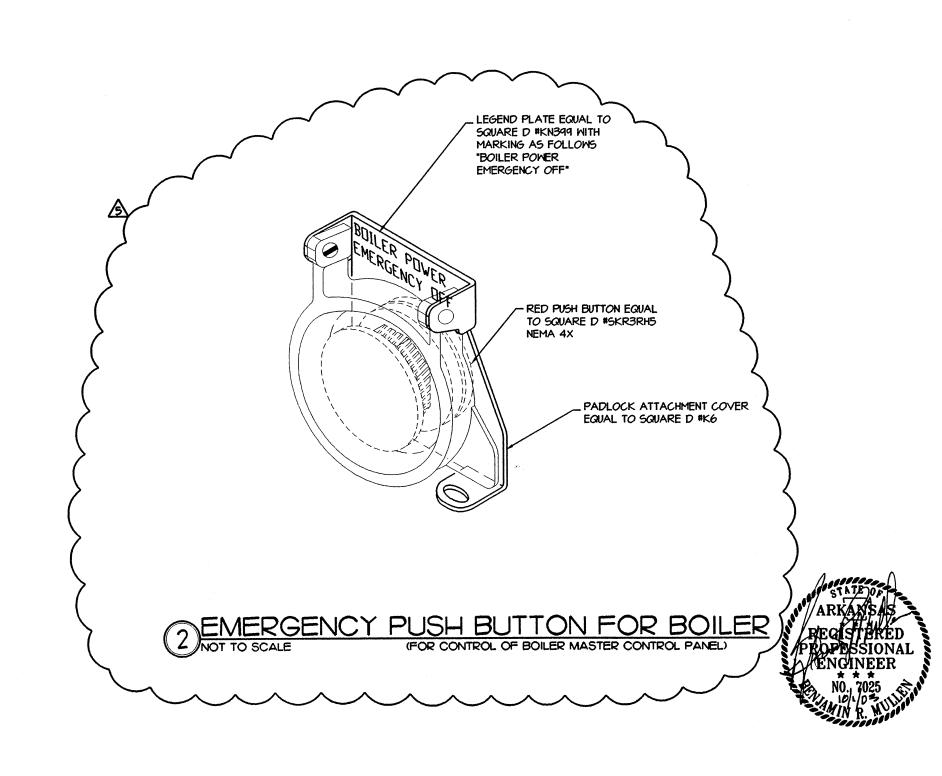


5 OCTOBER 1, 2003

CONNECTION POINT.

n first floor mechanical room floor plan - power

SCALE: 1/8" = 1'-0"

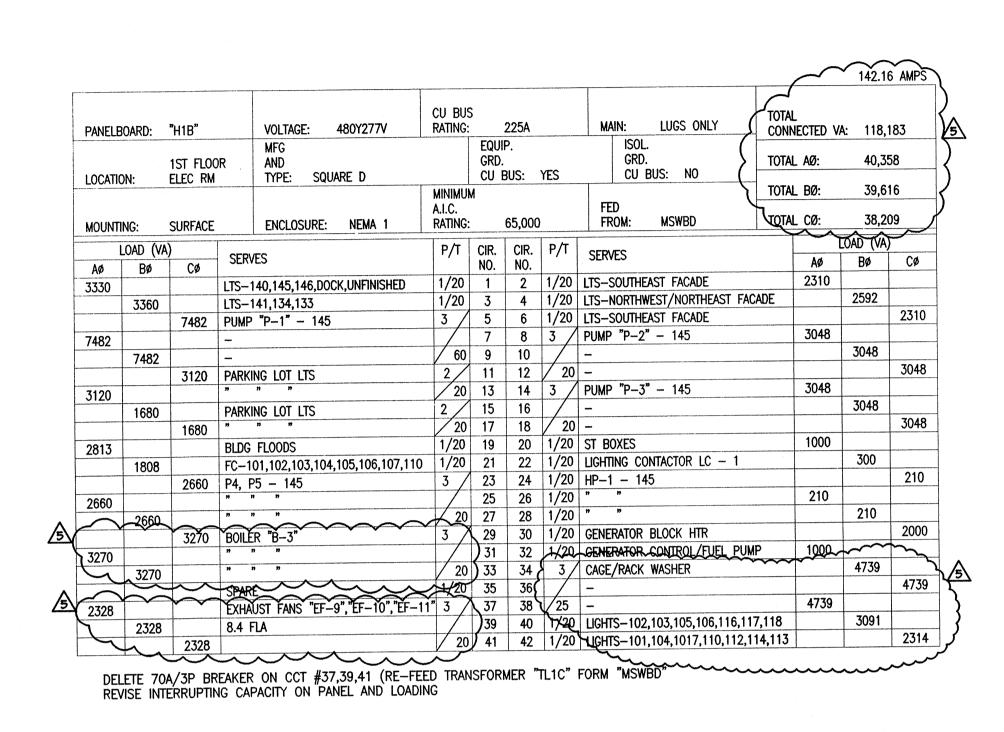

anelb		"L1C" SECTION		CU BUS RATING:		225A		MAIN: -	TOTA CONI	NEETED V	A: 72,24	40 5
LOCATIO	on: I	ELEC RM	MFG AND 146 TYPE: SQUARE D NQOD		equi GRD. Cu i		YES	ISOL. GRD. CU BUS: NO		ALÇAØ:	22,5)
MOUNTI		SURFACE	ENCLOSURE: NEMA 1	MINIMUI A.I.C. RATING:		10,000		FED FROM: -		AT CAS:	24,8 24,8	7
	LOAD (VA)			P/T	CIR.	CIR.	P/T	SERVES			DAD (VA)	
Αø	Bø	Cø	SERVES	,	NO.	NO.				Aø	Bø	Cø
1608			GROWTH CHAMBER #1	3 /	43	44	3	GROWTH CHAMBER #6		1608	4==0	
	1776				45	46					1776	4776
		1776	_	20	47	48	20	/ / // //		4000		1776
1608			GROWTH CHAMBER #2	3	49	50	3	GROWTH CHAMBER #7		1608	4776	
	1776		_		51	52	/				1776	1776
MARKAGE CONTRACTOR STATE		1776	_	20	53	54	20			1608		1//0
1608			GROWTH CHAMBER #3	3	55	56	3	GROWTH CHAMBER #8		1000	1776	
	1776		_ /	_/_	57	58	/20				1//0	1776
		1776	_	20	59	60	20	- COURT CHANED IO		1608		1770
1608			GROWTH CHAMBER #4	3	61	62	3	GROWTH CHAMBER #9		1000	1776	
	1776		_	-1/	63	64	/00			-	1770	1776
		1776	_	20	65	66	20	- CDOMEN CHAMPED #10		1608		1770
1608			GROWTH CHAMBER #5	3	67	68	3	GROWTH CHAMBER #10		1000	1776	
	1776		-	20	69	70	20	~~~~	~~	———	——————————————————————————————————————	1776
<u>~</u>	\frown	7976				<u> </u>	3 /	FUTURE CHAMBER		1608		~~~
1608			FUTURE CHAMBER	3	73	74 76	13/	FUIURE CHAMDER		1000	1776	
	1776			1/00	75	78	20			-	1775	1776
		1776		20	77	80	3 /	FUTURE CHAMBER		1608		+•
1608			FUTURE CHAMBER	3	79 81	82	13/	- CHAMBER		1000	1776	
	1776	1776	-	20	83	84	20				1	1776

PANELE	BOARD:	"L1C" SECTION	2	CU BUS RATING:		400		400A/3P MCB MAIN: FEED THRU LUGS	TOTAL CONNE	CTED (VA		5,988 <i>-</i> 7,400 <i>-</i>	SECTIO SECTIO
1ST FLOOR LOCATION: ELEC RM			MFG OR AND TYPE: SQUARE D		EQUI GRD. CU		YES	ISOL. GRD. CU BUS: YES	TOTAL AØ:		11,420		,
		ENCLOSURE: NEMA 1	MINIMUN A.I.C. RATING:		22,000		FED PANEL "MSWBD" FROM: XFMR/"TL1C"	TOTAL		12,78 11,78		>	
MOUNT		SURFACE	ENCLOSORE. NEMA I					TROM. Army Tero			OAD (VA)		
	LOAD (VA		SERVES	P/T	CIR.	CIR.	P/T	SERVES	-	Aø	DAD (VA) Bø	Cø	
Aø	Bø	Cø		4 /00	NO.	NO.	1 /00	70.001 477 445		720	שם	CW	
900			RECEPTS-146	1/20	1	2	1/20	"WH-1" - 145		720	900		
	800		SECURITY GATE	1/20	3	4		RECEPTS - 146			900	800	
		800		1/20	5 7	8	1/20	SECURITY GATE		800		000	
800	200		SECURITY GATE	1/20	9	10	3/	B-1 - 145		000	720	·*·	
	800	600	DOILED CONTROLS	1/20	11	12	3/	n n n n			720	720	
700		600	BOILER CONTROLS	3/	13	14	20	77 79 21 79		720		720	
720	720		B-2 - 145	- 3/	15	16	V	UH - 101,102,103,104		720	560		
	/20	720	" " "	20	17	18		P6 - 145	-			1176	
600	~~	1	RECEPTS	1/20	19	20		SECURITY GATE		800			1
	1080		RECEPTS-A111, A112, A114	1/20	21	22	1	SECURITY GATE			800_	~	
	1000	900	RECEPTS—A111	1/20	23	24		RECEPTS-ATOO, ATO2	~	~		720	\ 5\
900			RECEPTS-A113, A114	1/20	25	26		RECEPTS-A102, A103, A106		900			
	900		RECEPTS-A113, A117	1/20	27	28		RECEPTS-A101, A104			1080)
		1080	RECEPTS-A109, A117	1/20	29	30	1/20	RECEPTS-A104, A107				1200	
1080			RECEPTS-A117, A118	1/20	31	32		RECEPTS-A110, A112		1080			1
	900		RECEPTS-A115	1/20	33	34		BIO-CABINET - A116			1764		1
***************************************		1000	RECEPTS-A111	1/20	35	36		DRYER - A110				300	1
800			RECEPTS-A111	1/20	37	38		FUTURE CAMERAS & RECORDERS		600			\mathcal{V}
	1764		BIO-CABINET - A113) 1/20	39	40		SPARE)
7		1764	BIO-CABINET - A113	1/20	41	42	1/20	SPARE					5

													<u></u>	1 AMDC
PANELB	OARD:	"L4A" SECTION	27	VOLTAGE:	208Y120V	CU BUS RATING:	EQUI			MAIN: LUGS ONLY		NECTED VA:	35,3	
LOCATIO	N:	FOURTH I		AND Type: So	QUARE D		GRD. CU I	BUS:	YES	GRD. CU BUS: YES	TOTA	L AØ:	\(\) 11,7	24
			control broads to the Angel of Control of Control			MINIMUN A.I.C.	A			FED	ATOT	L BØ:	\frac{\}{11,8}	24
MOUNTI	NG:	SURFACE		ENCLOSURE	: NEMA 1	RATING:	~~~	10,000		FROM: "L4A" SECT. #1	TOTA	L CØ:	11,7	$\sim\sim$
	OAD (VA		SERV	ÆS.		P/T	CIR.	CIR.	P/T	SERVES			AD (VA	
Aø	Bø	Cø	LTS -			1/20	NO. 43	NO. 44	1/20			Aø 1000	Bø	Cø
800	1000			PTS - 404	The state of the s	1/20	45	46	1/20	The second secon	**************************************	1000	1000	
		1000		PTS - 404		1/20	47	48	1/20	RECEPTS - 404				1000
1000				PTS - 404		1/20	49	50	1/20	RECEPTS - 412		900		
	2400		COOL	RM COND UN	NIT	3	51	52	1/20	COOL RM FAN DOOR HTR			1200	560
0.400		2400	,,	" "	,	30	53 55	54 56	1/20	UH - 401,402,403,404 LTS/RECPTS - ERAHU - 3		1400		300
2400	600		ITS -	- ERAHU-1,2,	3 PLENIIM	1/20		58	1/20			1100	1400	
	000	1176		NHOUSE	O I LLITOIN	1/20	59	60		THERAHUMAL	~~~		~~~	_1400_
1176				n n	***	1/20	61	62 (3 /	COLD ROOM DEHUMIDIFIER		3048		
	1176			» »	n n	1/20	63	64	/			-	3048	3048
		1176			**	1/20 1/20	65 67	66 (20	- SPARE		——————————————————————————————————————	~~	3040
			SPARE			1/20	69	70	1/20	SPARE				
			SPARE	*****		1/20	71	72	1/20					
:			SPACE				73	74		SPACE				
							75	76				-		
			11				77	78				-		
			-				79	80					~~~~~~~~~~~~~~~~~~~~~~~~~~~~~~~~~	
			+				81 83	84			A4444			



<u>√5</u> *осто*вея I, 2003



BUILDING

BIOSCIENCES/BIOTECHNOLOGY

ARKANSAS

UNIVERSIT

FACILIT


LARGE SCAL CULTURE FACIL FLOOR PLAN

Commission Num 10301

Date: October 1, 2




Commission Nun 10301 Date: October 1, 2

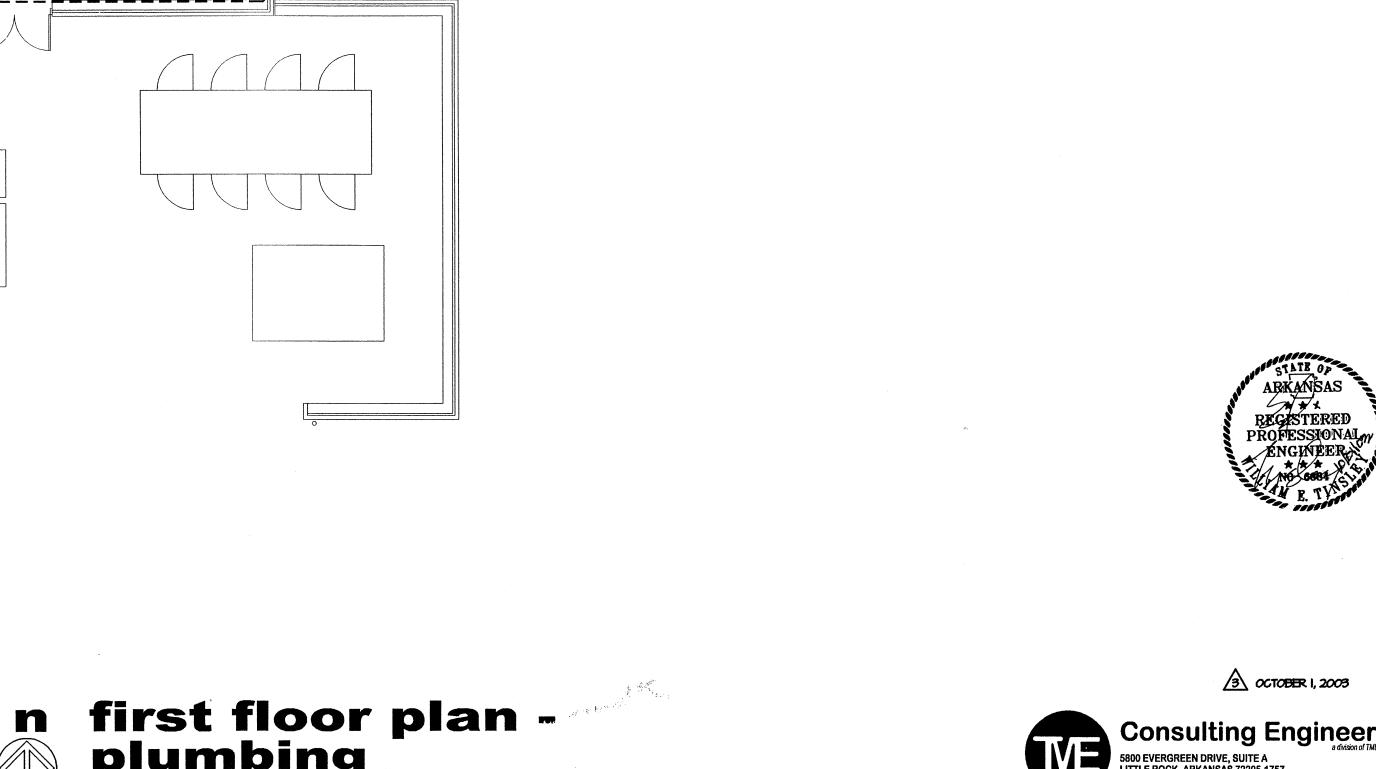

SCALE: 1/8" = 1'-0"

2" VENT BELOW FLOOR, TURN UP AND COLLECT IN RISE AND OFFSET ABOVE CEILING.

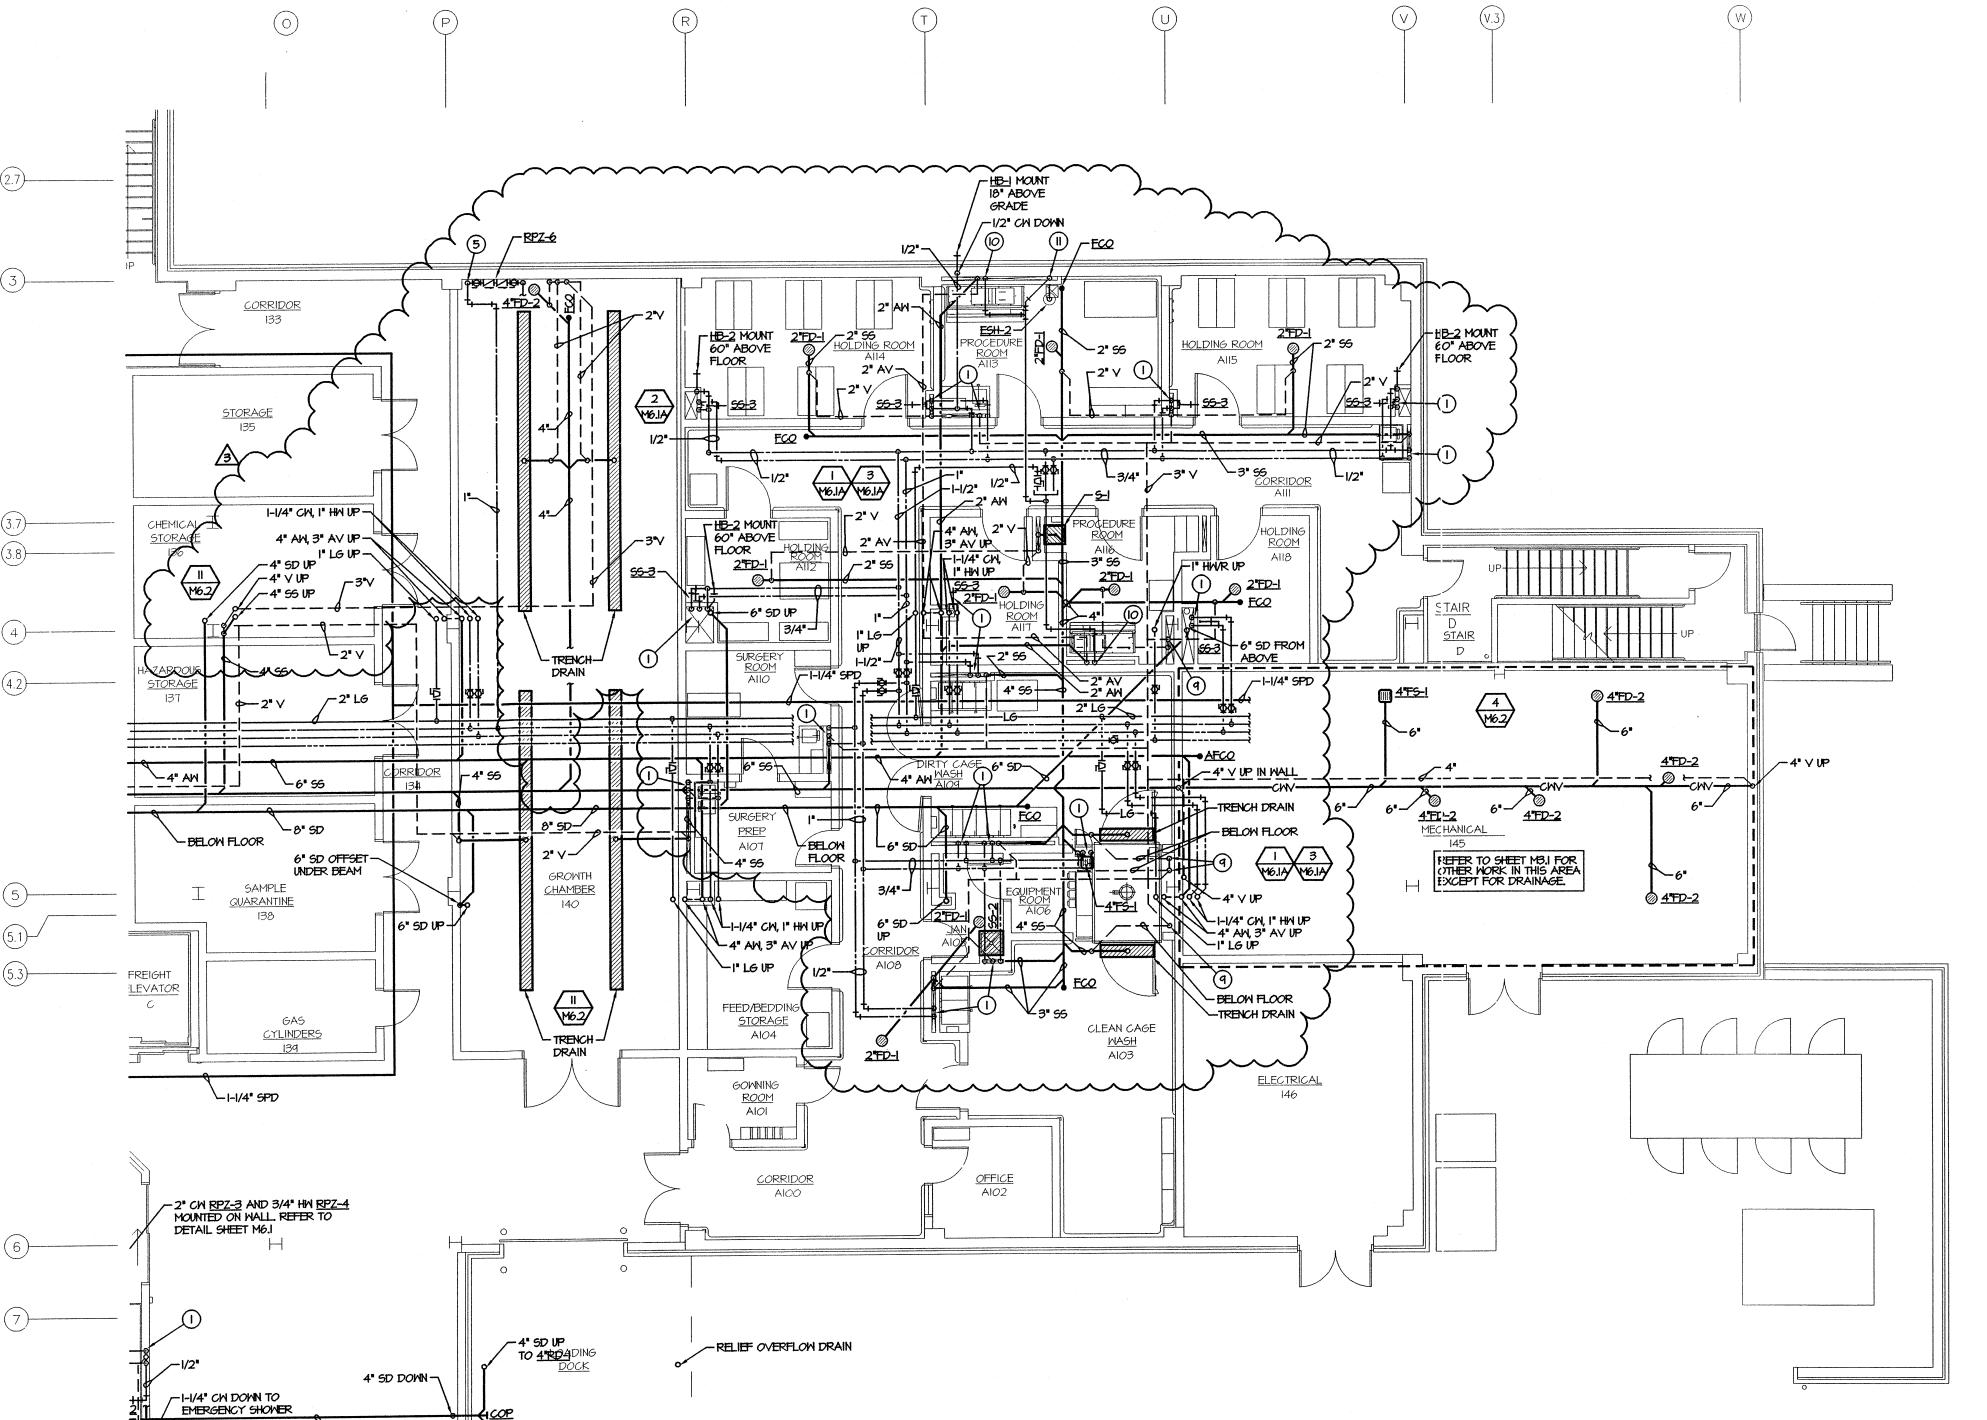

n first floor plan - plumbing

Consulting Engineers

a division of TME, Inc. 5800 EVERGREEN DRIVE, SUITE A LITTLE ROCK, ARKANSAS 72205-1757 Phone: (501) 666-6776 Fax: (501) 663-8888 tme@tmecorp.com





Commission Nur 10301

Date: October 1,




SCALE: 1/8" = 1'-0"

ARKANSAS

RECESTERED

PROPESSIONAL

ENGINEER

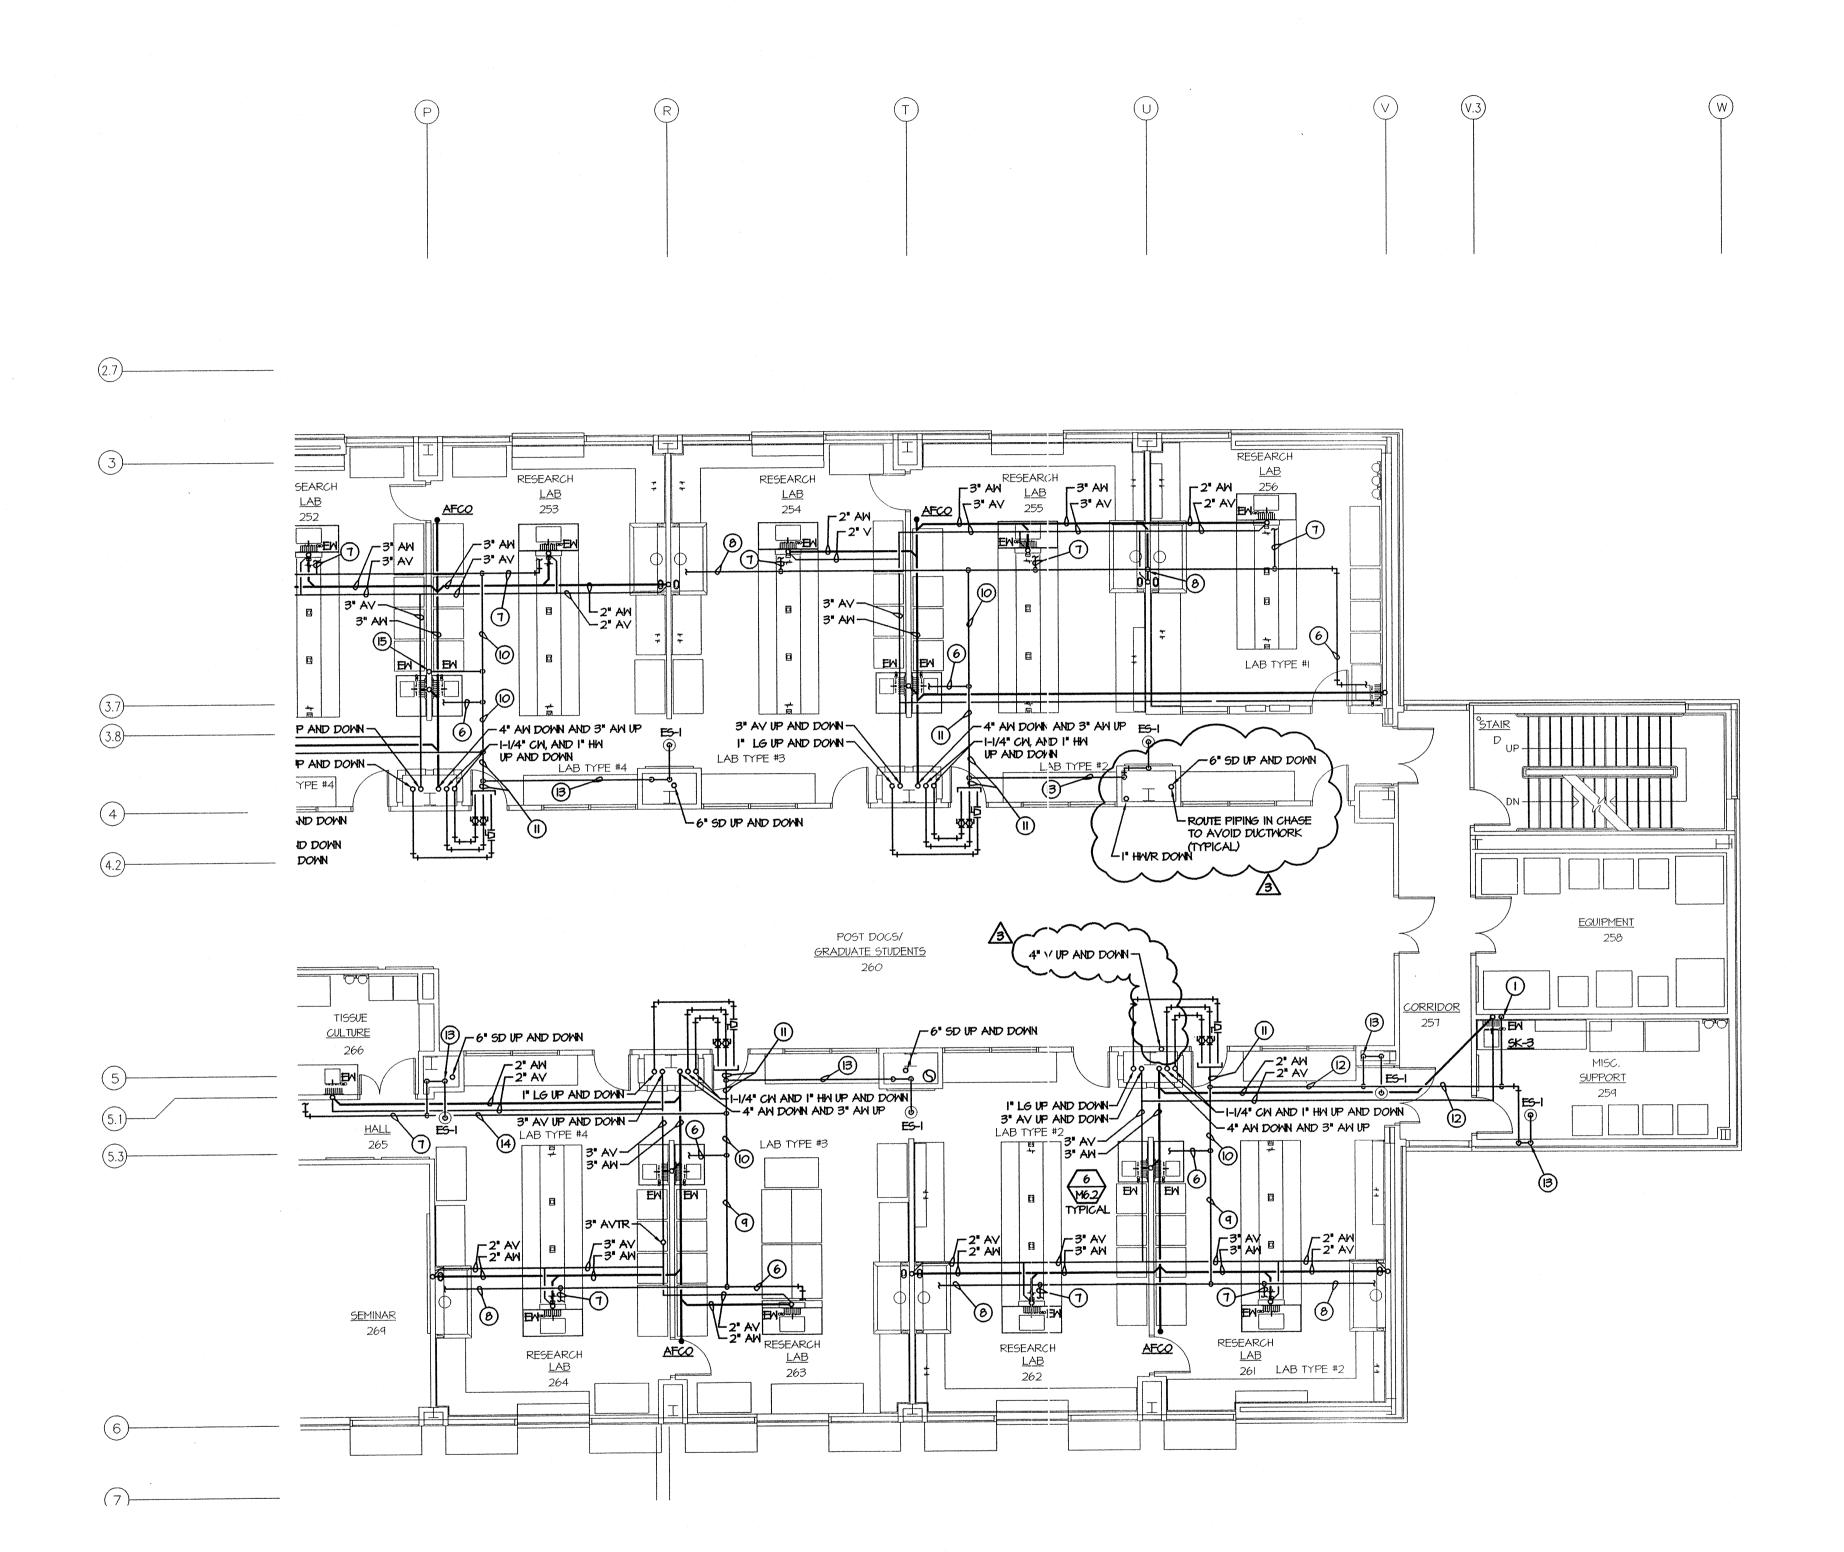



Commission Num 10301

Date: October 1, 2




ARKANSAS

REGISTERED

PROFESSIONAL

ENGINEER

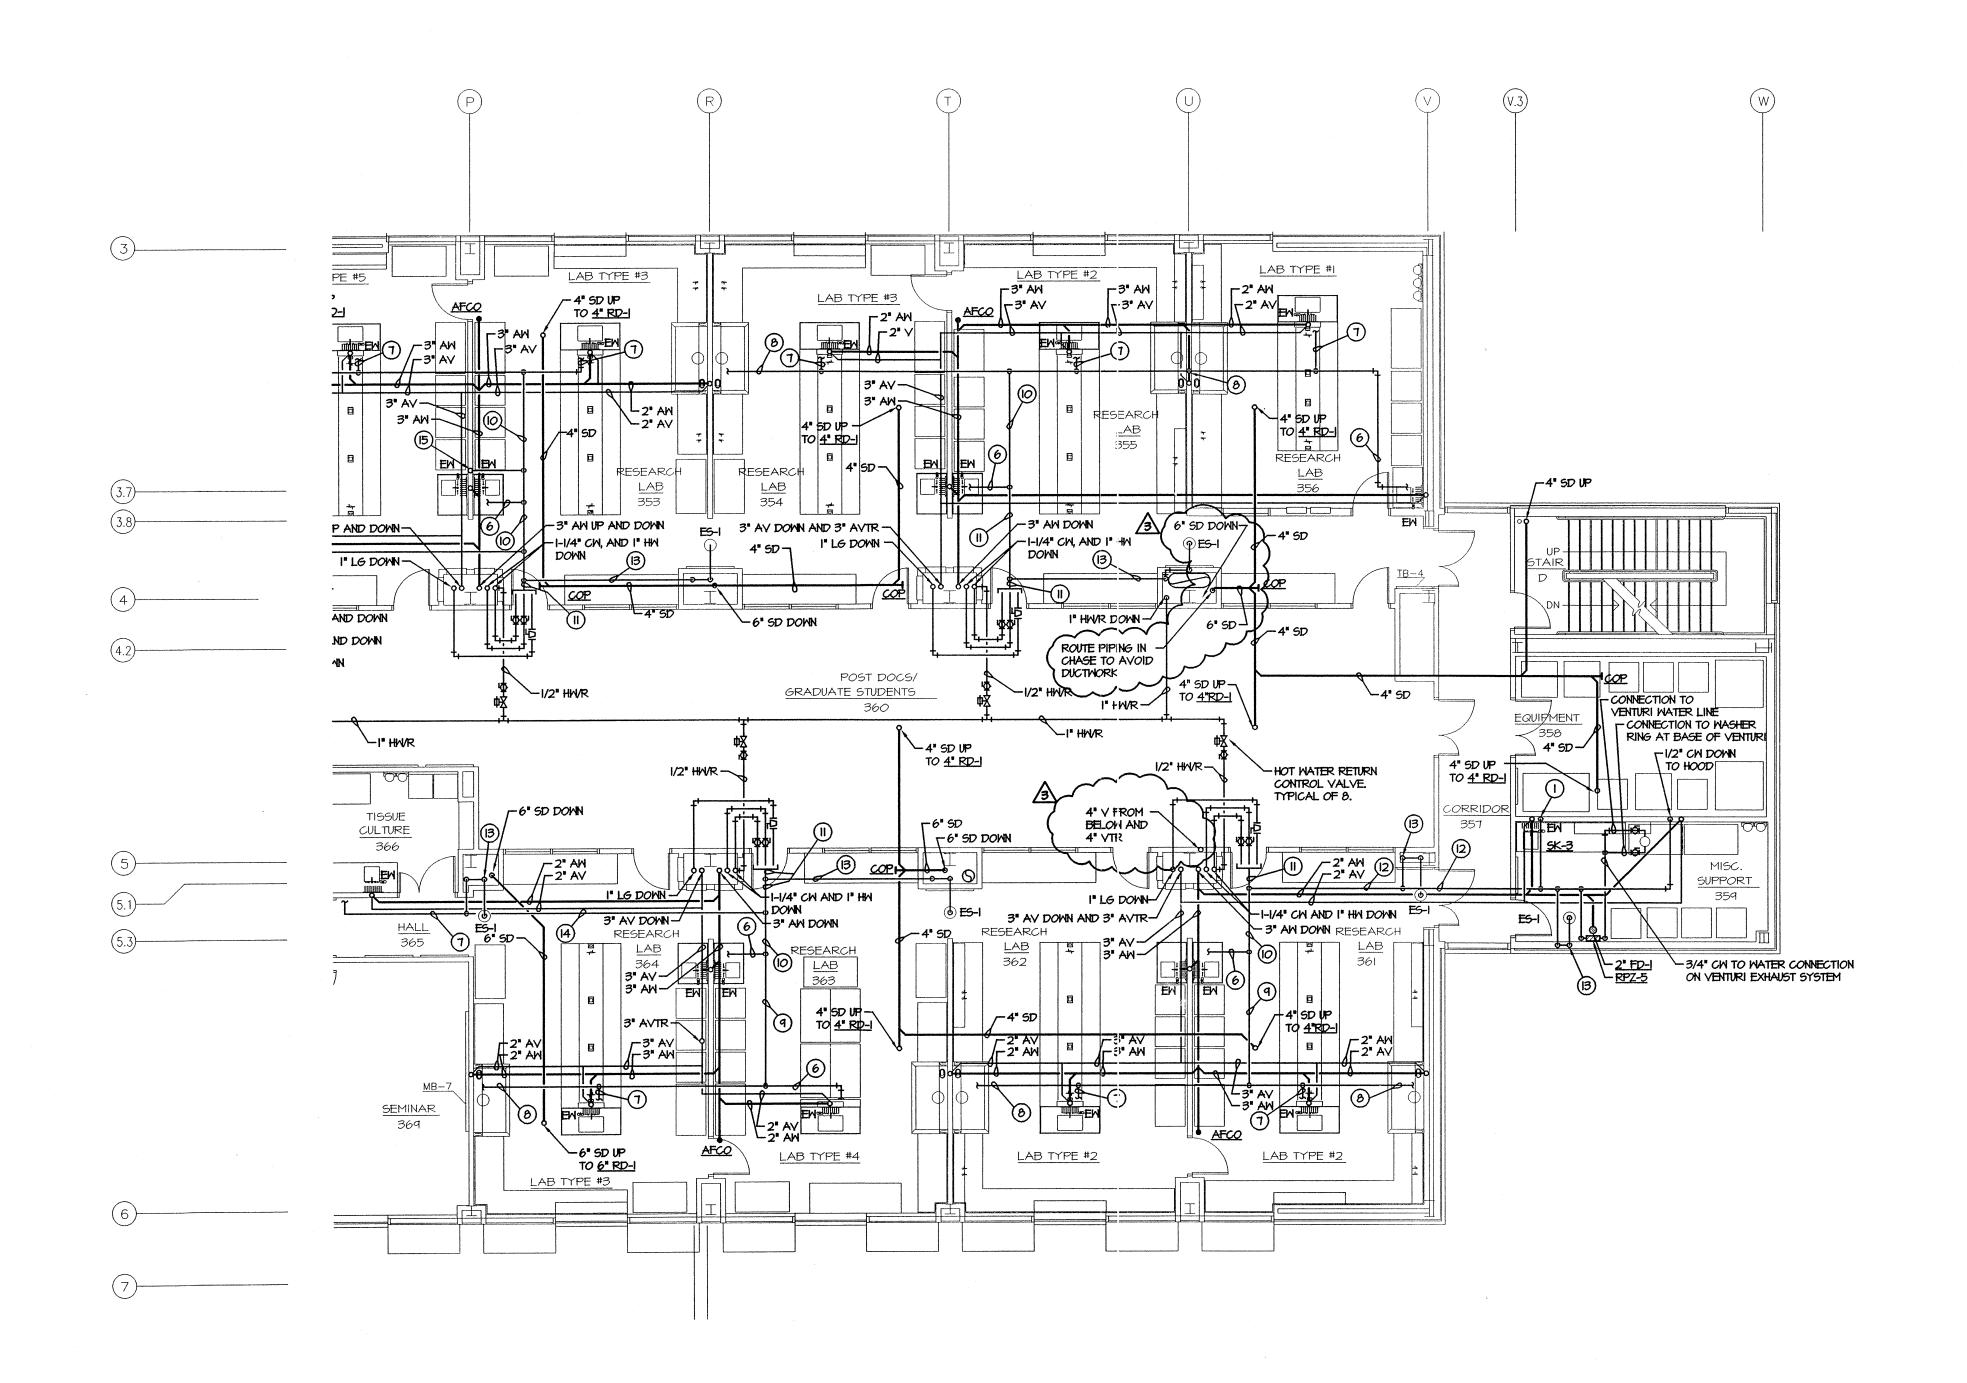






Commission Nur 10301

Date: October 1,



ARKANSAS
RECISTERED
PROPESSIONAL OF ENGINEER OF THE PROPESSION ALLO

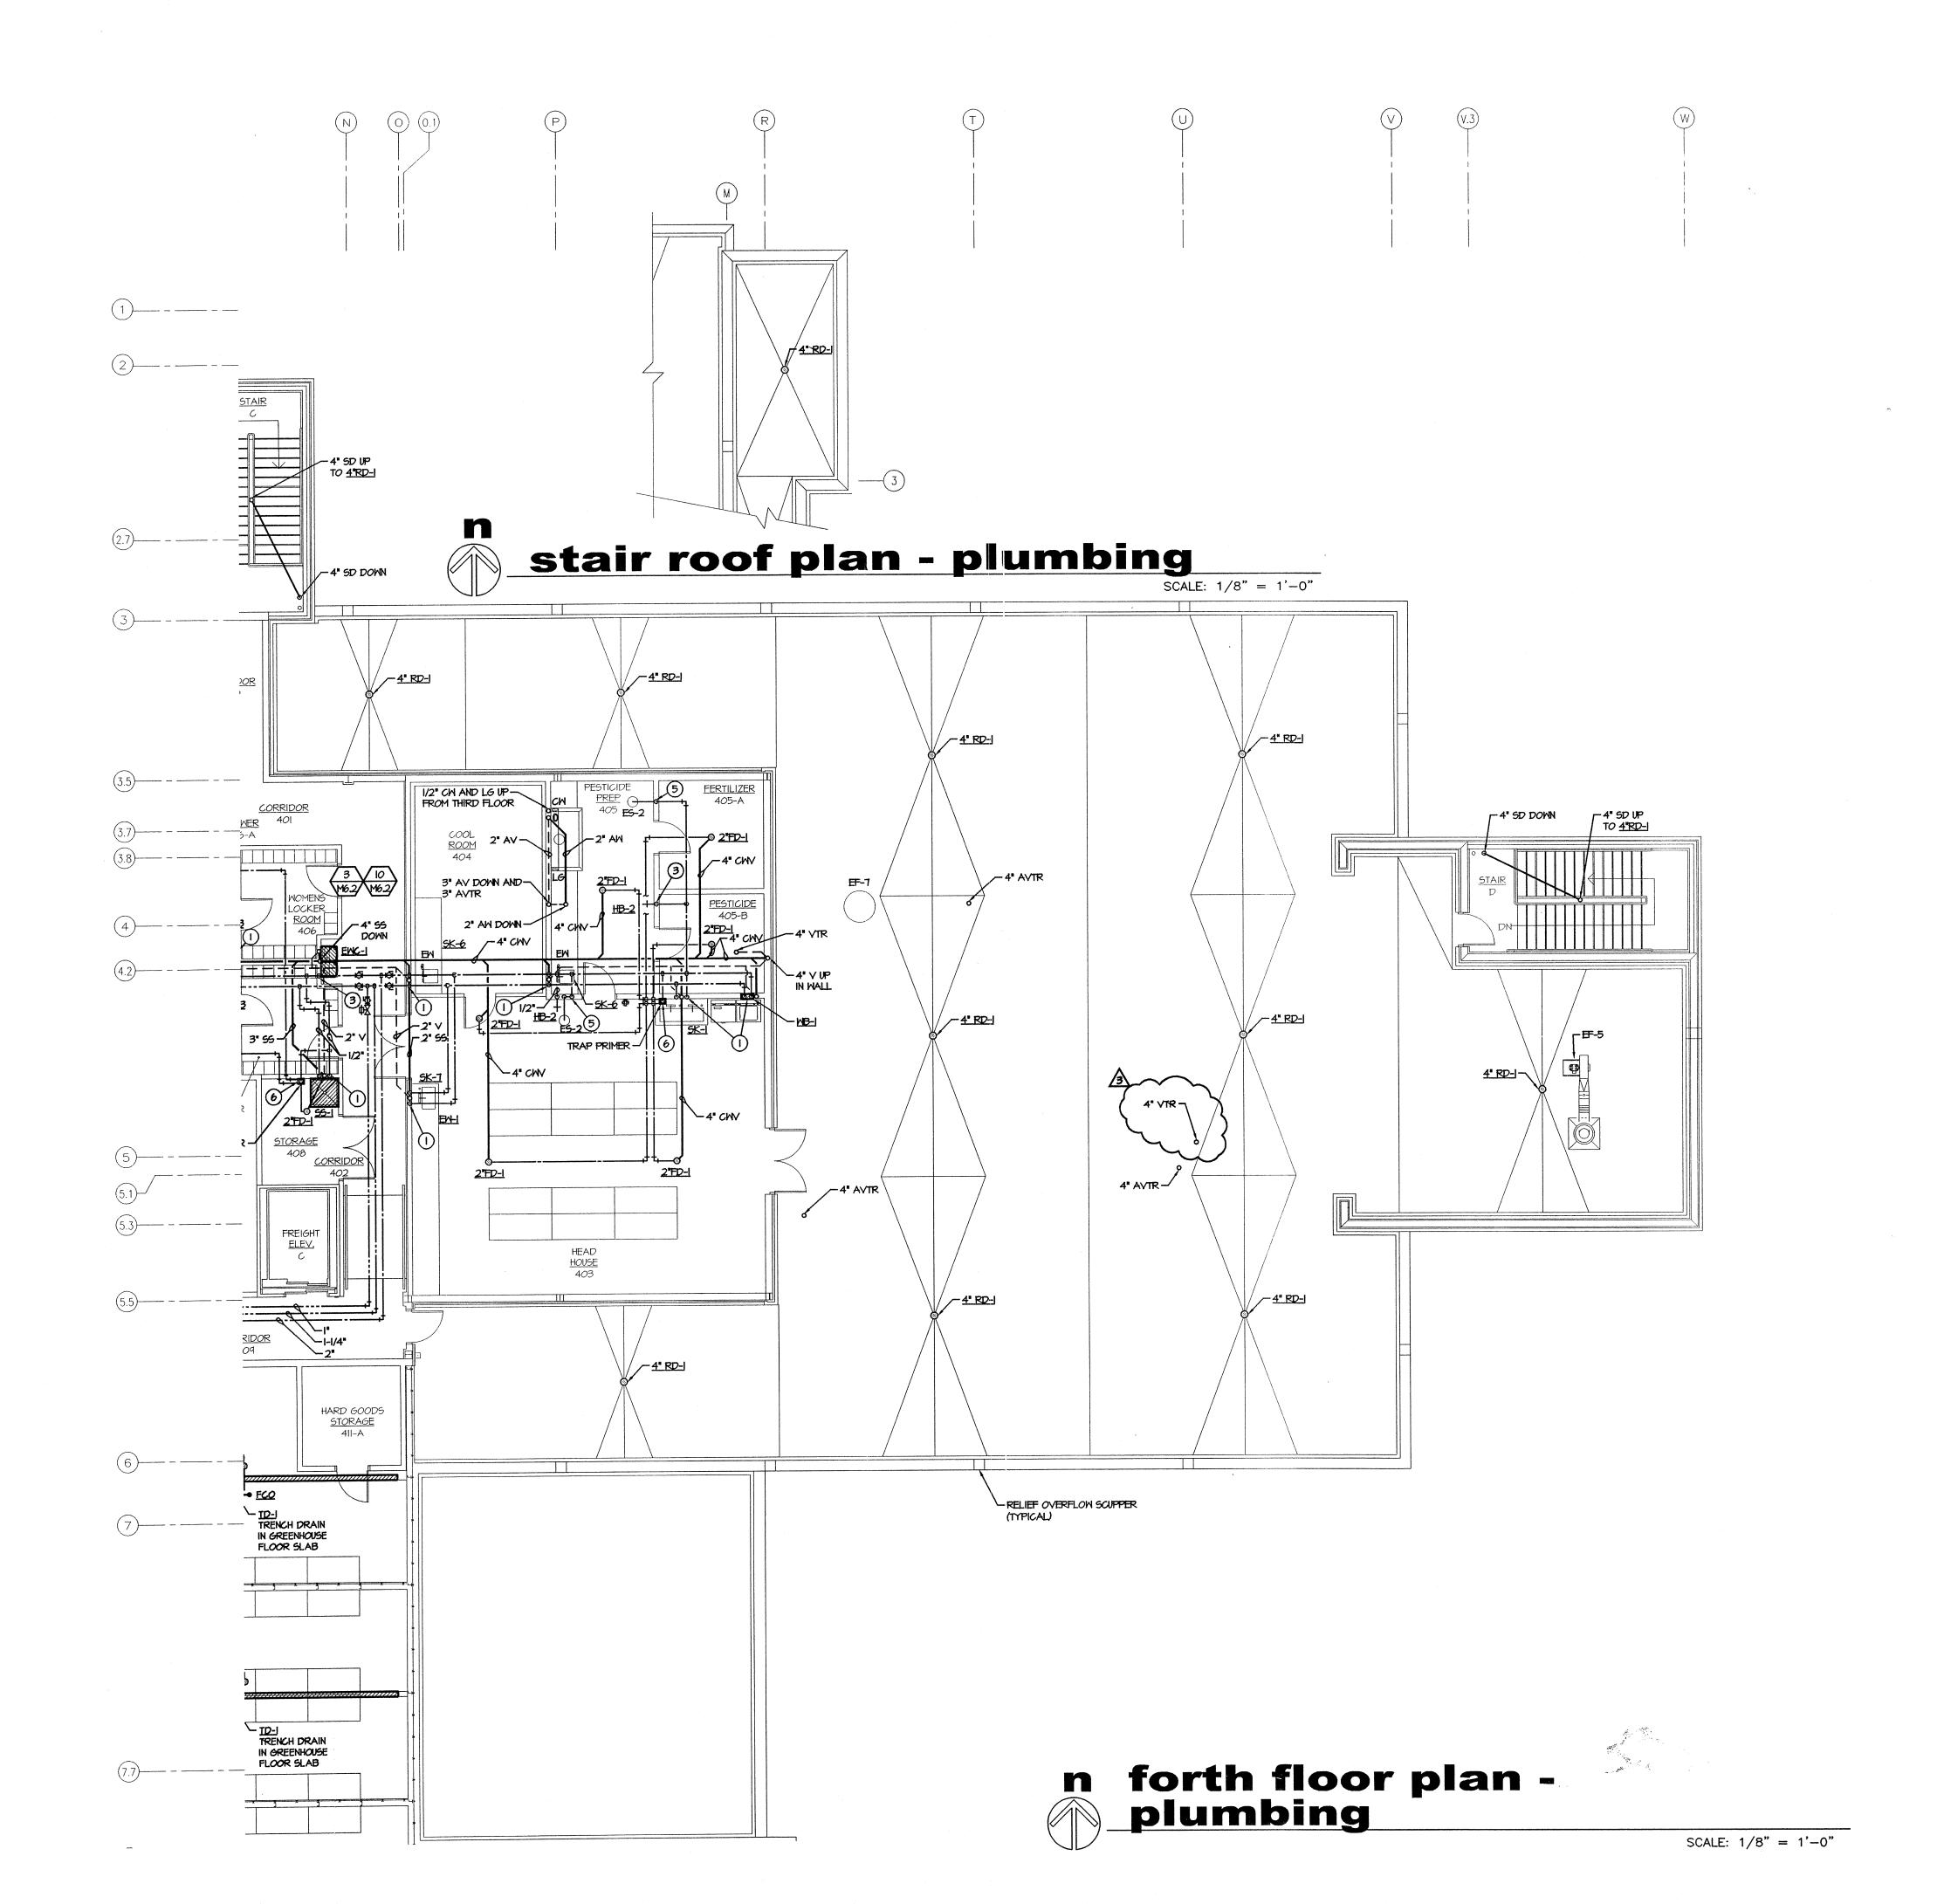

FIRST FLOOI PLAN - HVAO DUCTWORK


PROFESSIONALLY ENGINEERS

Commission Num

Date: October 1, 2



SCALE: 1/8" = 1'-0"

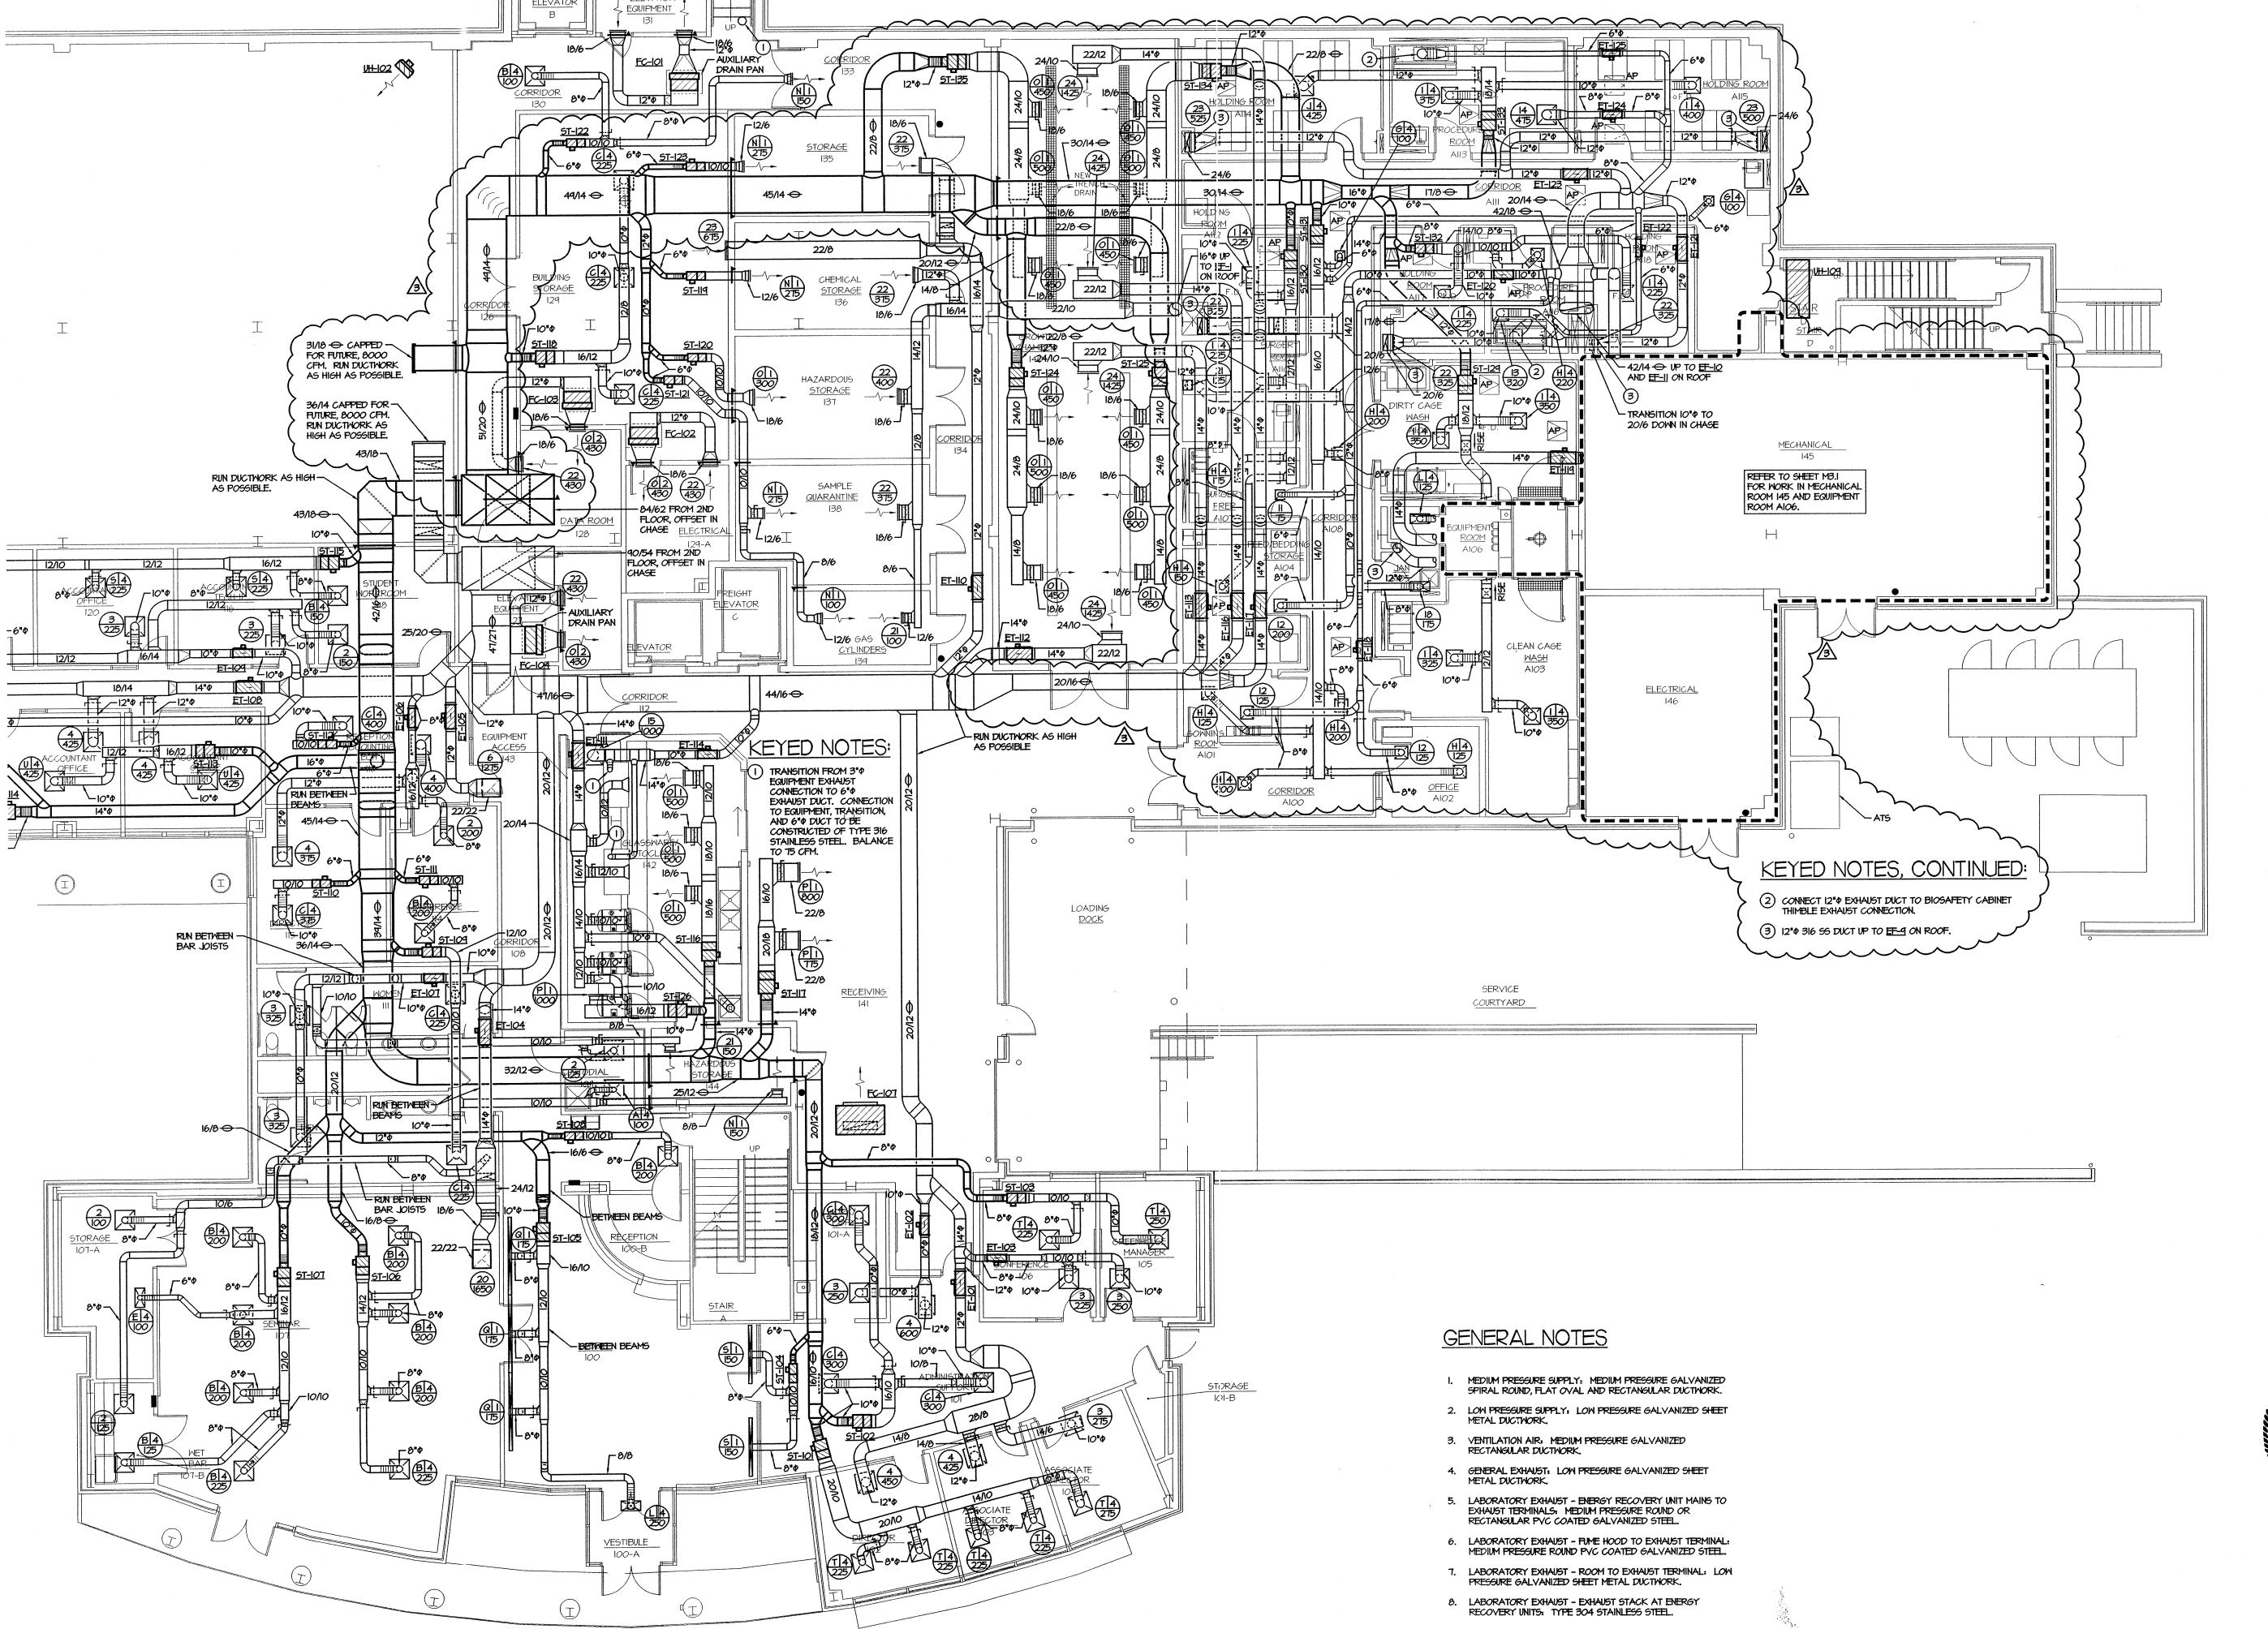

n first floor plan - HVAC

ductwork

SECOND FLOOR PLAN - HVAC DUCTWORK

Date: October 1, 2003

Commission Number 10301

Ilting Engineers
a division of TME, Inc.


PROFESSIONAL

3 OCTOBER 1, 2003



SCALE: 1/8" = 1'-0"

n second floor plan - HVAC ductwork

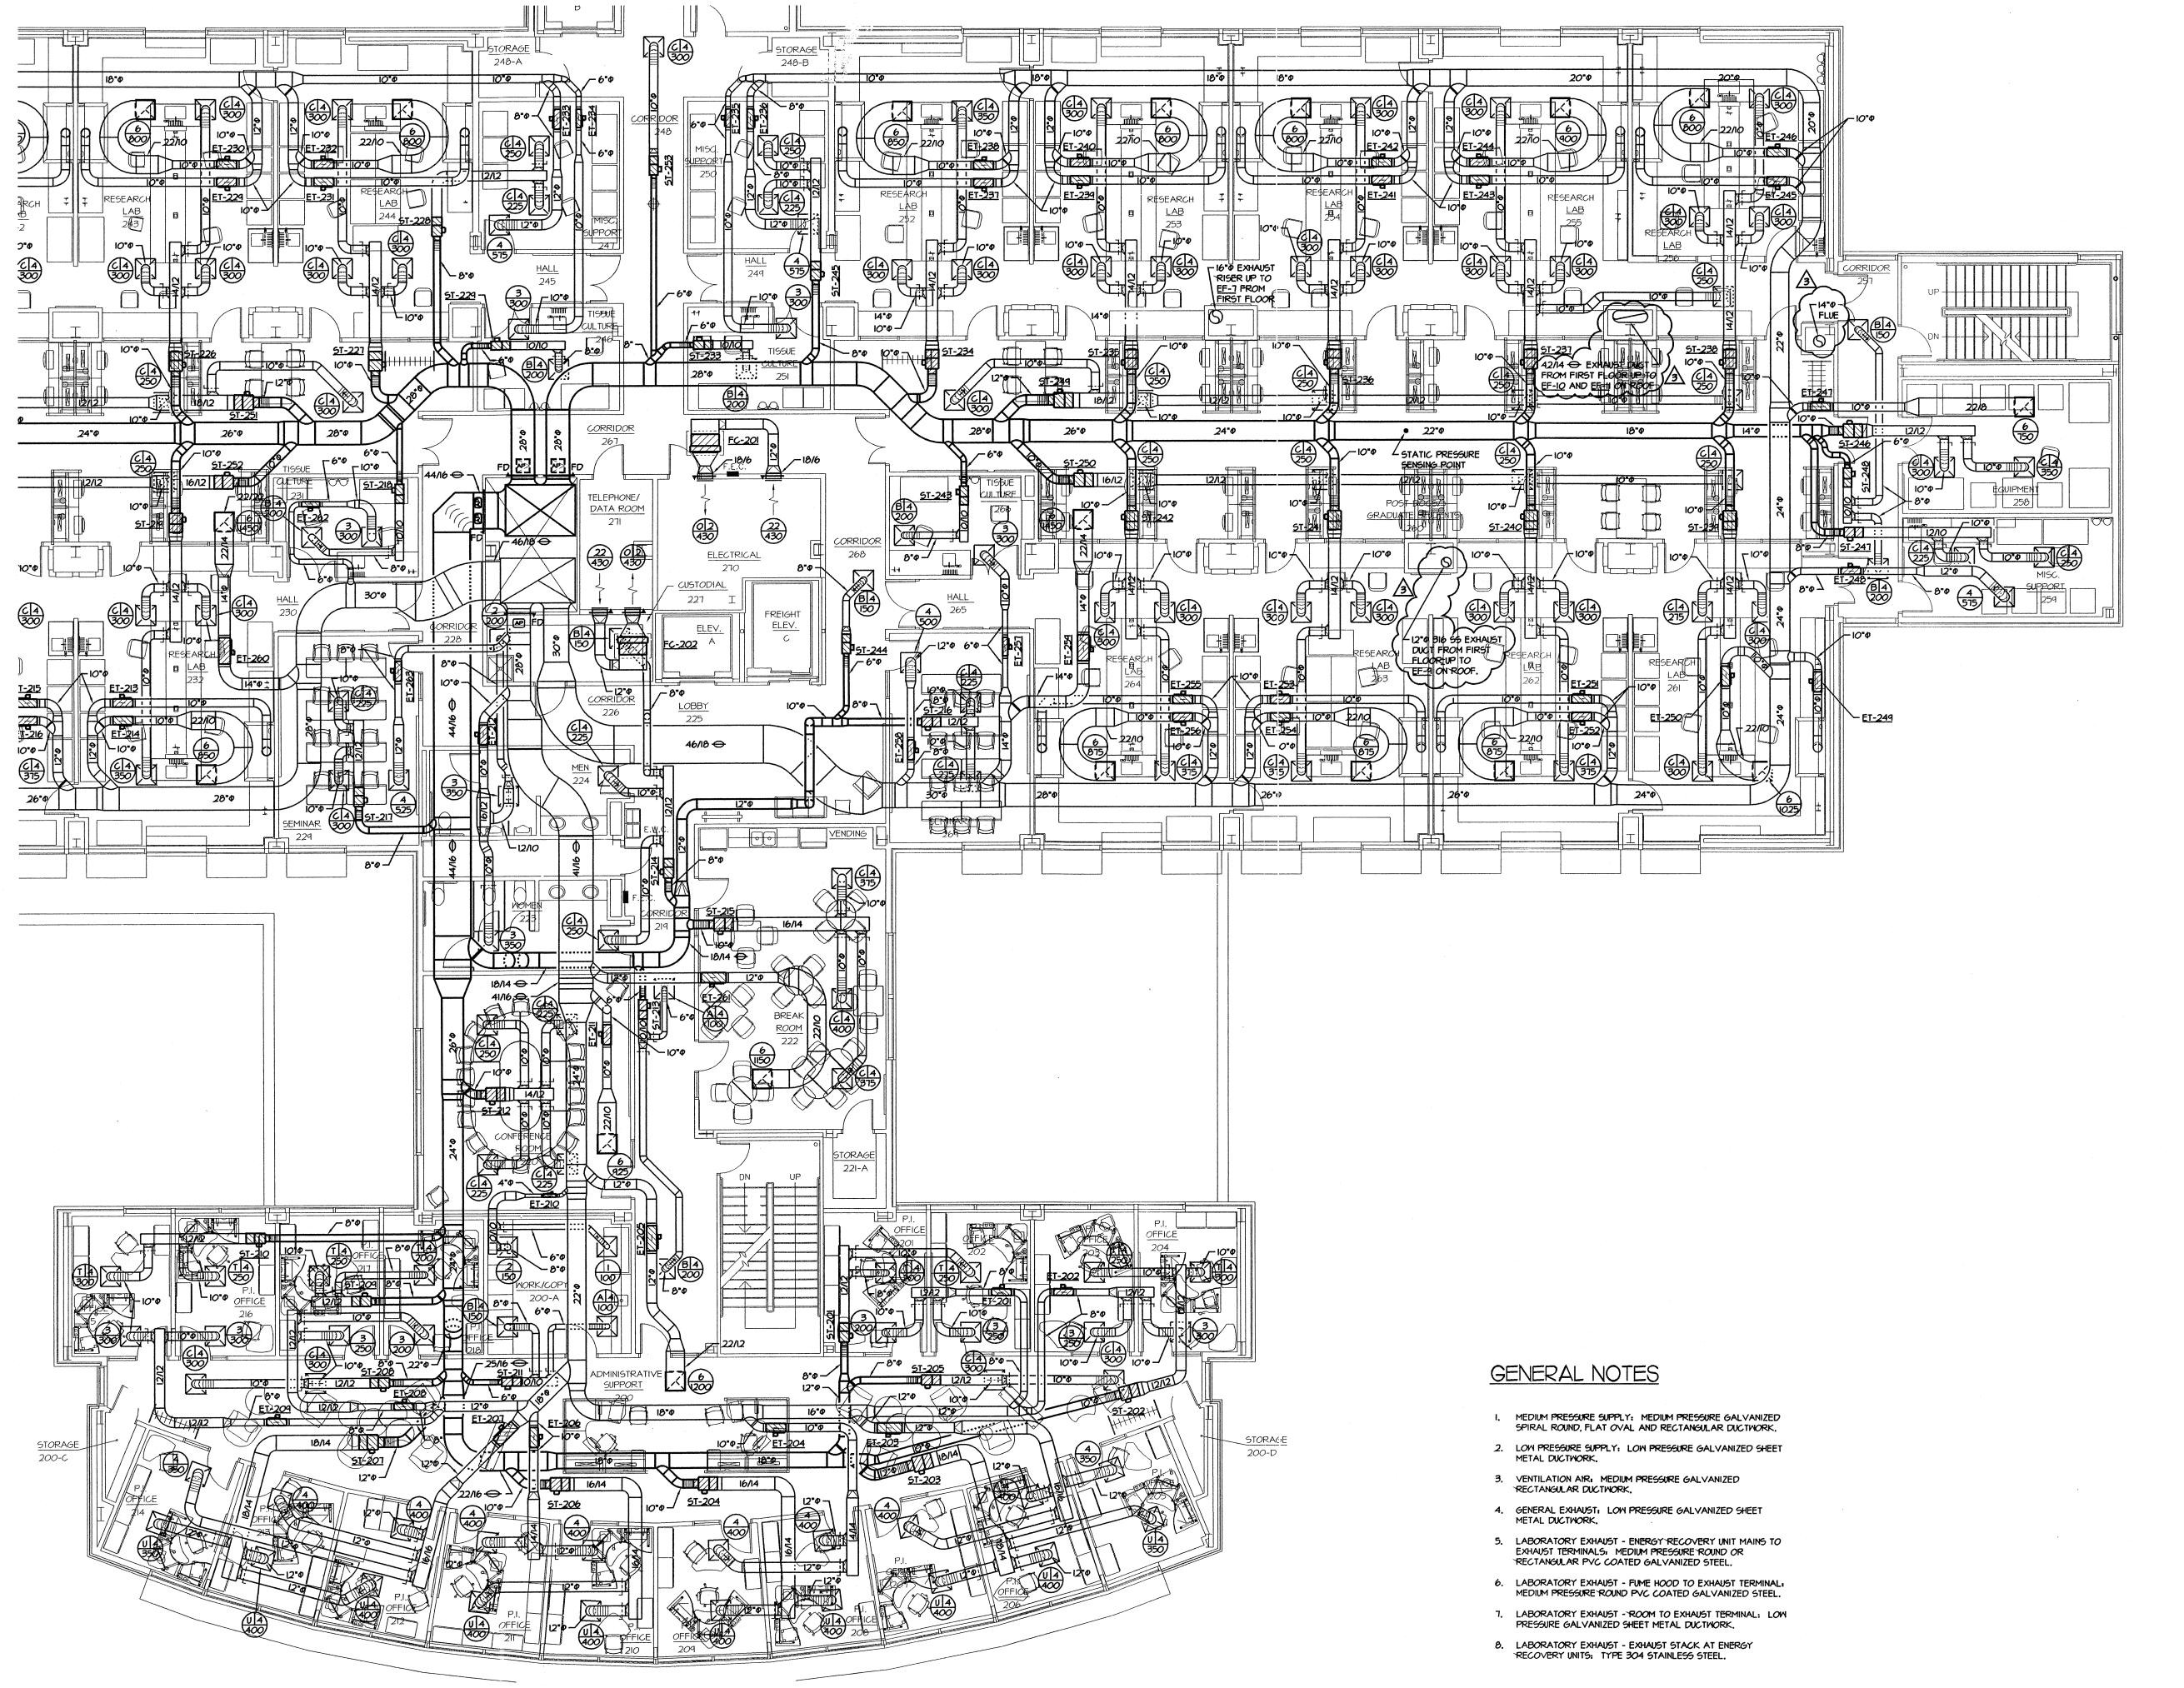

TME, INC. 178

THIRD FLOOR PLAN - HVAC DUCTWORK

Commission Number

Date: October 1, 2003


Consulting Engineers

5800 EVERGREEN DRIVE, SUITE A
LITTLE ROCK, ARKANSAS 72205-1757
Phone: (501) 666-6776 Fax: (501) 663-8988
tme@tmecorp.com

SCALE: 1/8" = 1'-0"

PROFESSIONAL

3 OCTOBER 1, 2003

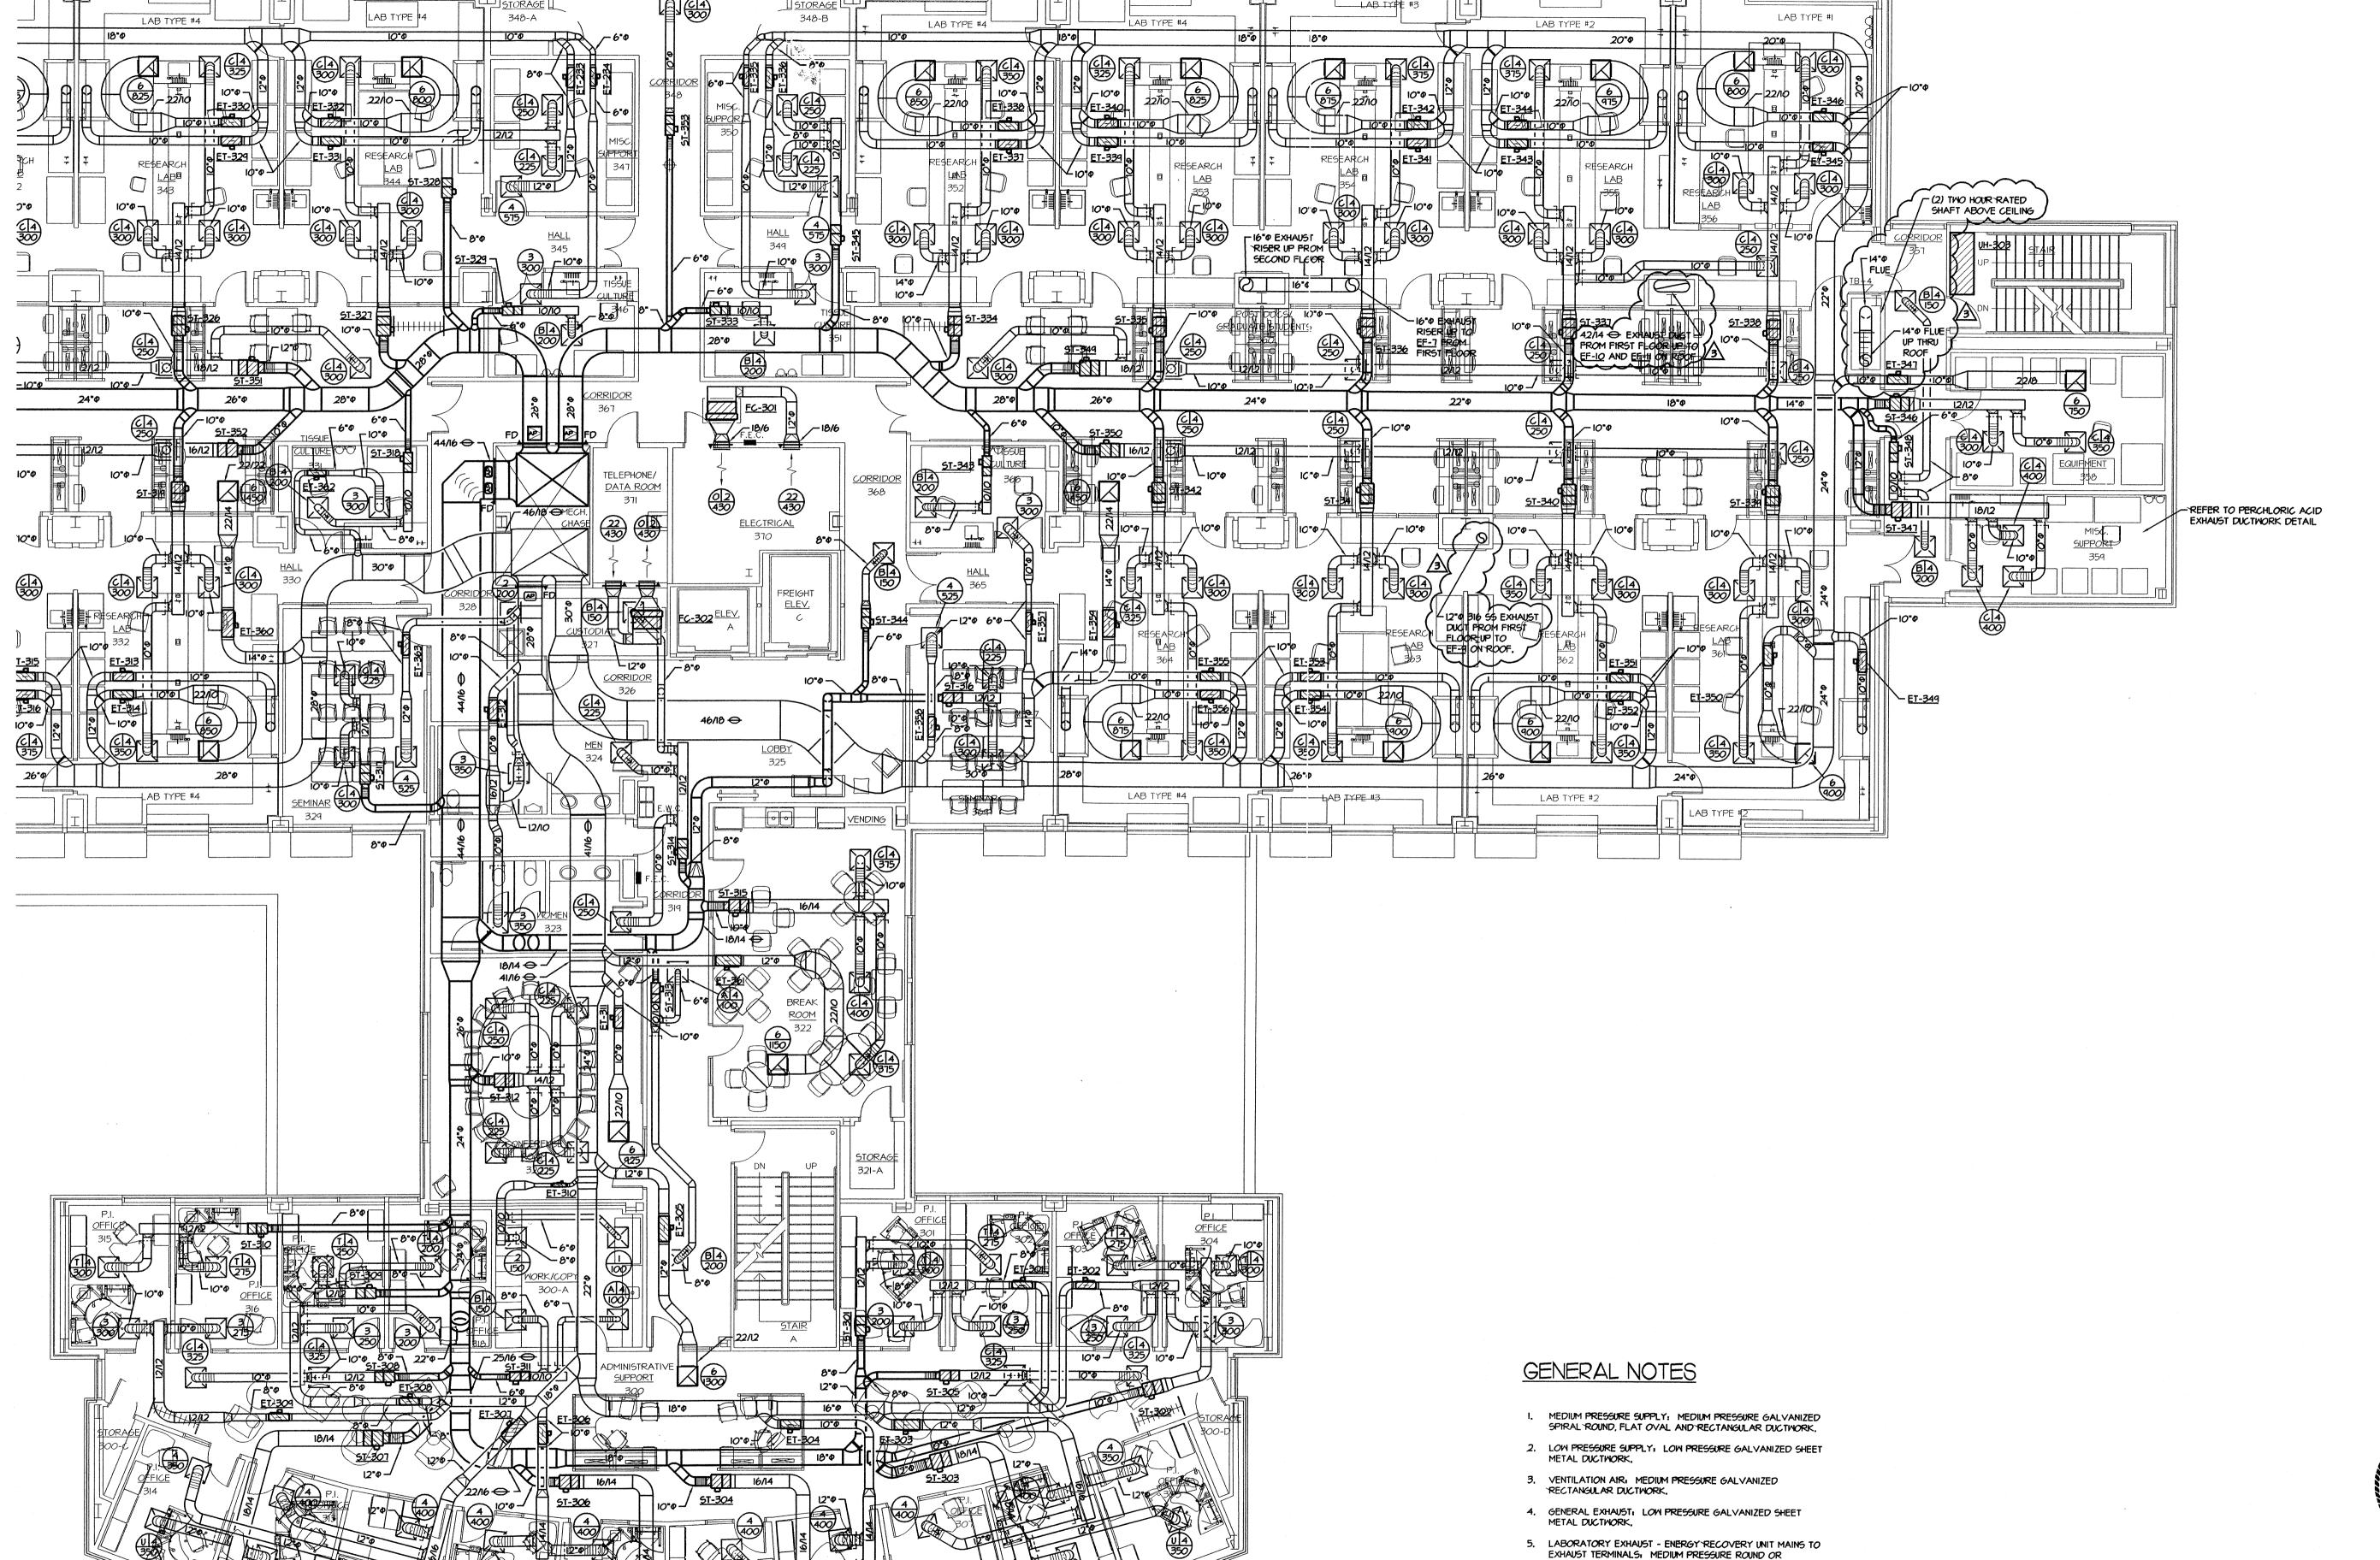

RECTANGULAR PVC COATED GALVANIZED STEEL.

6. LABORATORY EXHAUST - FUME HOOD TO EXHAUST TERMINAL:

7. LABORATORY EXHAUST - ROOM TO EXHAUST TERMINAL: LOW

PRESSURE GALVANIZED SHEET METAL DUCTWORK.

8. LABORATORY EXHAUST - EXHAUST STACK AT ENERGY RECOVERY UNITS: TYPE 304 STAINLESS STEEL.

n third floor plan - HVAC ductwork


MEDIUM PRESSURE ROUND PVC COATED GALVANIZED STEEL.



Commission Numb

M2.8

Date: October 1, 20

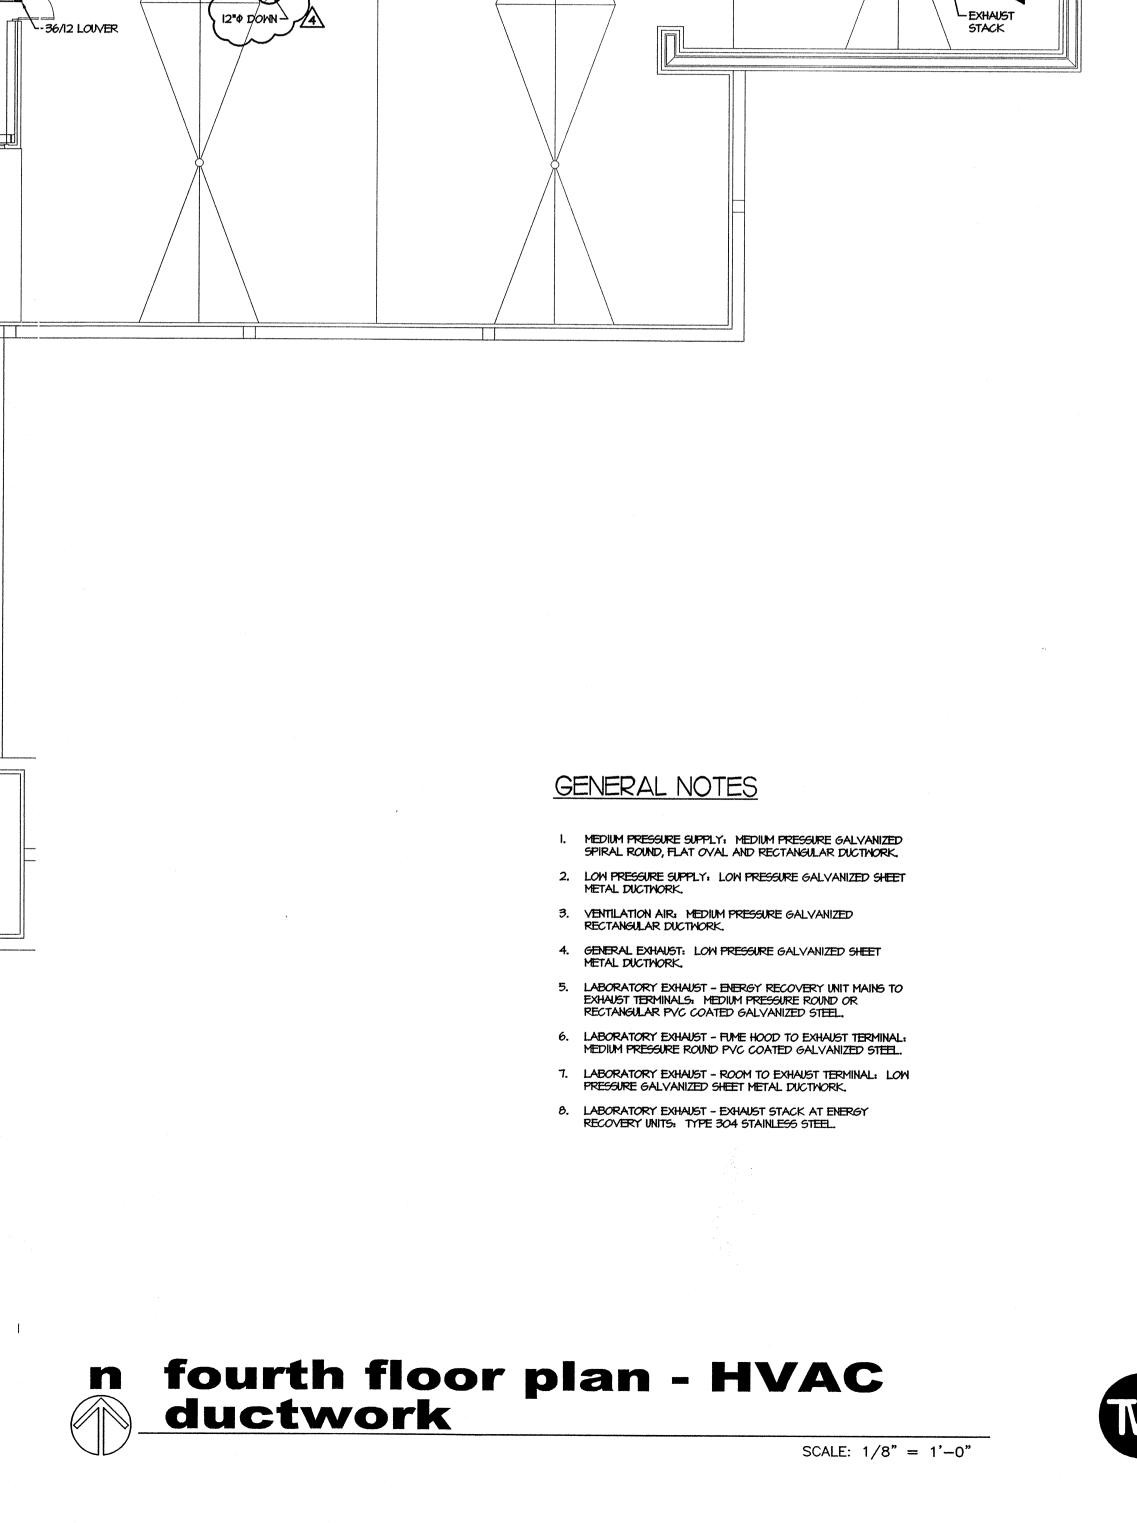

CONTROL DAMPER

EF-10

2**0**"Φ

MOUNT FANS <u>EF-IO</u> AND <u>EF-II</u> ON CURB SIMILAR TO <u>EF-5</u>

—14" PLUE MITH FLASHING, STORM COLLAR, AND RAIN CAP

> VENTURI DUCT -ON CURB BASE

14" O DOWN THRU -CURB TO LAB HOOD

TRANSITION 6 EXHAUST DUCT TO COOL ROOM EXHAUST CONNECTION.
BALANCE TO 35 CFM.

PESTICIDE

MECHANICAL

ELECTRICAL

36/12 ELEVATOR -SMOKE VENT CONTROL

> HARD GOODS STORAGE

> > UH-403

UH-404

FURNISHED AND INSTALLED BY THE GREENHOUSE CONTRACTOR, TYP. 4

GREENHOUSE -CONTROLLER

HOUSE

MECHANICAL

REFER TO SHEET M3.2 FOR MORK IN THIS AREA

- TRANSITION 6" PUPPLY DUCT TO COOL ROOM DEHUNIDIFIER VENTILATION CONNECTION. BALANCE TO 35 CFM.

36/120

I HOUR CEILINGS

DRYER VENT CAP


ARKANSAS
REGISTERED
PROFESSIONALO

△ OCTOBER I, 2003

Commission Number 10301

Date: October 1, 200



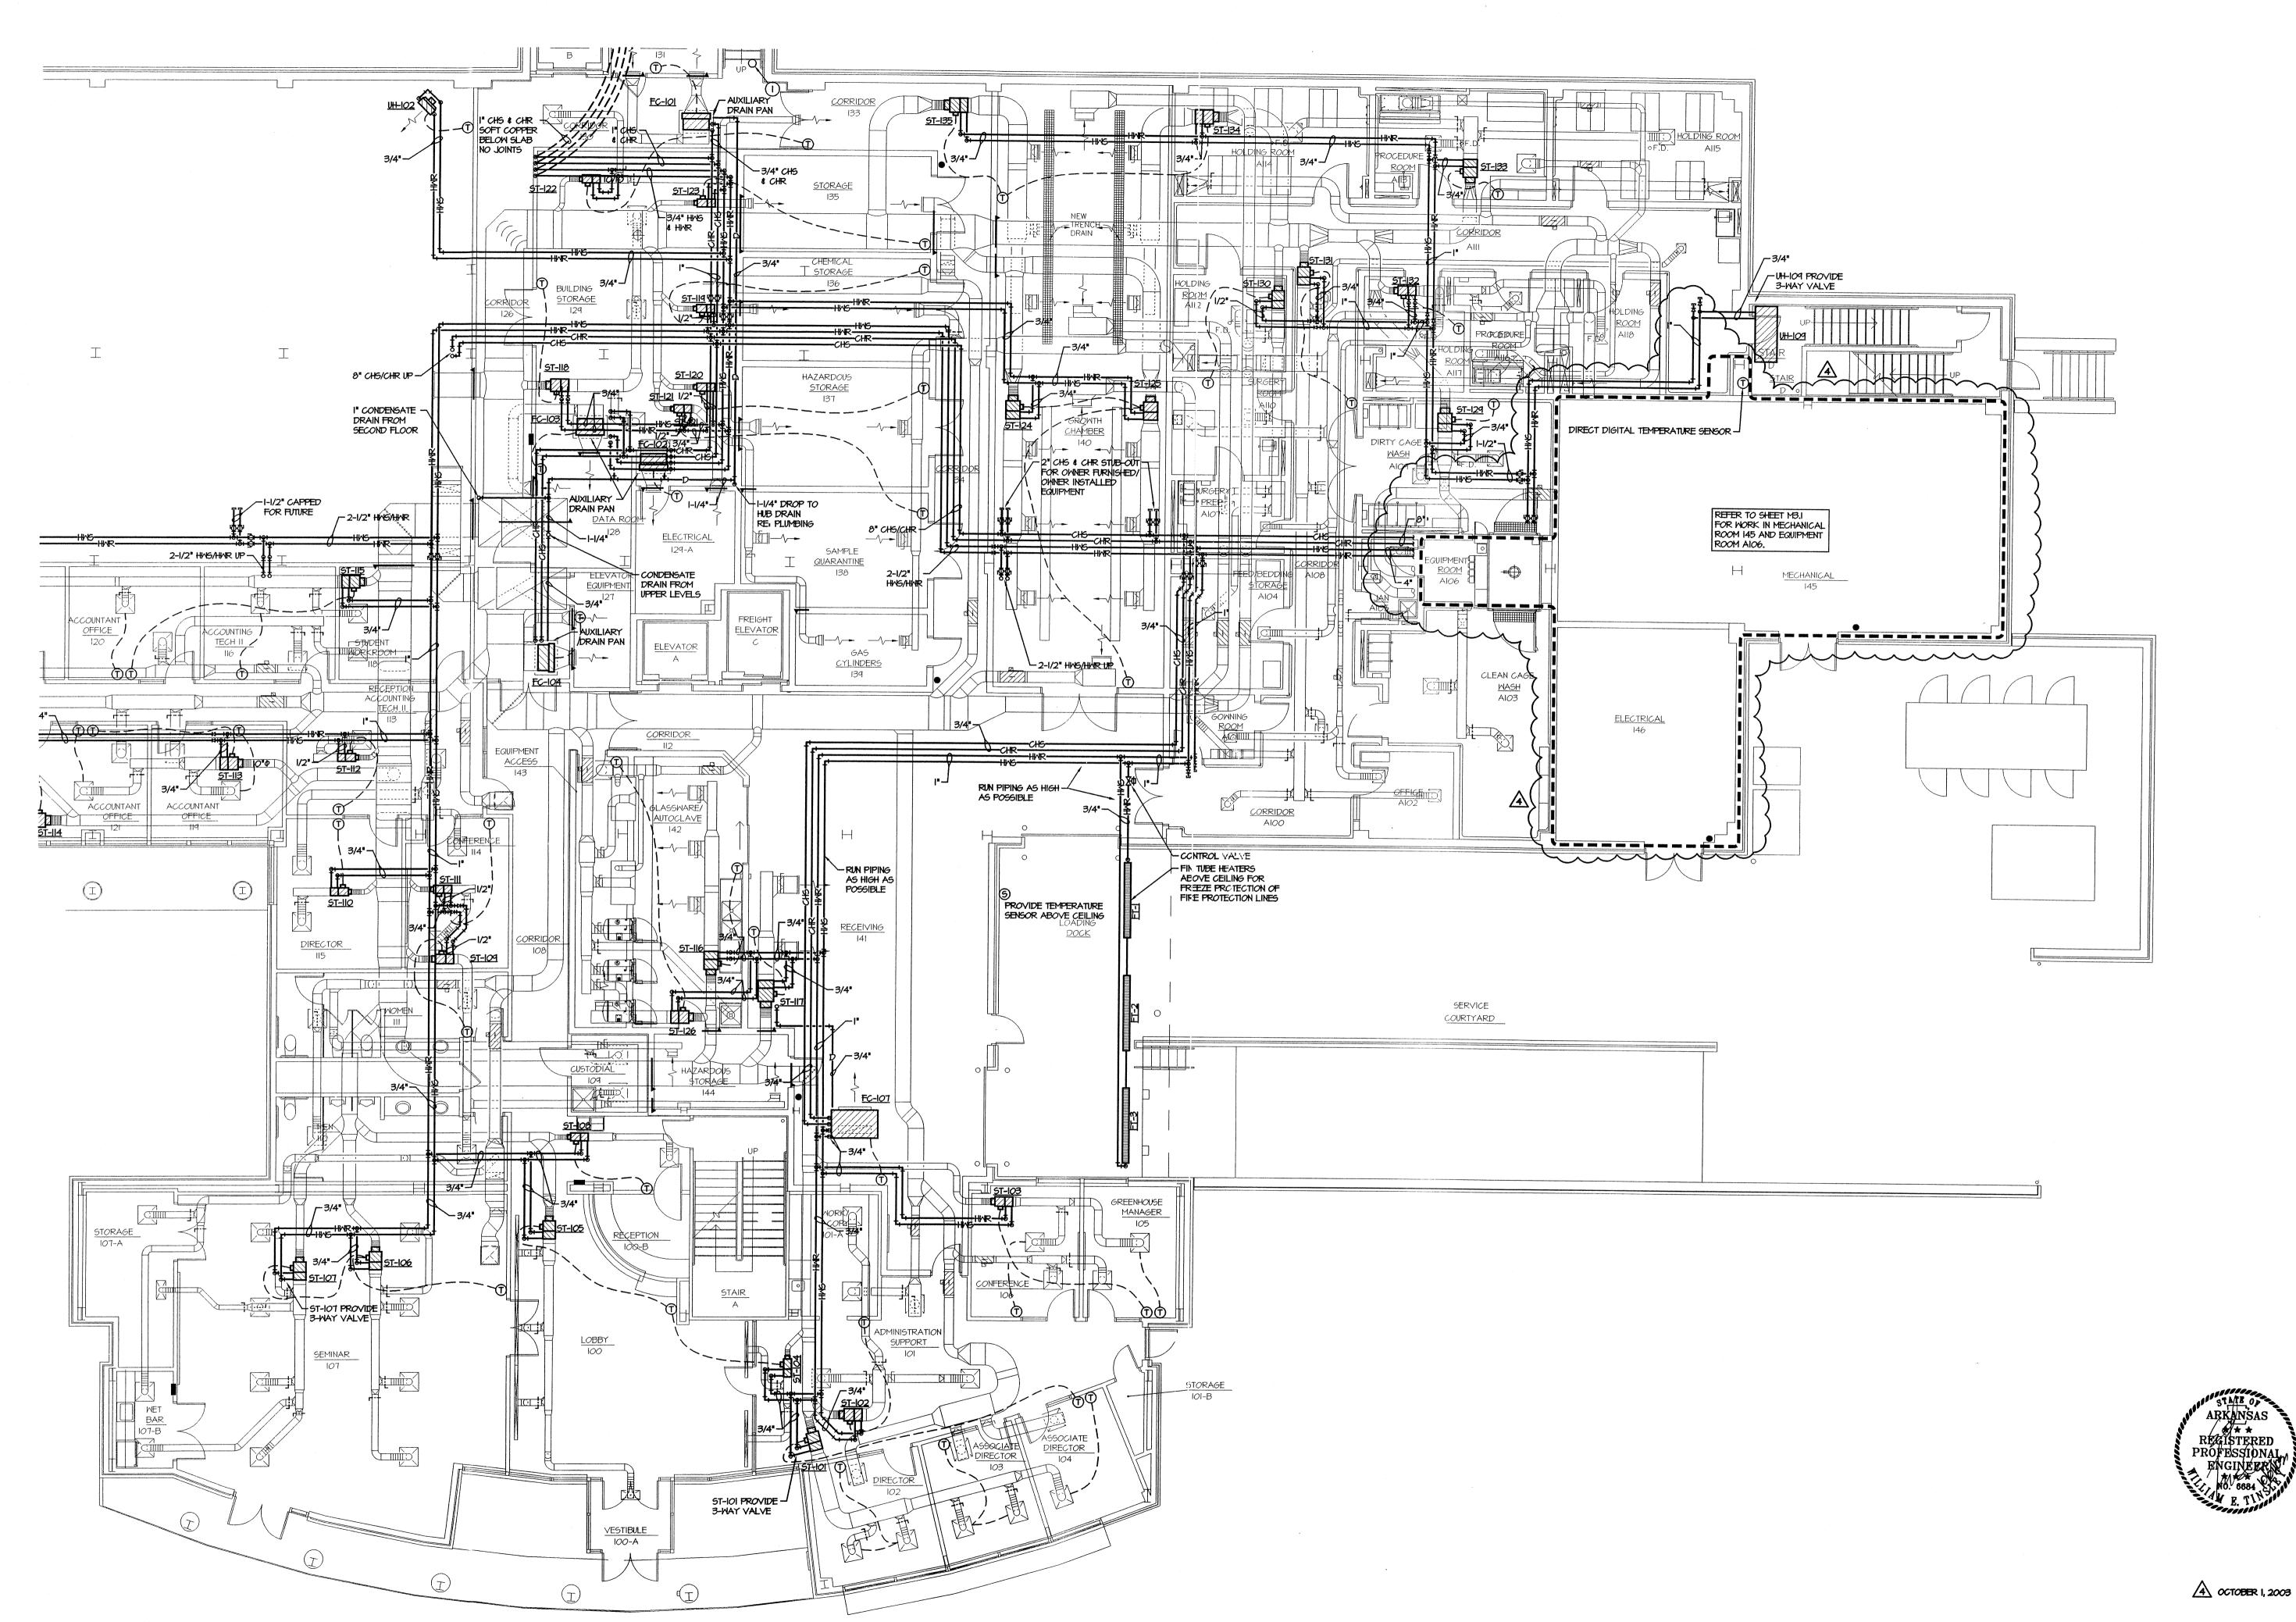

n first floor plan - HVAC
piping

SCALE: 1/8" = 1'-0"


SECOND FLOO PLAN - HVAO PIPING

Commission Num Consulting Engineers
5800 EVERGREEN DRIVE, SUITE A
LITTLE ROCK, ARKANSAS 72205-1757
Phone: (501) 668-6776 Fax: (501) 663-8888 Date: October 1,

<u>∕2</u> остовек I, 2003



FUME HOOD CONTROLLER

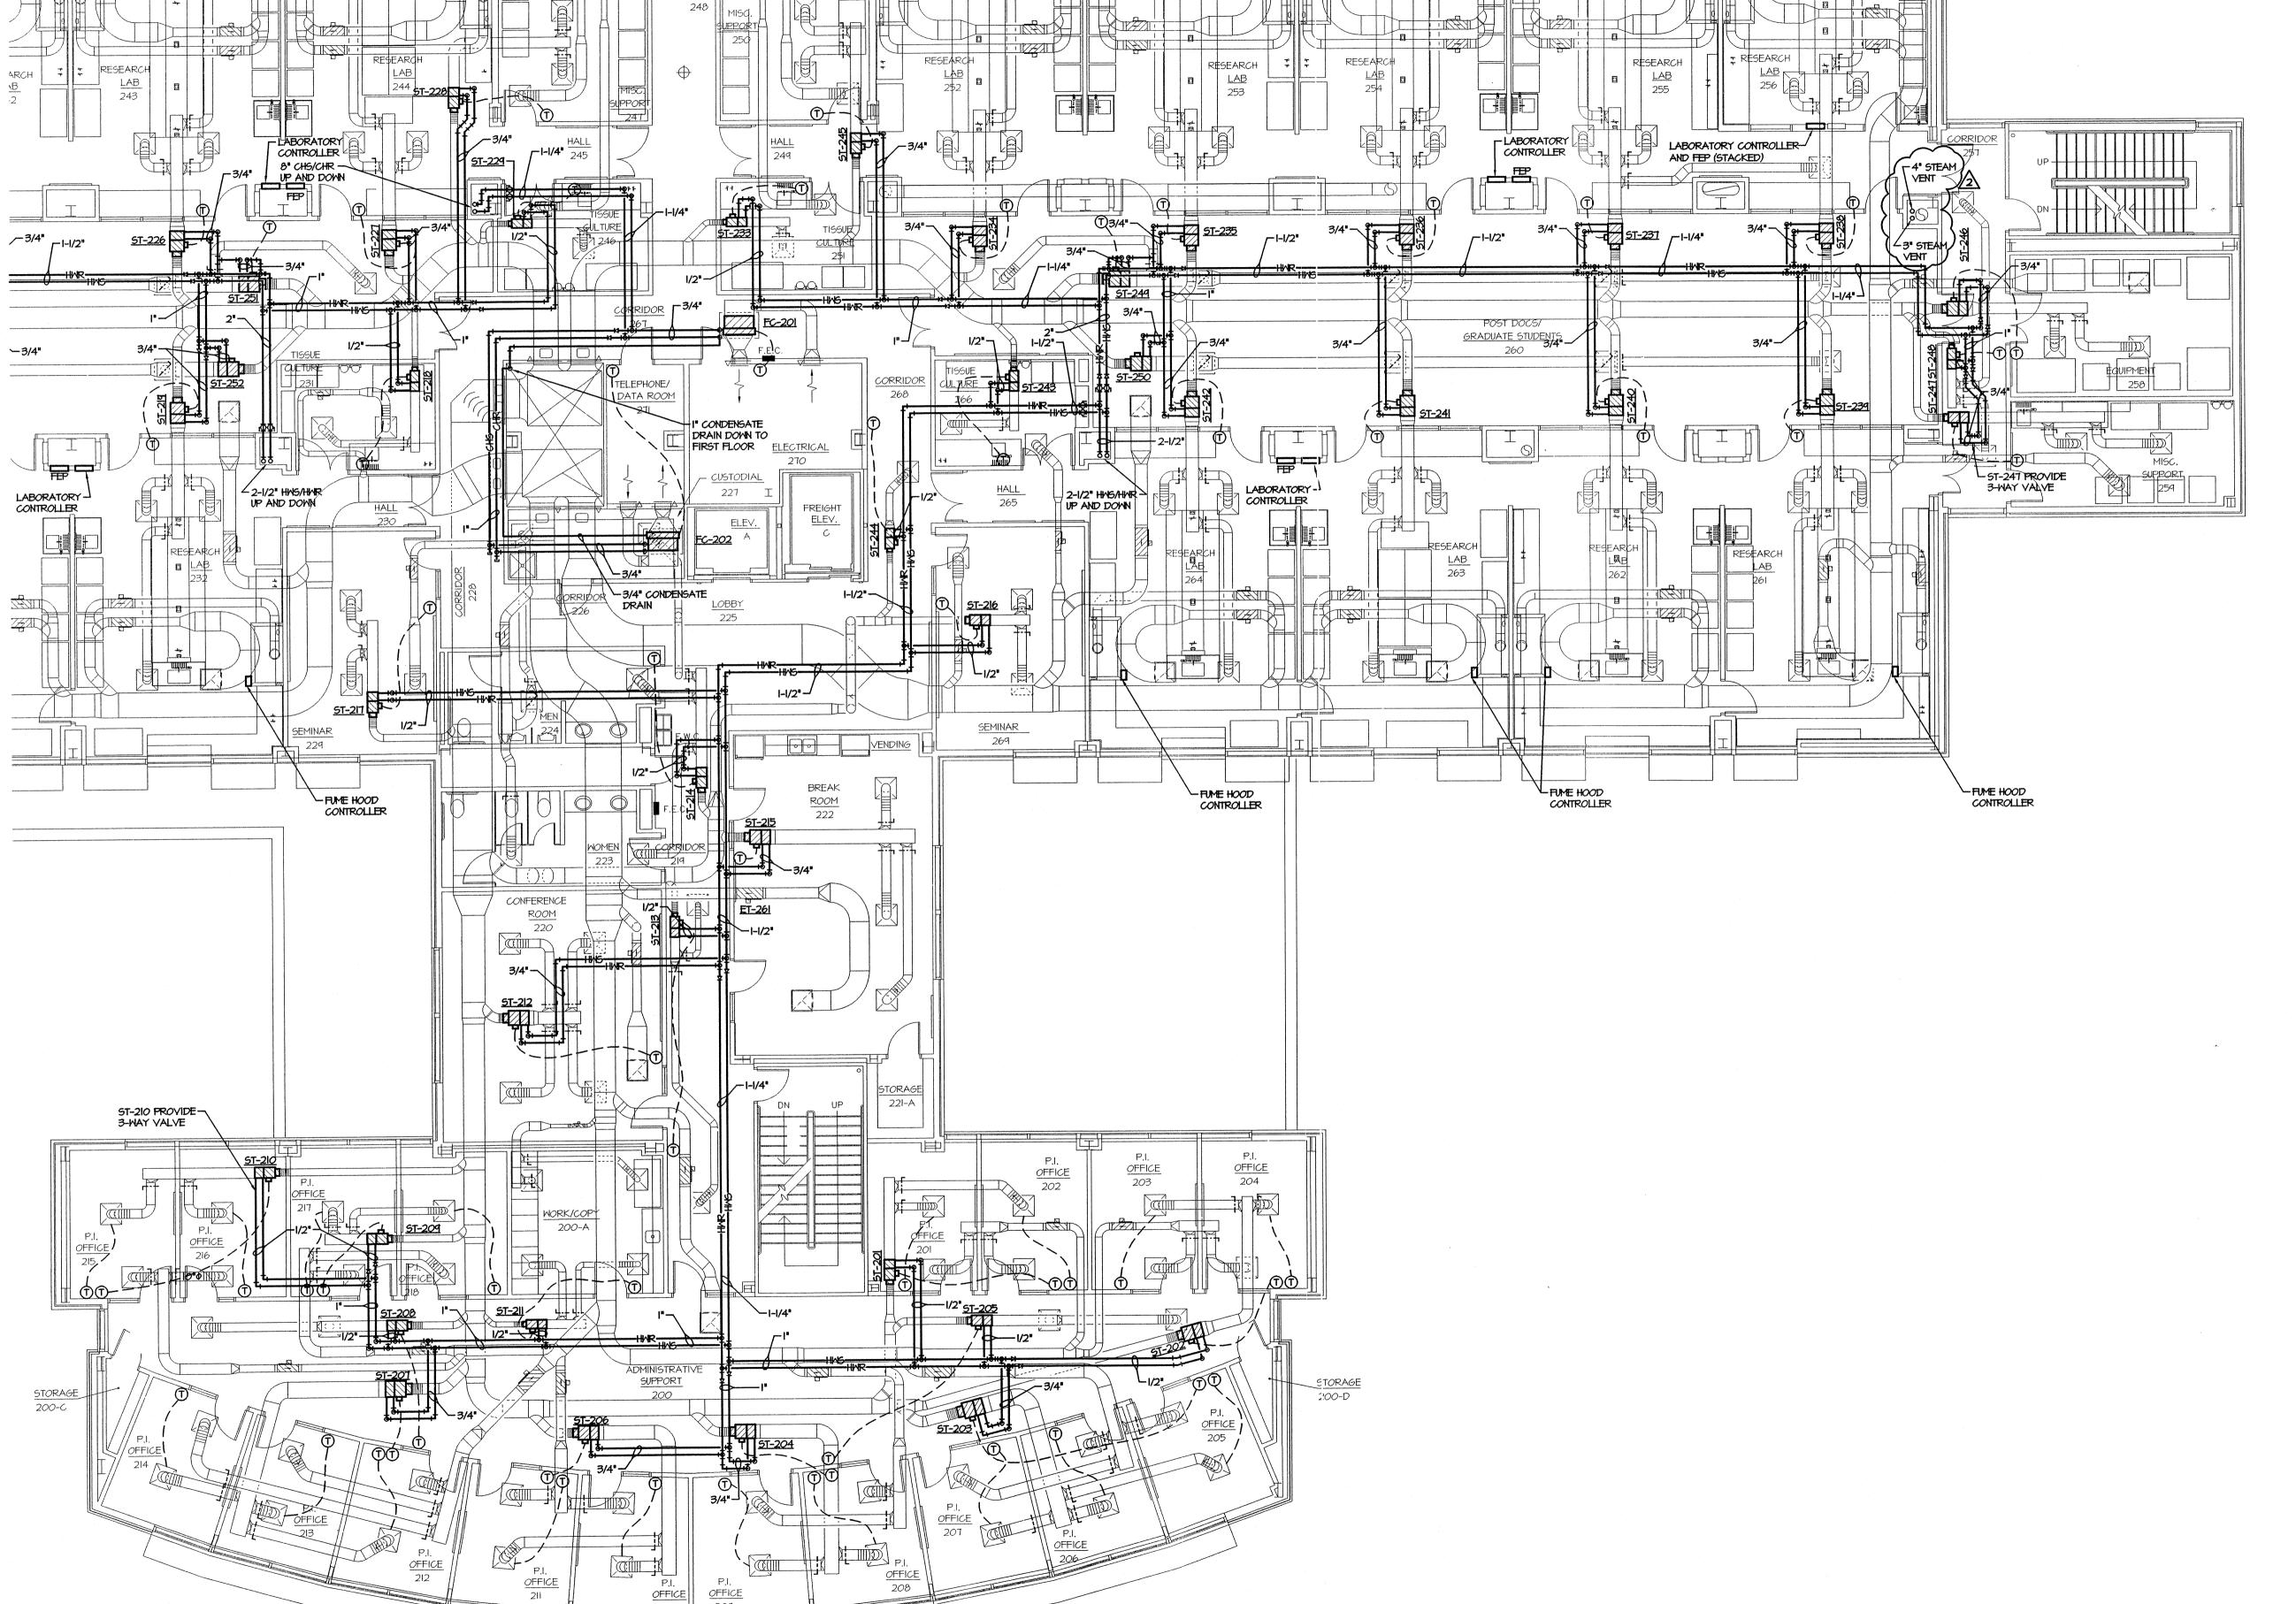

FUME HOOD CONTROLLER

248-B

FUME HOOD CONTROLLER

STORAGE 248-A

FUME HOOD CONTROLLER


THIRD FLOO PLAN - HVAO PIPING

Commission Number 10301 M2.17

Date: October 1,



△ 2003 2003

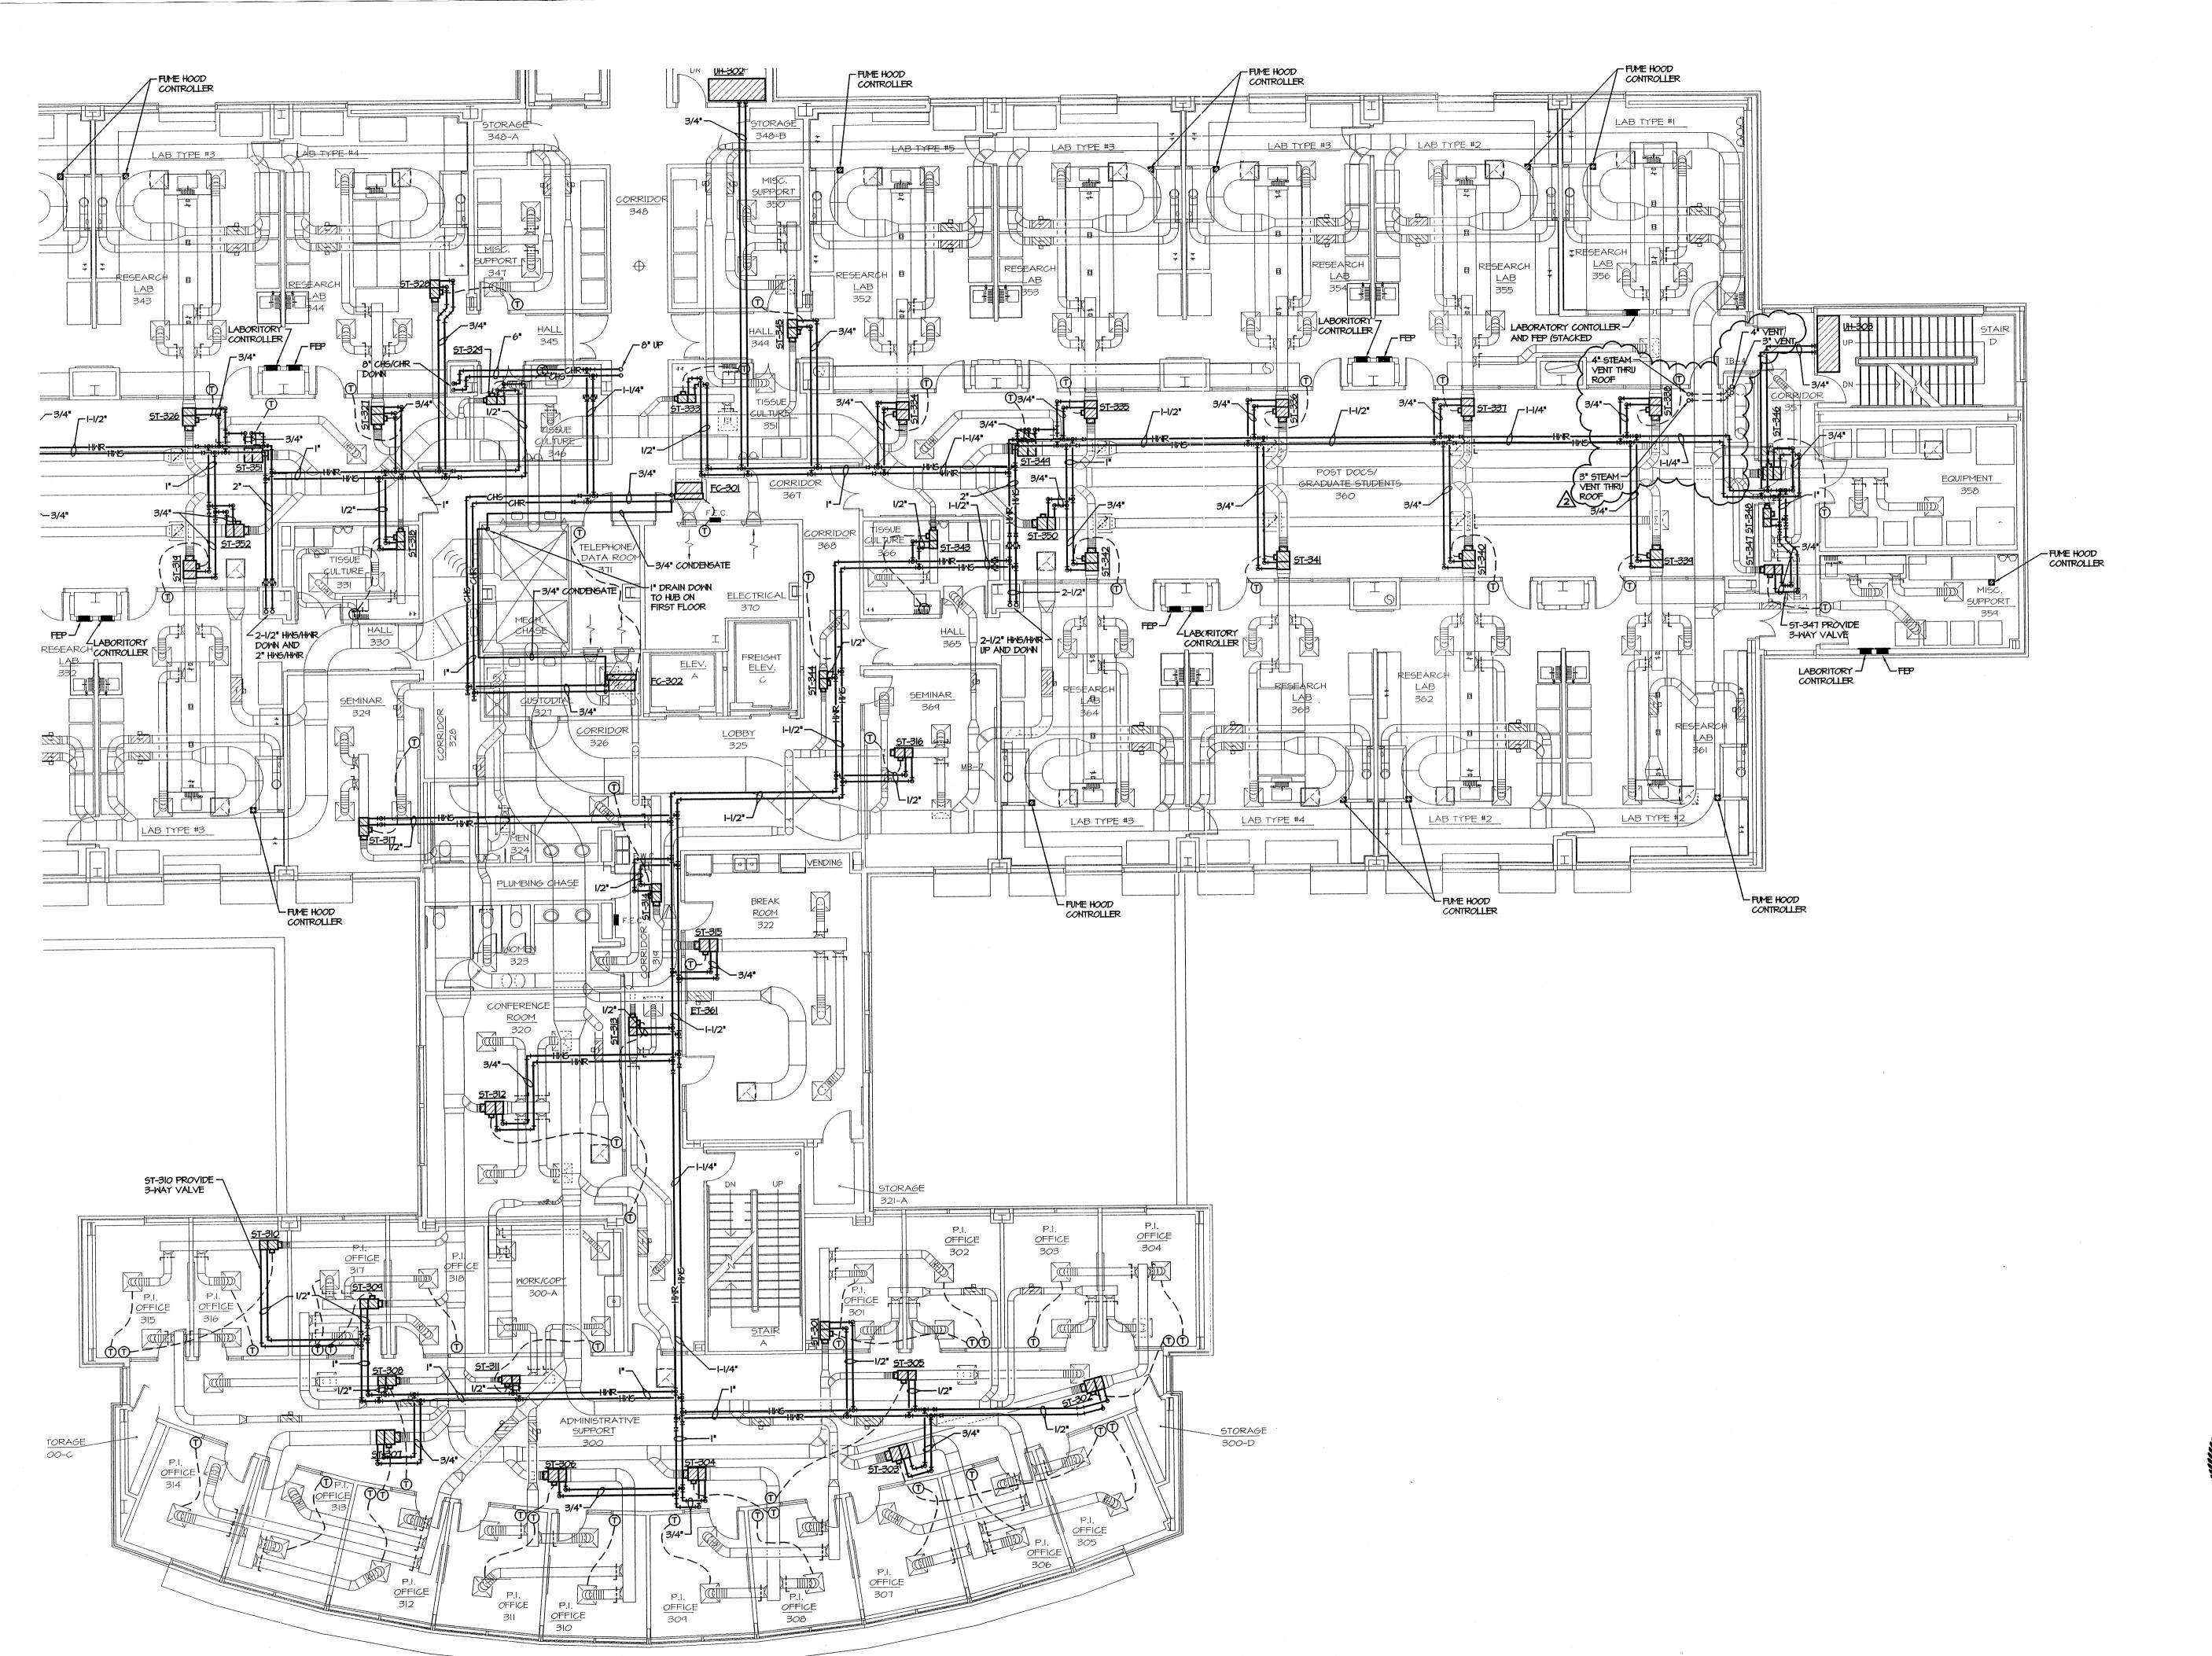

n third floor plan - HVAC
piping

SCALE: 1/8" = 1'-0"

FOURTH FLOO PLAN - HVAC PIPING


Commission Num

Date: October 1, 2

Consulting Engineers
5800 EVERGREEN DRIVE, SUITE A
LITTLE ROCK, ARKANSAS 72205-1757
Phone: (501) 666-6776 Fax: (501) 663-8888
tme@tmecorp.com

SCALE: 1/8" = 1'-0"


<u>∕2</u> остовек I, 2003

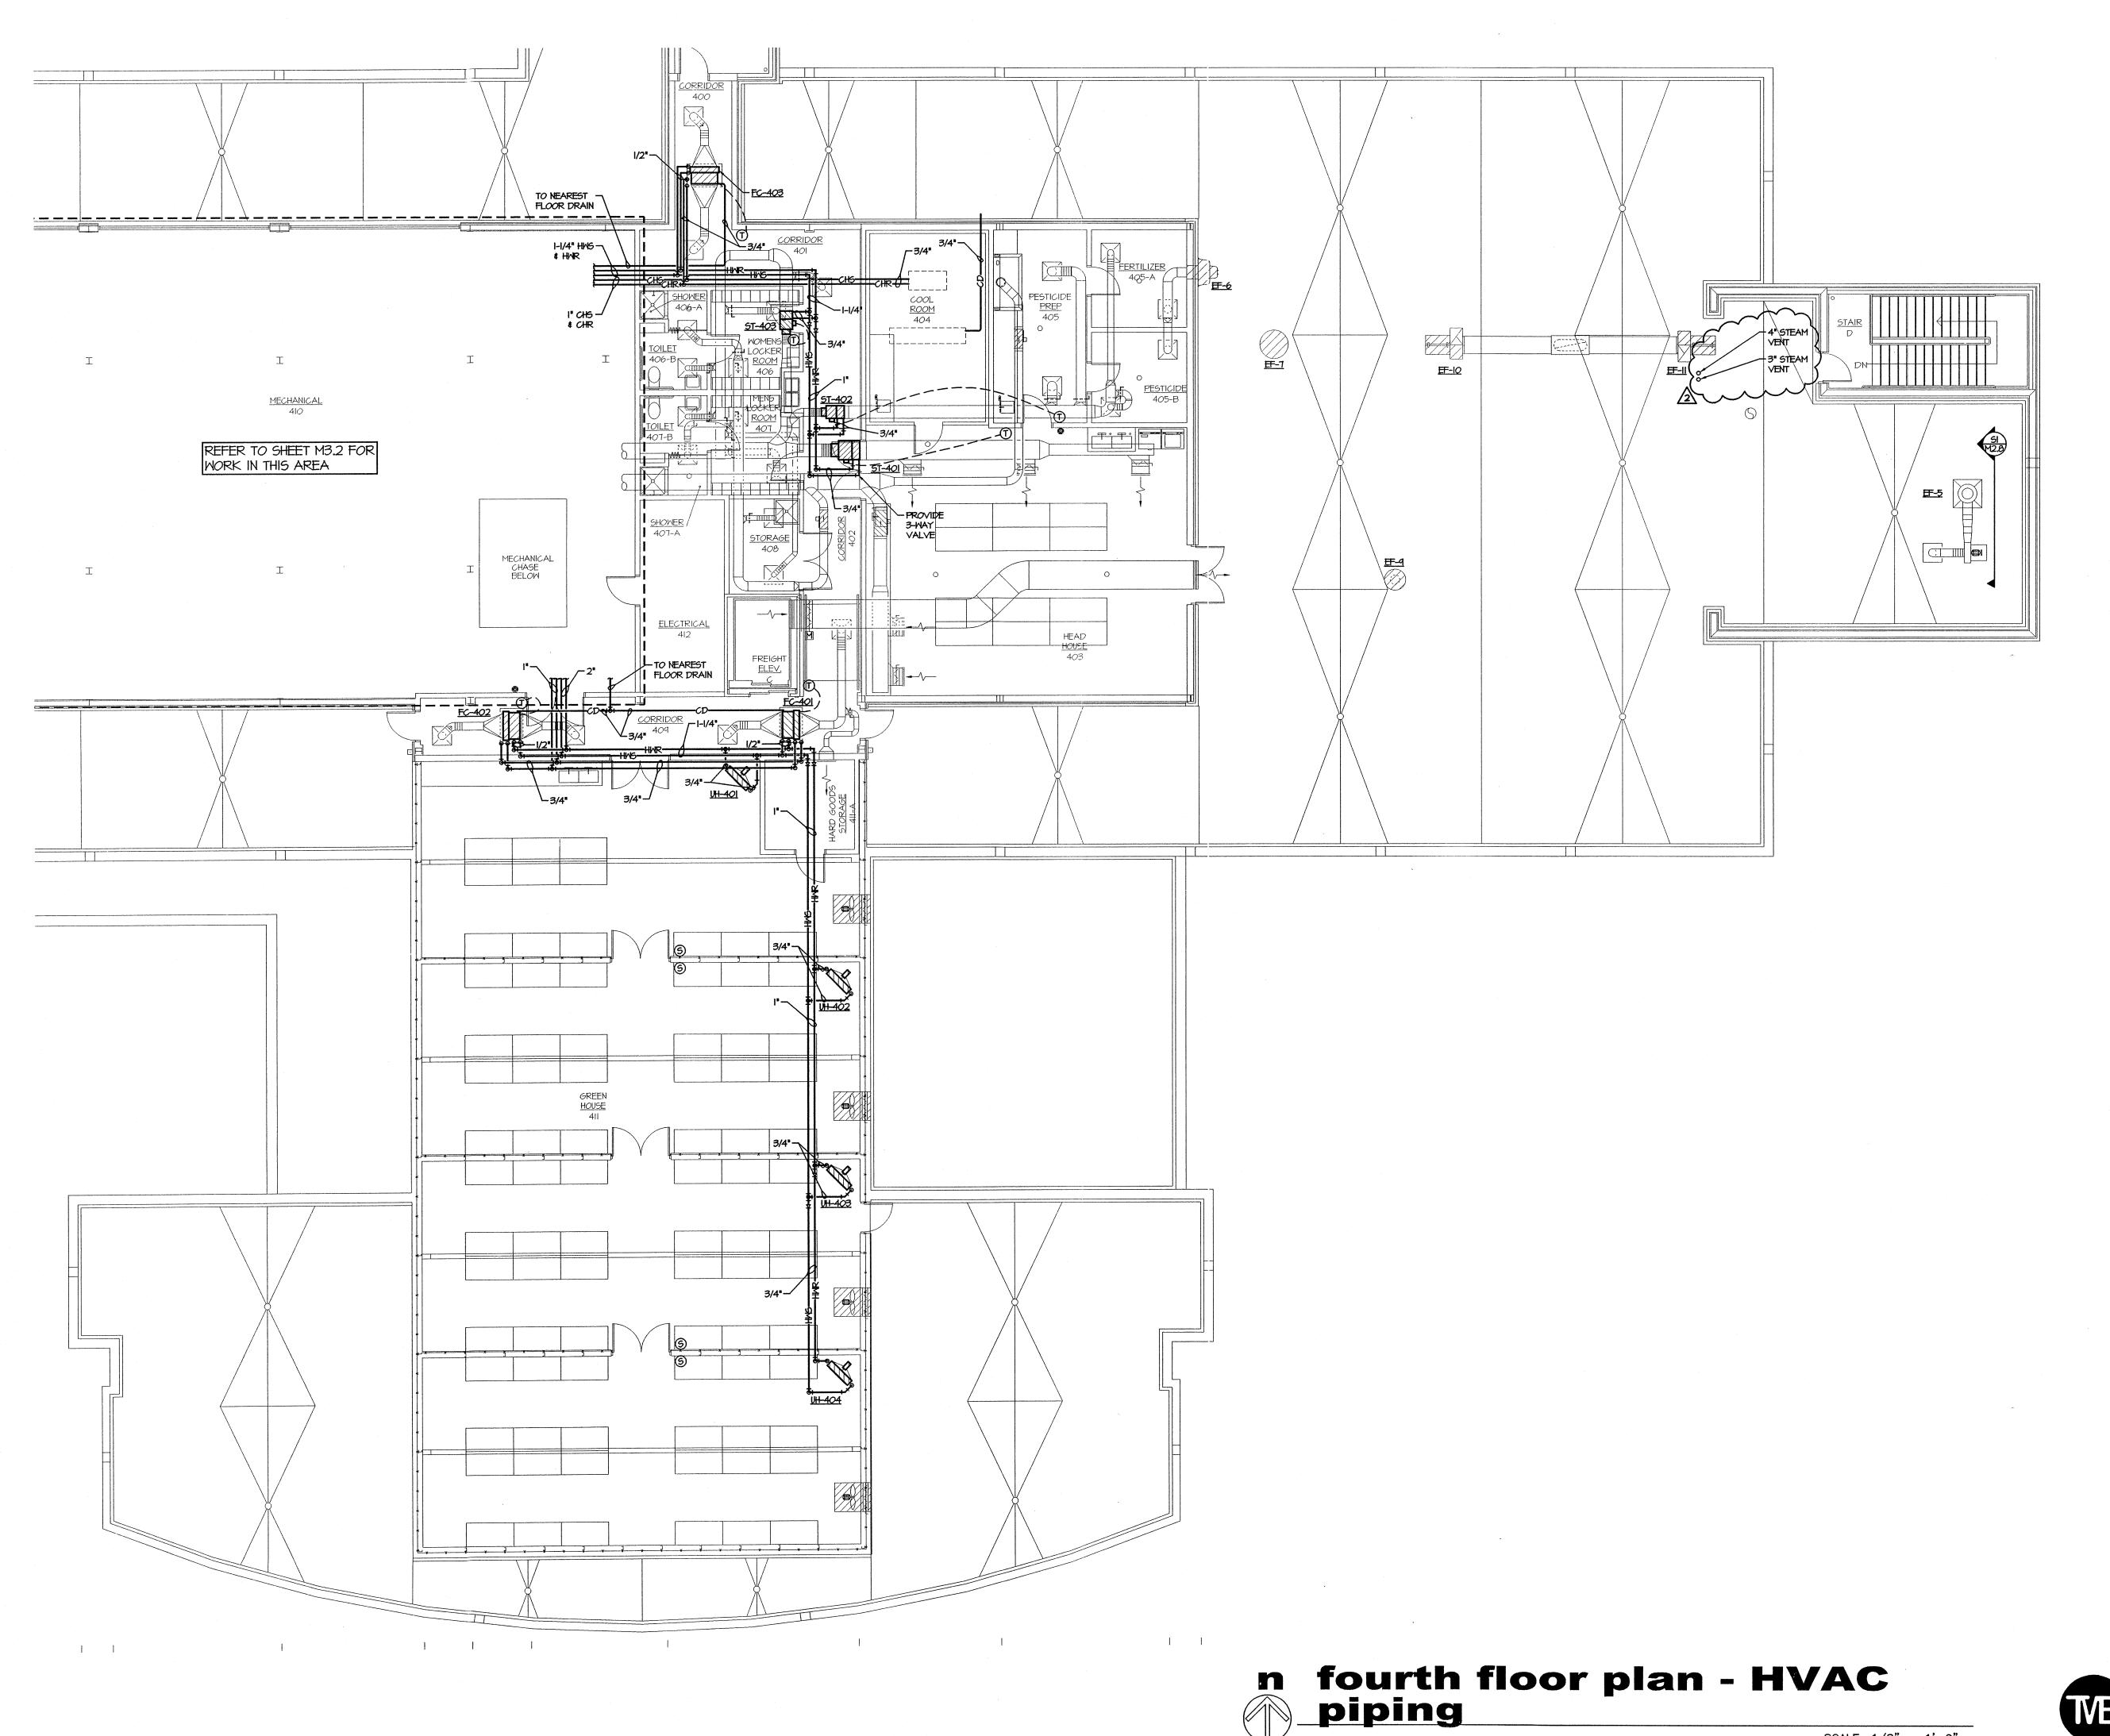

FIRST FLOOR MECHANICAL ROOM PLAN

Commission Num
10301

Date: October 1, 2

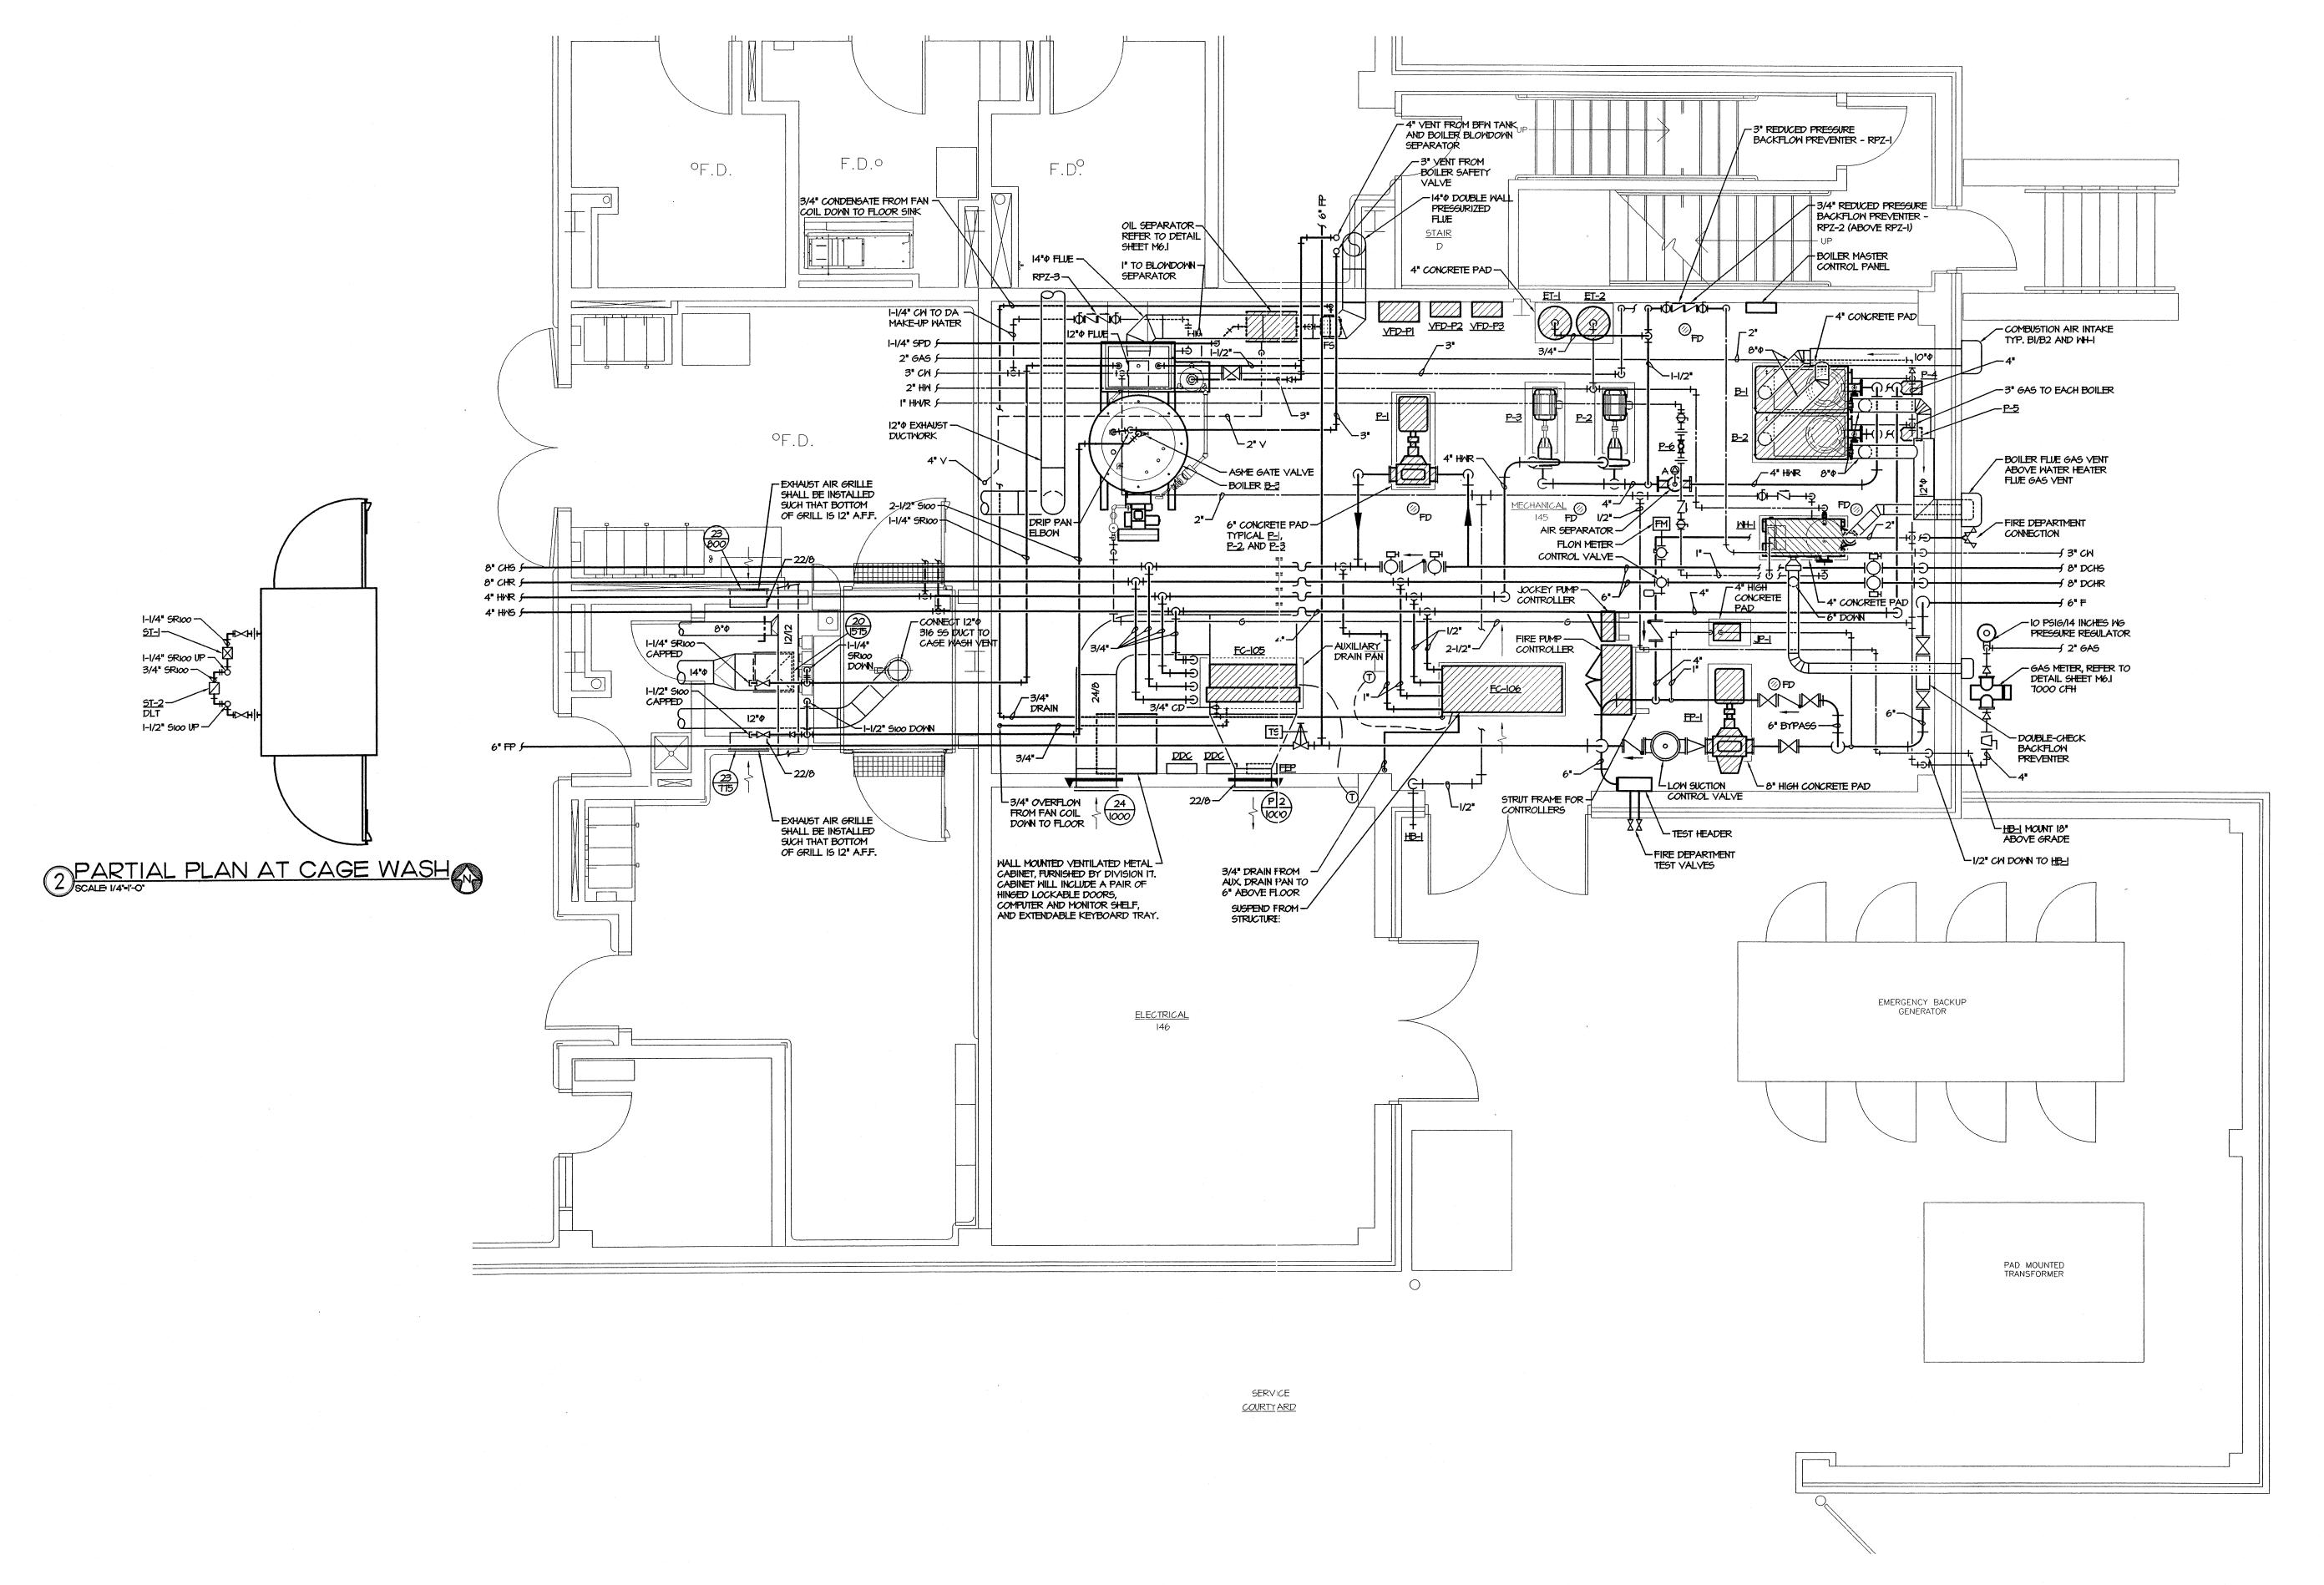



<u>√5</u> *осто*век I, 2003

Consulting Engineers
5800 EVERGREEN DRIVE, SUITE A
LITTLE ROCK, ARKANSAS 72205-1757
Phone: (501) 666-6776 Fax: (501) 663-8888
tme@tmecorp.com

FIRST FLOOR MECHANICAL ROOM PLAN SCALE: 1/4*-17-0*

> HIGH VELOCITY EXHAUST

HIGH PLUME — BLOWER

MOTOR DRIVE -COVER

I-5/8" GALVANIZED — STRUT ATTACHED TO FAN BASE

RUBBER IN SHEER ISOLATOR -ATTACHED TO RAIL

- DISCHARGE VENTURI

-FLEXIBLE CONNECTOR

-CONTROL DAMPER

OPEN DRAIN PLUG

12" TALL (MINIMUM)

GALVANIZED STEEL


RAIL SUPPORT


(2) EXHAUST FAN DETAIL (EF-IO ξ EF-II)








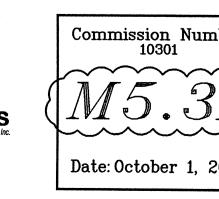

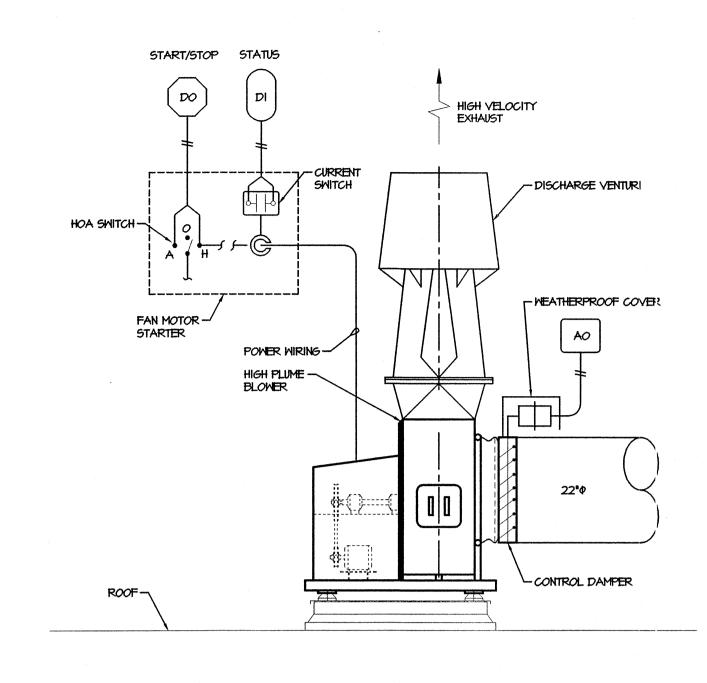

EXHAUST FAN CONTROL DIAGRAM (EF-IO & EF-II)

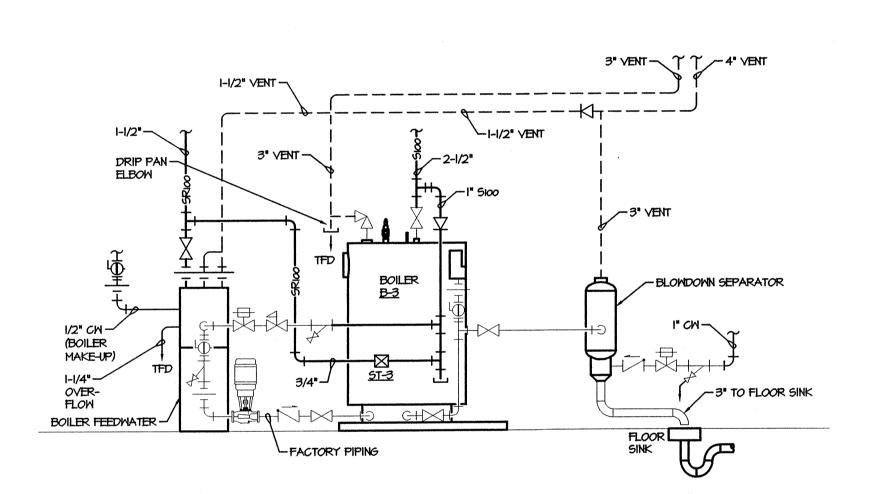

EXHAUST

EXHAUST FAN EF-9

MOTORIZED -DAMPER

FAN STATUS DI

FAN MOTOR

EXHAUST FAN (EF-9) CONTROL DIAGRAM

CURRENT SWITCH

FAN MOTOR STARTER

BOILER B-3 FLOW DIAGRAM




2 OCTOBER I, 2003



Date: October 1, 20






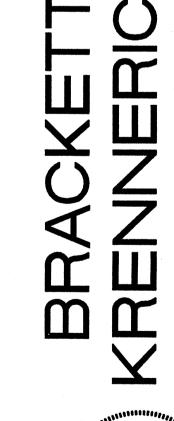




3 остовек I, 2003




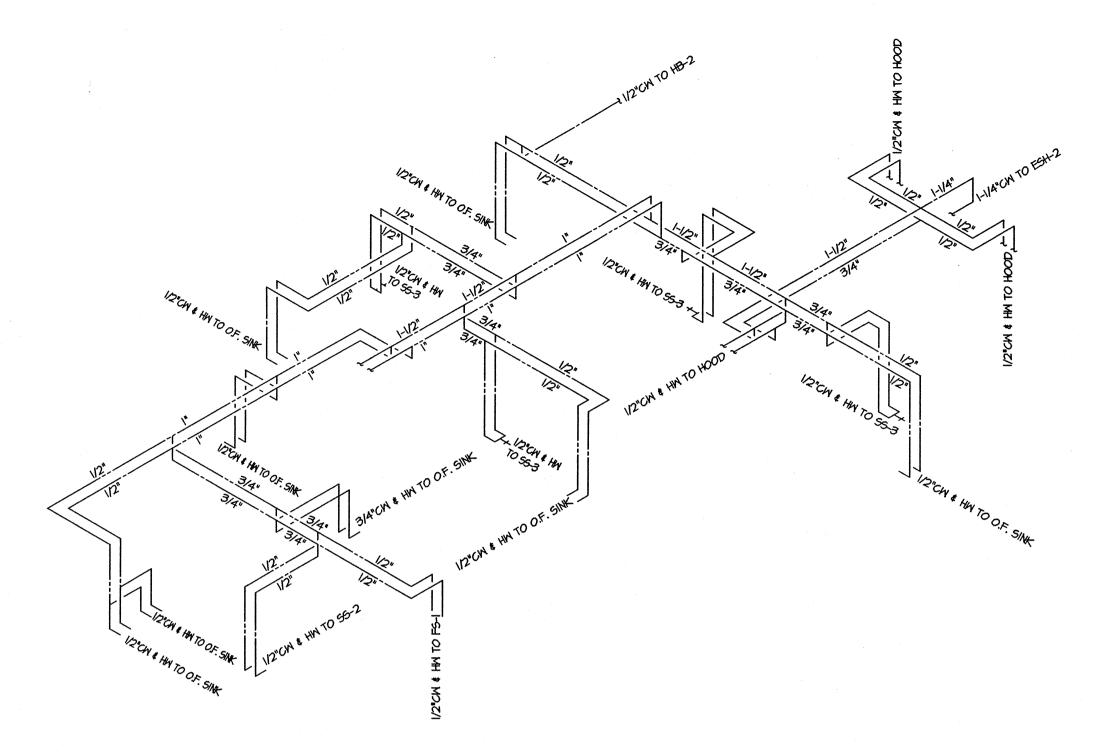


domestic water riser

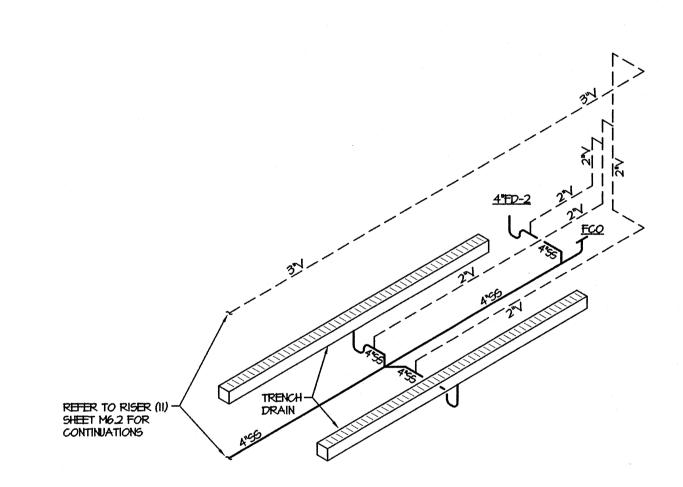

plumbing riser
scale: NONE

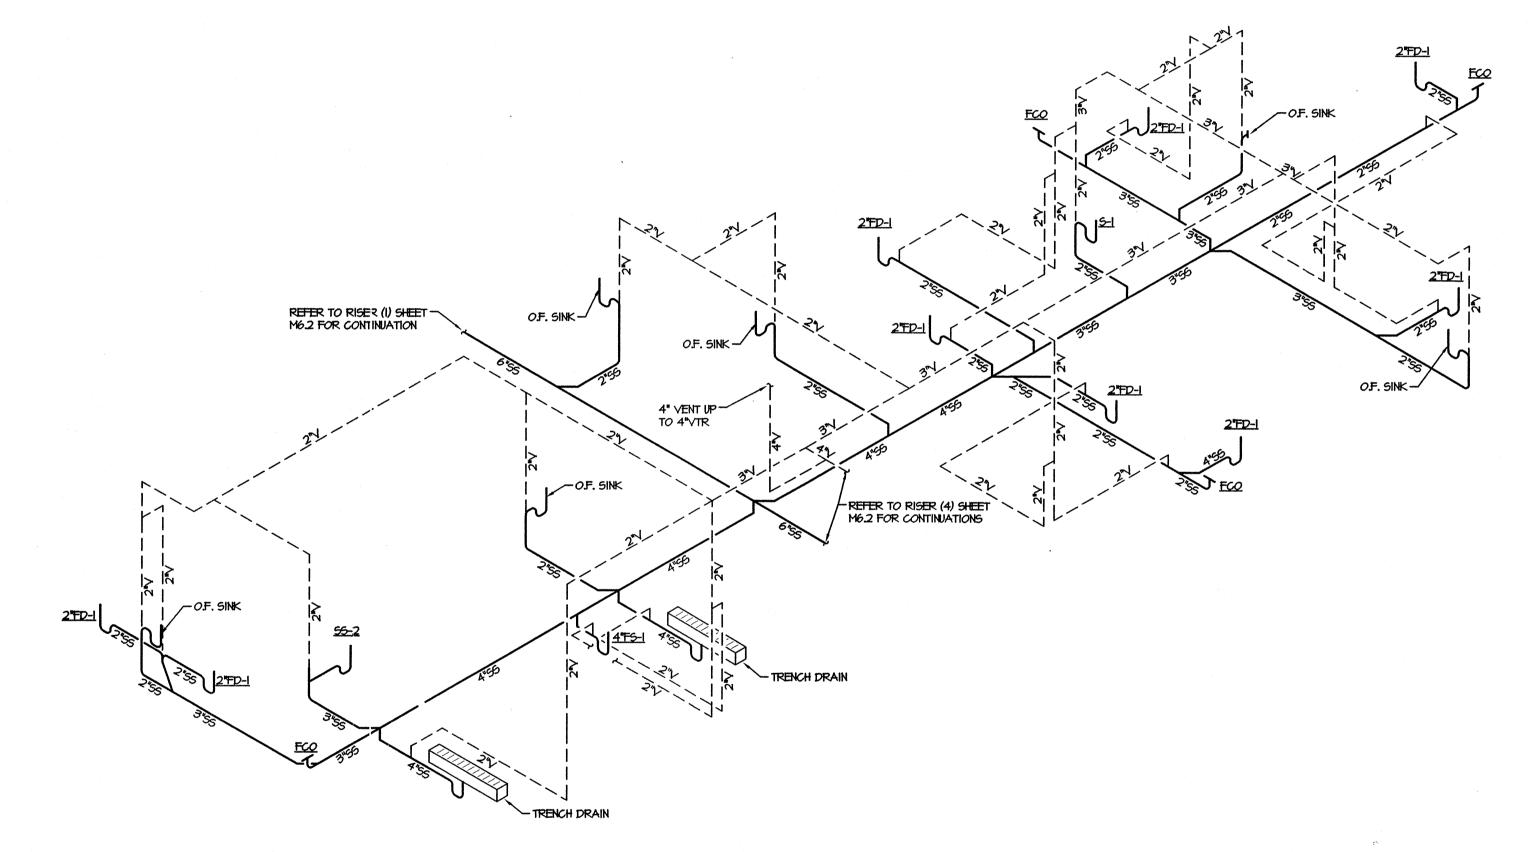

plumbing riser
SCALE: NONE

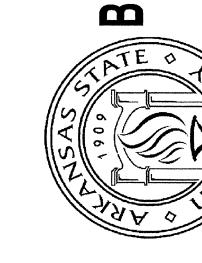



MECHANICAL SCHEDULES -

Commission Num 10301

Date: October 1, 2

SINGL	NGLE DUCT SUPPLY AIR TERMINALS WITH HOT WATER REHEAT COILS (FIRST FLOOR)								HEATING WATER COIL											
DESIGNATION	SERVES	REFERENCE PRODUCT	INLET SIZE (INCHES)	OCCUPIED MAX. AIRFLOW (CFM)	OCCUPIED MIN. AIRFLOW (CFM)	UNOCCUPIED AIRFLOH (CFM)	TERMINAL I PRESSURE DROP (INCHES M.g.)	HEATING COIL ² PRESSURE DROP (INCHES n.g.)	TOTAL ³ PRESGURE DROP (INCHES M.g.)	AIR FLON (CFM)	RONG	EAT	LAT °F.	HEATING COIL 4 PRESSURE DROP (INCHES M.g.)	EMT F.	LWT *F.	<i>Б</i> РМ	MPD (FEET)	MBH	REMARKS
ST-IOI	ASSOCIATE DIRECTOR 102, 103, 104	TUTTLE & BAILEY SDV	12"Φ	1175	600	0	0.01	0.21	0.22	600	2	55	107	0.06	160	125	2	0.29	33.6	
ST-102	ADMINISTRATION SUPPORT IOI, IOIA	TUTTLE # BAILEY SDY	10"Ф	900	450	0	0.02	0.23	0.25	450	2	55	111	0.07	160	132	2	0.69	27.2	
ST-103	GREENHOUSE MANAGER 105, 106	TUTTLE & BAILEY SDV	8"Ф	475	250	0	0.02	0.18	020	250	2	55	108	0.06	160	130	1	0.13	14.2	
ST-104	LOBBY 100	TUTTLE & BAILEY SDV	6"Φ	300	150	0	0.08	0.11	0.19	150	2	55	116	0.03	160	139	ı	0.12	10.0	
ST-105	LOBBY 100, 100A	TUTTLE & BAILEY SDY	ΙΟ"Φ	T75	400	0	0.02	0.17	0.19	400	2	55	114	0.05	160	134	2	0.69	25.3	
ST-106	SEMINAR 107	TUTTLE & BAILEY SDY	ΙΟ"Φ	825	425	0	0.02	0.19	0.21	425	2	55	112	0.06	160	133	2	0.69	26.2	
ST-107	SEMINAR 107, 107-A, 107-B	TUTTLE & BAILEY SDY	ΙΟ"Φ	1050	525	0	0.03	030	0.33	525	2	55	107	0.09	160	129	2	0.69	29.7	
ST-108	RECEPTION 100B, 108	TUTTLE & BAILEY SDY	6"Φ	200	200	0	0.04	0.05	0.09	200	2	55	110	0.05	160	135	ı	0.12	11.8	
ST-109	CUSTODIAL 109, 110, 111, 144	TUTTLE & BAILEY SDY	ΙΟ"Φ	700	700	450	0.02	0.14	0.16	700	2	55	105	0.14	160	134	3	1.42	38.0	
ST-IIO	DIRECTOR II5	TUTTLE & BAILEY SDV	8"Ф	375	200	0	0.01	0.12	0.13	200	2	55	113	0.04	160	134	ı	0.13	125	
ST-III	CONFERENCE II4	TUTTLE & BAILEY SDY	6"Ф	200	100	0	0.04	0.05	0.09	100	2	55	125	0.02	160	144	: 1	0.12	7.6	
ST-II2	RECEPTION II3	TUTTLE & BAILEY SDY	8"Ф	400	200	0	0.02	0.13	0.15	200	2	55	113	0.04	160	134	. 1	0.13	12.5	
ST-II3	ACCOUNTANT OFFICE 121, 119	TUTTLE & BAILEY SDY	ΙΟ"Φ	<i>850</i>	450	0	0.02	0.20	0.22	450	2	55	111	0.07	160	132	2	0.69	27.2	
5T-II4	ACCOUNTANT OFFICE 123, 124, 125	TUTTLE & BAILEY SDY	Ι2"Φ	1175	600	0	0.01	0.21	0.22	600	2	55	107	0.06	160	125	2	0.29	33.6	
ST-115	ACC. OFFICE 120, 116, 118, 122, 147	TUTTLE & BAILEY SDY	10"Ф	1025	550	0	0.03	0.28	0.31	550	2	55	106	0.09	160	128	2	0.69	30.4	
ST-116	AUTOCLAVE 142	TUTTLE & BAILEY SDY	12"Φ	1500	800	0	0.01	0.33	0.34	800	2	55	105	0.11	160	130	3	0.60	435	
ST-117	RECEIVING 141	TUTTLE & BAILEY SDY	Ι4"Φ	1575	1575	0	0.01	0.23	0.24	1575	2	55	101	0.23	160	133	6	1.14	77.6	
ST-II8	STORAGE 129	TUTTLE & BAILEY SDY	ΙΟ"Φ	675	350	0	0.01	0.14	0.15	350	2	55	117	0.04	160	136	2	0.69	23.3	
ST-119	CHEMICAL STORAGE 136	TUTTLE & BAILEY SDY	6"Ф	275	250	50	0.01	0.09	0.16	250	2	55	105	0.08	160	132	1	0.12	13.4	
ST-120	HAZARDOUS STORAGE 137	TUTTLE & BAILEY SDY	6"Ф	300	300	75	0.08	0.11	0.19	300	2	55	100	0.11	160	130	1	0.12	14.7	
5T-I2I	SAMPLE QUARANTINE 138, 139	TUTTLE & BAILEY SDY	8"Ф	450	400	50	0.02	0.16	0.18	400	2	55	105	0.13	160	137	2	0.46	21.6	•
ST-122	CORRIDOR 130, 133	TUTTLE & BAILEY SDY	6"Ф	250	125	0	0.06	0.08	0.14	125	2	55	121	0.02	160	141	· 1	0.12	8.9	
ST-123	STORAGE 135	TUTTLE & BAILEY SDY	6"Ф	275	150	0	0.07	0.09	0.16	150	2	55	116	0.03	160	139	, 1	0.12	10.0	
ST-124	GROWTH CHAMBER 140	TUTTLE & BAILEY SDY	12"Φ	1400	700	150	0.01	0.29	030	700	2	55	108	0.08	160	132	3	0.60	40.3	
ST-125	GROWTH CHAMBER 140	TUTTLE & BAILEY SDV	12"Φ	1400	700	150	0.01	0.29	0.30	700	2	55	108	0.08	160	132	3	0.60	40.3	
ST-126	EQUIPMENT ACCESS 143	TUTTLE & BAILEY SDV	ΙΟ"Φ	1000	500	150	0.03	0.27	030	500	2	55	108	0.08	160	130	2	0.69	28.9	
ST-127	DIRECTORS OFFICE 149	TUTTLE & BAILEY SDV	8"Ф	500	250	0	0.02	020	0.22	250	2	55	108	0.06	160	130	<u> </u>	0.13	14.2	
ST-128	SENIOR ACCOUNTANT OFFICE 148	TUTTLE & BAILEY SDV	6"Ф	300	150		0.08	0.11	0.19	150	2	55	116	0.03	160	139		0.12	10.0	—
ST-129	CL. CAGE WASH AIOS, AIOS, AIO9	TUTTLE & BAILEY SDY	12"Φ	1500	1500	1500	0.01	<i>``````````</i>	0.34	1500	2	55	91	0.33	160	132	5	1.47	68.0)
ST-130	HOLD. ROOM AII2, AIIO, AIO7, AIO4	TUTTLE & BAILEY SDV	10"Ф	T15	115	775	0.02	0.17	0.19	T15	2	55	103	0.17	160	132	3	1.42	40.2)
ST-I3I	CORR. AIOO, AIOI, AIO2, AIO8, AIII	TUTTLE & BAILEY SDV	IO"Φ	1050	1050	1050	0.03	030	0.33	1050	2	55	99	030	160	134	4	2.37	50.3	<u> </u>
ST-132	PROCEDURE ROOM AII6, AII7, AII8	TUTTLE & BAILEY SDV	8*Φ	670	670	670	0.04	0.33	0.37	675	2	55	98	0.33	160	138	3	0.94	31.1	
> ST-133	PROCEDURE ROOM AII3, AII4, AII5	TUTTLE & BAILEY SDV	12"Φ	1200	1200	1200	0.01	0.22	0.23	1200	2	55	99	0.22	160	130	4	0.99	57.6	\
ST-134	GROWTH CHAMBER 140	TUTTLE # BAILEY SDV	Ι2"Φ	1400	700	150	0.01	0.29	030	700	2	55	108	0.08	160	132	3	0.60	40.3	<u> </u>
> ST-135	GROWTH CHAMBER 140	TUTTLE & BAILEY SDY	12"Φ	1400	700	150	0.01	0.29	0.30	700	2	55	108	0.08	160	132	3	0.60	40.3	\ \ \ \ \ \ \ \ \ \ \ \ \ \ \ \ \ \ \

- DIFFERENCE IN STATIC PRESSURE FROM INLET TO DISCHARGE AT COOLING MAXIMUM AIR FLOW. DOES NOT INCLUDE HEATING COIL.

 2 AIR PRESSURE DROP AT COOLING MAXIMUM FLOW.
- 3 TOTAL AIR PRESSURE LOSS THRU UNIT AT COOLING MAXIMUM AIR FLOW.
- 4 AIR PRESSURE DROP AT HEATING AIR FLOW.

ESIGNATION	SERVES	ASSOCIATED SUPPLY AIR TERMINAL	REFERENCE PRODUCT	INLET SIZE (INCHES)	MAX, OCCUPIED AIRFLOW (CFM)	MIN, OCCUPIED AIRFLOW (CFM)	UNOCCUPIED AIRFLOW (CFM)	PRESSURE! DROP (INCHES M.g.)	MATERIAL TYPE	APPLICATION	REFERENCE CONTROL DIAGRAM
ET-IOI	DIRECTOR 102, 103, 104	ST-IOI	TUTTLE & BAILEY RRV	12"Φ	1175	600	0	0.09	GALV.	ROOM EXHAUST	
ET-102	ADMINISTRATION SUPPORT IOI, IOI-A	ST-102	TUTTLE & BAILEY RRV	10"Ф	900	450	0	0.16	GALV.	ROOM EXHAUST	
ET-103	GREENHOUSE MANAGER 105, 106	ST-103	TUTTLE & BAILEY RRV	8"Ф	475	250	0	0.09	GALV.	ROOM EXHAUST	
ET-104	SEMINAR 107, 107-A, 107-B	ST-106, 10T	TUTTLE & BAILEY RRV	16"Φ	1875	950	0	0.06	GALV.	ROOM EXHAUST	
ET-105	LOBBY 100, 108	ST-104, 105	TUTTLE & BAILEY RRV	12"Φ	1075	550	0	0.08	GALV.	ROOM EXHAUST	
ET-106	RECEPTION II3, II4, II5	ST-110, 111, 112	TUTTLE & BAILEY RRV	12"Φ	975	500	0	0.07	GALV.	ROOM EXHAUST	
ET-107	RESTROOMS 109, 110, 111, 144	ST-109	TUTTLE & BAILEY RRV	10"Ф	900	900	650	0.16	GALV.	ROOM EXHAUST	
ET-108	ACCOUNTANT OFFICE 121, II9, I23, I25	ST-113, 114	TUTTLE & BAILEY RRV	Ι4"Φ	1825	450	0	0.06	GALV.	ROOM EXHAUST	quintiple gare
ET-109	ACCOUNT, OFF, 120, 116, 118, 122, 147	ST-II5	TUTTLE & BAILEY RRV	ΙΟ"Φ	1025	550	0	0.11	GALV.	ROOM EXHAUST	
ET-IIO	STORAGE 129, 135	ST-II8, 123	TUTTLE & BAILEY RRV	Ι2"Φ	1050	600	100	0.08	GALV.	ROOM EXHAUST	
ET-III	AUTOCLAVE 142	ST-II6	TUTTLE & BAILEY RRV	Ι4"Φ	1600	900	100	0.08	304 55	ROOM EXHAUST	
ET-II2	GROWTH CHAMBER 140	ST-124	TUTTLE & BAILEY RRY	Ι4"Φ	1450	750	200	0.06	304 55	ROOM EXHAUST	-
ET-II3	GROWTH CHAMBER 140	ST-125	TUTTLE & BAILEY RRY	Ι4"Φ	1450	750	200	0.06	304 55	ROOM EXHAUST	-
ET-II4	EQUIP. ACCESS 143	ST-126	TUTTLE & BAILEY RRY	12"Φ	1100	600	250	0.09	304 55	ROOM EXHAUST	
ET-II5	DIRECTORS OFFICE 149, 148	ST-127, 128	TUTTLE & BAILEY RRV	ΙΟ"Φ	800	400	0	0.06	GALV.	ROOM EXHAUST	
ET-II6	GROWTH CHAMBER 140	ST-134	TUTTLE & BAILEY RRY	14"Φ	1450	750	200	0.06	304 55	ROOM EXHAUST	—)
ET-117	GROWTH CHAMBER 140	ST-135	TUTTLE & BAILEY RRV	Ι4"Φ	1450	150	200	0.06	304 55	ROOM EXHAUST	
ET-II8	GOWNING ROOM AIOI, AIO2	ST-131	TUTTLE & BAILEY RRV	6"Ф	250	250	250	0.06	GALV.	ROOM EXHAUST	
ET-119	EQUIPMENT ROOM AIO6	ST-129	TUTTLE & BAILEY RRY	Ι4"Φ	1575	1175	1175	0.05	GALV.	ROOM EXHAUST	
ET-120	SURGERY ROOM AIIO,	ST-130	TUTTLE & BAILEY RRV	10"Ф	900	900	900	0.09	GALV.	ROOM EXHAUST	
ET-121	Ali2, Alo4, Alo5, Alo7 PROCEDURE ROOM Ali6, Ali7, Ali8	5T-l32	TUTTLE & BAILEY RRV	12"Φ	970	640	970	0.02	GALV.	ROOM EXHAUST	-
ET-122	PROCEDURE ROOM AII6	ST-132	TUTTLE & BAILEY RRY	6"Φ	330	0	0	0.10	GALV.	ROOM EXHAUST	
ET-123	HOLDING ROOM All4, All5	ST-133	TUTTLE & BAILEY RRY	12"Φ	1025	1025	1025	0.04	GALV.	ROOM EXHAUST	
ET-125	PROCEDURE ROOM AII3	ST-133	TUTTLE & BAILEY RRV	8"Ф	475	145	475	0.05	GALV.	ROOM EXHAUST	
ET-125	PROCEDURE ROOM AII3	ST-133	TUTTLE & BAILEY RRV	6"Ф	330	0	0	0.10	GALV.	ROOM EXHAUST	→ / 5

I DIFFERENCE IN STATIC PRESSURE FROM INLET TO DISCHARGE AT MAXIMUM EXHAUST AIRFLOW

REFERENCE PRODUCT PRESSURE (CFM) FRESSURE (N. MATER) (N.	EXI	HAUS	ST FANS												SPECIFIED IN SECTION 15600
ACME UP-BLAST EQUIPMENT 500 2.0 2,869 BELT 61 0.68 3/4 460 3 PNUXPOBORFH UP-BLAST ROOM AIO6 500 2.5 I59I BELT 69 I.7I 3 460 3			REFERENCE	TYPE		RATE	PRESSURE		DRIVE	1	I		T		
A FE-IO MK PLASTICS CENTRIFUGAL 121 122 123 124 2600 25 1591 BELT 69 1.71 3 460 3)	(EF-	-9	ACME Y	UP-BLAST	ROOM AIO6			2,869	BELT	67	0.68	3/4	460	3	
	EF-I	10	MK PLASTICS AXIJET-F 1825	CENTRIFUGAL	ET-118, 119, 120, 121, 122, 123, 124	2,600	2.5	1591	BELT	69	1.71	3	460	3	
AXI_ET_F 1825 EF-II MK PLASTICS AXI_ET_F 1825 CENTRIFUGAL 121, 122, 123, 124 2600 25 1541 BELT 64 1.71 3 460 3 5	EF-	-11	MK PLASTICS AXIJET-F 1825		ET-118, 119, 120, 121, 122, 123, 124					69	1.71	3	460	3)/5\

BOILER	S - STEAM	1												ELECT	RICAL		SPECIFIED IN SECTION 15600
DESIGNATION	REFERENCE PRODUCT	LOCATION	TYPE	FUEL.	CAPACITY (HP)	NAT. GAS INPUT (MBH)	GAS PRESSURE ("N.C.)	STEAM FLOW RATE (LBS/HR)	STEAM PRESSURE (PSIG)	FIRING TYPE	FLUE DIAMETER (IN.)	NUMBER OF PASSES	OPERATING WEIGHT (LES)	FAN MOTOR (HP)	VOLTS/PHASE	CONTROLS (AMPS/VOLTS)	REMARKS
B-3	HURST 4VTG48150	MECH. 145	4-PASS VERTICAL	NAT. GAS	48	1606	14.0	1656	150	MODULATING IO:I	12	4	6400	1	480/3	5 / 120	ONE ELECTRICAL CIRCUIT

DOILLR	R FEED WAT						BOILE	R FEED PL	IMPS					SPECIFIED IN SECTION 1560
DESIGNATION	REFERENCE PRODUCT	LOCATION	CAPACITY (LB/HR)	DIAMETER	TANK LENGTH (INCHES)	STORAGE CAPACITY (GALS.)	FLOW RATE (GPM)	PUMP HEAD (FT. HATER)	MOTOR SIZE (HP)	PUMP SPEED (RPM)	NO. of STAGES	GUANTITY	VOLTS/PHASE	REMARKS
B-3	HURST FMD-60150	MECH. 145	50	25	36	60	7	370	2	3450	ı	2	480 / 3	ONE ELECTRICAL CIRCUIT

3 5	STEAM	TRAPS								SPECIFIED IN SECTION 15100	•
DE	SIGNATION	REFERENCE PRODUCT	SERVES	TYPE	CONDENSATE LOAD (LBS/HR)	CAPACITY (LBS/HR)	ORIFICE SIZE (IN.)	MAXIMUM INLET PRESSURE (PSIG)	MIN. DIFFERENTIAL PRESSURE (PSIG)	REMARKS	
`	ST-I	SARCO FT-125	CAGE WASH	FLOAT AND THERMOSTATIC	1300	2300	1/4	125	20	I-I/4" PIPE CONNECTION	•
	ST-2	SARCO BIH-125	DRIP LEG	INVERTED BUCKET	100	446	1/8	125	20	3/4" PIPE CONNECTION	•
											•

PUMPS													SPECIFIED IN SECTION 15400	
	REFERENCE				WATER		ROTATION	EFFICIENCY	мото	R SIZE	ELEC1	RICAL	REMARKS	
DESIGNATION	PRODUCT	LOCATION	SERVES	TYPE	FLOW RATE (6PM)	HEAD (FT. WATER)	(RPM)	(%)	BHP	MHP	VOLTS	PHASE		
FP-I	AC FIRE PUMP 6x4x12	MECH. RM. #145	FIRE PROTECTION SYSTEM	DOUBLE SUCTION SPLIT-CASE	500	92	ITTO	-	-	20	460	3		
JP-I	GOULD 15V-3	MECH. RM. #145	FP-I	VERTICAL MULTI-STAGE	14	104	3450		-	3/4	460	3		

MECHANICAL LEGEND

- -----Stoo----- STEAM LINE PRESSURE —SRICO— STEAM RETURN LINE PRESSURE

	<u>\$</u>	OCTOBER	I,	2

ARKANSAS

REGISTERED
PROFESSIONAL
ENGINEERS





Commission Num 10301

Date: October 1, 2



SCALE: 1/8" = 1'-0"

