KAYS HALL ARKANSAS FIRE PREVENTION CODE DATA OCCUPANCY CLASSIFICATION : R2 BUILDING AREA: FIRST FLOOR: 13,612 S.F. 2ND - 11TH FLOORS: 10,186 S.F. PENTHOUSE: 1,420 S.F. BUILDING HEIGHT: 106' ABOVE GRADE NUMBER OF STORIES: ELEVEN TYPE OF CONSTRUCTION: TYPE II UNSPRINKLERED

TWIN TOWERS ARKANSAS FIRE PREVENTION CODE DATA OCCUPANCY CLASSIFICATION : R2 BUILDING AREA: FIRST FLOOR: 17,182 S.F. 2ND - 9TH FLOORS: 118996 S.F. PENTHOUSE: 1,300 S.F. BUILDING HEIGHT: 90' ABOVE GRADE NUMBER OF STORIES: NINE TYPE OF CONSTRUCTION: TYPE II UNSPRINKLERED


# Kays Hall RESIDENCE HALL RENOVATIONS

### STRUCTURAL ENGINEERS: ENGINEERING CONSULTANTS, INC.

209 West Capitol, Suite 423 Little Rock, Arkansas 72201 501-376-3752 Fax: 501-376-7314

### MECHANICAL/ELECTRICAL ENGINEERS: PETTIT & PETTIT CONSULTING ENGINEERS

201 East Markham Little Rock, Arkansas 72201 501-374-3731 Fax: 501-374-1802

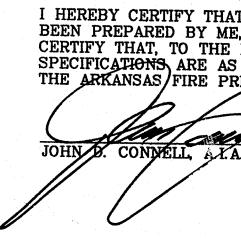

FOR

## ARKANSAS STATE UNIVERITY

Jonesboro, Arkansas

March 18, 1999


### ARCHITECT:

STEELMAN CONNELL MOSELEY ARCHITECTS, P.A. 10411 West Markham, Suite 220 Little Rock, Arkansas 72205-1410 501-224-3055 Fax: 501-224-6934


> I HEREBY CERTIFY THAT THESE PLANS AND SPECIFICATIONS HAVE BEEN PREPARED BY ME, OR UNDER MY SUPERVISION. I FURTHER CERTIFY THAT, TO THE BEST OF MY KNOWLEDGE, THESE PLANS AN SPECIFICATIONS ARE AS REQUIRED BY LAW AND IN COMPLIANCE WITH THE ARKANSAS/FIRE PREVENTION CODE FOR THE STATE OF ARKANSAS

> > 3.18.99

DATE:

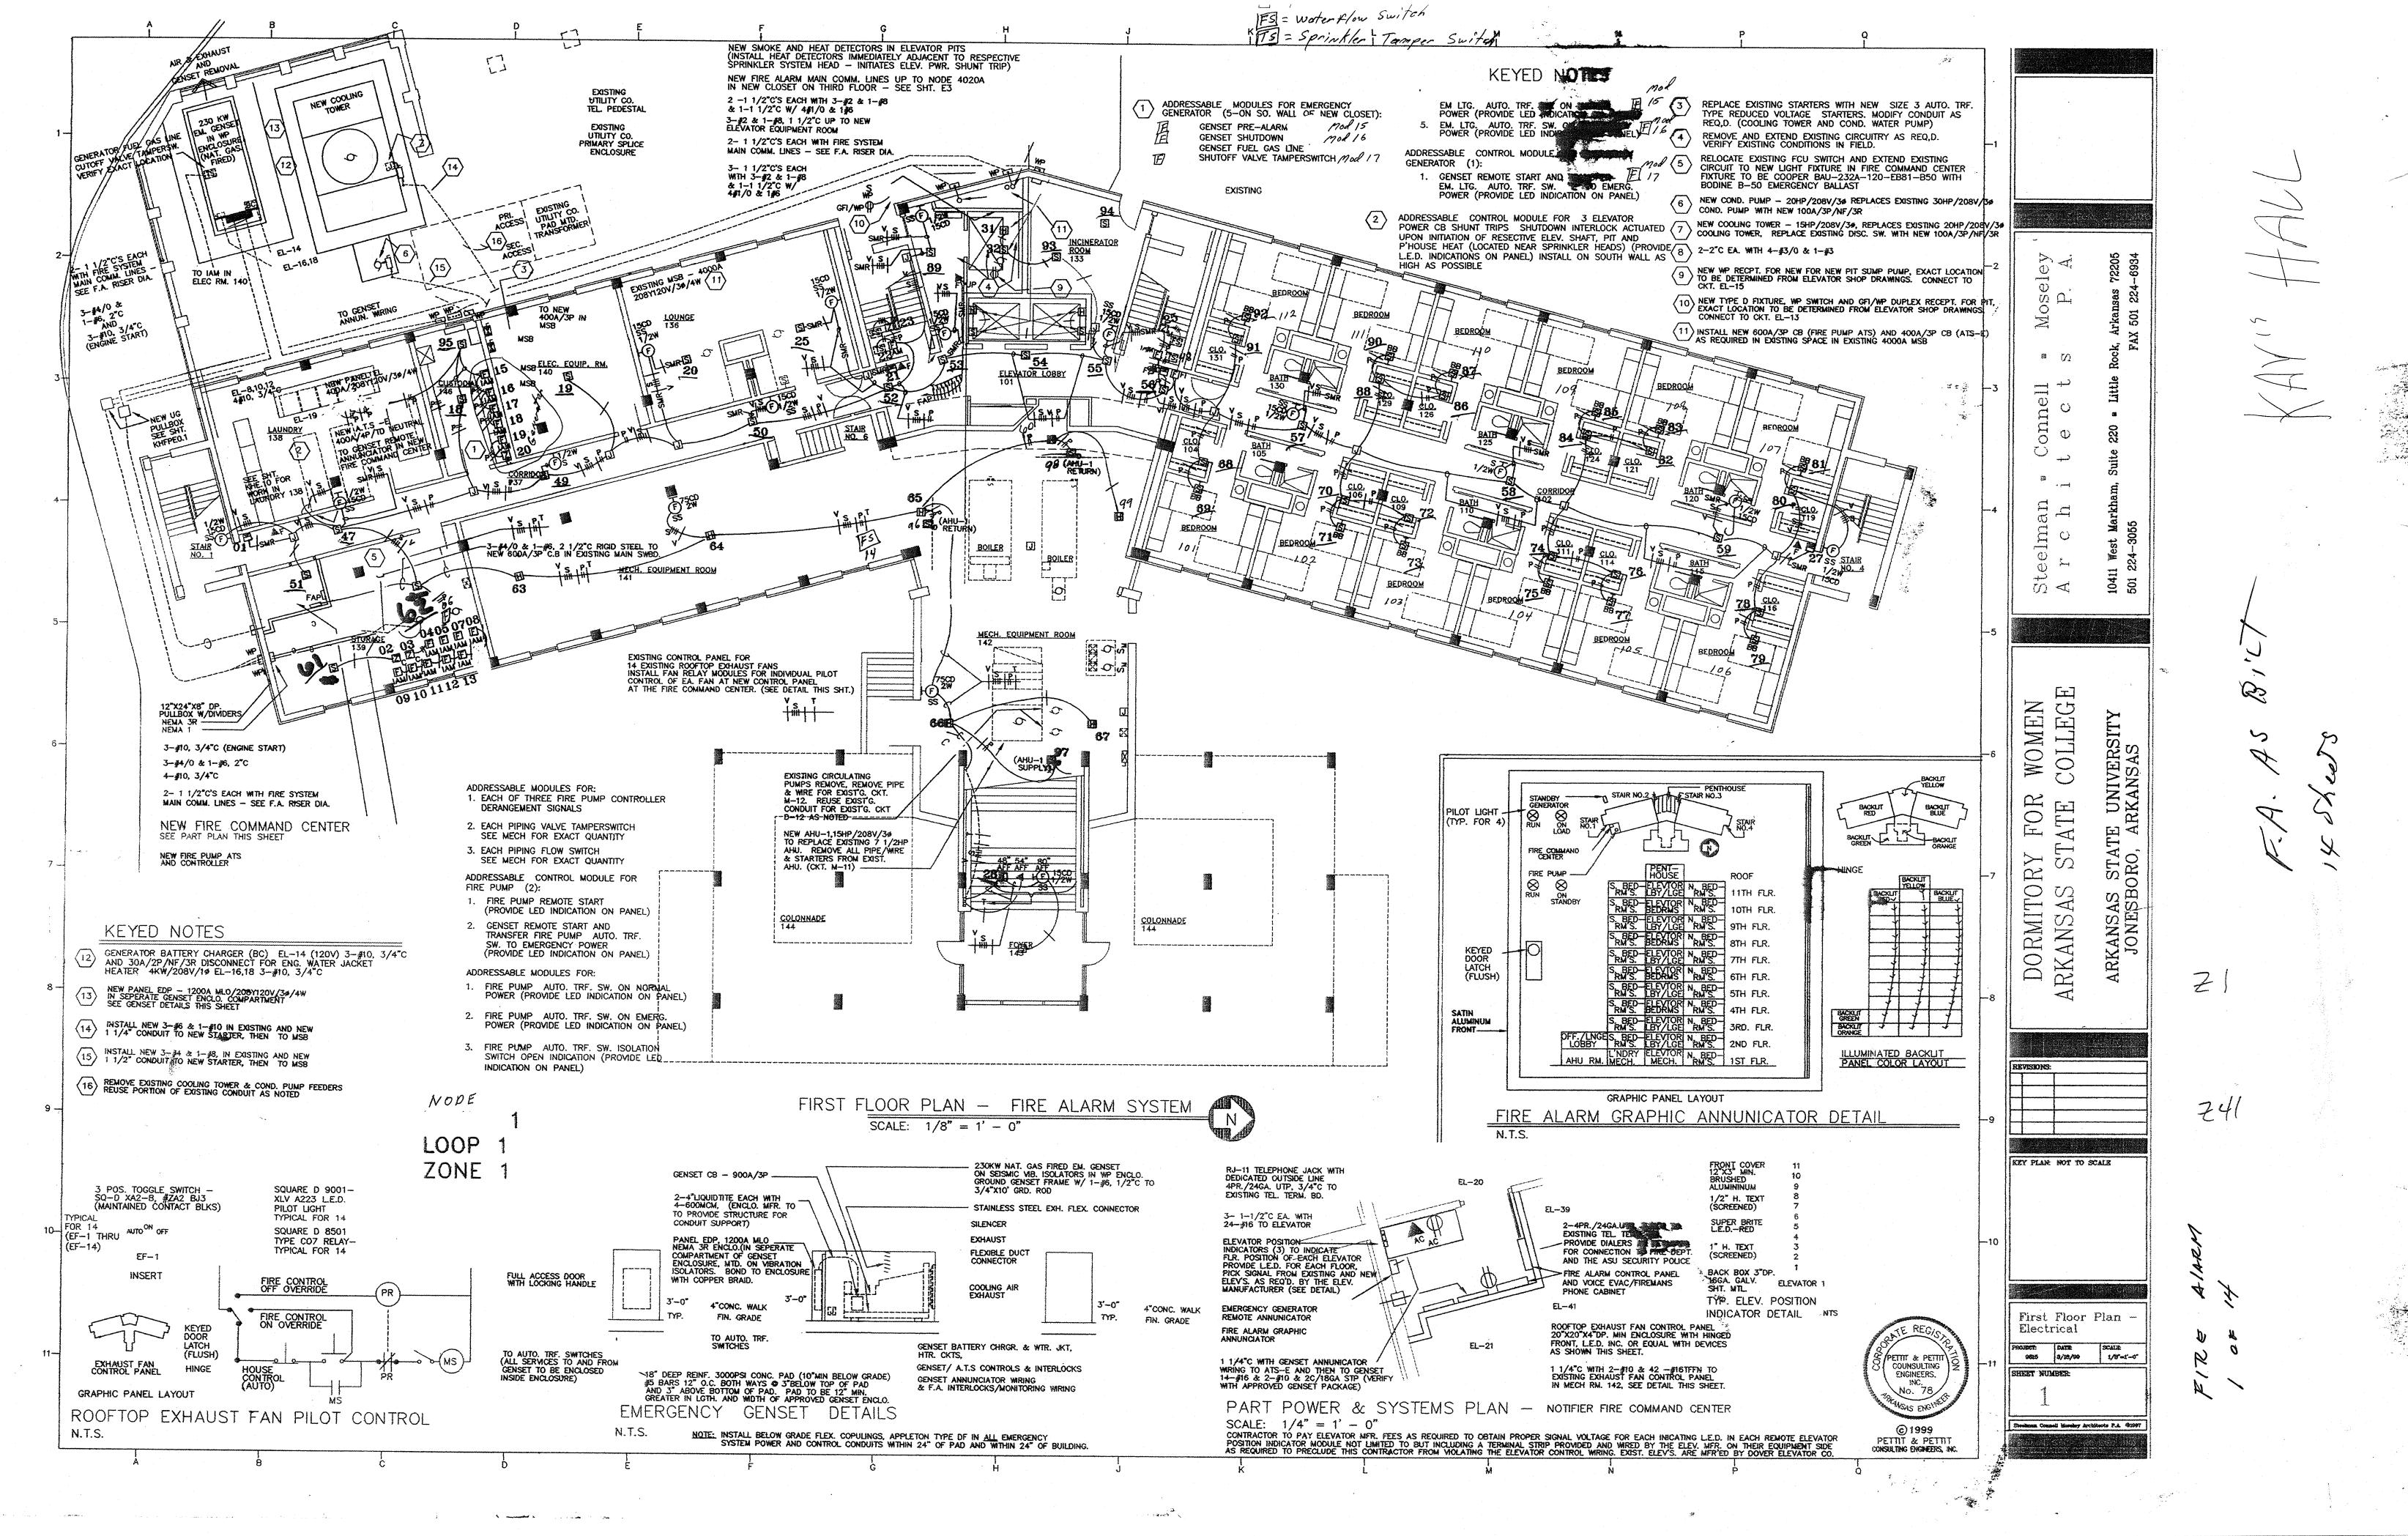


) - Ser

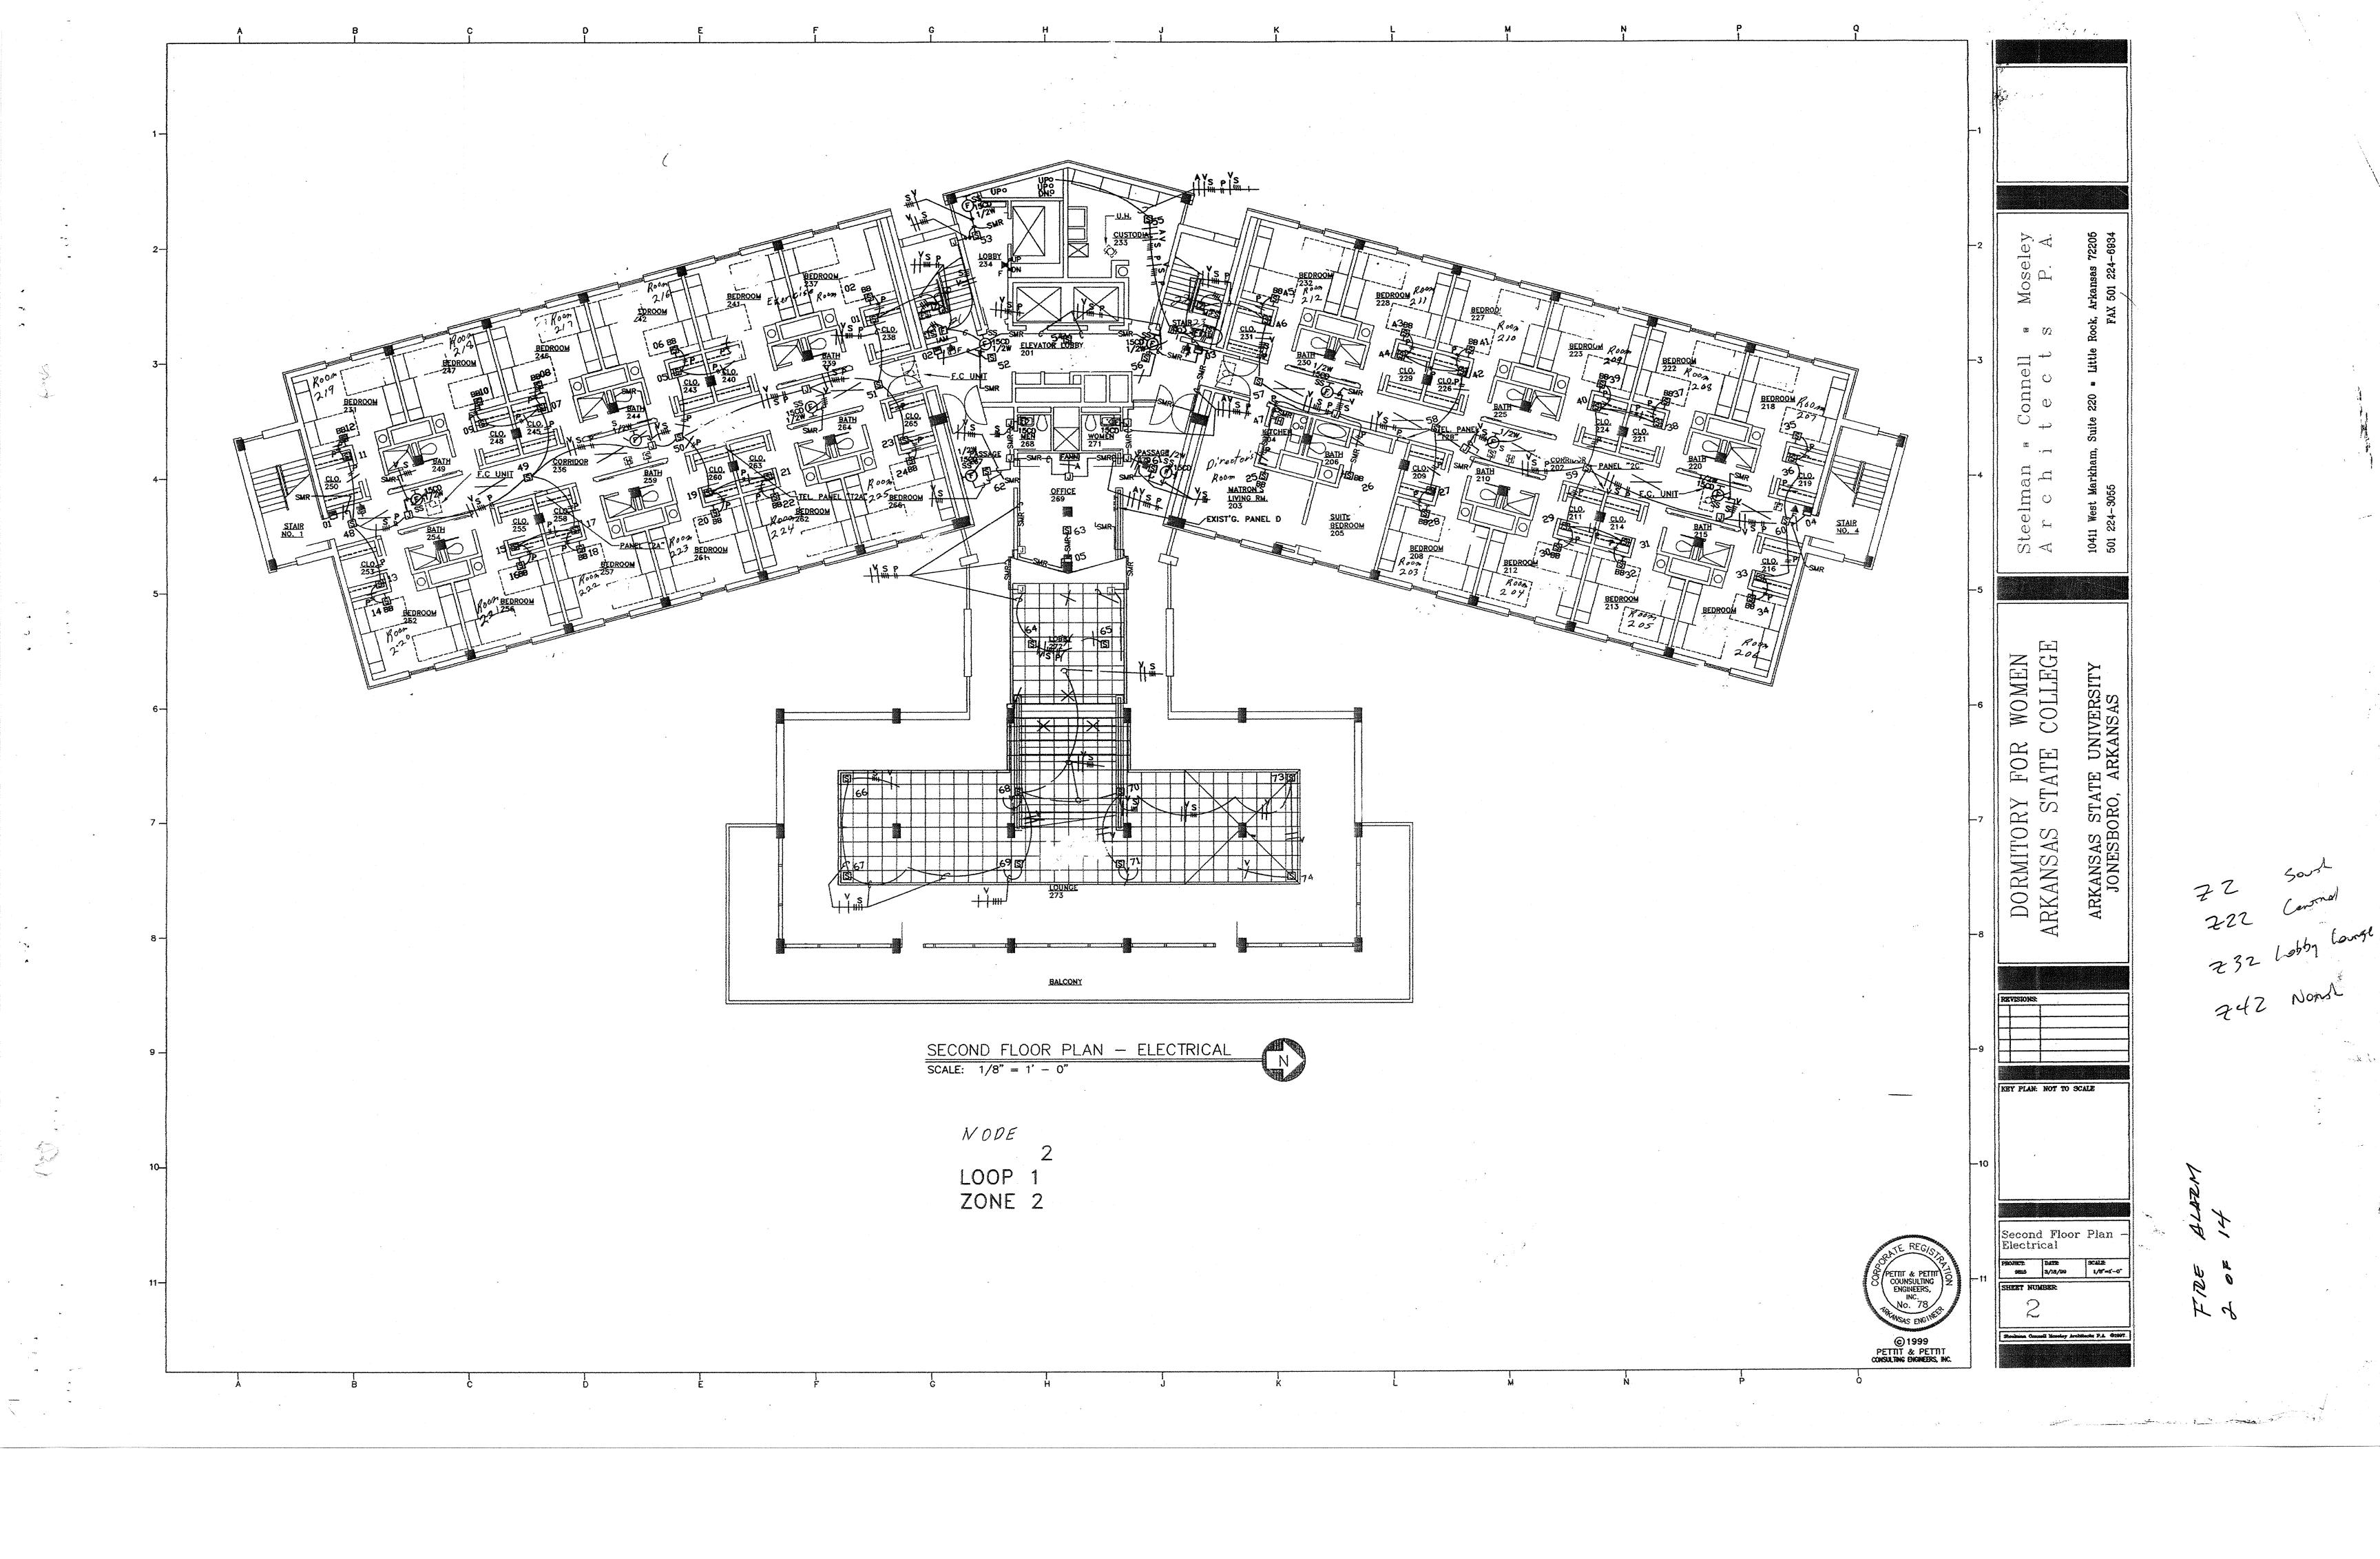

INSERT @ CORR. 337 NEW LIGHTING PLAN 1/8" = 1" --\_) \_ .r FOR LOCATION ISI \_\_\_\_ FURR H vLOUNGE CORRIDOR STAIRWELL P \* - WIREMOLD 2100 OR EQ. PAINT TO MATCH MOUNTING SURFACE به ۲ آر 8 DETAIL AT ELEV. LOBBY/LOUNGE • g . \* , r y H . . 10-// 11 .


 $\searrow$ 

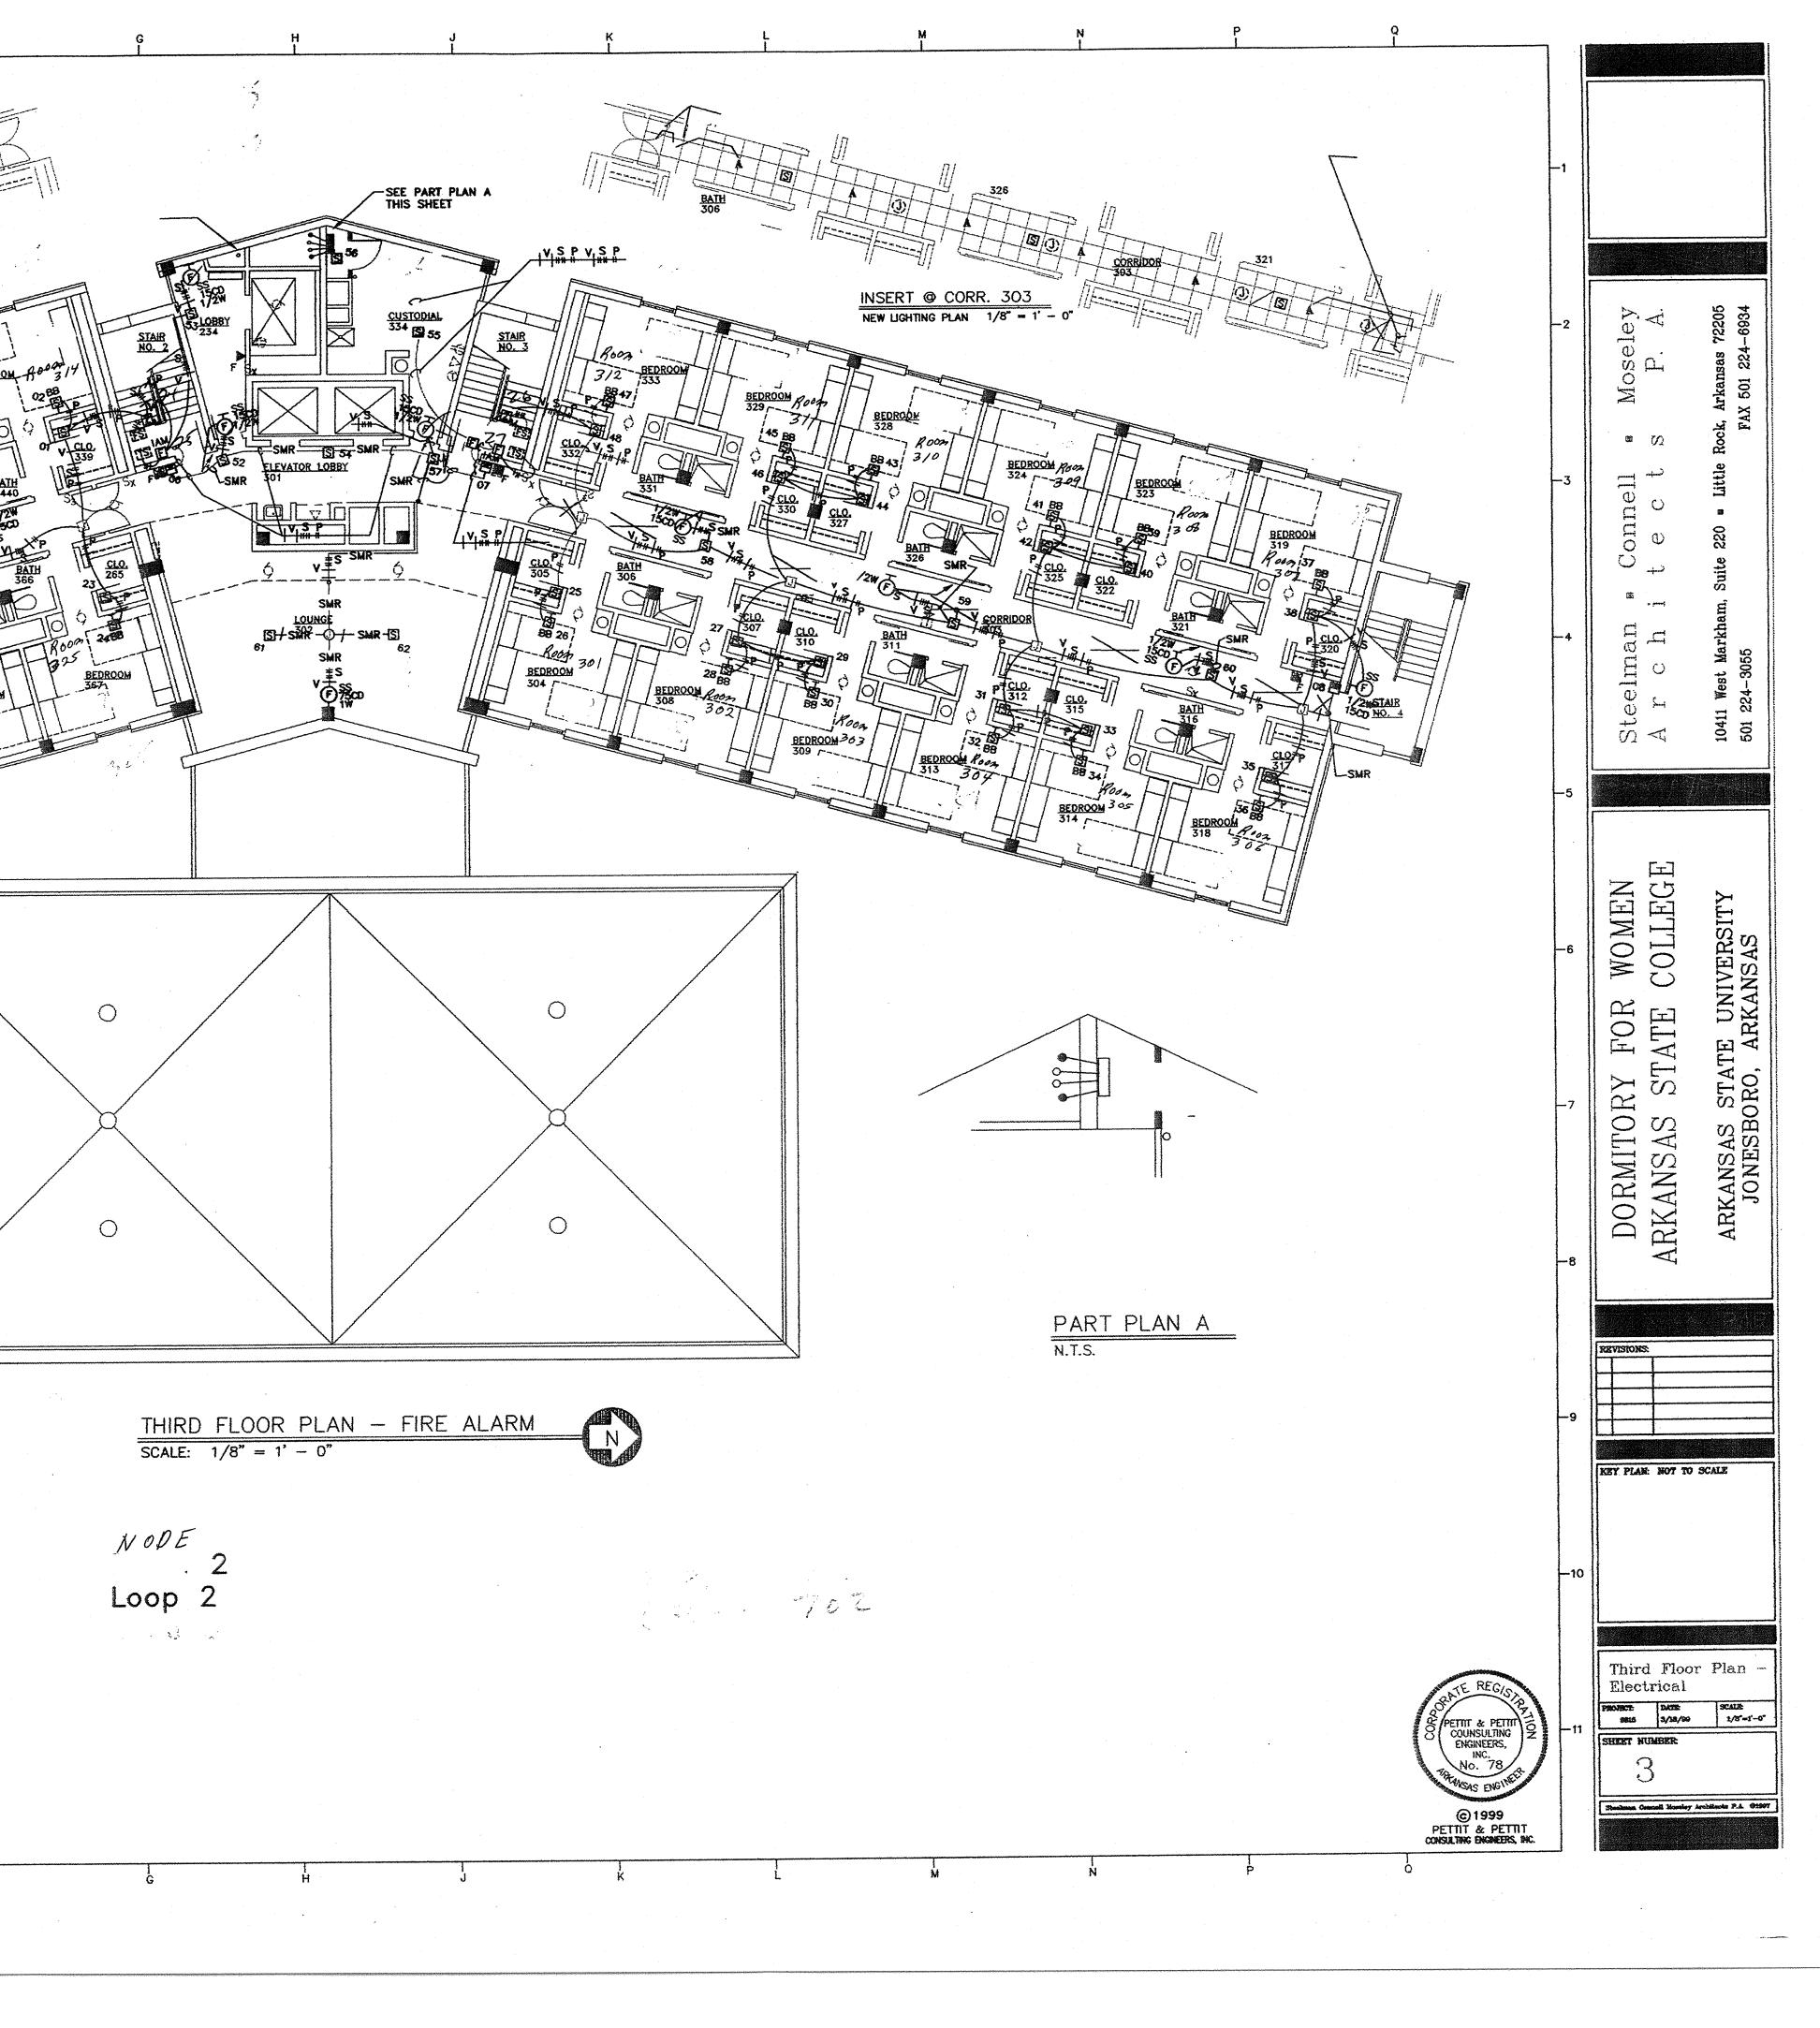


1. N.

•

20 N N

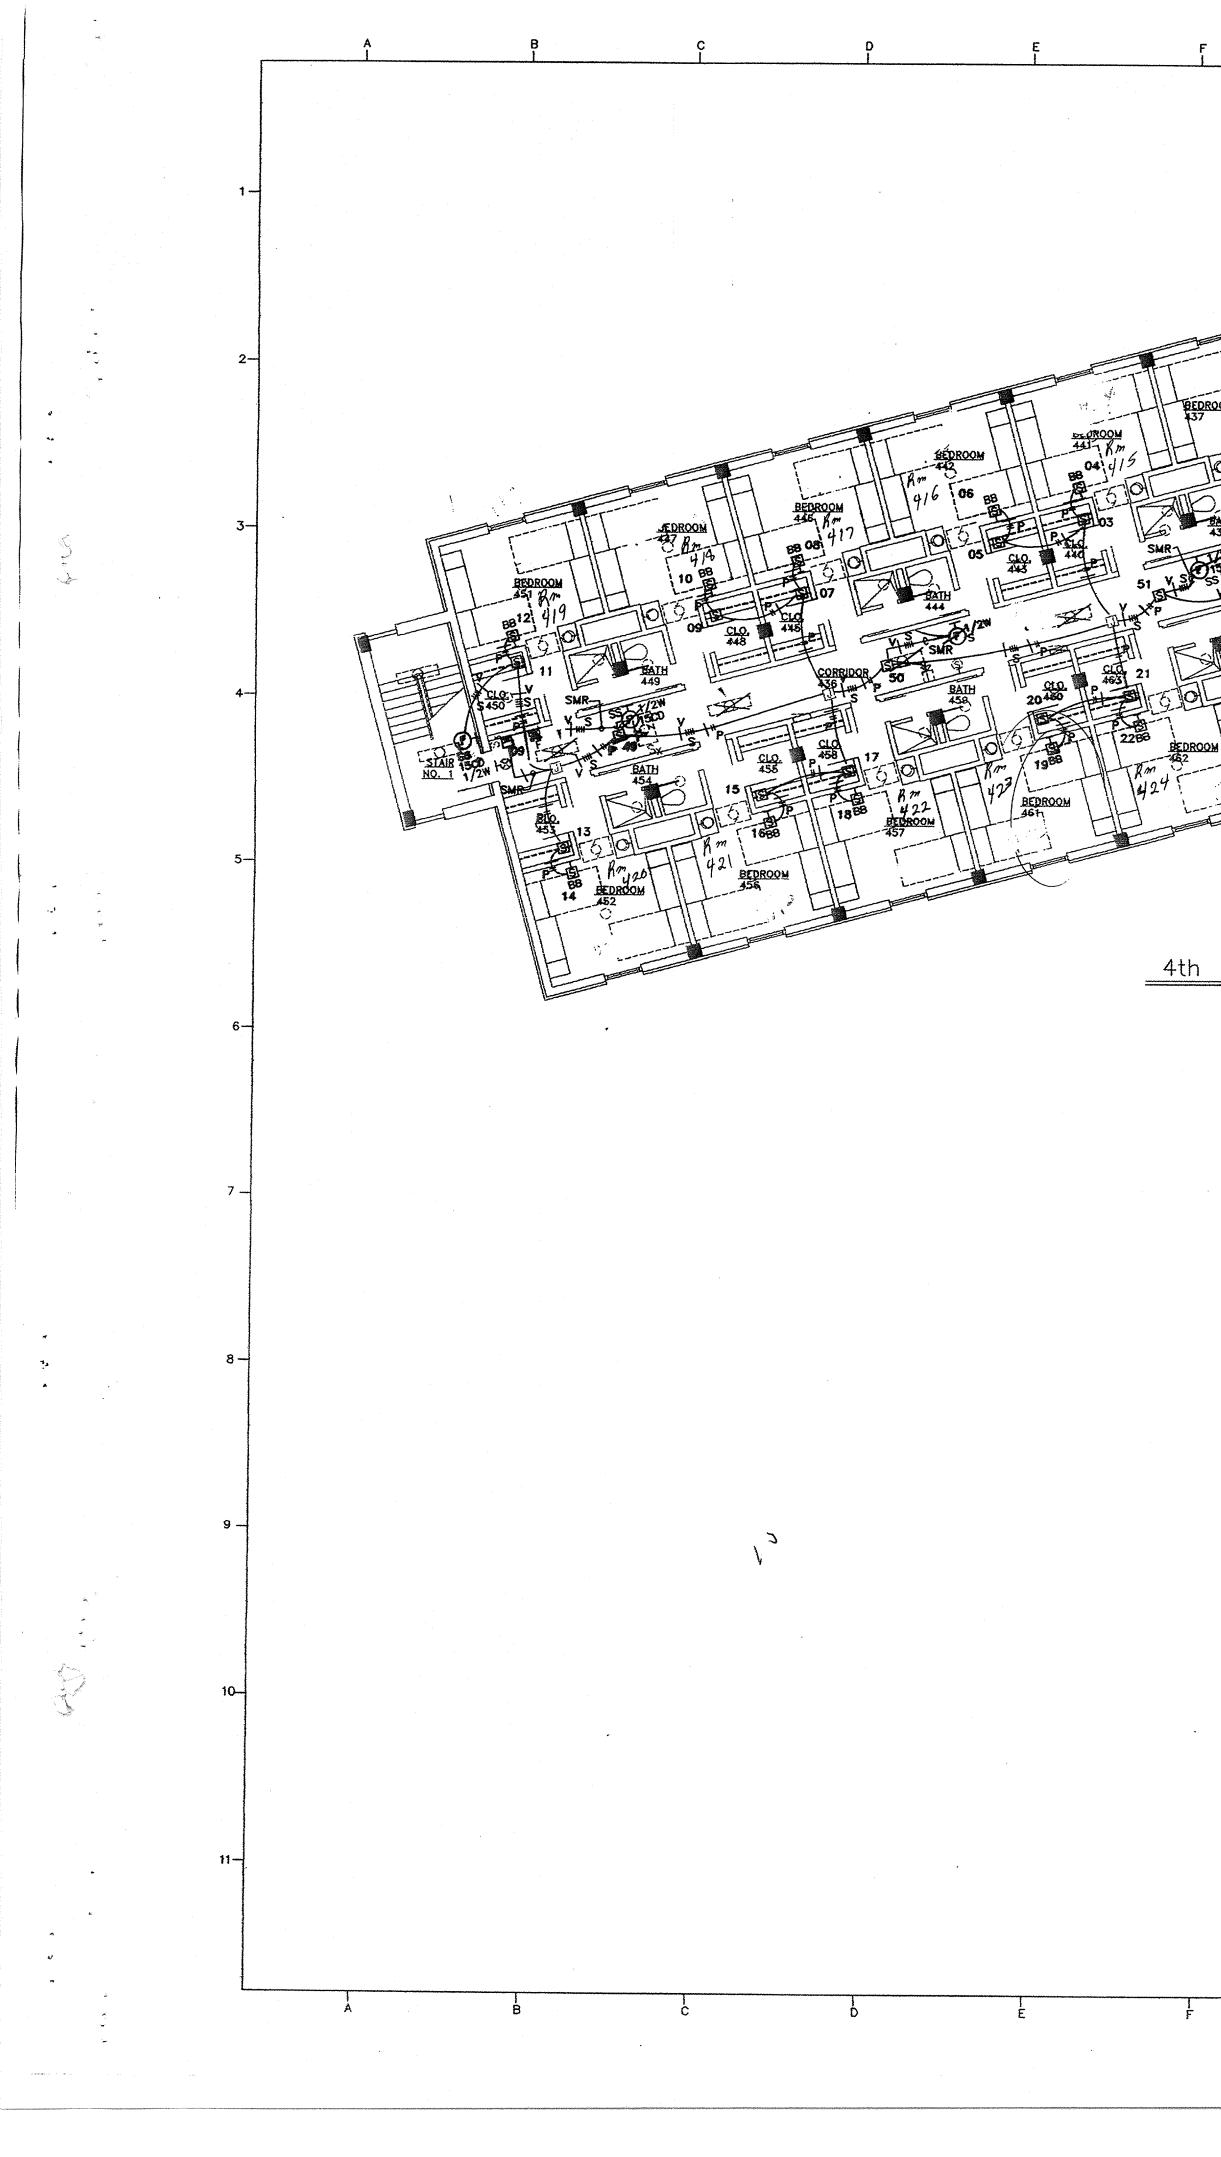


STODIAL BEDROON BEDROOM 4th FLOOR PLAN - FIRE ALARM NODE LOOP 3 ---- @ 8th FLOOR - UP TO 1010 NODE C ON 9th FLOOR 2HR. CHASE EXCLUSIVELY FOR FIRE ALARM WIRING --- 10th FLOOR - DOWN TO 1010 NODE C ON 9th FLOOR TO F.A. DEVICES ON 10th FLOOR TO F.A. DEVICES ON 8th FLOOR UP TO F.A. DEVICES ON 7th FLOOR SEE SHT. KHE.6 DN. TO F.A. DEVICES ON 5th FLOOR - SEE SHT. KHE.6 -**o**-+ MAIN COMM. LINES DOWN TO 1010 NODE A ON 3rd FLOOR SEE SHT. KHE.4------E6-32 <u>\_S</u>-MAIN COMM. LINES UP TO 1010 NODE C ON 9th FLOOR - SEE SHT. KHE.6------ TO 6th FLOOR F.A.
 DEVICES UP TO 9th FLR .-E6-30,34 MAIN COMM. LINES DOWN TO FIRST FLOOR SEE KHE.1 -DOWN TO 3rd FLOOR PART PLAN A 1010 NODE B CLOSET ON 6th FLOOR ONLY N.T.S. Ŵ Ň Н G • •.

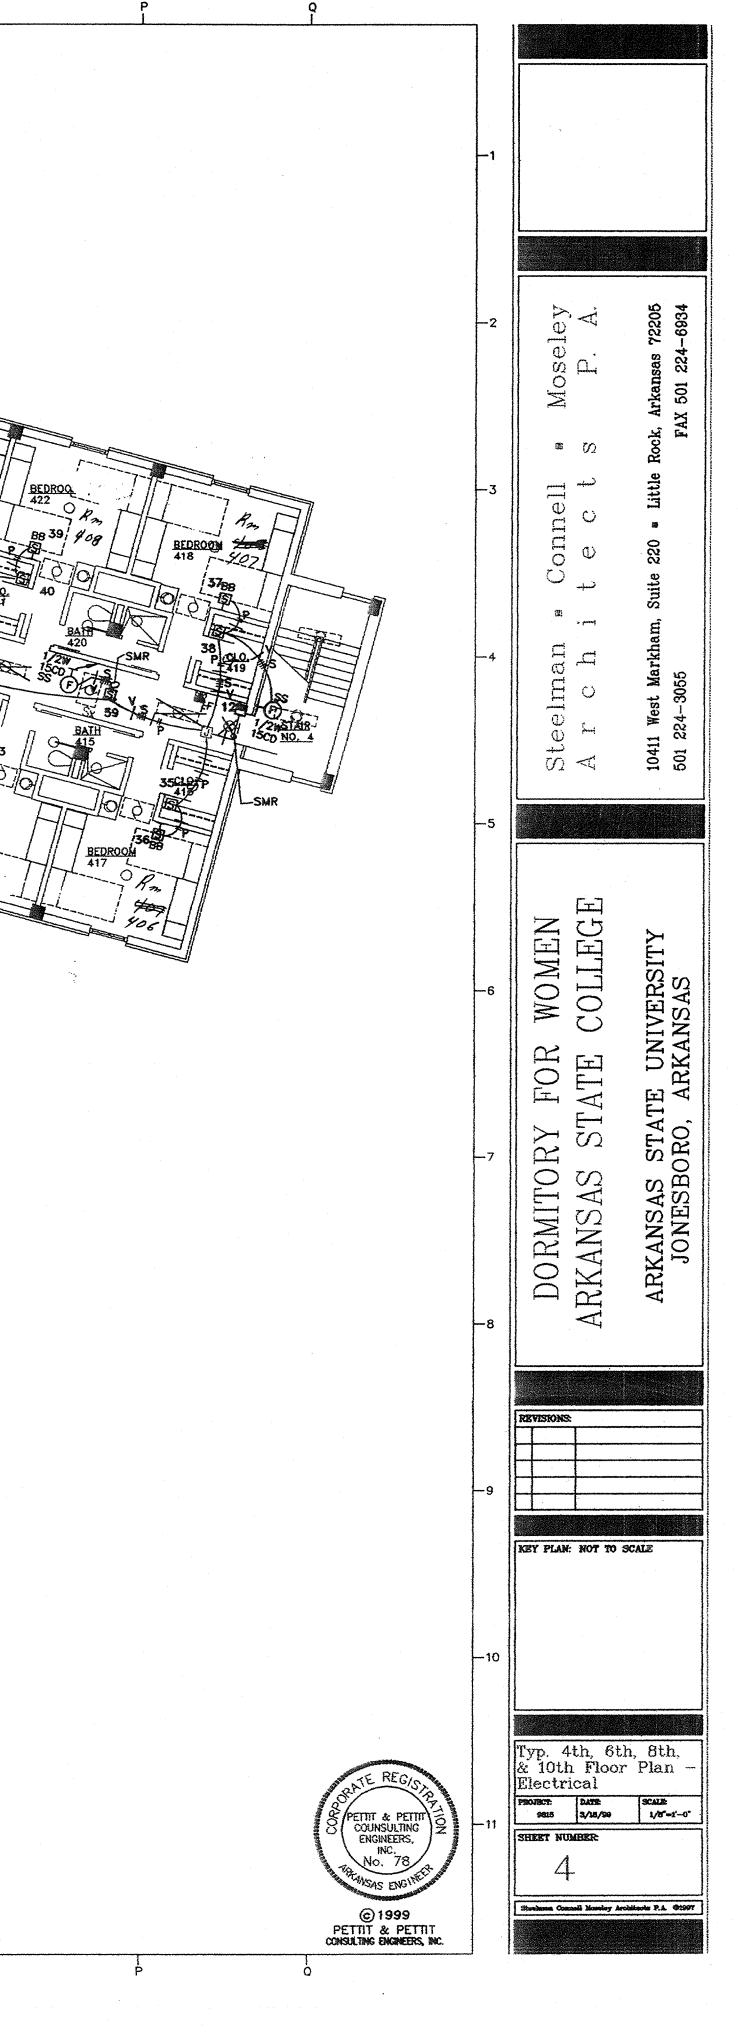


2  $\mathbf{\tilde{\mathbf{v}}}$ N

٠ ر

. 1 e

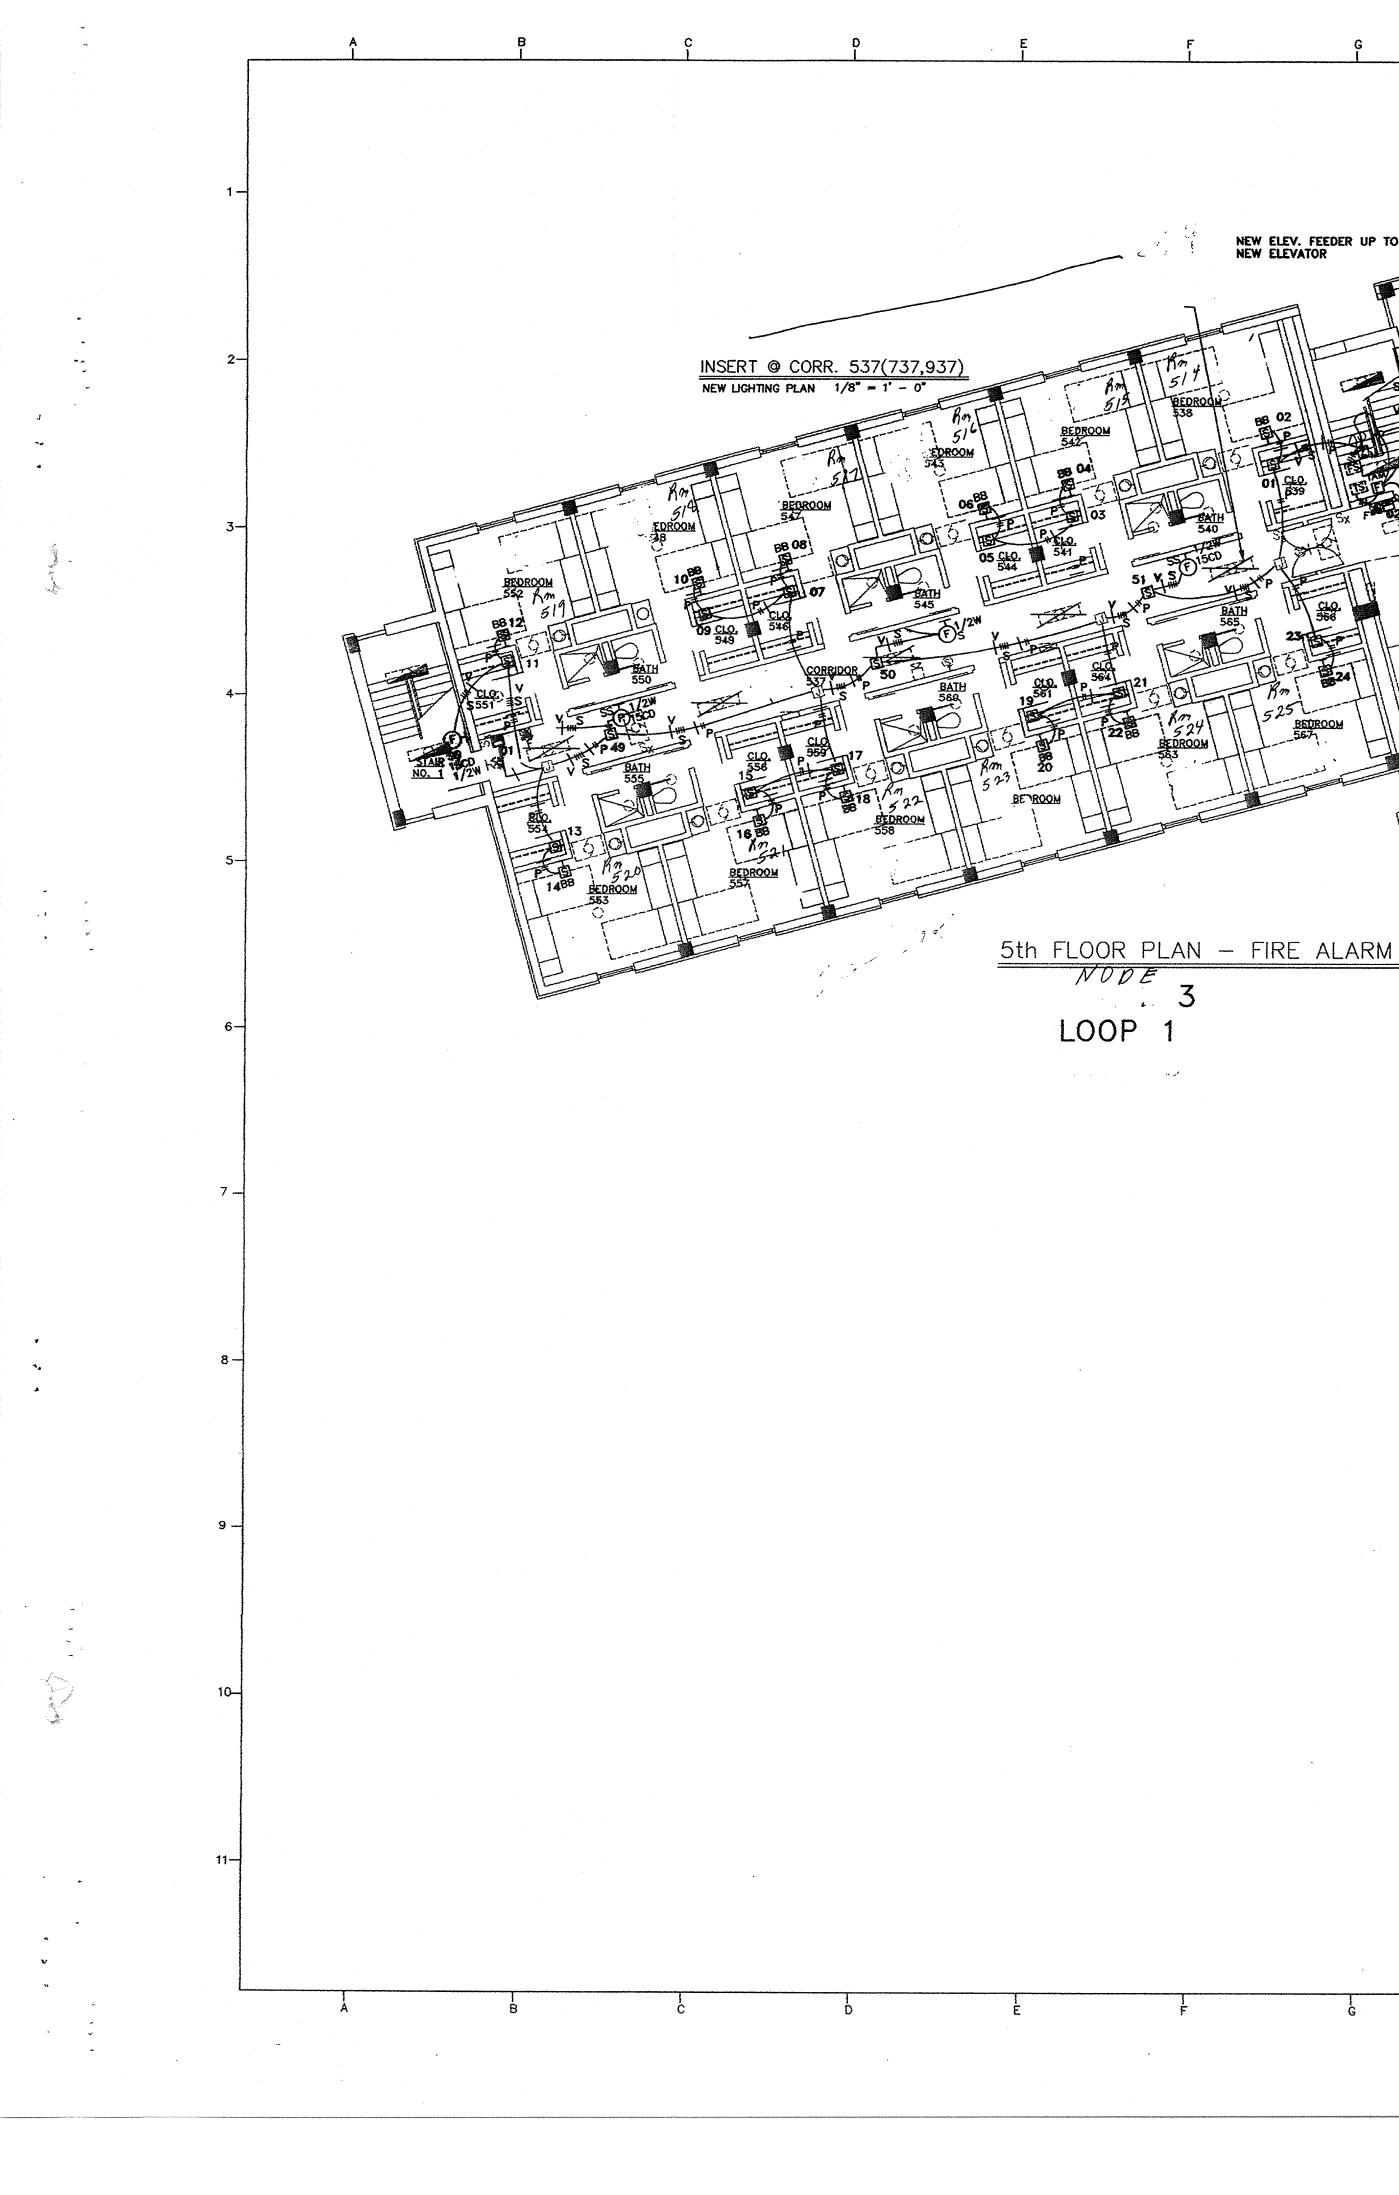


NEW ELEV. FEEDER UP TO NEW ELEVATOR Star Lan INSERT @ CORR 503(703,903) NEW LIGHTING PLAN 1/8 - 1' - 0" NEW LIGHTING PLAN 510 BEDRO 528 17 00 509 BEDROOM [6] BEDROOM EDROOL UP TO F.A. DEVICES IN ELEV. PENTHOUSE, SEE SHT. KHE.8-UP TO F.A. DEVICES ON 11tH FLOOR - SEE SHT. KHE.7 UP TO F.A. DEVICES ON 10th FLOOR - SEE SHT. KHE,5 MAIN LINE COMM. DOWN TO 1010 ON 6th FLR. . . . .

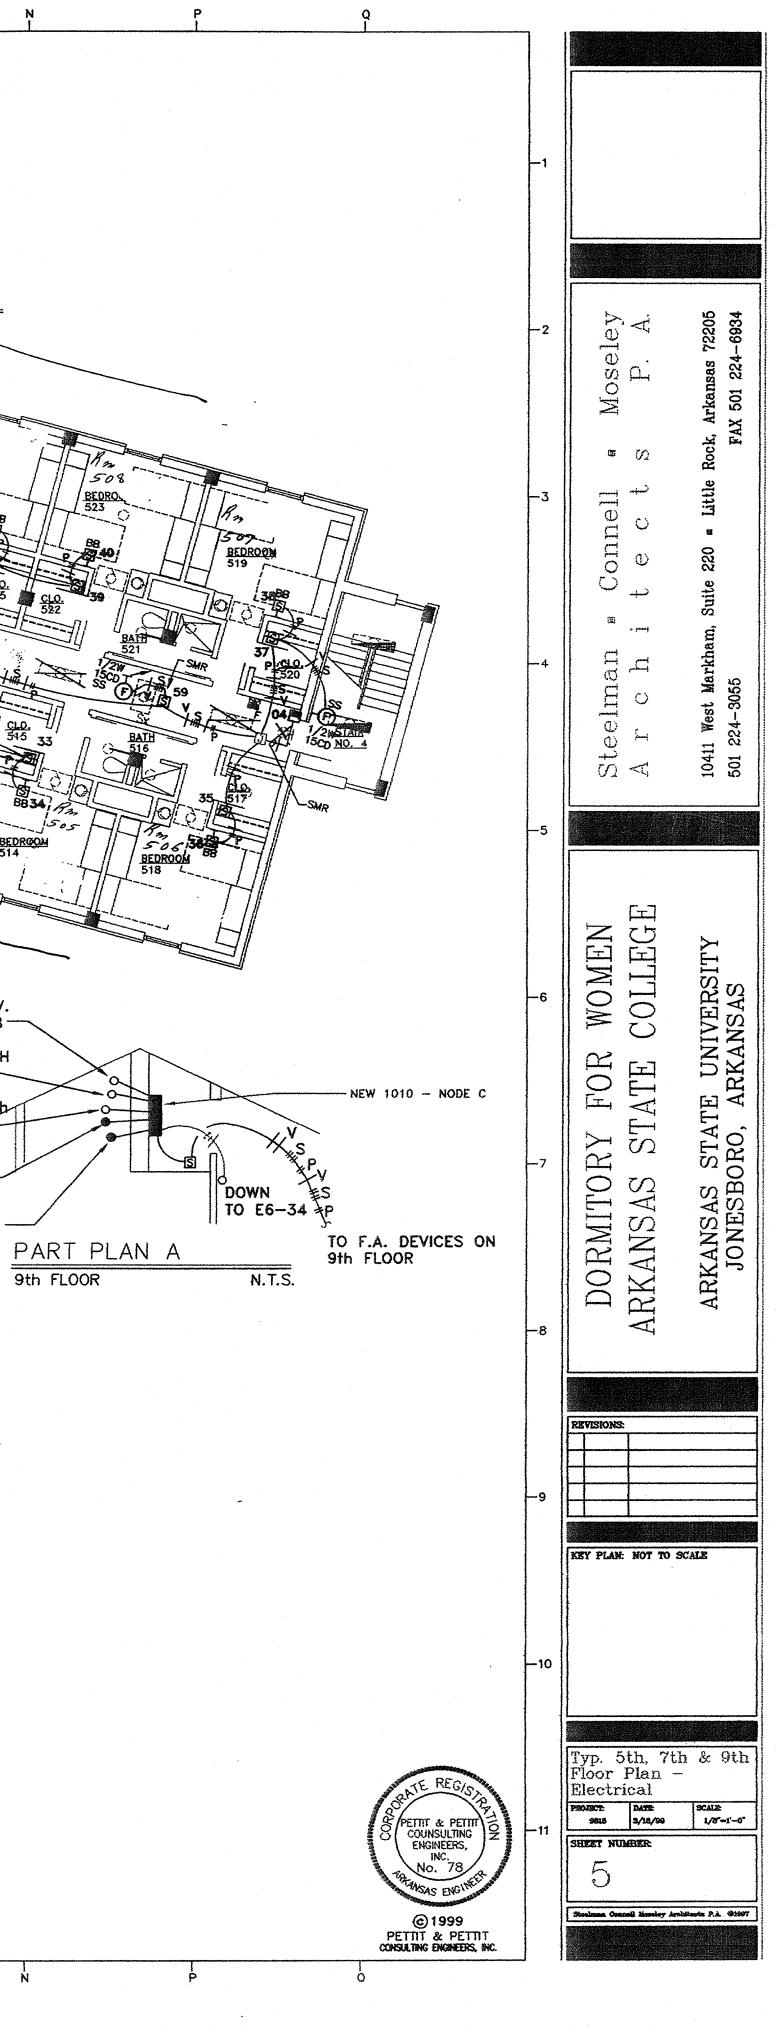

R  $\sim$ 

•

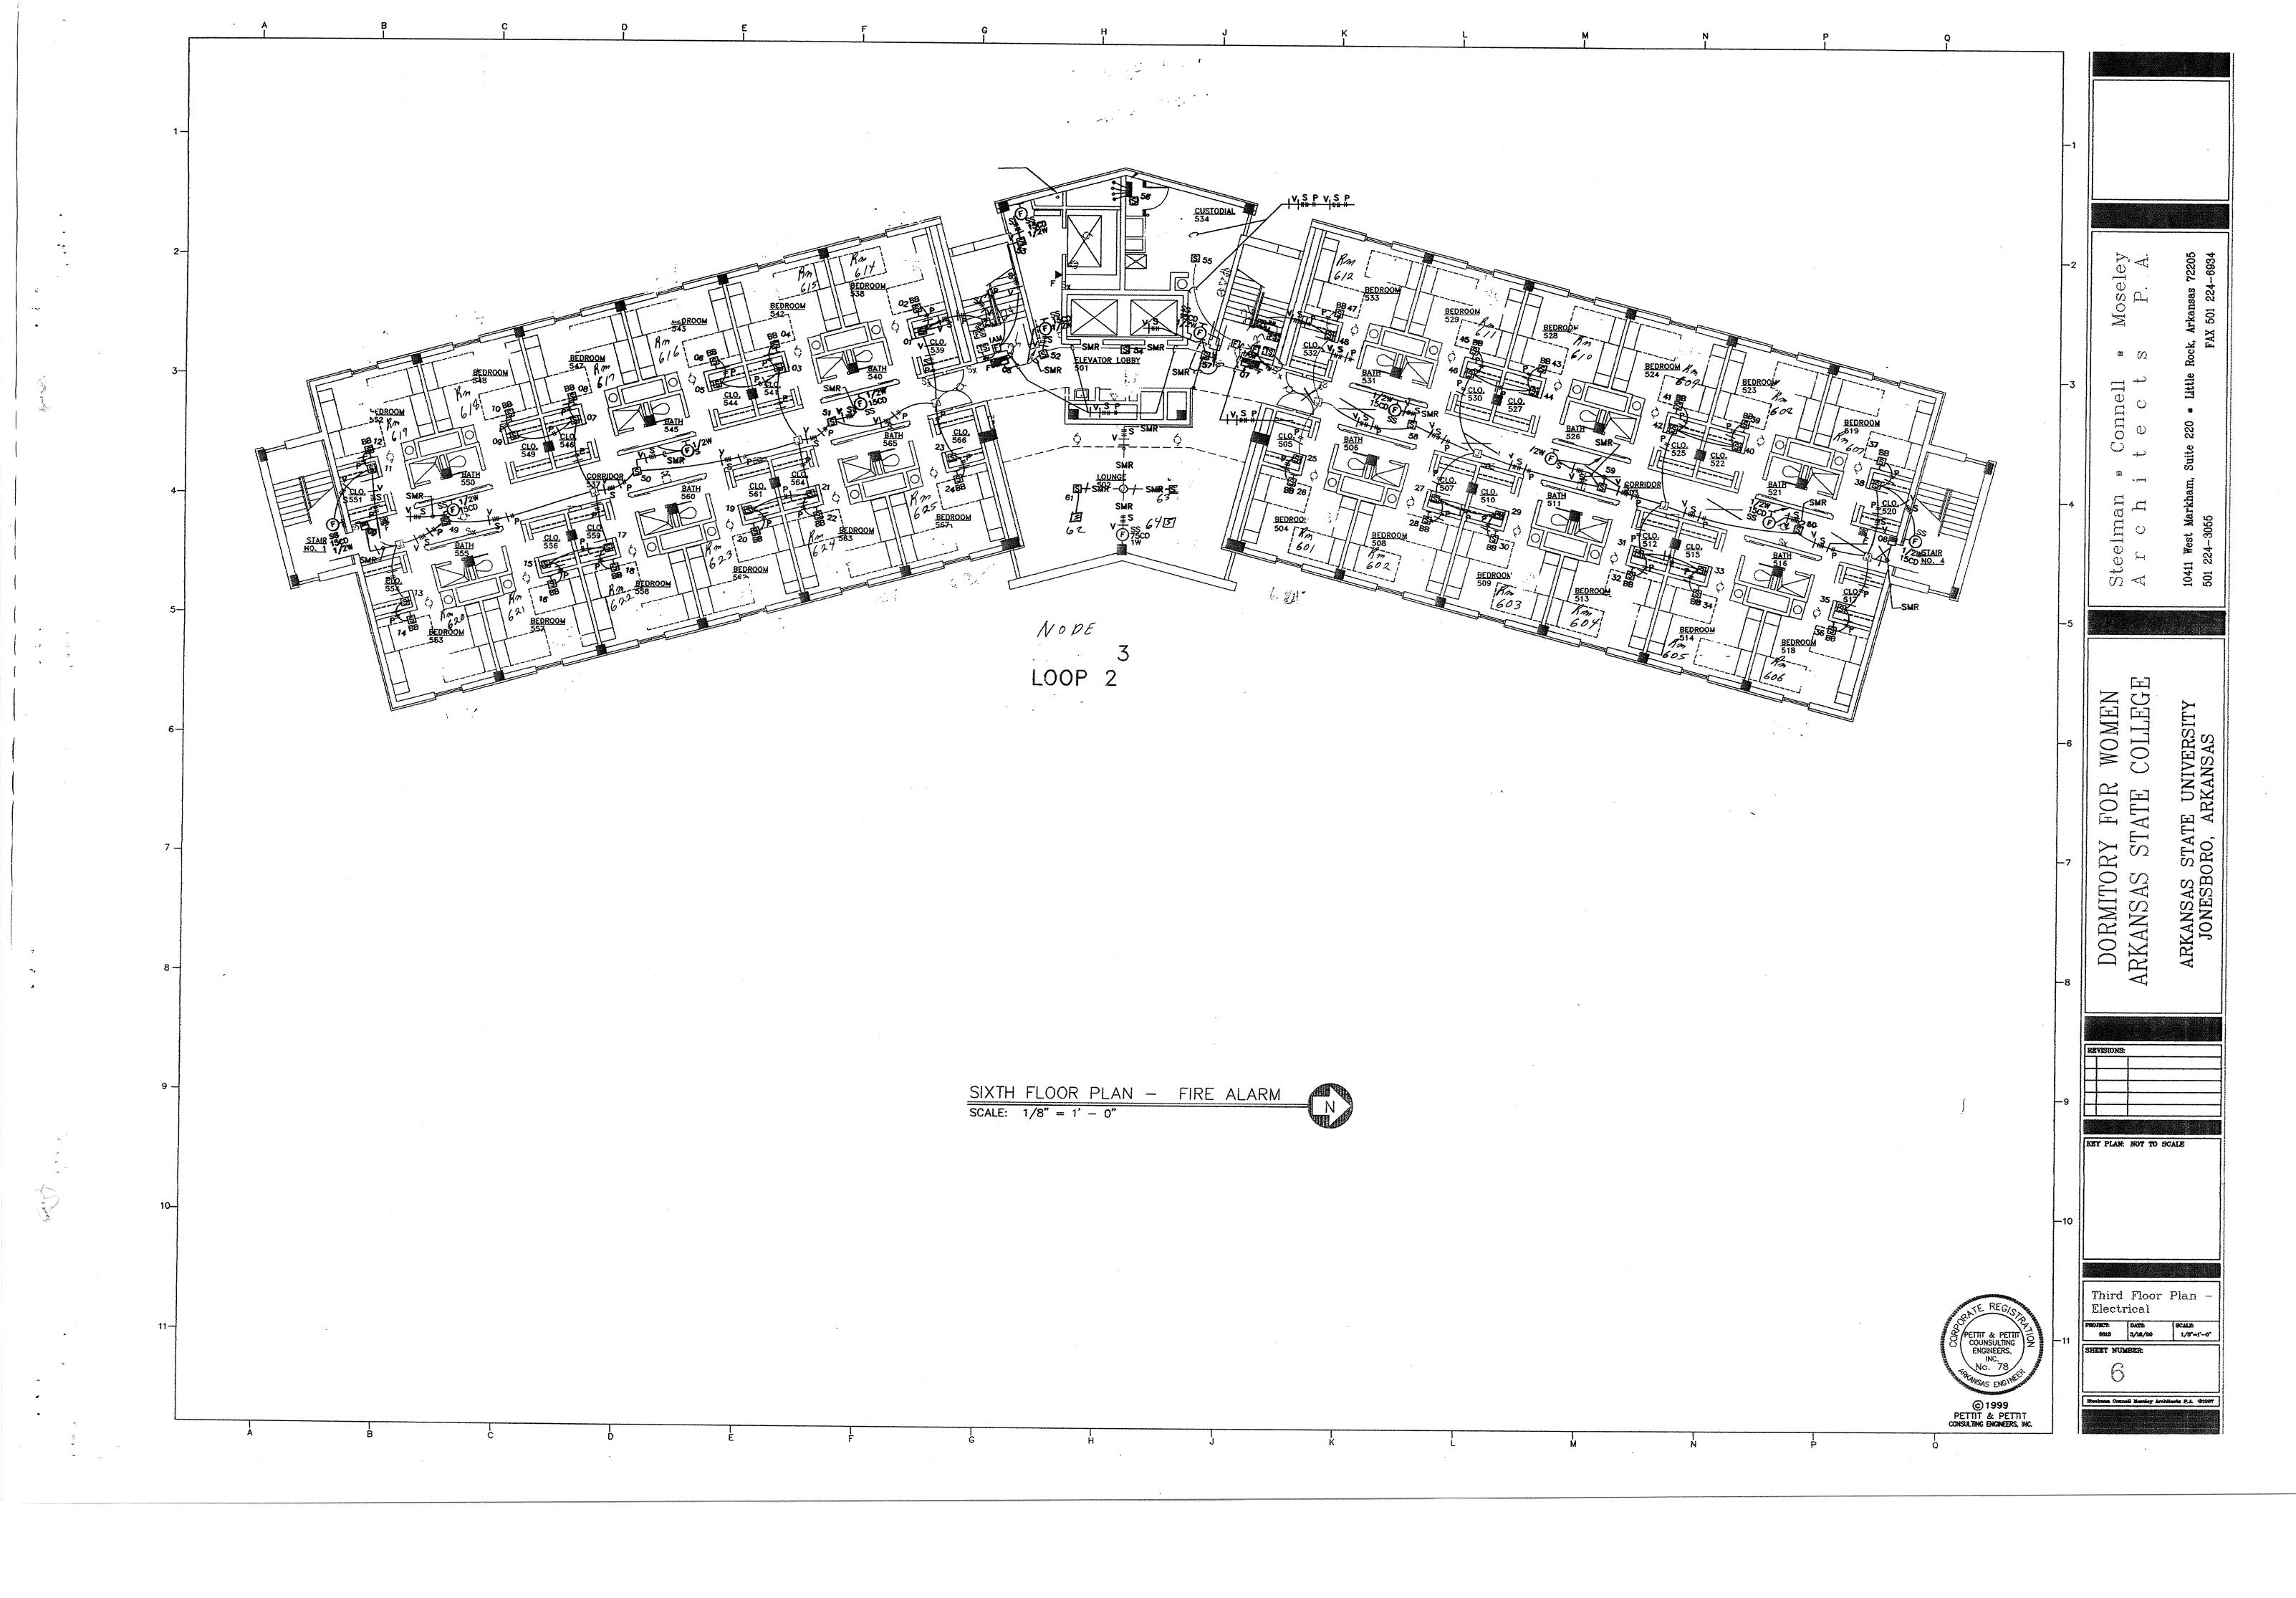

6 19

NEW ELEV. FEEDER UP TO NEW ELEVATOR INSERT @ CORR. 503(703,903) NEW LIGHTING PLAN  $1/8^{\circ} = 1^{\circ} - 0^{\circ}$ INSERT @ CORR. 537(737,937) NEW LIGHTING PLAN 1/8" = 1' - 0" BEDROOM 7th FLOOR PLAN - FIRE ALARM NOPE 3 UP TO F.A. DEVICES IN ELEV. PENTHOUSE, SEE SHT. KHE.8-LOOP 3 . • UP TO F.A. DEVICES ON 11HH FLOOR - SEE SHT. KHE.7 UP TO F.A. DEVICES ON 10th FLOOR - SEE SHT. KHE,5 MAIN LINE COMM. DOWN TO 1010 ON 6th FLR. 7 ---2000 MAIN-LINE COMM. DOWN TO 1st FLOOR THEN TO FAP ----DESCRIPTION SYMBOL STABOL DESCRIPTION DESCRIPTION STAROL | BRANCH CIRCUIT IN CONDUIT - SWITCH LEG, PHASE LEG, NEUTRAL, EQUIPMENT INDIVIDUAL ADDRESSABLE MODULES 9th FLOOR EIAN 5-HTZ-5 FLUORESCENT LIGHT FIXTURE - CEILING MOUNTED  $\Box$ ground, and isolated ground indicated FLUORESCENT LIGHT FIXTURE CONNECTED TO EMERGENCY POWER CIRCUIT BRANCH CIRCUIT HOMERUN - PANEL AND CIRCUIT NUMBER INDICATED FRE ALARM SYSTEM FAULT ISOLATOR MODULE E, FLUCRESCENT STRIP LIGHT - CEILING MOUNTED OR CHAIN HUNG ZONE ADDRESSABLE CONTROL MODULE [Z]<sub>C</sub> 8-D1/2W F.A.VOICE EVAC SYSTEM RECESSED CELLING SPEAKER, 8", NUMBER INDICATES WATTAGE TAP, "S" INDICATES SPEAKER ONLY FLUORESCENT LIGHT FIXTURE - WALL MOUNTED -----S EXISTING CONDUIT DI/2W F.A. VOICE EVAC SYSTEM RECESSED CEILING SPEAKER/STROBE, 8". NUMBER INDICATES WATTAGE TAP, CD INDICATES MIN CANDELA RATING OF STROBE FLUORESCENT LIGHT FIXTURE - WALL MOUNTED EMERGENCY CIRCUIT(S) (SHOWN WITH NON-ARCHED LINES) SS T 7500 F.A. VOICE EVAC SPEAKER/STROBE DEVICE (WALL MTD.) - CD NUMBER INDICATES 1/2W INDICATES MINI. CANDELA RATING OF STROBE, W NUMBER INDICATES WATTAGE TAP O INCANDESCENT, FLUORESCENT, OR HID DOWNLICHT FIXTURE - CEILING MOUNTED Р DISCONNECT STATCH TS F.A. VOICE EVAC SYSTEM WALL NTD. SPEAKER, "S" INDICATES SPEAKER ONLY NUMBER INDICATES WATTAGE TAP Incandescent, Fluorescent, or hid downlight fixture - celling mounted connected to emergency power circuit COMBINATION MOTOR STARTER / DISCONNECT SWITCH 函 上 INCANDESCENT, FLUORESCENT, OR HID LIGHT FOXTURE - WALL MOUNTED EXISTING 2 MOTOR STARTER  $(\mathbf{I})$ X THERMOSTAT 9 SURFACE NOUNTED PANELBOARD EXISTING LIGHT FIXTURE RECONNECTED TO NEW EMERGENCY LIGHTING CXT. ABOVE COUNTER AC FLUSH MOUNTED PANELBOARD - EXISTING ALLAND EMERGENCY LIGHT FIXTURE AFF ABOVE FINISH FLOOR EXIT LIGHTS - WALL MT. & CELLING MT. SHOWN - SHADING INDICATES FACE(S), DIRECTIONAL ARROWS SHALL BE AS SHOWN ON PLANS 2 8 7-----TELEPHONE TERMINAL BOARD CKT CIRCUIT FRE ALARM STROBE ONLY (WALL MTD.) - NUMBER INDICATES MINIMUM CANDELA RATING OF STROBE S/S SINGLE-POLE TOGGLE SWITCH NEW / EXISTING Ê<sup>75</sup> GFI GROUND FAULT INTERRUPTING THREE-WAY TOGGLE SWITCH NEW / EXISTING FIRE ALARM PULL STATION, ADDRESSABLE  $S_3/S_3$ B MOUNTED NTD 10-MANUAL MOTOR STARTER WITH OVERLOADS, TOGGLE OPERATED Sa HI HEAT DETECTOR, ADDRESSABLE NON-FUSED DISCONNECT SWITCH NFDS 1 DUPLEX RECEPTACLE SHOKE DETECTOR, ADDRESSABLE S EXISTING ITERCOM SPEAKER TO REMAIN ş DUPLEX RECEPTACLE MOUNTED ABOVE COUNTER TOP - VERIFY MOUNTING HEIGHT WITH ARCHITECTURAL DRAWINGS Ø<sub>xc</sub> SHOKE DETECTOR W/ BUZZER BASE, ADDRESABLE EXISTING F.A. PULLSTA. REMOVE USE FOR NEW FREMANS PHONE SYSTEM ភ្ DUPLEX RECEPTACLE - GROUND FAULT INTERRUPTING, SURGE PROTECTION, 12 H GFI 10 SP (SID DUCT MOUNTED SMOKE DETECTOR HS EXISTING EXIT LIGHT TO REMAIN TWIST-LOCK, & WEATHERPROOF TYPES INDICATED FLOW SWITCH (FURNISHED BY DIVISION 15) CITZII EXIST. SURF. FLUOR. FIXTURE TO REMAIN FREMANS TELEPHONE OUTLET ES: 11-EXIST. SURF. FLUOR. FIXTURE TO BE REMOVED, CONNECT EXISTING CKT. TO WIRE THRU, OR EXTEND TO NEW FIXTURE AS INDICATED TAMPER SWITCH (FURNISHED BY DIVISION 15) STELEPHONE CUTLET - WALL MOUNTED @ 48" A.F.F. U.O.N. IS TELEPHONE OUTLET - MOUNTED ABOVE COUNTER TOP - VERFY MOUNTING HEIGHT WITH ARCHITECTURAL DRAWINGS DOOR HOLDER (FURNISHED BY DIVISION 8) ≪l AC 26 EXIST. RECESSED F.A. HORN - ABANDON IN PLACE Ę ZIM ZONE ADDRESSABLE MONITOR MODULE JUNCTION BOX

•...•


.

:

٩,

L

STMBOL	DESCRIPTION
}¢	F.A. 24V DC POWER #12 AWG WAY.
Å	F.A. ADDRESSABLE ANNAUNCIATOR CABLE SHIELDED TWISTED PAIR
T	F.A. FIREMANS PHONE SYSTEM CABLE UNSHIELDED TWISTED PAIR
	F.A. ADDRESSABLE LOOP CABLE SHIELDED THISTED PAIR
	F.A. VOICE EVAC CABLE UNSHIELDED TWISTED PAIR
	F.A. SIGNAL WIRHIG #12 AWG MIN.
[FANN]	FIRE ALARM SYSTEM ANNUNCIATOR

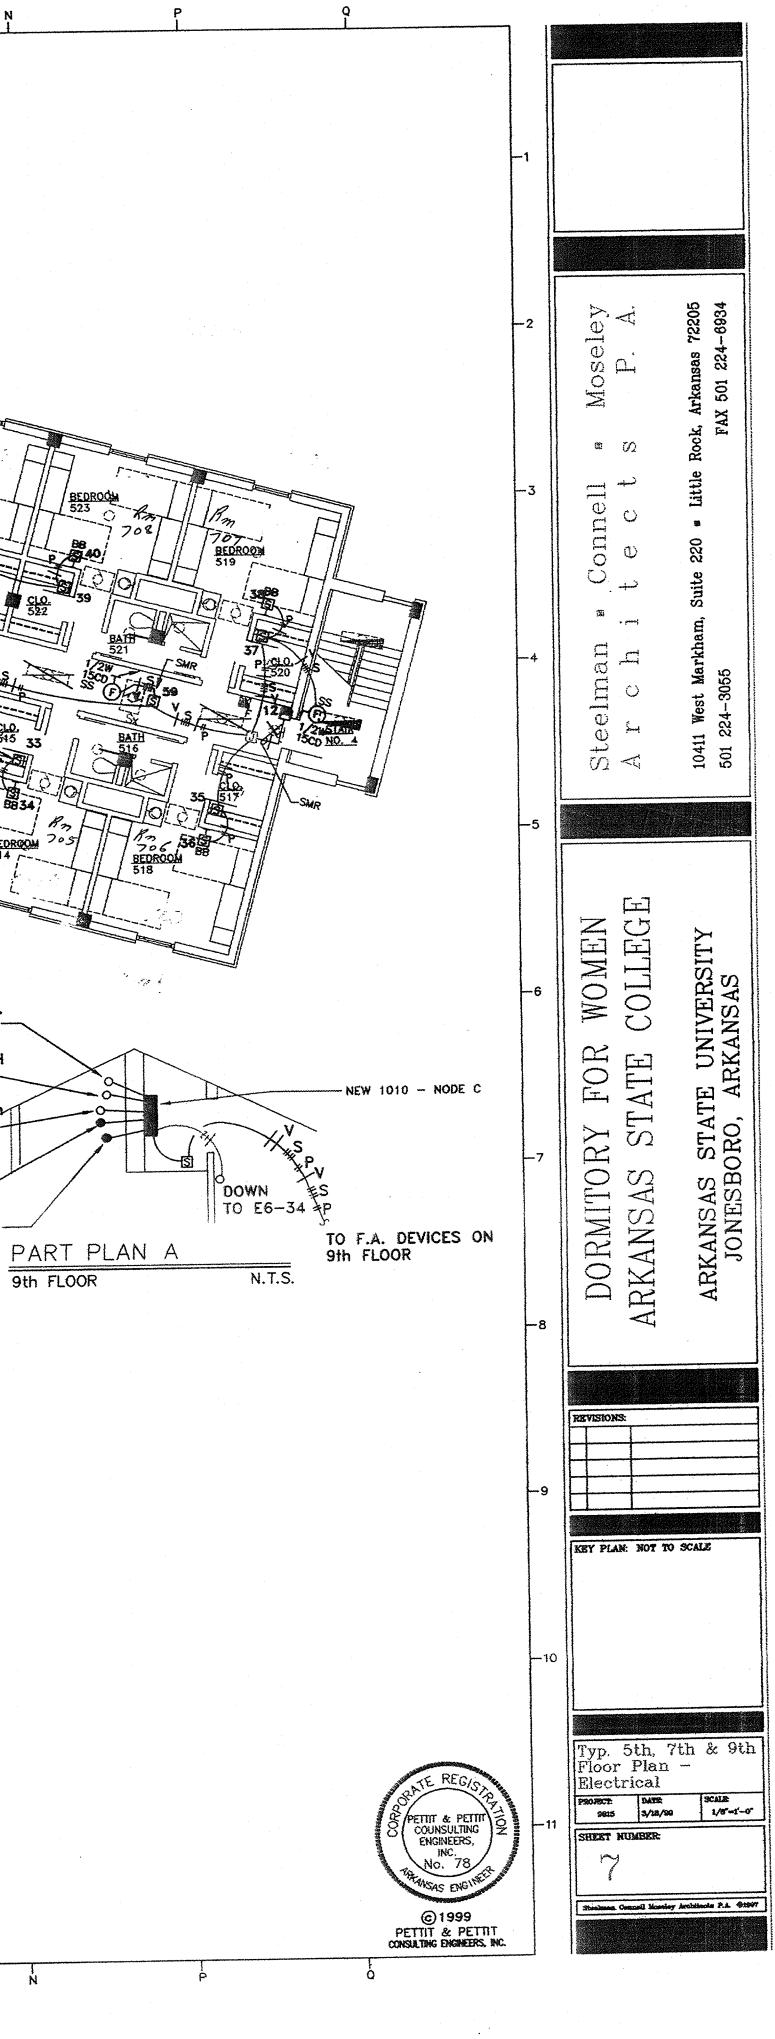


loquie	Report 2	th Floor Node: 3		LOOI	8	-KX	14	 <i>مىينىغ ب</i> ىلمىيە	Page
adule 7 1	Description Mon Pull Sta	Device Label SOUTH STAIRWELL EXIT	A-P	1A-P	t CBE (252262140)	۷V		SII No	WT No
• 2	Mon Pull Sta	ELEVATOR LOBBY EXIT	ă	6	(252352140)			No	No
• 3	Mon Pull Sta	ELEVATOR LOBBY EXIT	ă	ő	(252352140)			No	No
14	Mon Pull Sta	NORTH STAIRWELL EXIT	d .	ő	(2\$2432140)			No	No
° 20	Water Flow	SOUTH CENTER STAIR	d	þ	(7.52140)			No	No
21	Sprvsry Matr	SOUTH CENTER STAIR	đ	35	(225)			No	No
• 22	Water Flow	NORTH CENTER STAIR	d	Ø	(252140)			No	No
723	Sprysry Mntr	NORTH CENTER STAIR	6	35	(Z25)			No	No
6 55	Speaker.	<b>STH FL SPEAKERS</b>	1	12	OR(Z205Z240)			Yes	No
56	Speaker	6TH FL SPEAKERS	1	13	OR(Z206Z240)			Yes	No
57	Speaker	7TH FL SPEAKERS	1	14	OR(22072249)			Yes	No
58	Control	SPARE	9	P	ORO			Yeş	No
\$ 59	Control	STH FL STROBES	9	p	OR(22052240)			No	No
60	Control	6TH FL STROBES	U	ę	OR(Z2062240)			No	No
61	Control	TTH FL STROBES	y .	ò	OR(2207224b)			No	No
62	Control	SPARE	U A	, X	OR() OR(26522052240)			No	No
•63 64	Form C Relay	STH-FL BUZZER BASES 6TH FL BUZZER BASES	U A	8	OR(Z6622062240)			Yes	No
65	Form C Relay Form C Relay	7TH FL BUZZER BASES	0	0	OR(26722072240)			Yes	'No No
00	FOLD C REERY	TH PL DUZZER DASES	U U		010(2012.2012.240)			res	NO

•


.


Nov. 17 2000 03:36PM P15

. . .

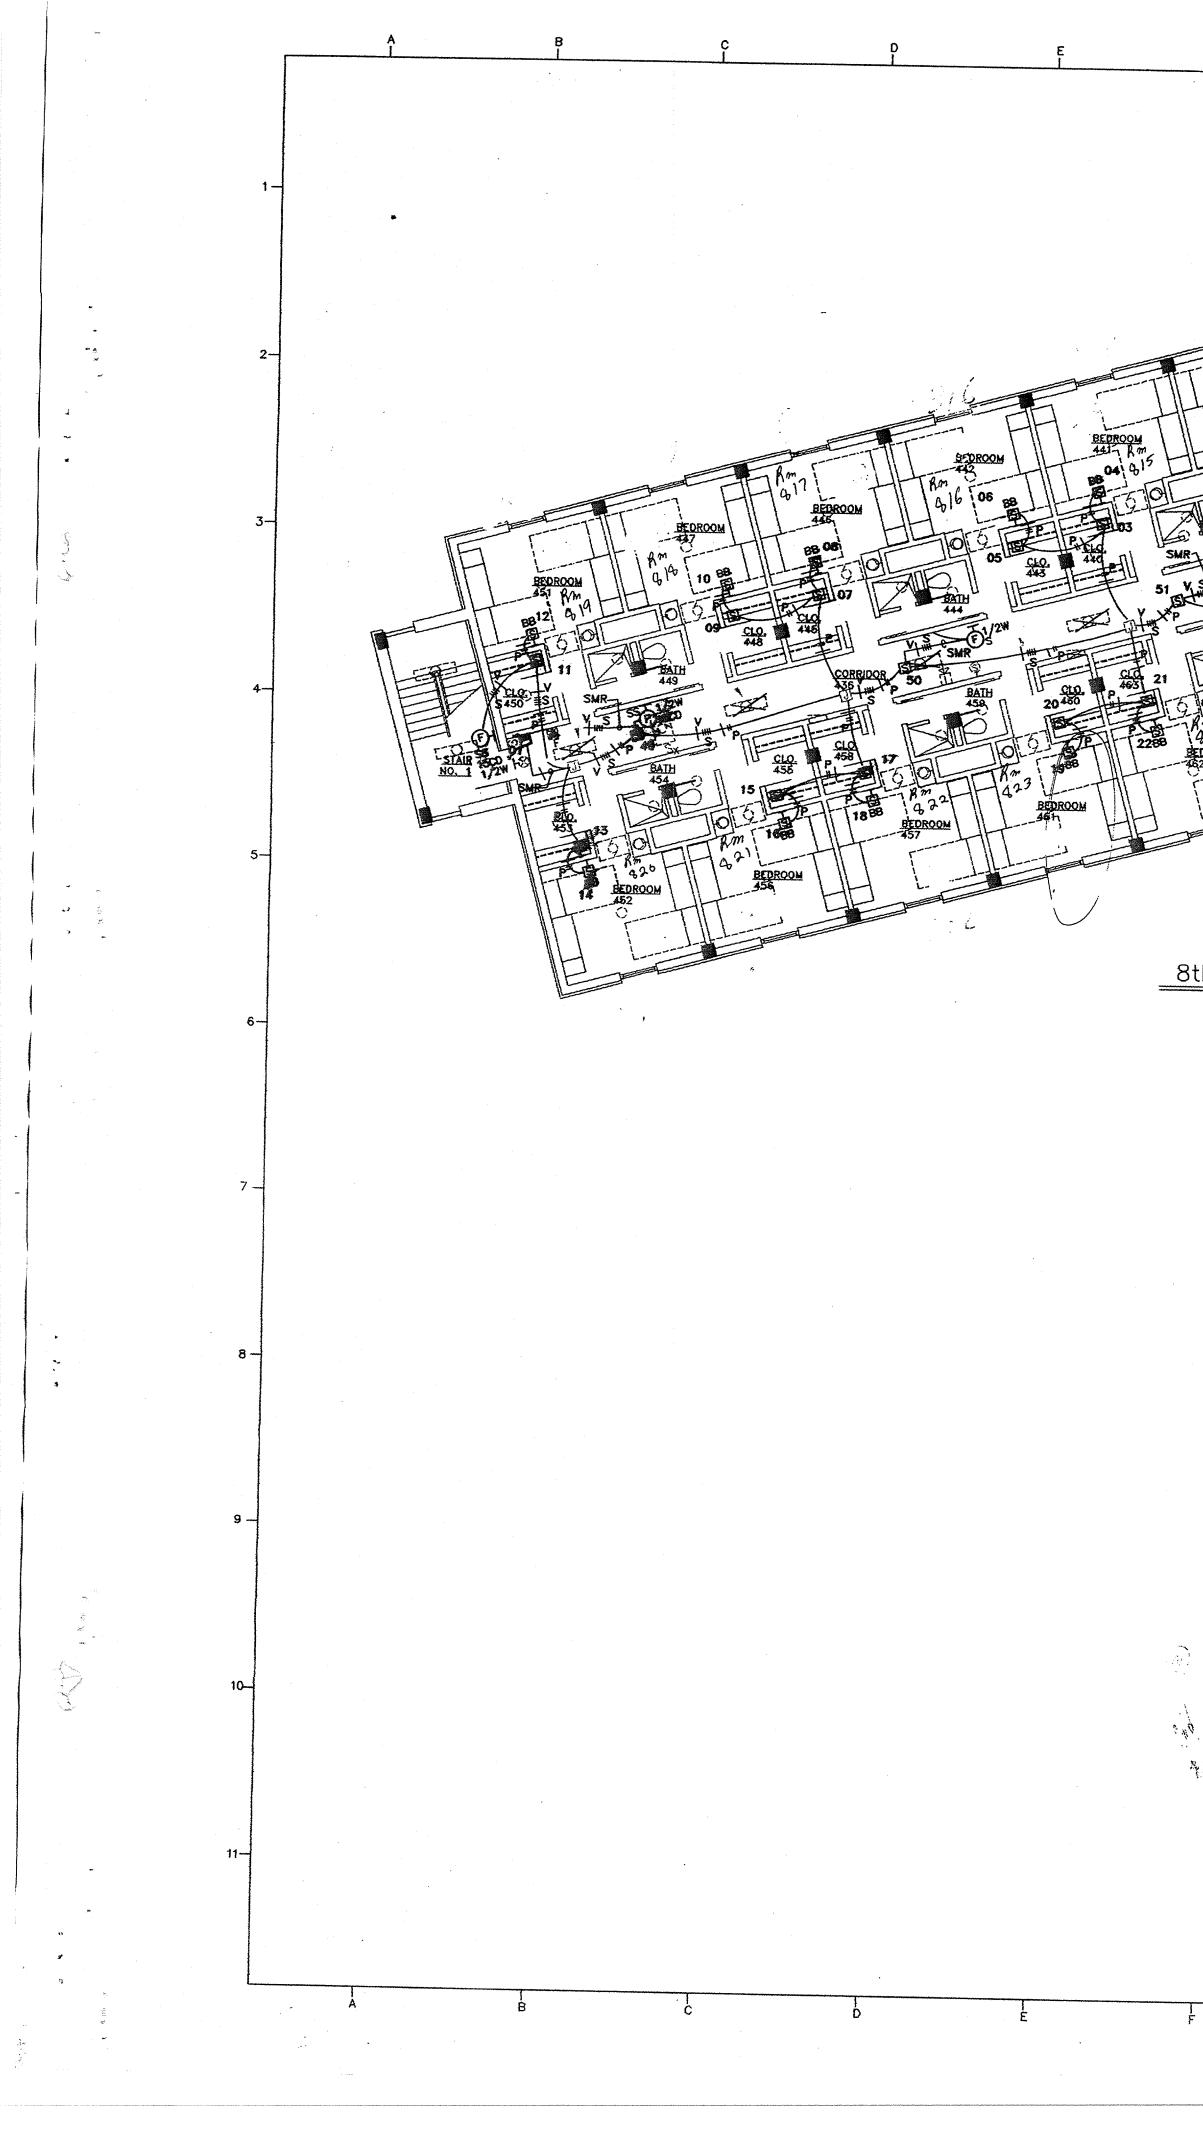


y the sh 443 S 55 BEDROOM BEDROOM 402 BEDROO BEDROOM BEDROOM 8th FLOOR PLAN - FIRE ALARM N ----- Sth FLOOR - UP TO 4020 NODE C ON 9th FLOOR 2HR. CHASE EXCLUSIVELY FOR FIRE ALARM WIRING - @ 10th FLOOR - DOWN TO 4020 NODE C ON 9th FLOOR TO F.A. DEVICES ON 10th FLOOR TO F.A. DEVICES ON 8th FLOOR UP TO F.A. DEVICES ON 7th FLOOR SEE SHT. KHE.6 Vot-DN. TO F.A. DEVICES ON 5th Floor - See SHT. KHE.6 -----MAIN COMM. LINES DOWN TO 4020 NODE A ON 3rd FLOOR SEE SHT. KHE.4----ø-----E6-32 19 <u>\_15</u>\_\_ TO 6th FLOOR F.A. DEVICES UP TO SHA FLR. E6-30,34 MAIN COMM. LINES DOWN TO FIRST FLOOR SEE KHE.1 DOWN TO 3rd FLOOR PART PLAN A 4020 NODE B CLOSET ON 6th FLOOR ONLY N.T.S. ×, 4. Ny man . • 1 G Н J ĸ Ń . .

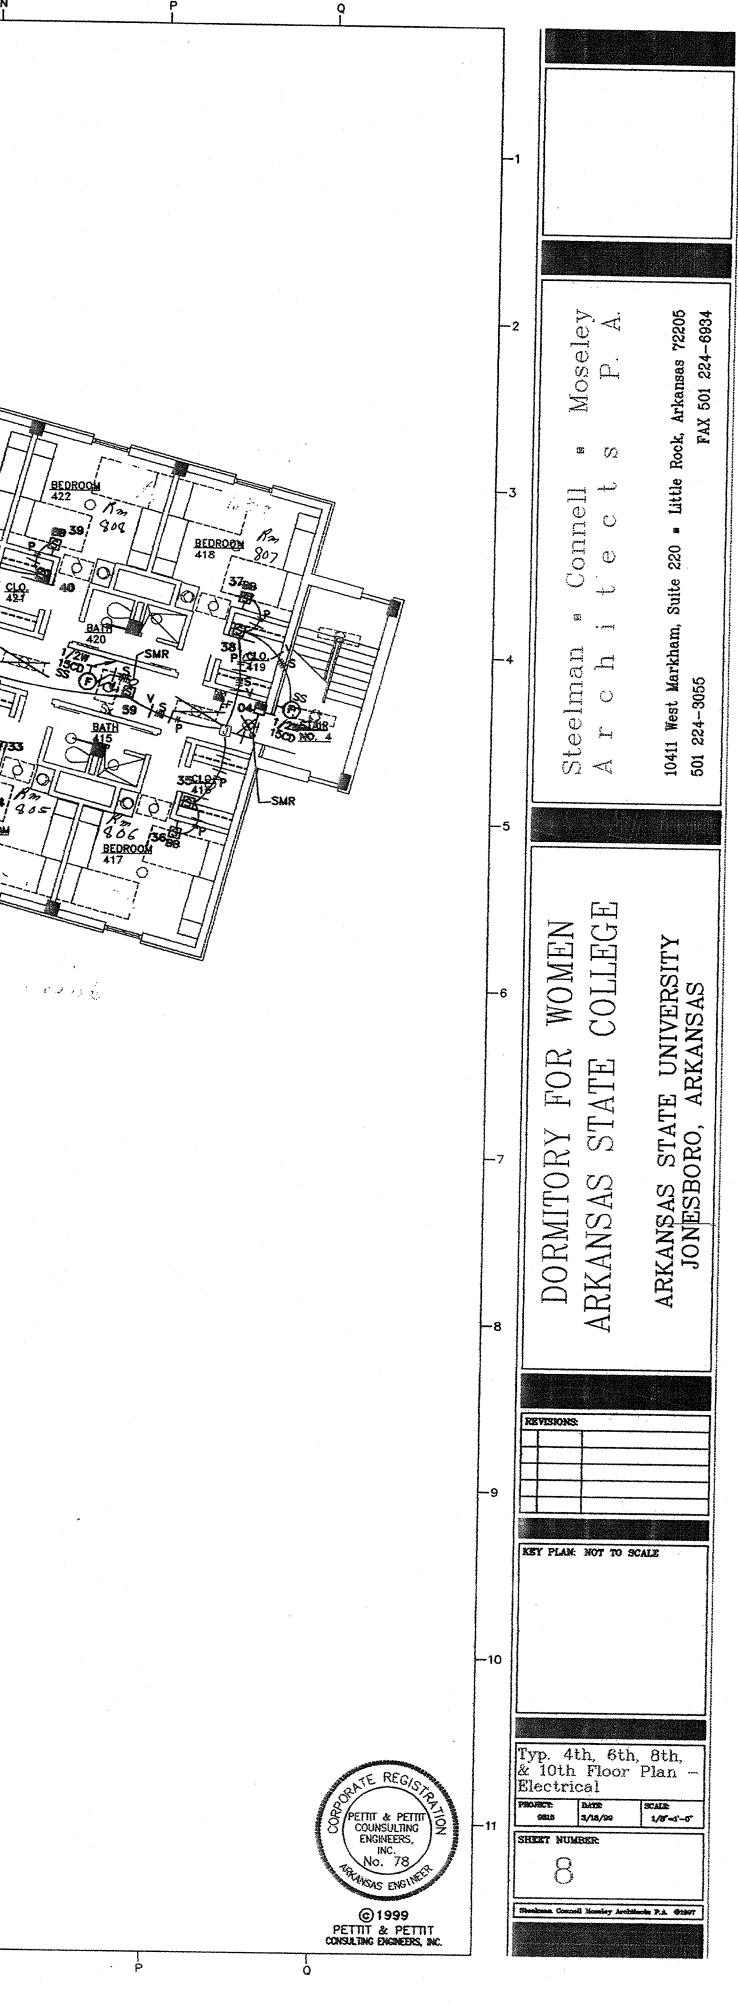

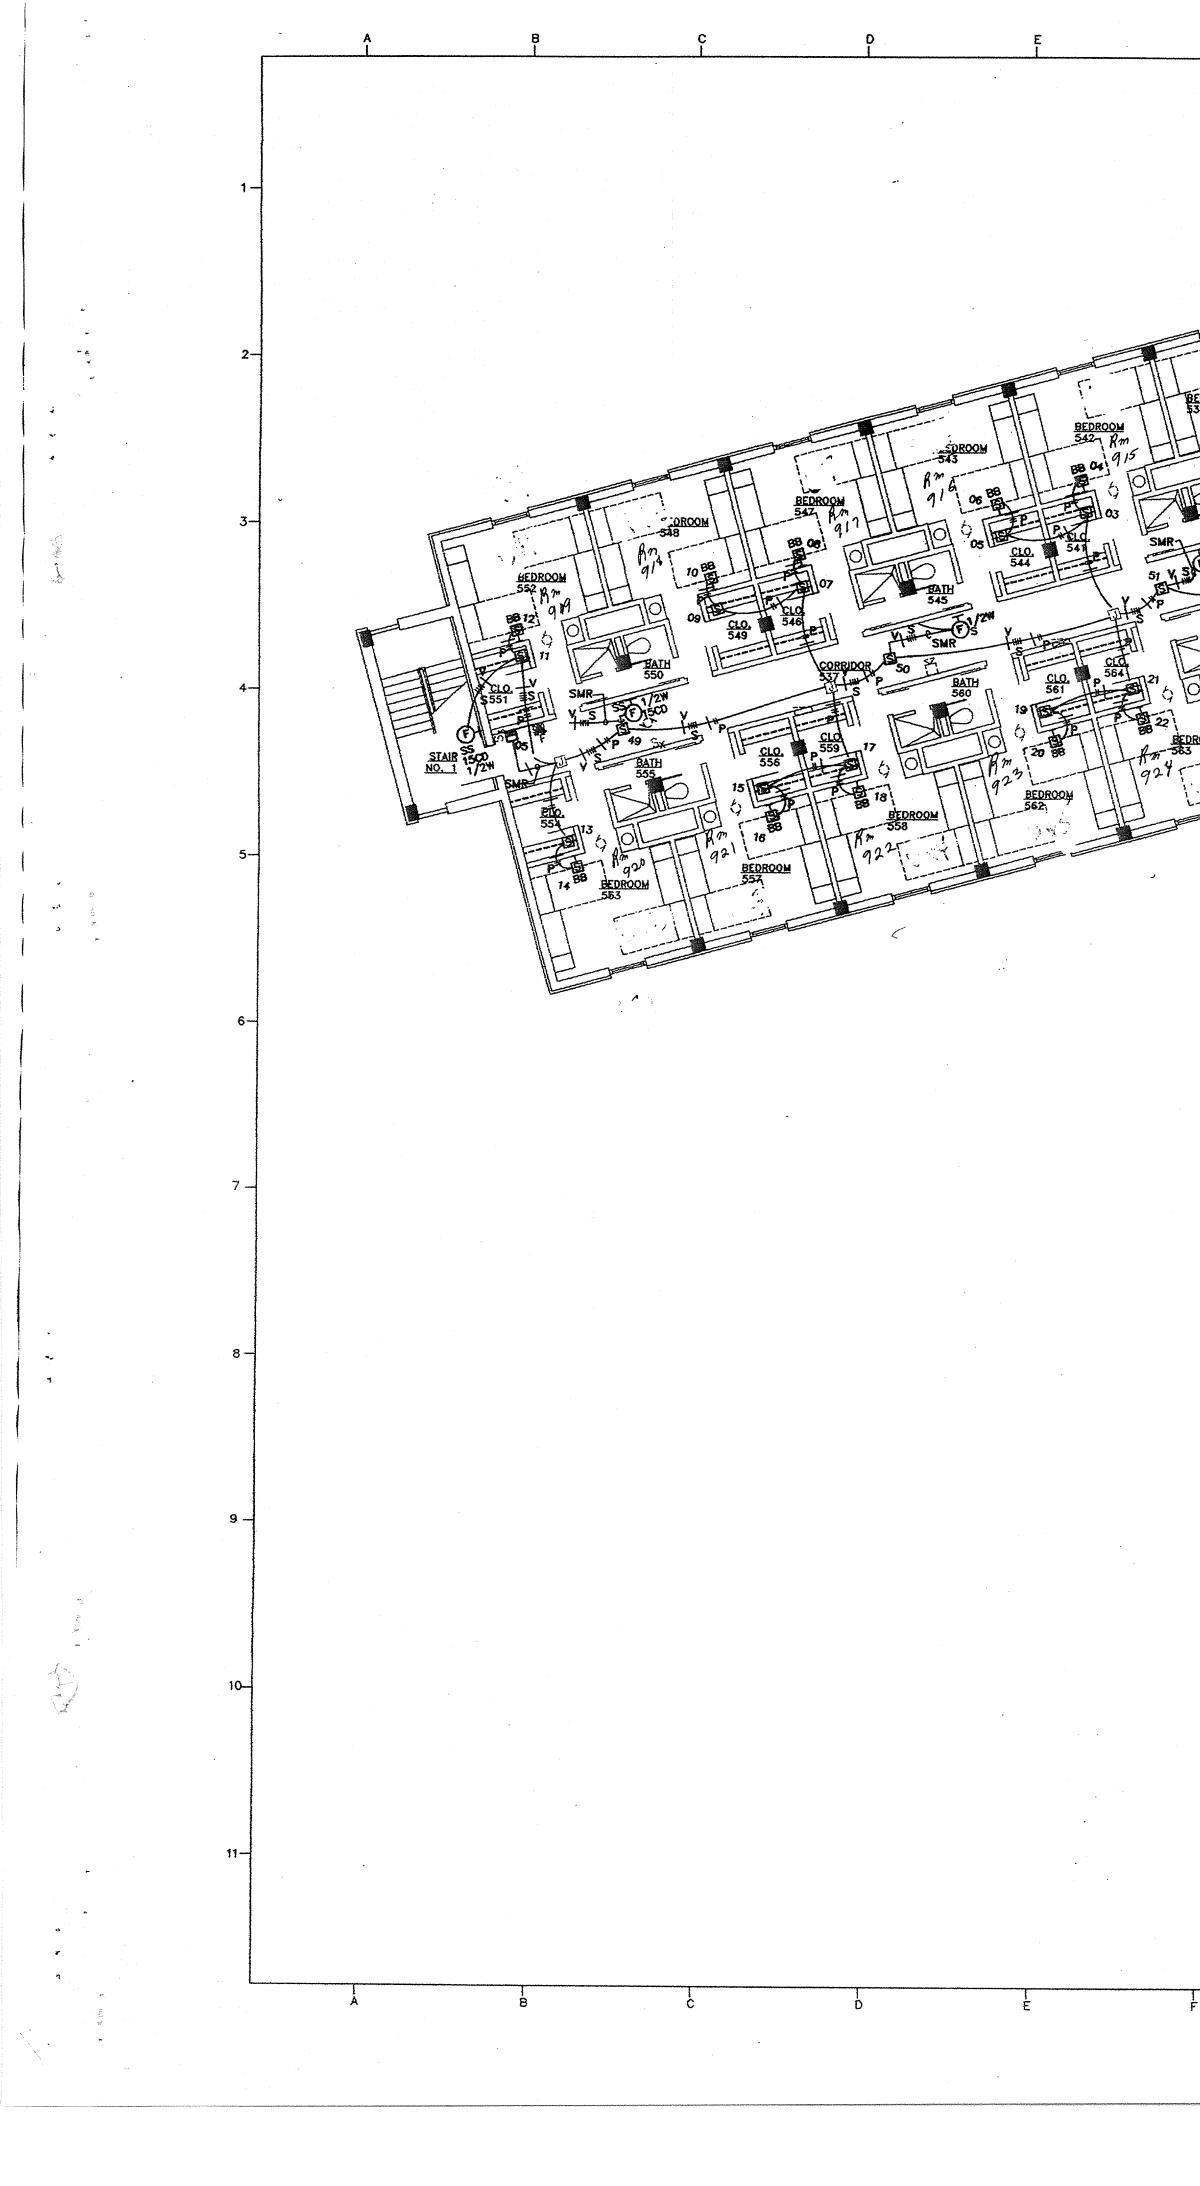


VSPVSP CUSTODIAL 534 SEDRO SI+S## BEDROON EDROOM BEDROOM NODE LOOP 2 . •  $\frac{\text{NINTH FLOOR PLAN} - \text{FIRE ALARM}}{\text{SCALE: } 1/8" = 1' - 0"}$ . 1 3 M Ĝ 

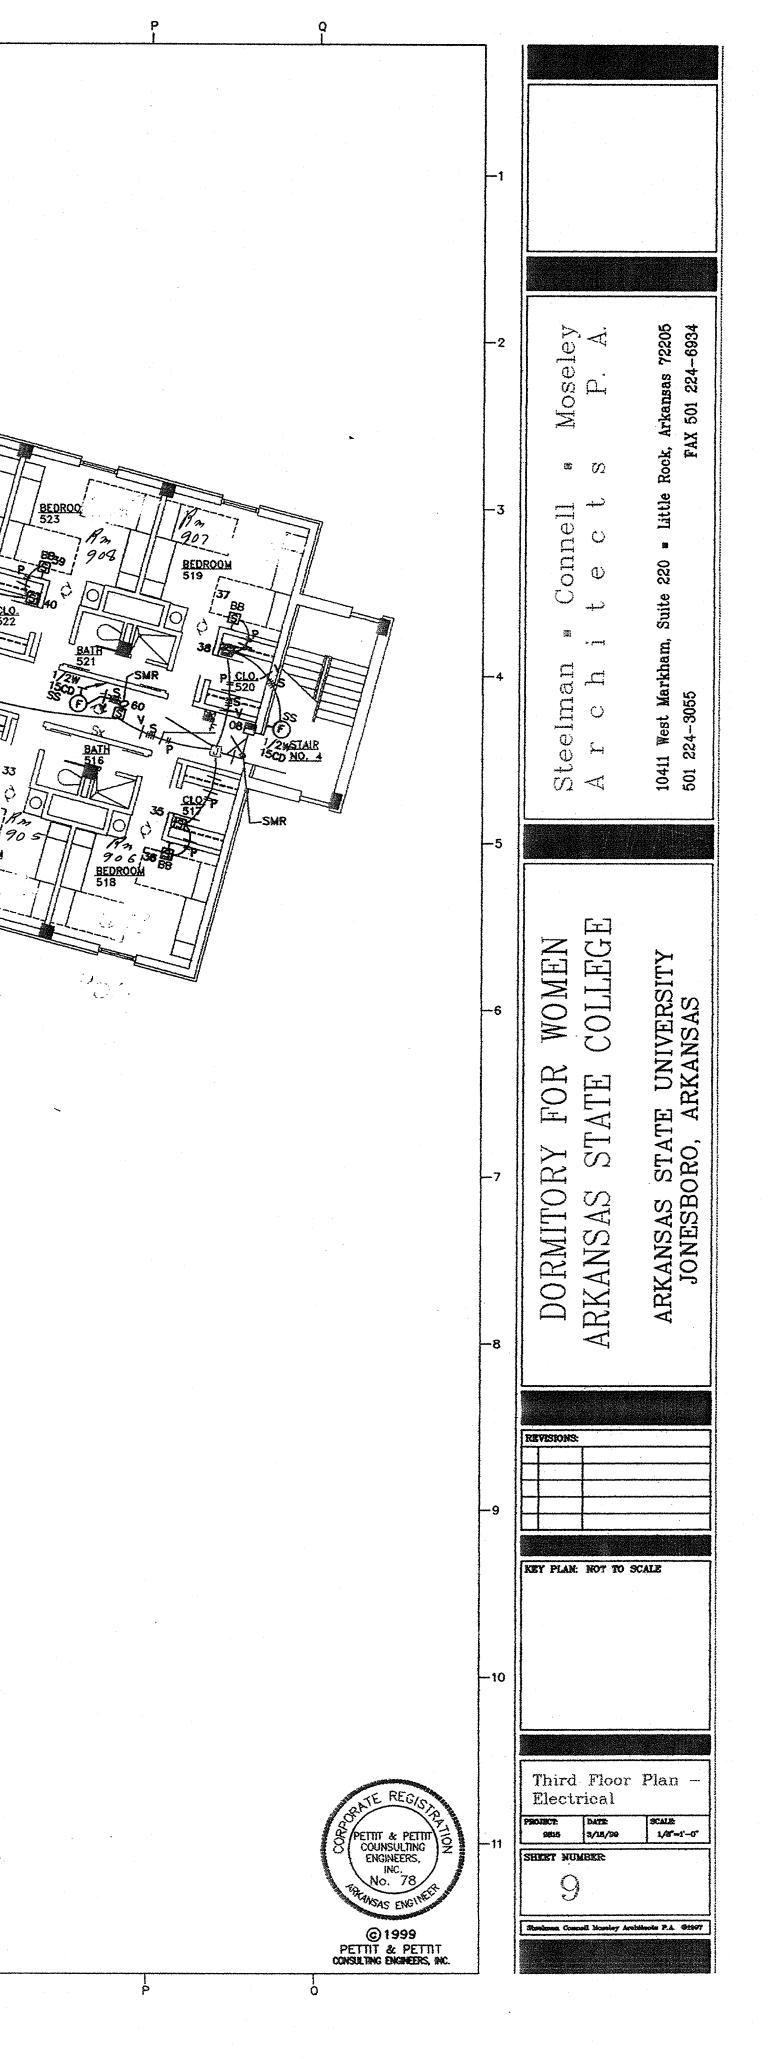


10

Ń

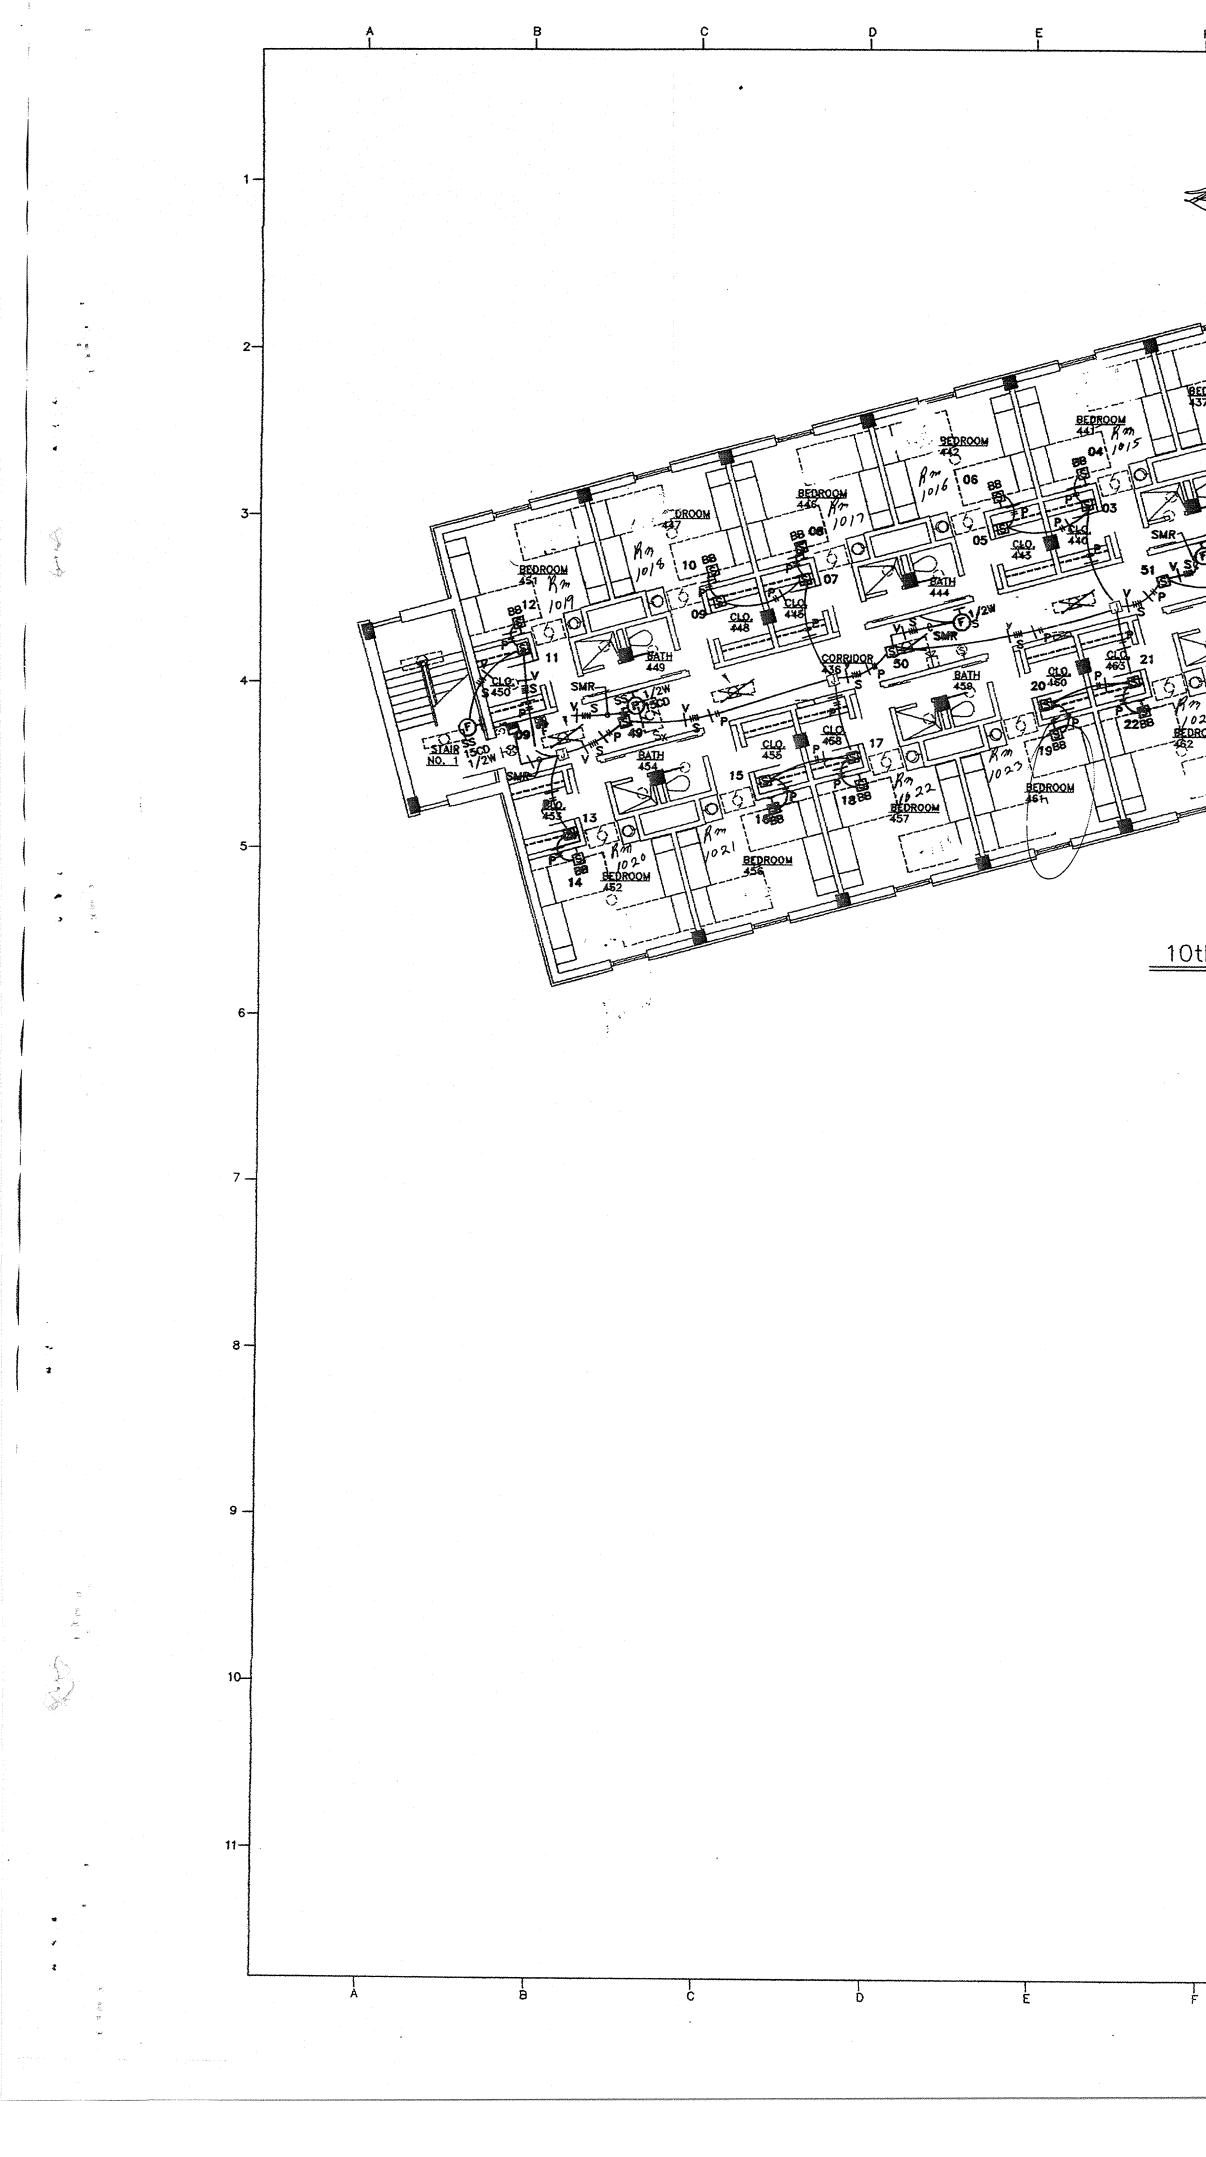


 $N \rightarrow$ æ-5 STODIAL BEDROON BEDROOM RA <u>веркоом</u> 471  $\odot$  $\odot$ BEDROOM 1002 BEDROO EDROON 10th FLOOR PLAN - FIRE ALARM PANEL 4 LOOP 3 ZONE 10 - 9 8th FLOOR - UP TO 4020 NODE C ON 9th FLOOR 2HR. CHASE EXCLUSIVELY FOR FIRE ALARM WIRING - 10th FLOOR - DOWN TO 4020 NODE C ON 9th FLOOR TO F.A. DEVICES ON 10th FLOOR TO F.A. DEVICES ON 8th FLOOR UP TO F.A. DEVICES ON 7th FLOOR SEE SHT. KHE.6 DN. TO F.A. DEVICES ON 5th FLOOR - SEE SHT. KHE.8 MAIN COMM. LINES DOWN TO 4020 NODE A ON 3rd FLOOR SEE SHT. KHE.4 E6-32 <u>S-</u> TO 6th FLOOR F.A. DEVICES /UP TO SHI FLR. E6-30,34 MAIN COMM. LINES DOWN TO FIRST FLOOR SEE KHE.1 DOWN TO 3rd FLOOR PART PLAN A N.T.S. 4020 NODE B CLOSET ON 6th FLOOR ONLY . L M Ń . •

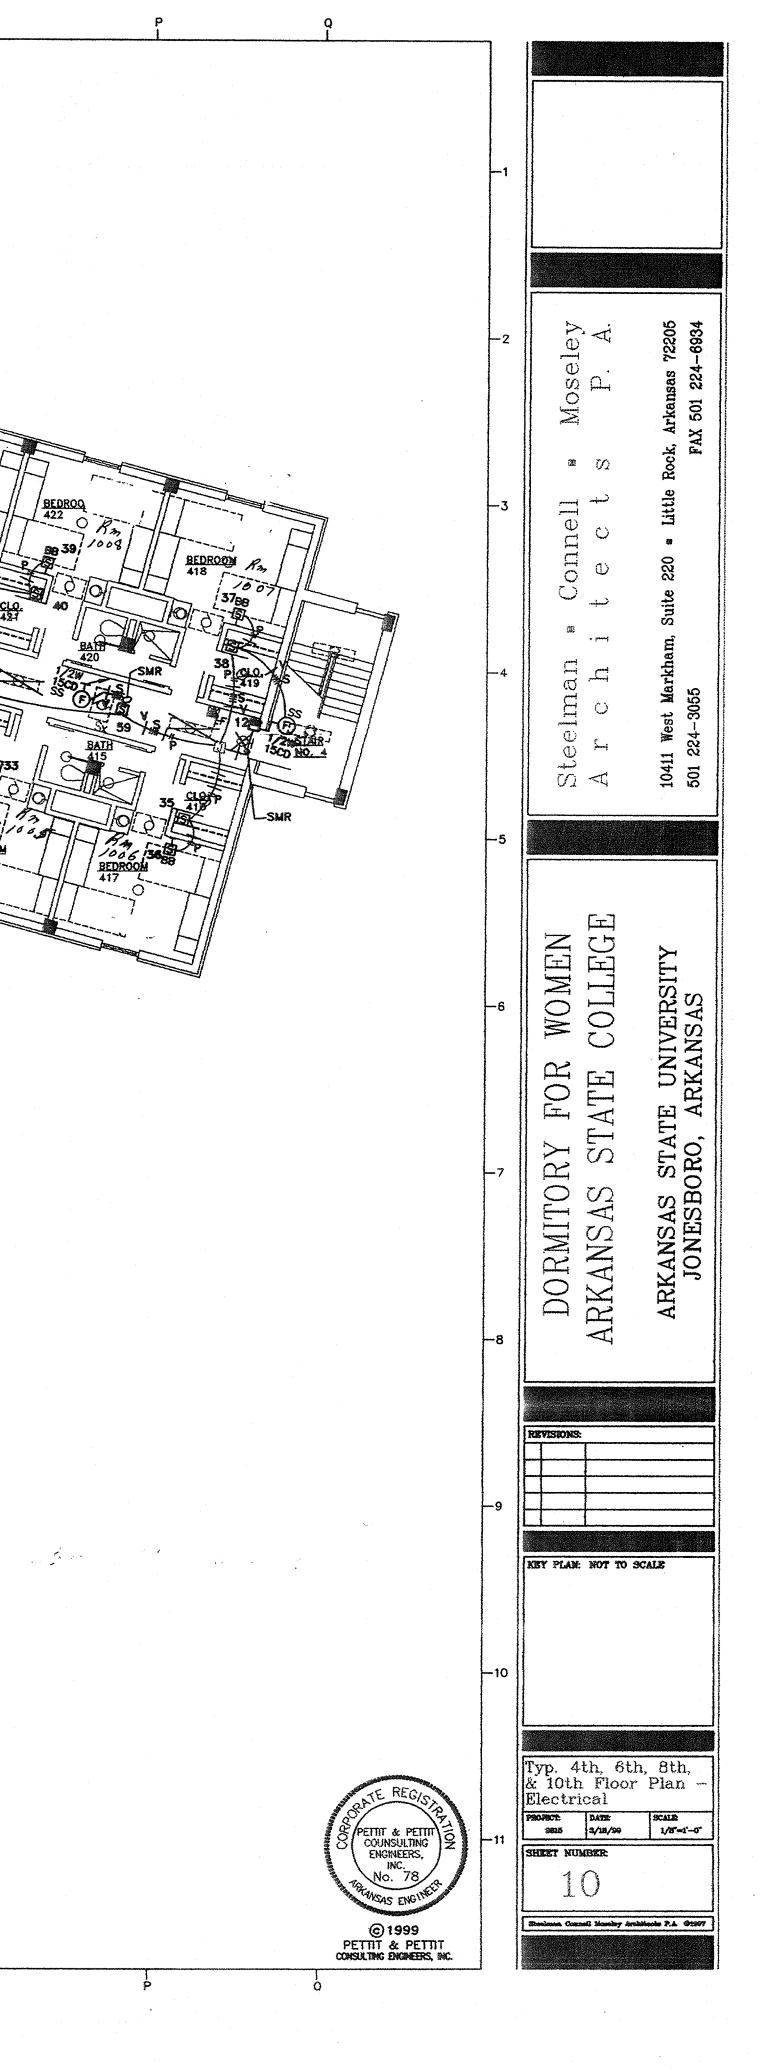


•

1 .

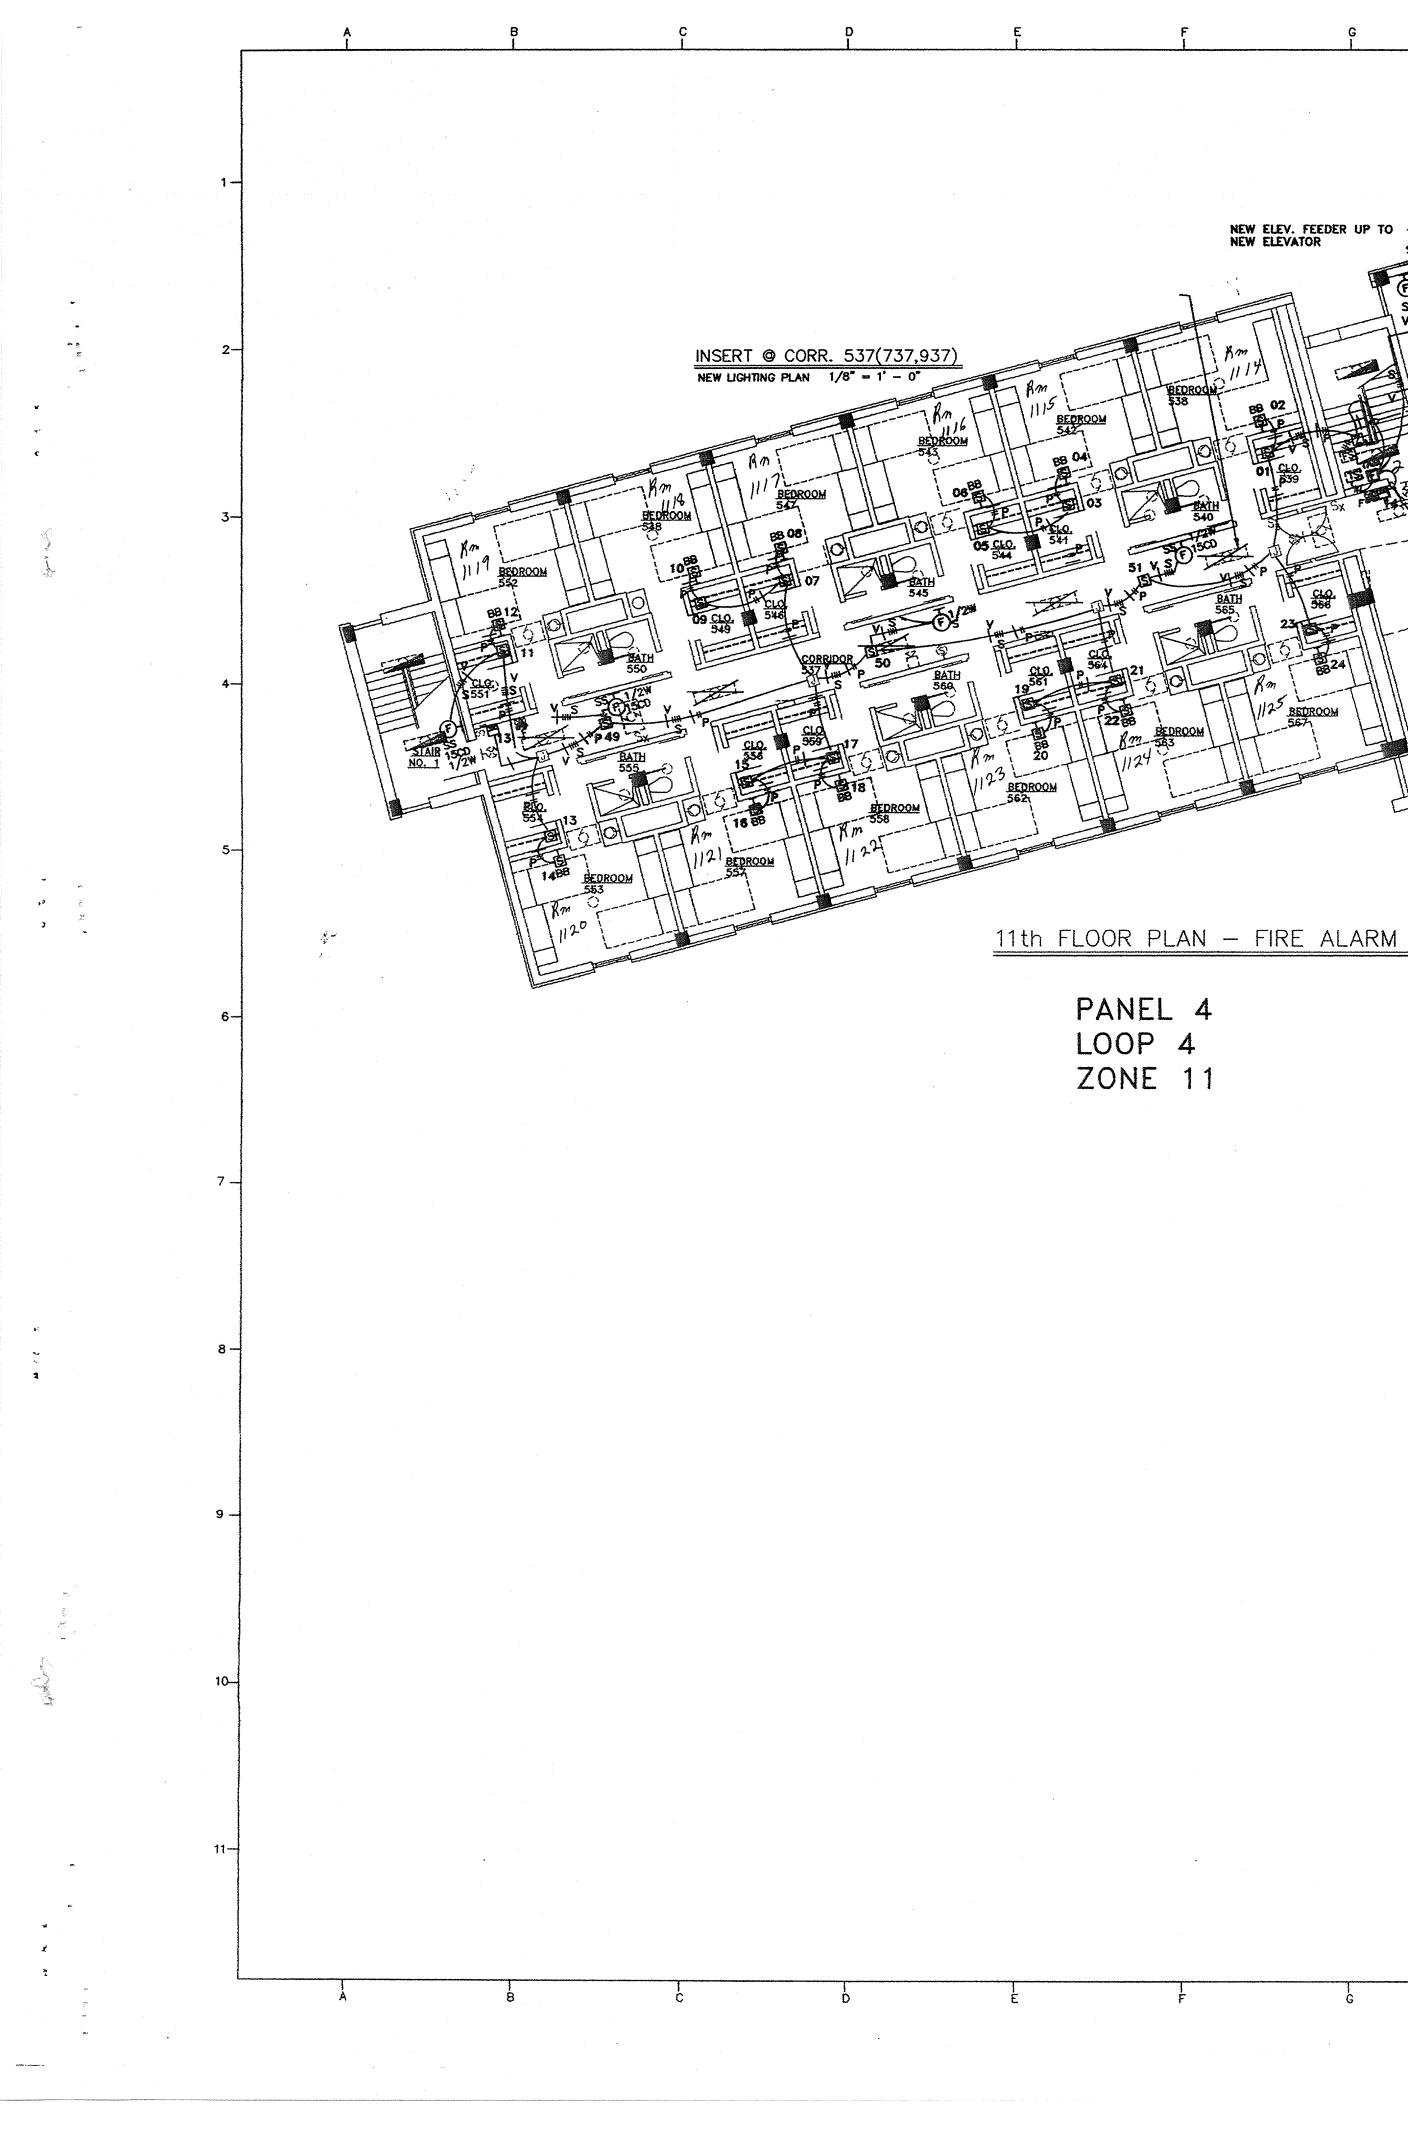


NEW ELEV. FEEDER UP TO NEW ELEVATOR INSERT @ CORR. 503(703,903) NEW LIGHTING PLAN 1/8" = 1' - 0" BEDROO SEDRODM BEDROOM 110  $\odot$ -SMR-[2] BEDROOM BEDROOM BEDROOM  $\odot$ BEDROOM BEDROOM N UP TO F.A. DEVICES IN ELEV. PENTHOUSE, SEE SHT. KHE.8-UP TO F.A. DEVICES ON 11tH FLOOR - SEE SHT. KHE.7 UP TO F.A. DEVICES ON 10th FLOOR - SEE SHT. KHE,5 MAIN LINE COMM. DOWN TO 4020B ON 6th FLR. -MAIN-LINE COMM. DOWN TO 1st FLOOR THEN TO FAP -----. •

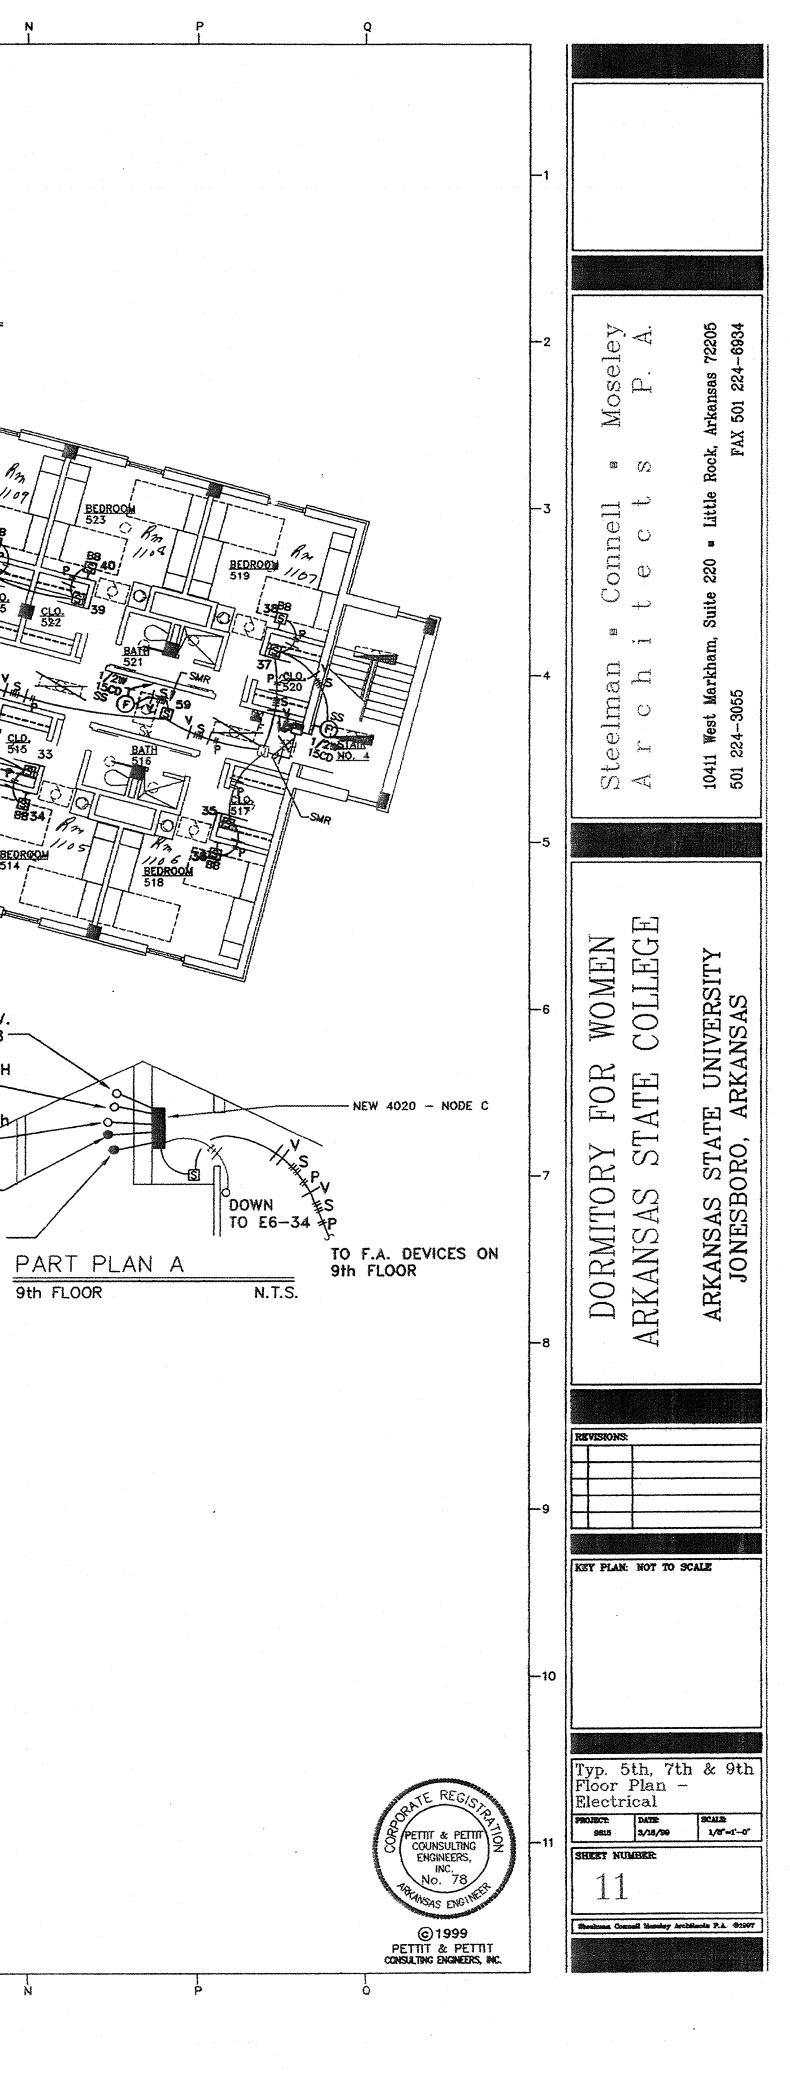


0 

N 1

Ĵ

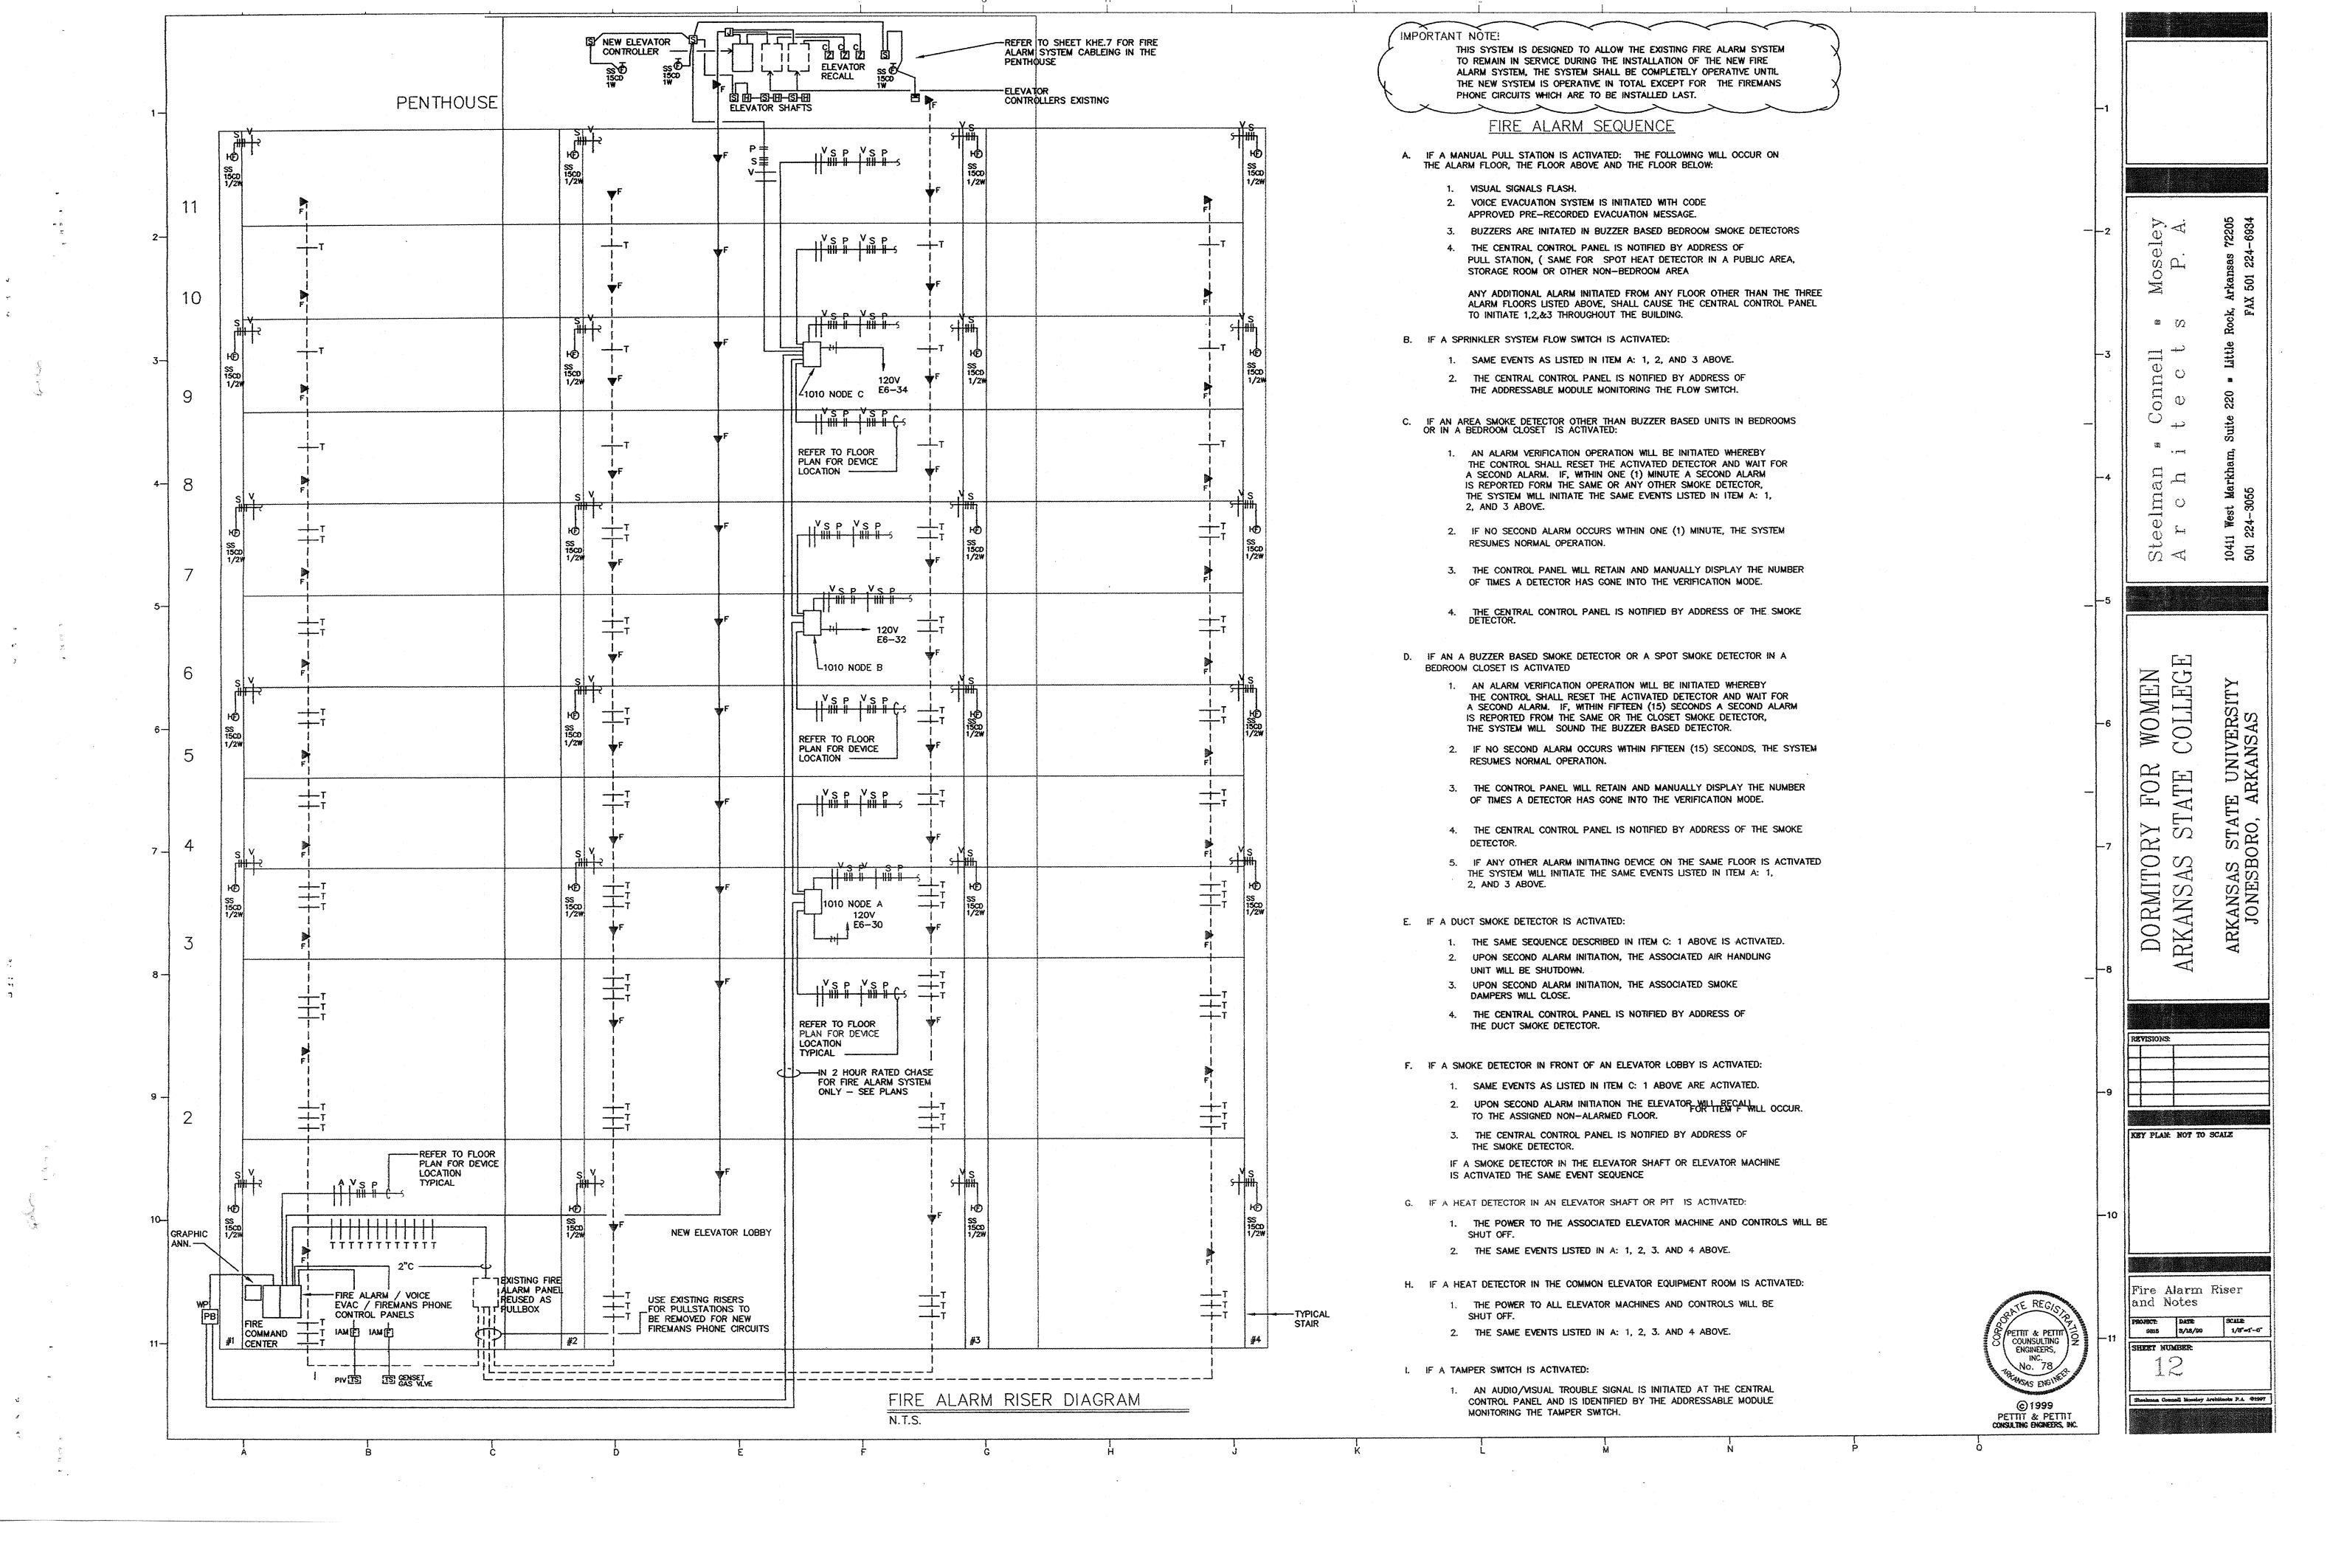

N) N ~

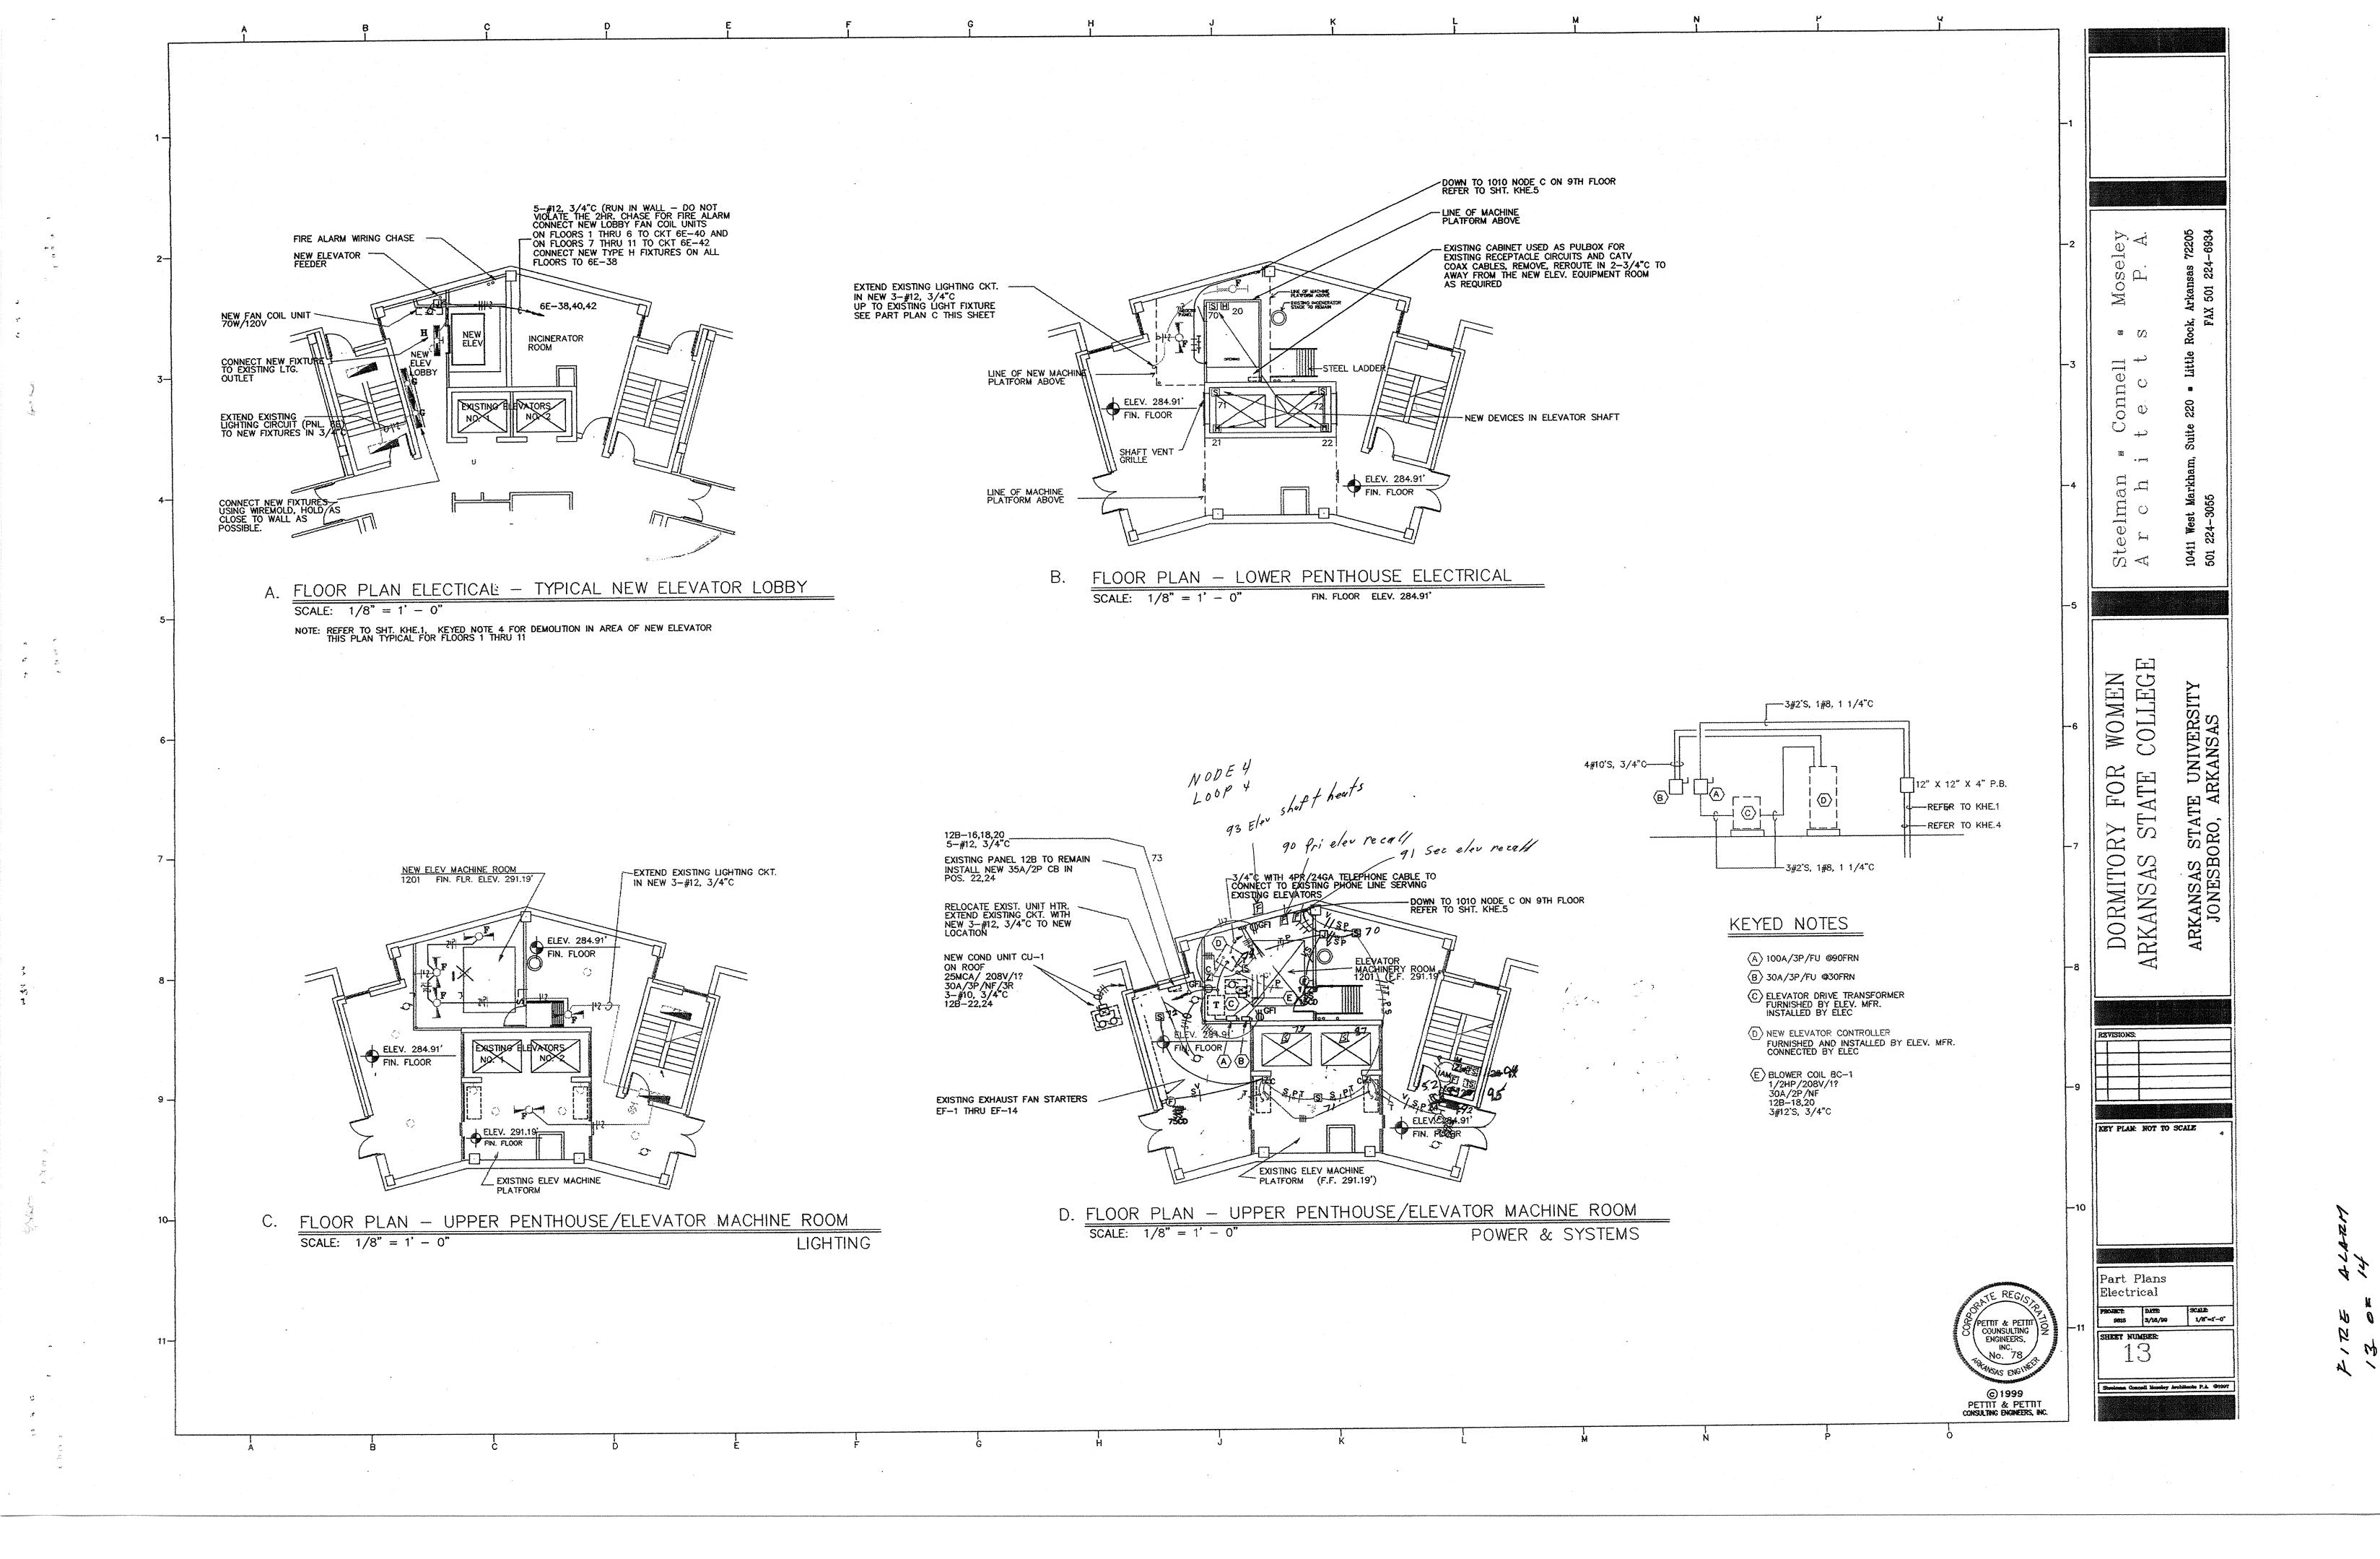

NO O 2 < M

THIS CONTRACTOR SHALL BE RESPONSIBLE FOR ALL DEMOLITION IN AREAS OF RENOVATION. ALL WIRING DEVICES, LIGHT FIXTURES, WIRE AND CONDUIT SHALL BE REMOVED IN THESE AREAS AND STORED AS DIRECTED BY THE OWNER OR RELOCATED AS SHOWN ON THE NEW FLOOR PLAN. APPROPRIATE MEASURES SHALL BE TAKEN TO ASSURE CONTINUITY OF EXISTING CIRCUITS WHERE REQUIRED. SOME EXISTING MECH. EQUIPMENT, WIRING DEVICES, FIXTURES, ETC. MAY BE REQUIRED TO BE RECONNECTED TO NEW PANELBOARDS BASED ON EXISTING FIELD CONDITIONS. ALL POWER OUTAGES WHICH MAY RESULT SHALL BE COORDINATED WITH THE OWNER PRIOR TO THE WORK.

ALL EXISTING BRANCH CIRCUITS NOT USED SHALL BE REMOVED BACK TO PANEL. THE CIRCUIT BREAKERS SHALL BE LABELED AS SPARE, AND EXISTING CONDUIT SHALL REMAIN FROM PANEL TO ABOVE ACCESSIBLE CEILING SPACE.

### KEYED DEMOLITION NOTES


- (1) REMOVE EXISTING LIGHT FIXTURE. TURN LIGHT FIXTURE OVER TO OWNER.
- $\langle 2 \rangle$  remove existing light fixture. Relocate as shown on New Floor plan.
- $\langle 3 \rangle$  EXISTING WIRING DEVICE TO REMAIN. MAINTAIN CONTINUITY OF EXISTING CIRCUIT.
- (4) REMOVE EXISTING WIRING DEVICE, WIRE AND CONDUIT.
- 5 REMOVE ELECTRICAL CONNECTION TO EXISTING UNIT HEATER. INSTALL J-BOX AND EXTEND EXISTING CIRCUIT TO NEW LOCATION OF HEATER.
- 6 REMOVE EXISTING MOTOR CONTROL SWITCH. RELOCATE AS SHOWN ON NEW PLAN. EXTEND EXISTING CIRCUIT TO NEW SWITCH LOCATION.
- (7) REMOVE EXISTING CIRCUIT BREAKER ENCLOSURE AND ASSOCIATED BRANCH CIRCUITS.
- (8) REMOVE EXISTING SPEAKER AND RELOCATE AS SHOWN ON NEW PLAN. EXTEND EXISTING CIRCUIT TO NEW LOCATION.
- $\langle 9 \rangle$  REMOVE EXISTING WIRING DEVICE. INSTALL BLANK COVERPLATE.

### NOTES:


1

1 F


1. INSTALL SURFACE RACEWAY AND MATCHING DEVICE BOX EQUAL TO WIREMOLD #V700. PAINT TO MATCH WALL.

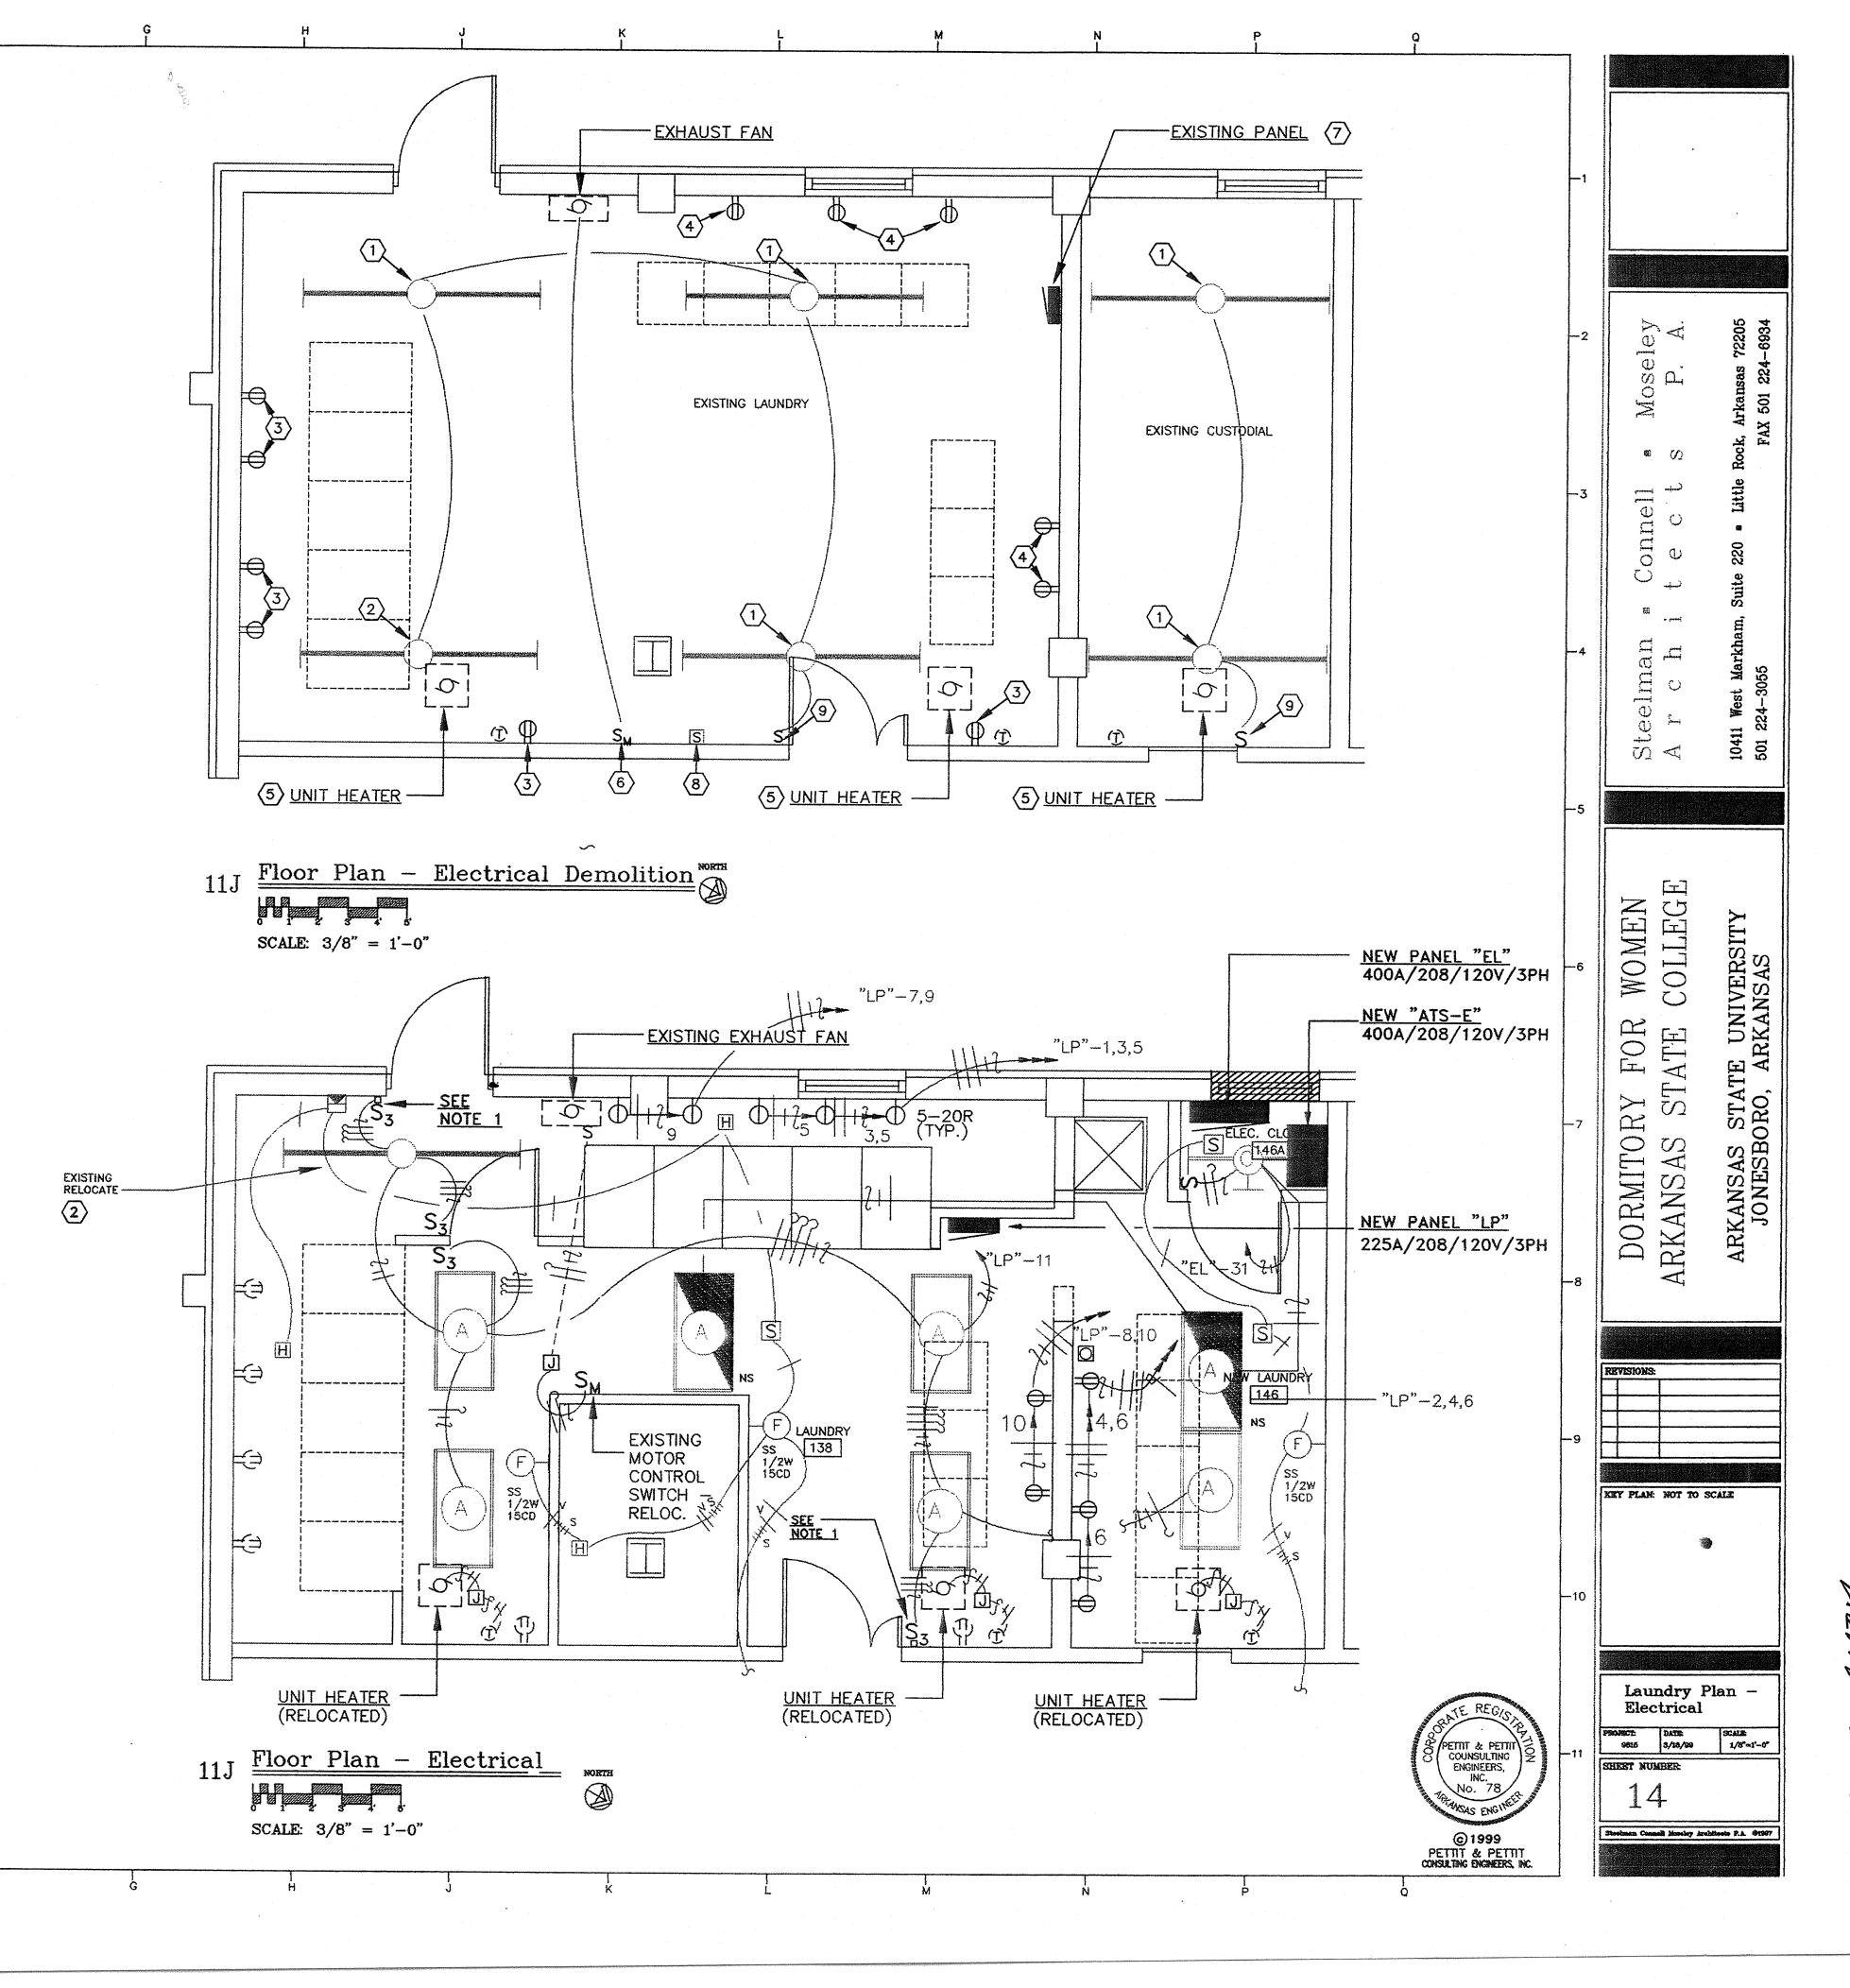

FIRE HLAN

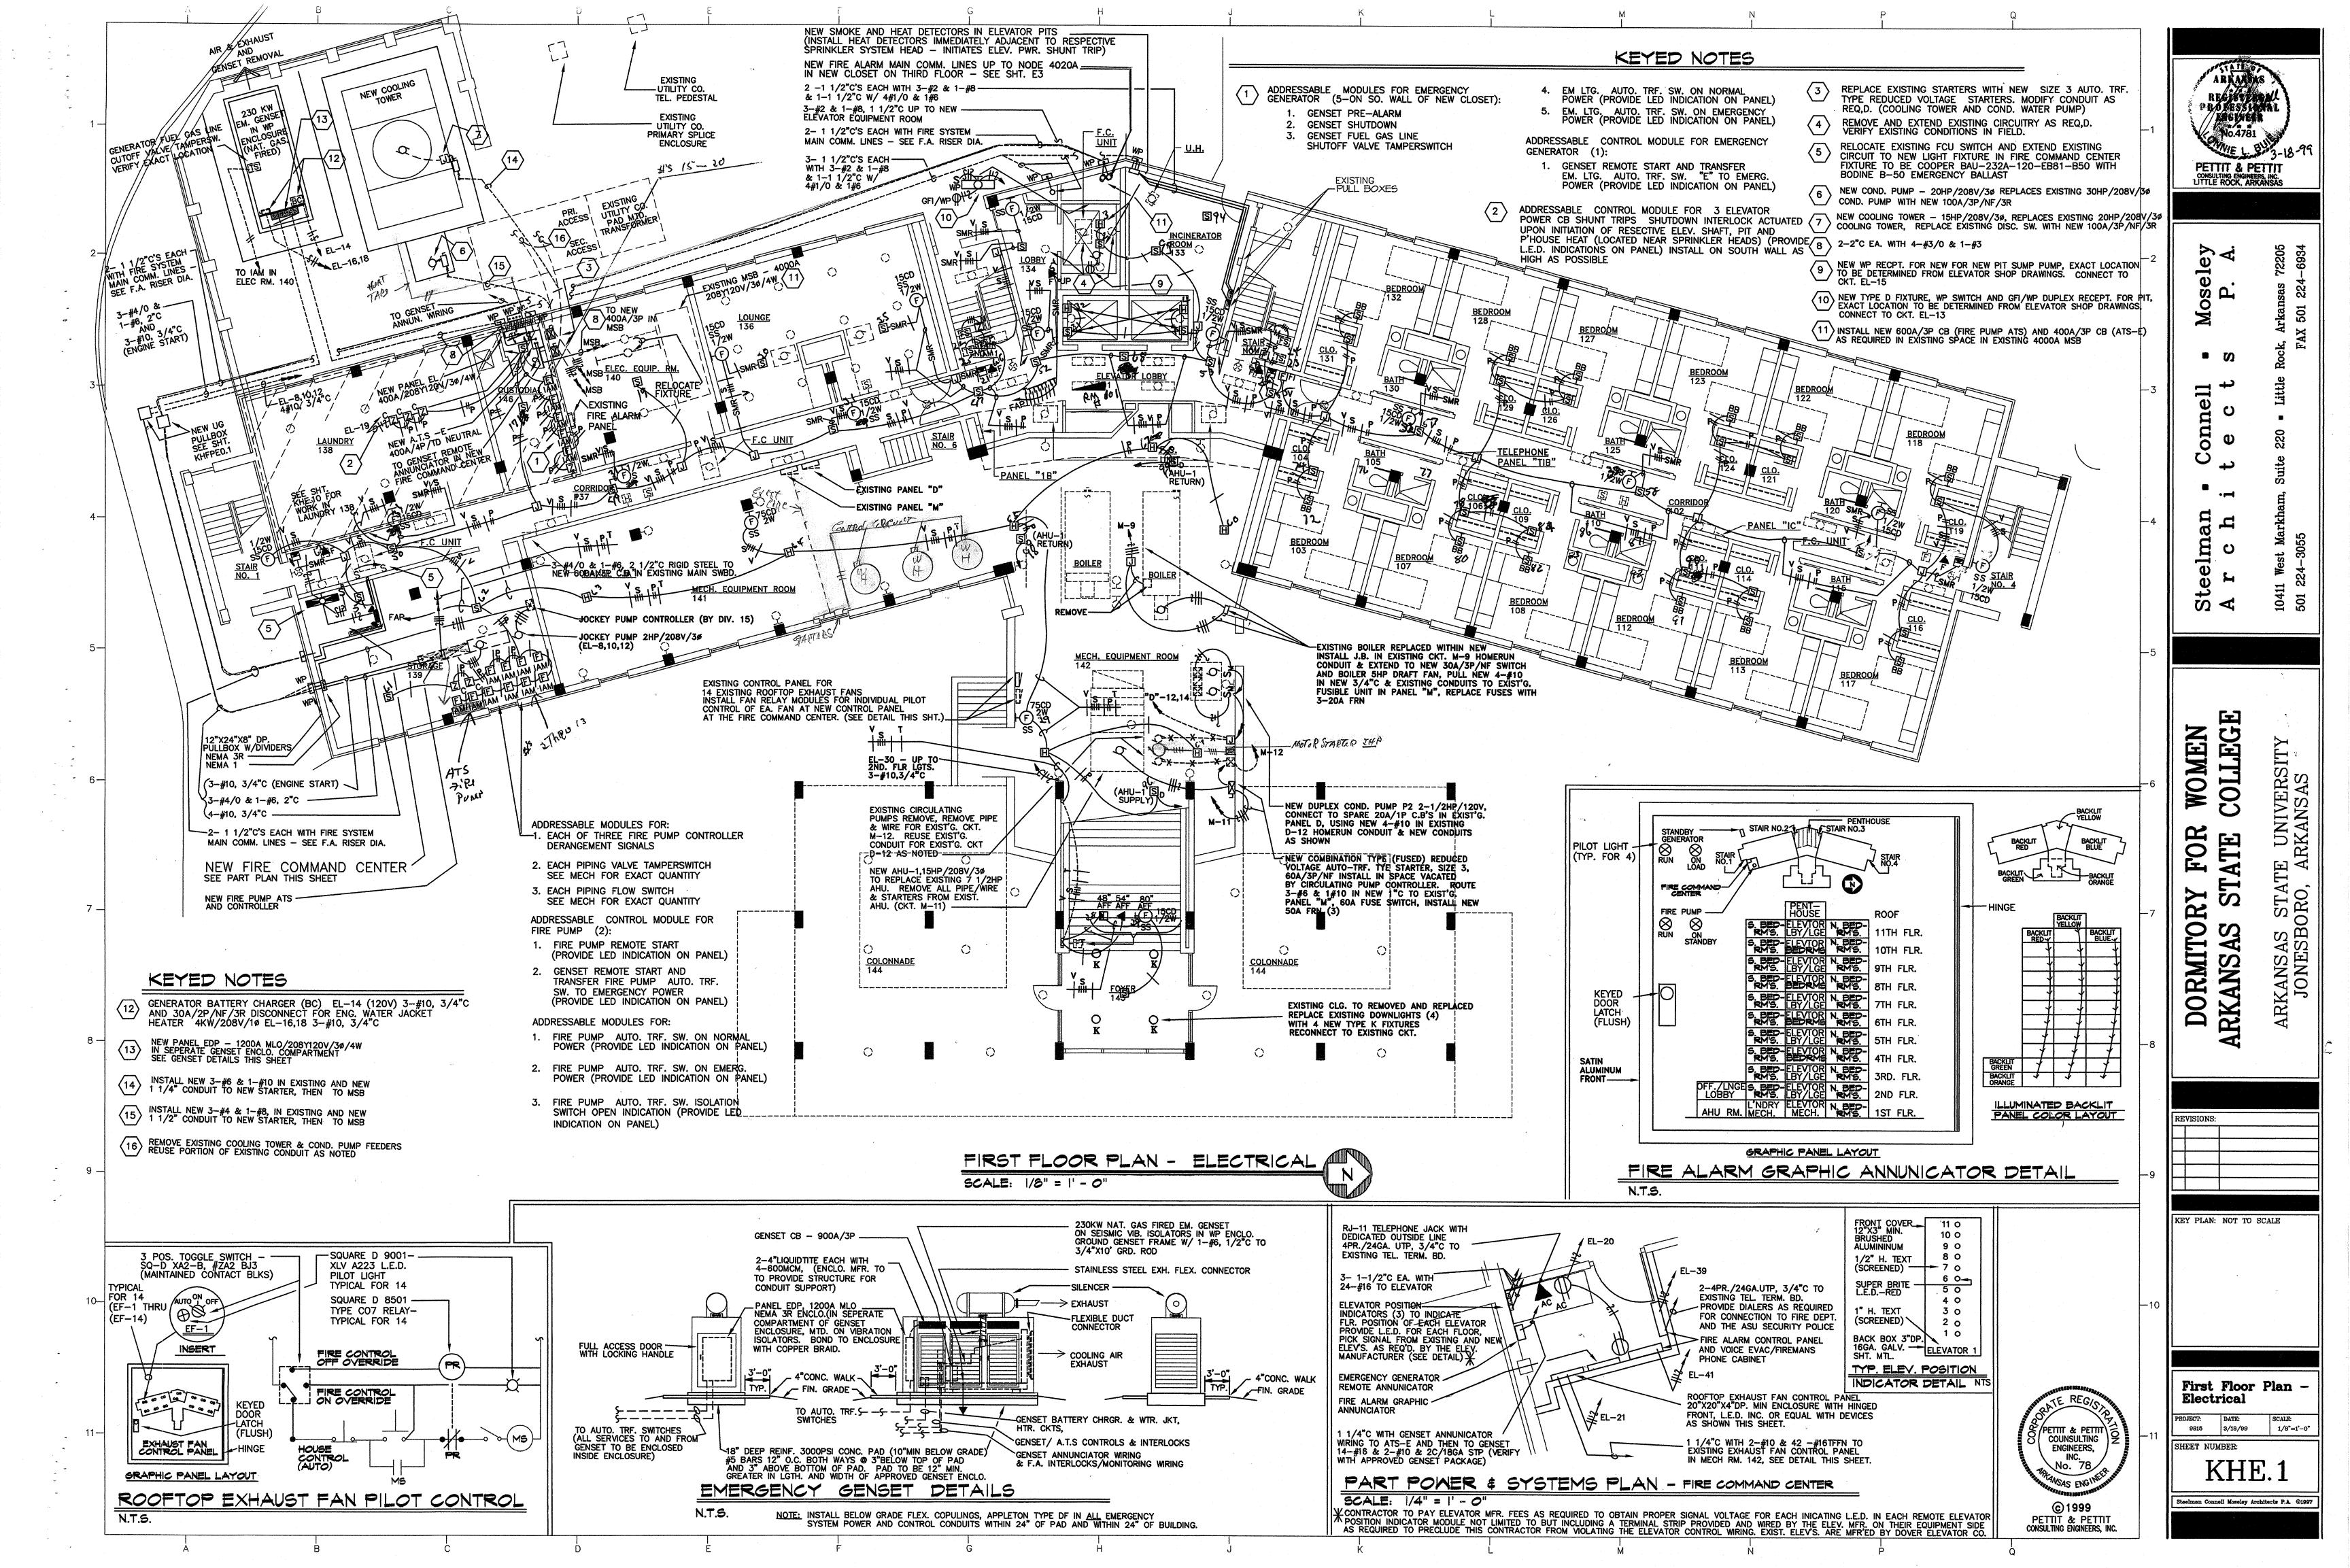


CONNECT LTG. CKT. TO FEED THRU THIS OUTLET INSERT @ CORR. 337 NEW LIGHTING PLAN 1/8" = 1' - 0" REMOVE EXISTING FIXTURES, EXTEND EXISTING CIRCUITS IN 1/2" FLEX TYP. BEDROOM EDROO CONNECT LTG. CKT. TO FEED THRU \_\_\_\_\_ THIS OUTLET EDROON BEDROOM BEDROOM BEDROOM AS Per Elec. Drouwingn 10--

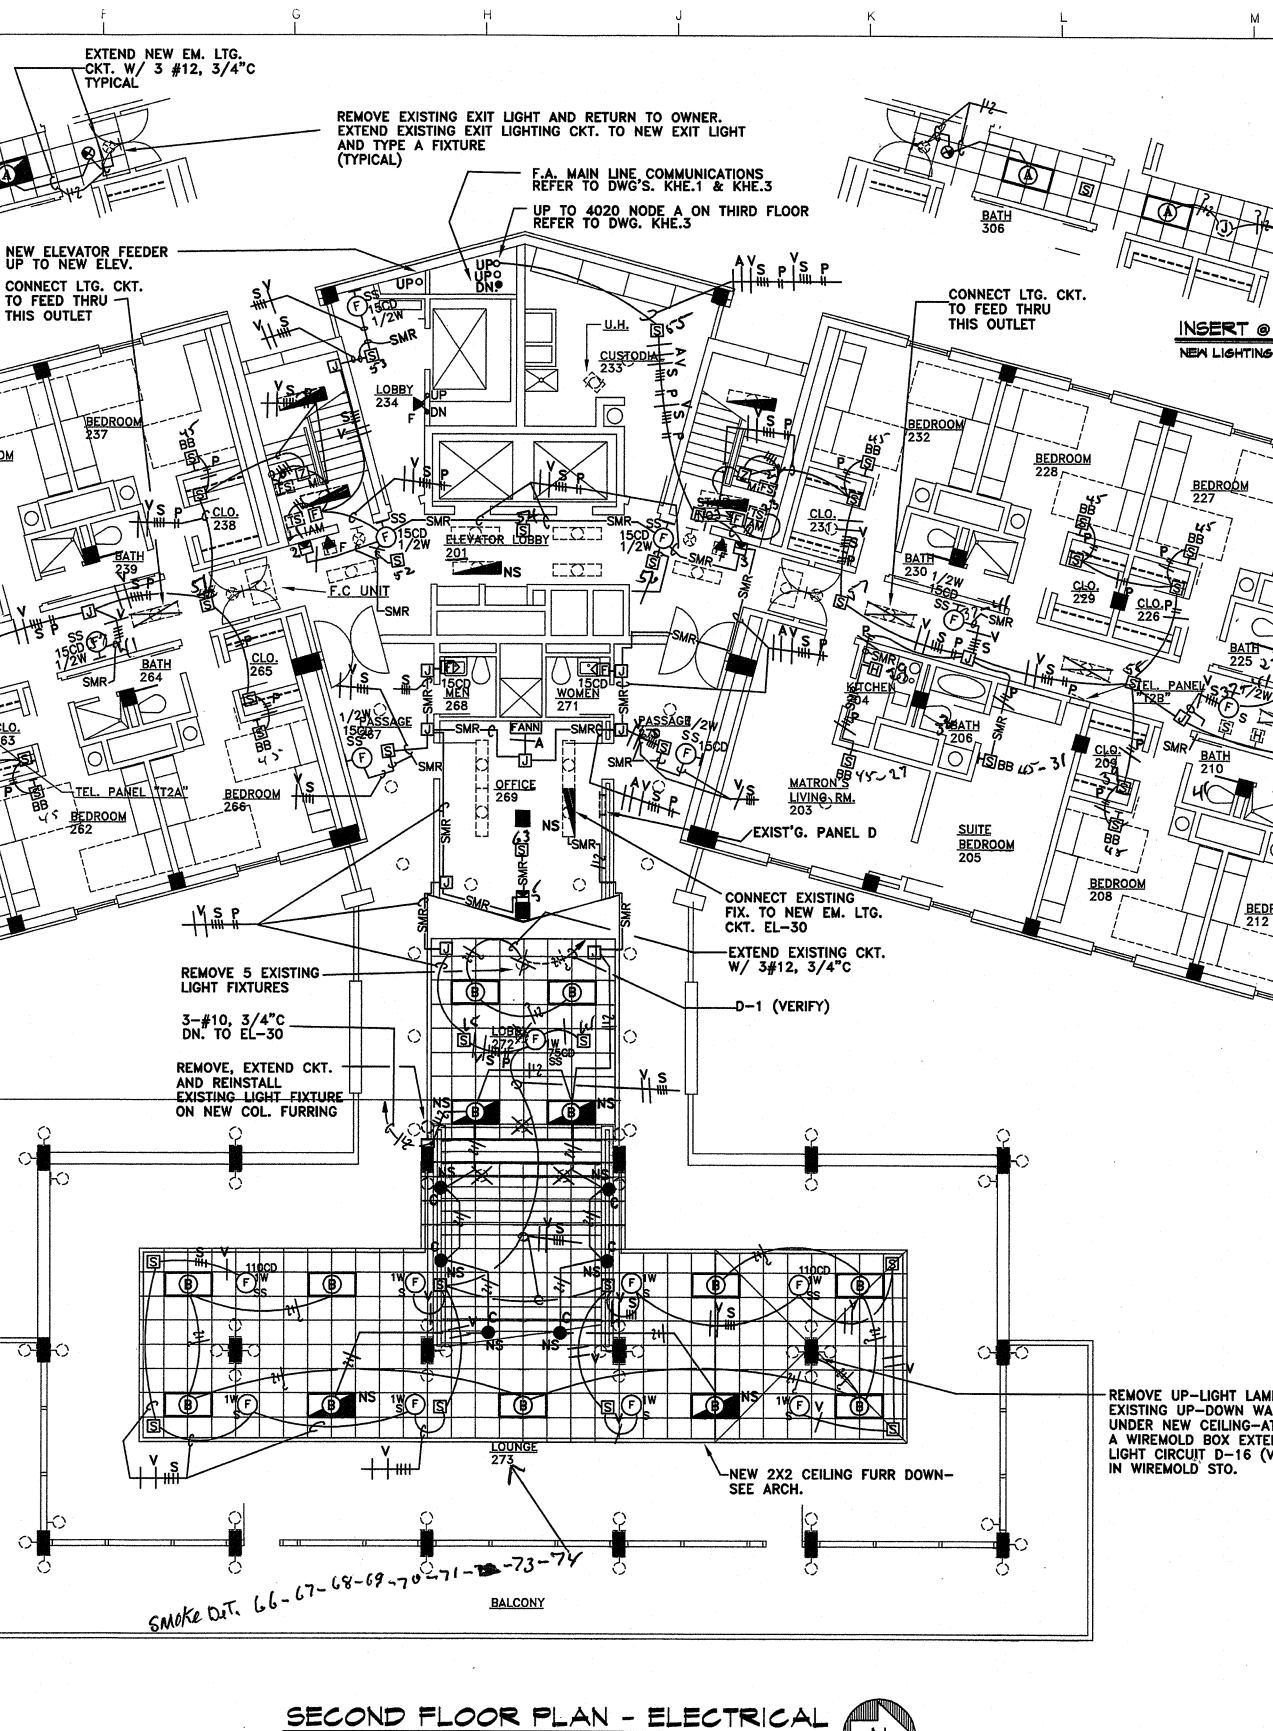


SCALE: 1/8" = 1' - 0"

ARKAKŠA Millin -EXTEND EXISTING CKT TO NEW FIXTURE **TYPICAL** RELOCATE EXISTING EXIT LIGHT TO DIRECTLY BELOW NEW CLG. EXTEND EXISTING CKT IN NEW 3-#12, 3/4"C TO RELOCATED EXIT LGT. AND NEW TYPE A FIX. TYPICAL ENGINEER No.4781 -18:99 NNIE L PETTIT & PETTIT CONSULTING ENGINEERS, INC. LITTLE ROCK, ARKANSAS INSERT @ CORR. 303 NEW LIGHTING PLAN 1/8" = 1' Å. Ð ۵. 22 Д 0 501 CONNECT LTG. CKT. TO FEED THRU THIS OUTLET S BEDROOM onnell BEDROOM 45-10 C 45217 BEDROOM Ð C د an L <u>B</u> C Ð 5 0 104 501 N A BEDROOM 45-4 BEDROOM BEDROOM 45 COLLEGE WOMEN VERSITY NSAS ARKANSAS STATE UNI JONESBORO, ARKAN FOR STATE DORMITORY ARKANSAS ST REMOVE UP-LIGHT LAMP FROM 16 EXISTING UP-DOWN WALL MTD. FIXTURES UNDER NEW CEILING-AT THIS FIXTURE, INSTALL A WIREMOLD BOX EXTENSION & EXTEND EXIST'G. LIGHT CIRCUIT D-16 (VERIFY) UP TO ABOVE CLG. IN WIREMOLD STO. **REVISIONS:** KEY PLAN: NOT TO SCALE Second Floor Plan – Electrical - REG/-ROJECT: DATE: 9815 3/18/99 PROJECT: SCALE: 1/8"=1'-0" COUNSULTING ENGINEERS, INC. SHEET NUMBER: KHE.2 © 1999 PETTIT & PETTIT CONSULTING ENGINEERS, INC. iteelman Connell Moseley Architects P.A. ©1997

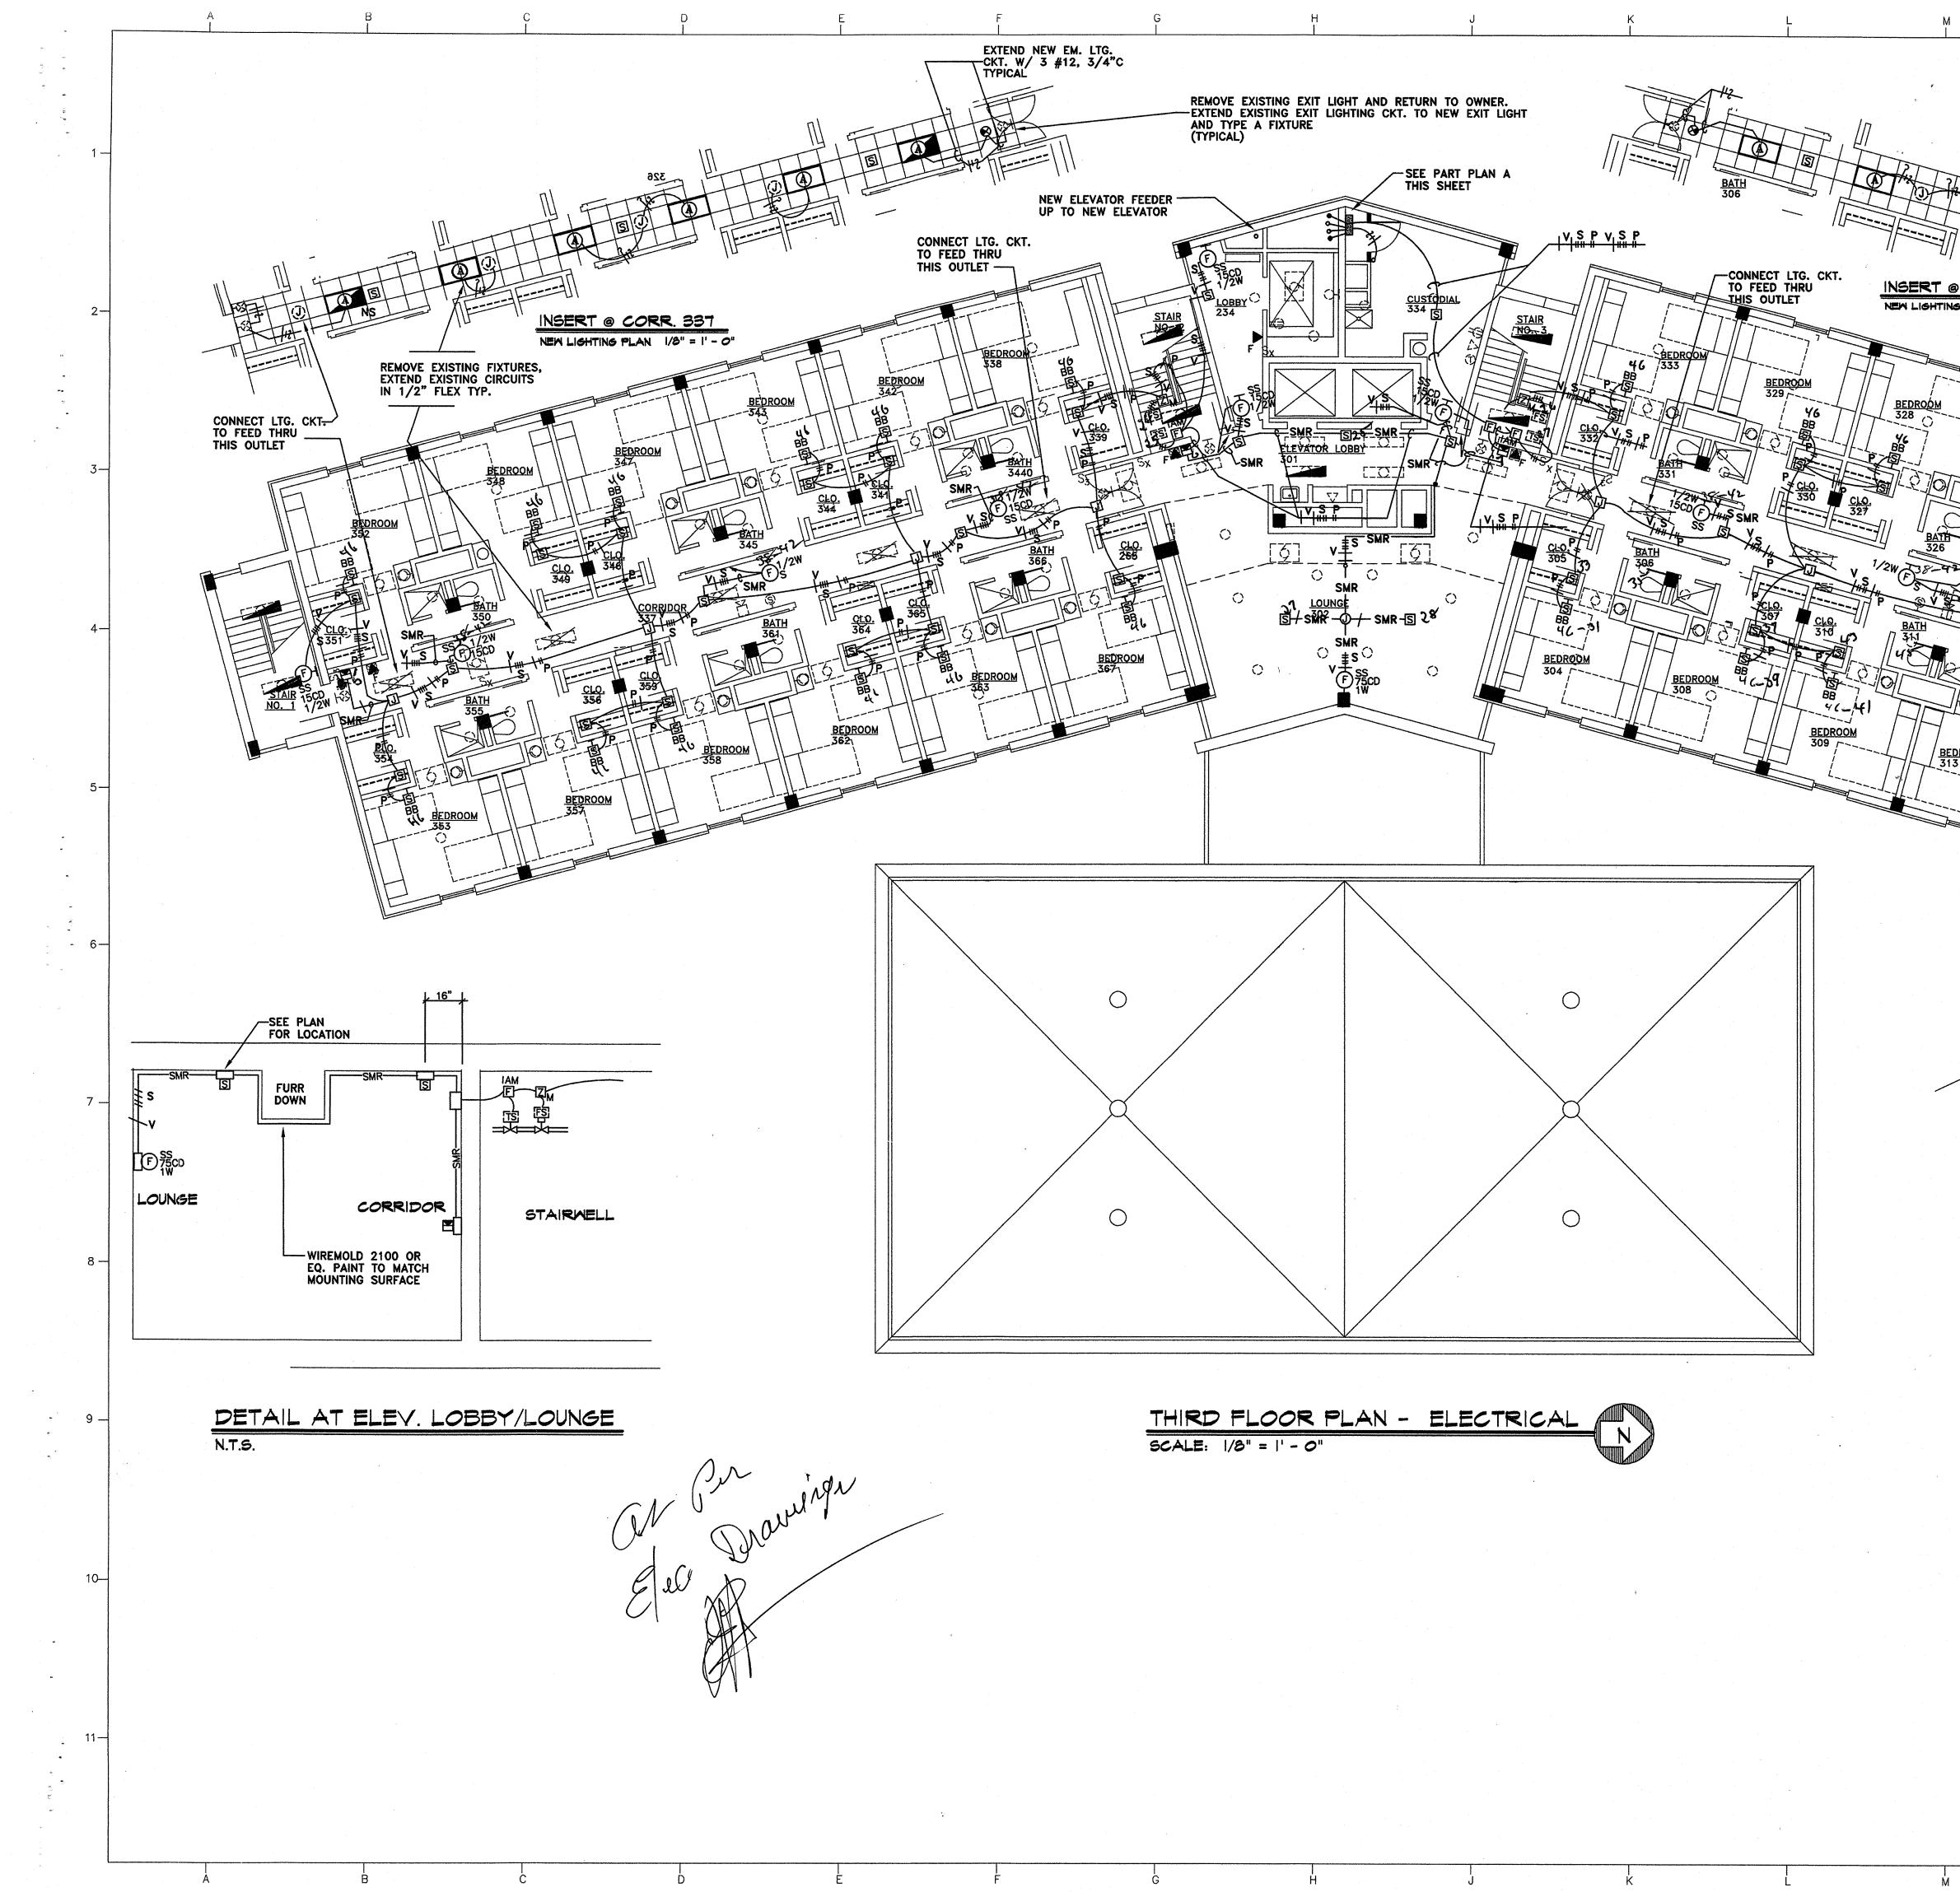


ARKANSA -EXTEND EXISTING CKT TO NEW FIXTURE RELOCATE EXISTING EXIT LIGHT TO DIRECTLY BELOW NEW CLG. EXTEND EXISTING CKT IN NEW 3-#12, 3/4"C TO RELOCATED EXIT LGT. AND NEW TYPE A FIX. TYPICAL TYPICAL PETTIT & PETTIT <u> SERT @ CORR. 303</u> NEW LIGHTING PLAN 1/8" = 1' -Å. Ð \_ Ð 22 N L 0 501 CONNECT LTG. CKT. TO FEED THRU THIS OUTLET **N** BEDROOM BEDROO Ð C U U U BEDROON B  $\mathbf{C}$ 4 C đ E C 0 <u>الم</u> **U** 104 501 N A DROOM 46-18 BEDROOM BEDROON E WOMEN COLLEGI VERSITY VSAS UP TO 4th FLOOR FIRE ALARM DEVICES - SEE SHT. KHE.5 ARKANSAS STATE UNI JONESBORO, ARKAN RY FOR STATE - TO 2nd FLOOR FIRE ALARM DEVICES - SEE SHT. KHE.3 - NEW 4020 - NODE A DORMITORY ARKANSAS ST - MAIN COMM LINES DOWN TO FIRST FLOOR - THEN TO F.A.P. - SEE SHT. KHE.2 - MAIN COMM LINES UP TO 4020 NODE B ON 6th FLOOR SEE SHT. KHE.7 - NEW 2 HR. RATED CHASE FOR FIRE ALARM WIRING ONLY PART PLAN A **REVISIONS:** KEY PLAN: NOT TO SCALE -10 Third Floor Plan -Electrical REG PROJECT: DATE: 9815 3/18/99 SCALE: 1/8\*=1'-0" PETTIT & PETTIT COUNSULTING ENGINEERS, INC. SHEET NUMBER: KHE.3 © 1999 PETTIT & PETTIT CONSULTING ENGINEERS, INC. Steelman Connell Moseley Architects P.A. ©1997

EXTEND NEW EM. LTG. CKT. W/ 3 #12, 3/4"C TYPICAL REMOVE EXISTING EXIT LIGHT AND RETURN TO OWNER. --EXTEND EXISTING EXIT LIGHTING CKT. TO NEW EXIT LIGHT AND TYPE A FIXTURE (TYPICAL) CLOSET - 4020 NODE B 6th Floor Only See PART PLAN A THIS SHT. NEW ELEVATOR FEEDER-UP TO NEW ELEVATOR V S P V S P CONNECT LTG. CKT. TO FEED THRU THIS OUTLET 6E-34 UP REPLACE WITH NEW PANEL 6E IN SAME LOGATION -30,32,34 5 5 NSERT @ CORR. 436 NEW LIGHTING PLAN 1/8" = 1' - O' BEDROON REMOVE EXISTING FIXTURES, EXTEND EXISTING CIRCUITS IN 1/2" FLEX TYP. BEDROOM BEDROOM BEDROOM CONNECT LTG. CKT. TO FEED THRU \_\_\_\_\_ THIS OUTLET BEDROOM BEDROOM 469 BEDROOM 467 BEDROOM 471 0 0 BEDROOM BEDROOM BEDROOM DROO 48-29 BEDROOM BEDROON 4th Floor Lounge Smokes SEDROOM W 2100R COMPUTER LAB SMOKIS 63 BEDROOM BEDROOM TYPICAL (4th) 6th, 8th, 10th) FLOOR PLAN - ELECTRICAL 6th FLOOR SHOWN AS TYPICAL SCALE: 1/8" = 1' - 0" al Pin Elel 8th FLOOR - UP TO 4020 NODE C ON 9th FLOOR 2HR. CHASE EXCLUSIVELY FOR FIRE ALARM WIRING ------TO F.A. DEVICES ON 10th FLOOR TO F.A. DEVICES ON 8th FLOOR 8. DN. TO F.A. DEVICES ON 5th FLOOR – SEE SHT. KHE.6 MAIN COMM. LINES DOWN TO 4020 NODE A ON 3rd FLOOR SEE SHT. KHE.4-------4020 NODE B TE6-32 S TO 6th FLOOR F.A. DEVICES MAIN COMM. LINES UP TO 4020 NODE C ON 9th FLOOR - SEE SHT. UP TO 9th FLR.-۰. KHE.6-----E6-30,34 -DOWN TO 3rd FLOOR PART PLAN A 4020 NODE B CLOSET ON 6th Floor Only N.T.S. 10-11

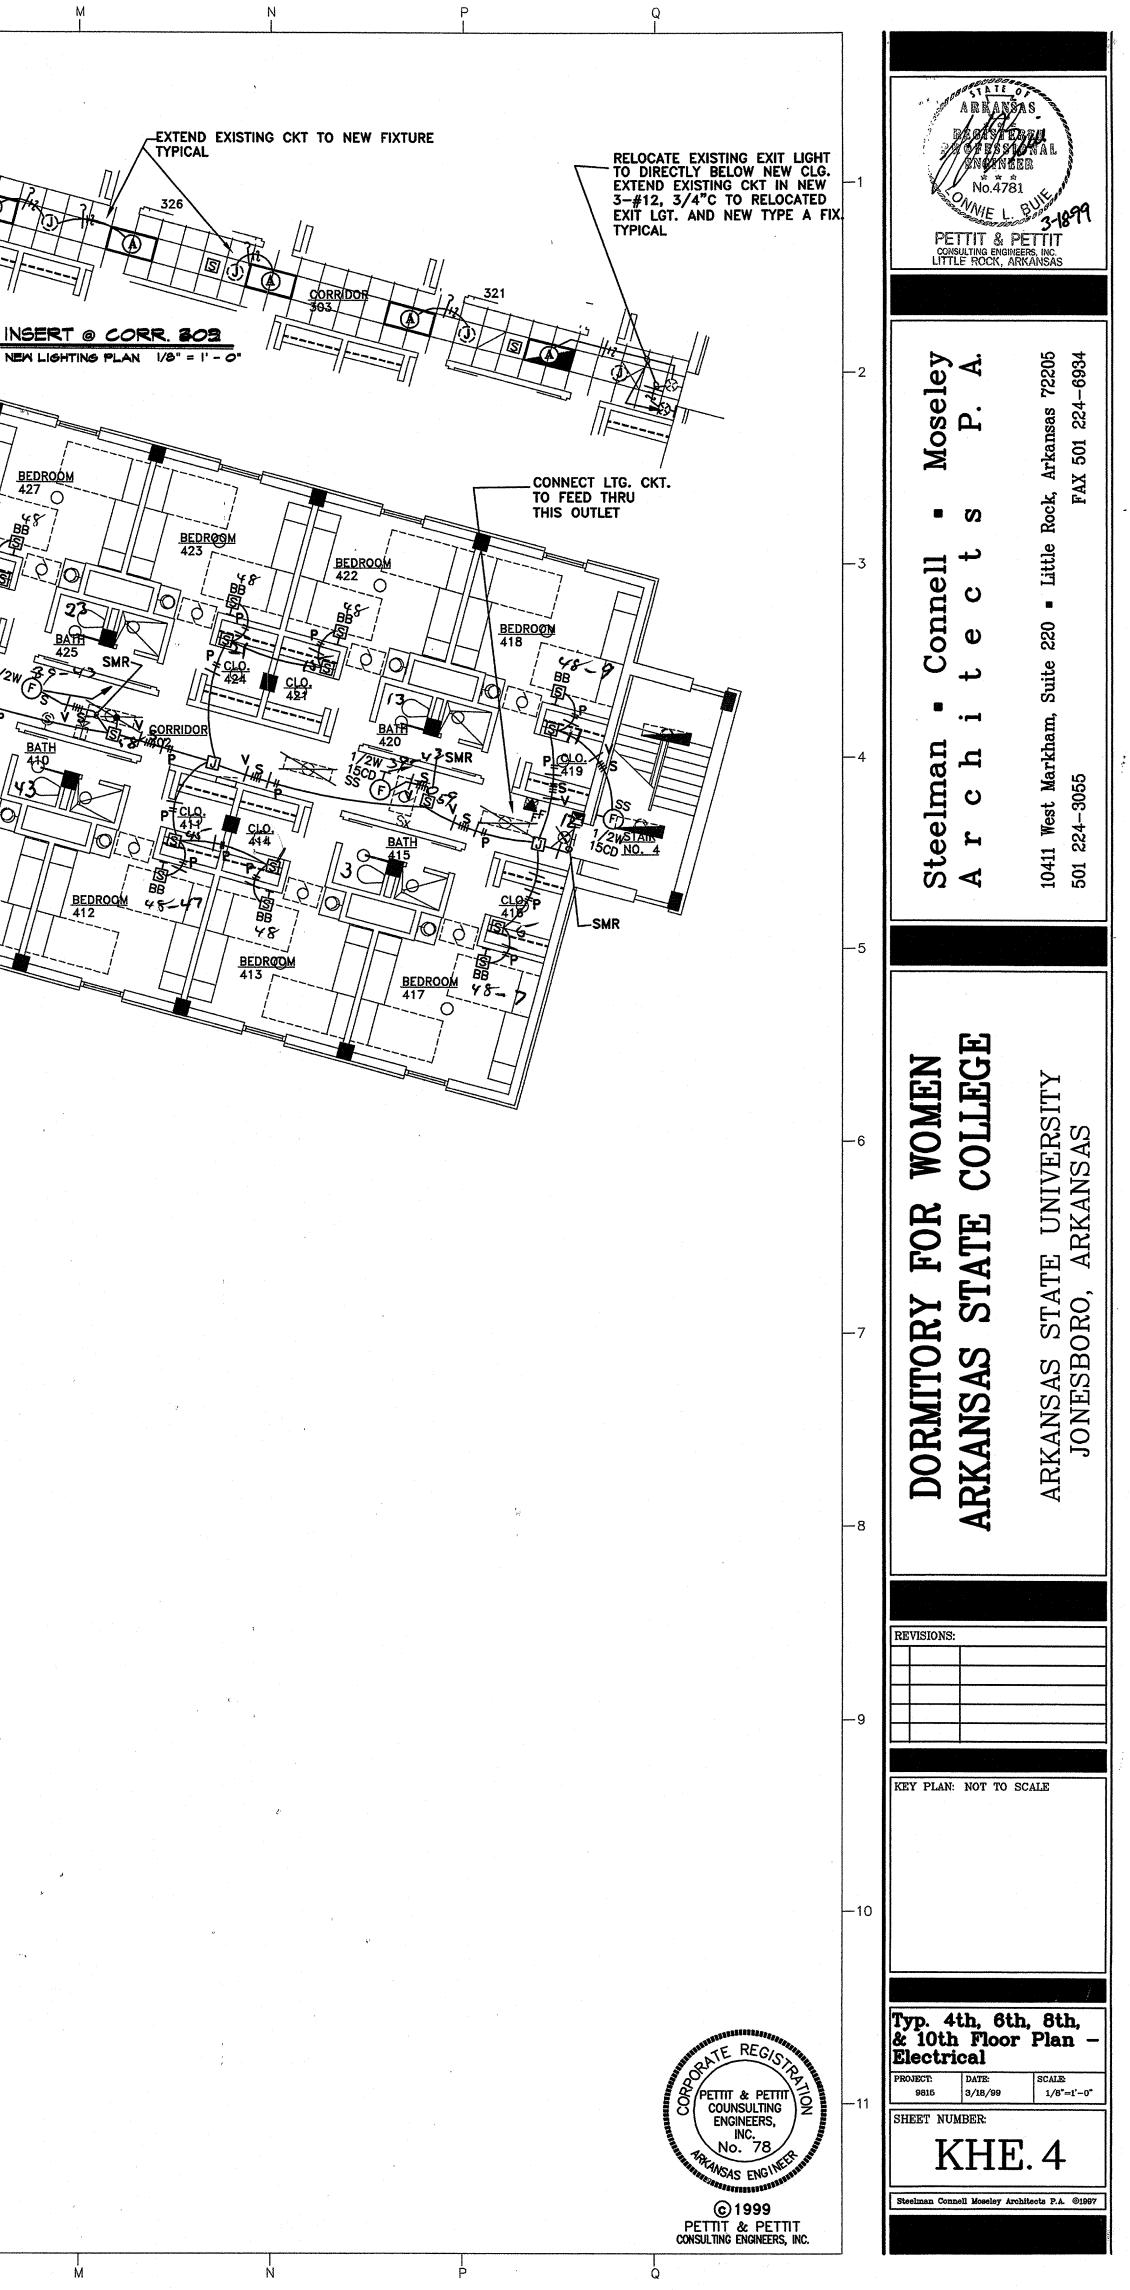

THIS OUTLET -<u> 15ert @ Corr. 537(737,937)</u> NEW LIGHTING PLAN 1/8" = 1' - 0 REMOVE EXISTING FIXTURES, EXTEND EXISTING CIRCUITS IN 1/2" FLEX TYP. BEDROON CONNECT LTG. CKT.--TO FEED THRU \_\_\_\_\_ THIS OUTLET BEDROOM SCALE: 1/8" = 1' - 0" SYMMBOLS SCHEEDURE: e n on o a car on o a SYMBOL DESCRIPTION SYMBOL DESCRIPTION BRANCH CIRCUIT IN CONDUIT - SWITCH LEG, PHASE LEG, NEUTRAL, EQUIPMENT 5-192 FLUORESCENT LIGHT FIXTURE - CEILING MOUNTED GROUND, AND ISOLATED GROUND INDICATED **O** FLUORESCENT LIGHT FIXTURE CONNECTED TO EMERGENCY \$<del>12</del> BRANCH CIRCUIT HOMERUN - PANEL AND CIRCUIT NUMBER INDICATED POWER CIRCUIT H-0-1 FLUORESCENT STRIP LIGHT - CEILING MOUNTED OR CHAIN HUNG 4---CONDUIT CONCEALED IN OR BELOW FLOOR SLAB OR BELOW GRADE Ō FLIORESCENT LIGHT FIXTURE - WALL MOUNTED WITH EM, BALLAST \_\_\_\_ EXISTING CONDUIT FLUORESCENT LIGHT FIXTURE - WALL MOUNTED EMERGENCY CIRCUIT(S) (SHOWN WITH NON-ARCHED LINES) 0 INCANDESCENT, FLUORESCENT, OR HID DOWNLIGHT FIXTURE - CEILING MOUNTED С DISCONNECT SWITCH INCANDESCENT, FLUORESCENT, OR HID DOWNLIGHT FIXTURE - CEILING MOUNTED COMBINATION MOTOR STARTER / DISCONNECT SWITCH CONNECTED TO EMERGENCY POWER CIRCUIT INCANDESCENT, FLUORESCENT, OR HID LIGHT FIXTURE - WALL MOUNTED EXISTING X MOTOR STARTER EXISTING LIGHT FIXTURE RECONNECTED TO NEW EMERGENCY LIGHTING CKT. SURFACE MOUNTED PANELBOARD V FLUSH MOUNTED PANELBOARD - EXISTING 4 EMERGENCY LIGHT FIXTURE \_\_\_\_\_ EXIT LIGHTS - WALL MT. & CEILING MT. SHOWN - SHADING INDICATES FACE(S), DIRECTIONAL ARROWS SHALL BE AS SHOWN ON PLANS TELEPHONE TERMINAL BOARD S/S Ê <sup>75</sup> FIRE ALARM STROBE ONLY (WALL MTD.) - NUMBER INDICATES MINIMUM CANDELA RATING OF STROBE SINGLE-POLE TOGGLE SWITCH NEW / EXISTING  $S_3/S_3$ THREE-WAY TOGGLE SWITCH NEW / EXISTING FIRE ALARM PULL STATION, ADDRESSABLE 10--Sm MANUAL MOTOR STARTER WITH OVERLOADS, TOGGLE OPERATED E HEAT DETECTOR, ADDRESSABLE Ф DUPLEX RECEPTACLE S SMOKE DETECTOR, ADDRESSABLE ф <sup>vc</sup> DUPLEX RECEPTACLE MOUNTED ABOVE COUNTER TOP - VERIFY MOUNTING HEIGHT WITH ARCHITECTURAL DRAWINGS [되 모BB SMOKE DETECTOR W BUZZER BASE, ADDRESABLE TL⊕GFI ₩P⊕SP DUPLEX RECEPTACLE - GROUND FAULT INTERRUPTING, SURGE PROTECTION, TWIST-LOCK, & WEATHERPROOF TYPES INDICATED [S]<sub>D</sub> DUCT MOUNTED SMOKE DETECTOR ◀ FIREMANG TELEPHONE OUTLET [FS] FLOW SWITCH (FURNISHED BY DIVISION 15) 🗲 W TELEPHONE OUTLET - WALL MOUNTED . 48" A.F.F. U.O.N. ĨŜ TAMPER SWITCH (FURNISHED BY DIVISION 15) TELEPHONE OUTLET- MOUNTED ABOVE COUNTER TOP - VERIFY 🗲 AC DH DOOR HOLDER (FURNISHED BY DIVISION 8) MOUNTING HEIGHT WITH ARCHITECTURAL DRAWINGS IJ JUNCTION BOX [Z]<sub>M</sub> ZONE ADDRESSABLE MONITOR MODULE

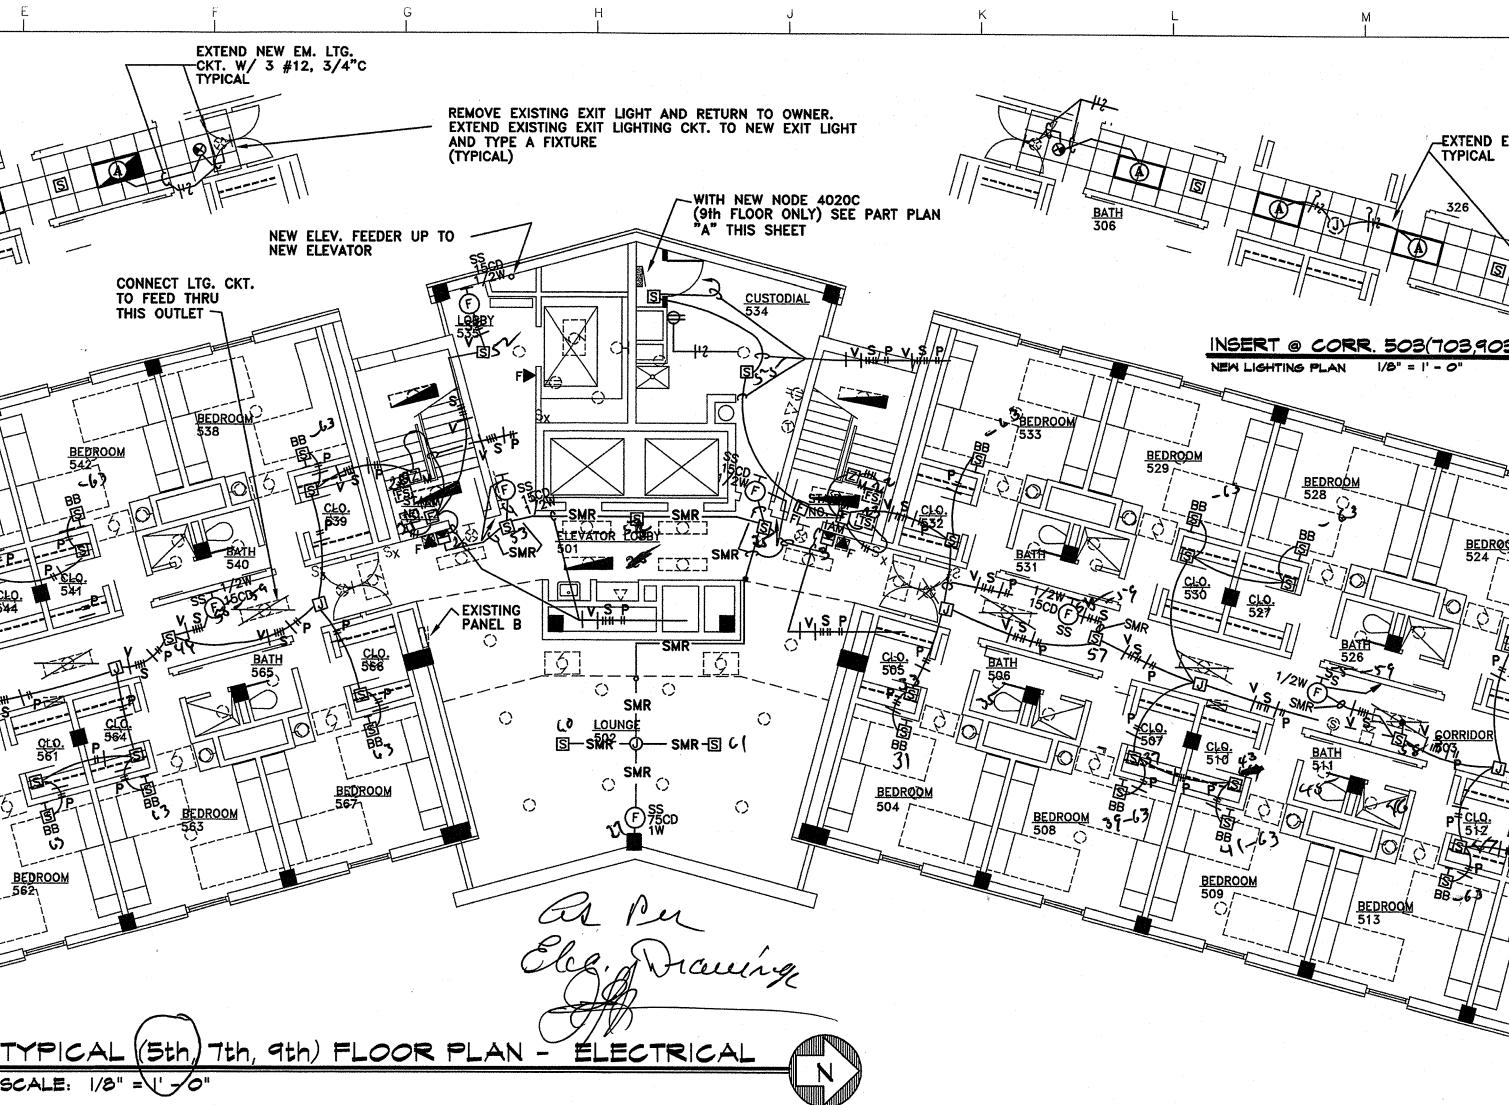


MAIN LINE COMM. DOWN MAIN-LINE COMM. DOWN


	SYMBOLS SCHEDULE.					
SYMBOL	DESCRIPTION					
(E) <sub>IAM</sub>	INDIVIDUAL ADDRESGABLE MODULES					
E	FIRE ALARM SYSTEM FAULT ISOLATOR MODULE					
Zc	ZONE ADDRESSABLE CONTROL MODULE					
(E) <sup>S</sup> <sub>1/2W</sub>	F.A.VOICE EVAC SYSTEM RECESSED CEILING SPEAKER, 8", NUMBER INDICATES WATTAGE TAP, "S" INDICATES SPEAKER ONLY					
©1/2W	F.A.VOICE EVAC SYSTEM RECESSED CEILING SPEAKER/STROBE, 8", NUMBER INDICATES WATTAGE TAP, CD INDICATES MIN CANDELA RATING OF STROBE					
	F.A. VOICE EVAC SPEAKER/STROBE DEVICE (WALL MTD.) - CD NUMBER INDICATES INDICATES MIN. CANDELA RATING OF STROBE, W NUMBER INDICATES WATTAGE TAP					
₫ <mark>\$</mark> 1/2₩	F.A.VOICE EVAC SYSTEM WALL MTD. SPEAKER, "S" INDICATES SPEAKER ONLY NUMBER INDICATES WATTAGE TAP					
(Î)	THERMOSTAT					
AC	ABOVE COUNTER					
AFF	ABOVE FINISH FLOOR					
СКТ	CIRCUIT					
GFI	GROUND FAULT INTERRUPTING					
MTD	MOUNTED					
NFDS	NON-FUSED DISCONNECT SWITCH					
<u>چ</u>	EXISTING ITERCOM SPEAKER TO REMAIN					
F	EXISTING F.A. PULLSTA. REMOVE USE FOR NEW FIREMANS PHONE SYSTEM					
К	Existing Exit light to remain					
[[0]]	Exist. Surf. Fluor. Fixture to Remain					
	EXIST. SURF. FLUOR. FIXTURE TO BE REMOVED, CONNECT EXISTING CKT. TO WIRE THRU. OR EXTEND TO NEW FIXTURE AS INDICATED					
—9MR—	SURFACE METAL RACEWAY - WIREMOLD 2100					
斑	EXIST. RECESSED F.A. HORN - ABANDON IN PLACE					


	SEMBOLS SCHEDELE
SYMBOL	DESCRIPTION
P	F.A. 24V DC POWER #12 ANG MIN.
<b>A</b>	F.A. ADDRESSABLE ANNINCIATOR CABLE SHIELDED TWISTED PAIR
T	F.A. FIREMANS PHONE SYSTEM CABLE UNSHIELDED TWISTED PAIR
	F.A. ADDRESSABLE LOOP CABLE SHIELDED TWISTED PAIR
	F.A. VOICE EVAC CABLE UNSHIELDED TWISTED PAIR
- <del>111</del>	F.A. SIGNAL WIRING #12 AWG MIN.
EANN	FIRE ALARM SYSTEM ANNUNCIATOR


ABAAAS -EXTEND EXISTING CKT TO NEW FIXTURE RELOCATE EXISTING EXIT LIGHT TO DIRECTLY BELOW NEW CLG. EXTEND EXISTING CKT IN NEW 3-#12, 3/4"C TO RELOCATED EXIT LGT. AND NEW TYPE A FIX. TYPICAL SS MAA YPICAL No.4781 PETTIT & PETTIT ACONSULTING ENGINEERS, INC. LITTLE ROCK. ARKANSAS Å. **(**) el 22 ρ. Ŋ C 501 CONNECT LTG. CKT. TO FEED THRU THIS OUTLET N BEDROOM ell **JEDROOM** C BEDROON **(**) O  $\mathbf{C}$ د C 0) 104 501 N A EDROO BEDROOM BEDROOM COLLEGE WOMEN VERSITY VSAS UP TO F.A. DEVICES IN ELEV. PENTHOUSE, SEE SHT. KHE.8 ----ARKANSAS STATE UN JONESBORO, ARKA UP TO F.A. DEVICES ON 11th FOR STATE FLOOR - SEE SHT. KHE.7 ----NEW 4020 - NODE C 0-1 UP TO F.A. DEVICES ON 10th FLOOR - SEE SHT. KHE DORMITORY ARKANSAS S TO 4020B ON 6th FLR. \_\_\_\_\_ DOWN TO E6−34 ₹P TO 1st FLOOR THEN TO FAP TO F.A. DEVICES ON PART PLAN A 9th FLOOR N.T.S. 9th FLOOR **REVISIONS:** KEY PLAN: NOT TO SCALE Typ. 5th, 7th & 9th Floor Plan – Electrical DATE: ROJECT: SCALE PETTIT & PETTIT COUNSULTING ENGINEERS, INC. 9816 3/18/99 1/8"=1'-0" SHEET NUMBER: KHE.5 No. Steelman Connell Moseley Architects P.A. ©1997 ©1999 PETTIT & PETTIT CONSULTING ENGINEERS, INC.

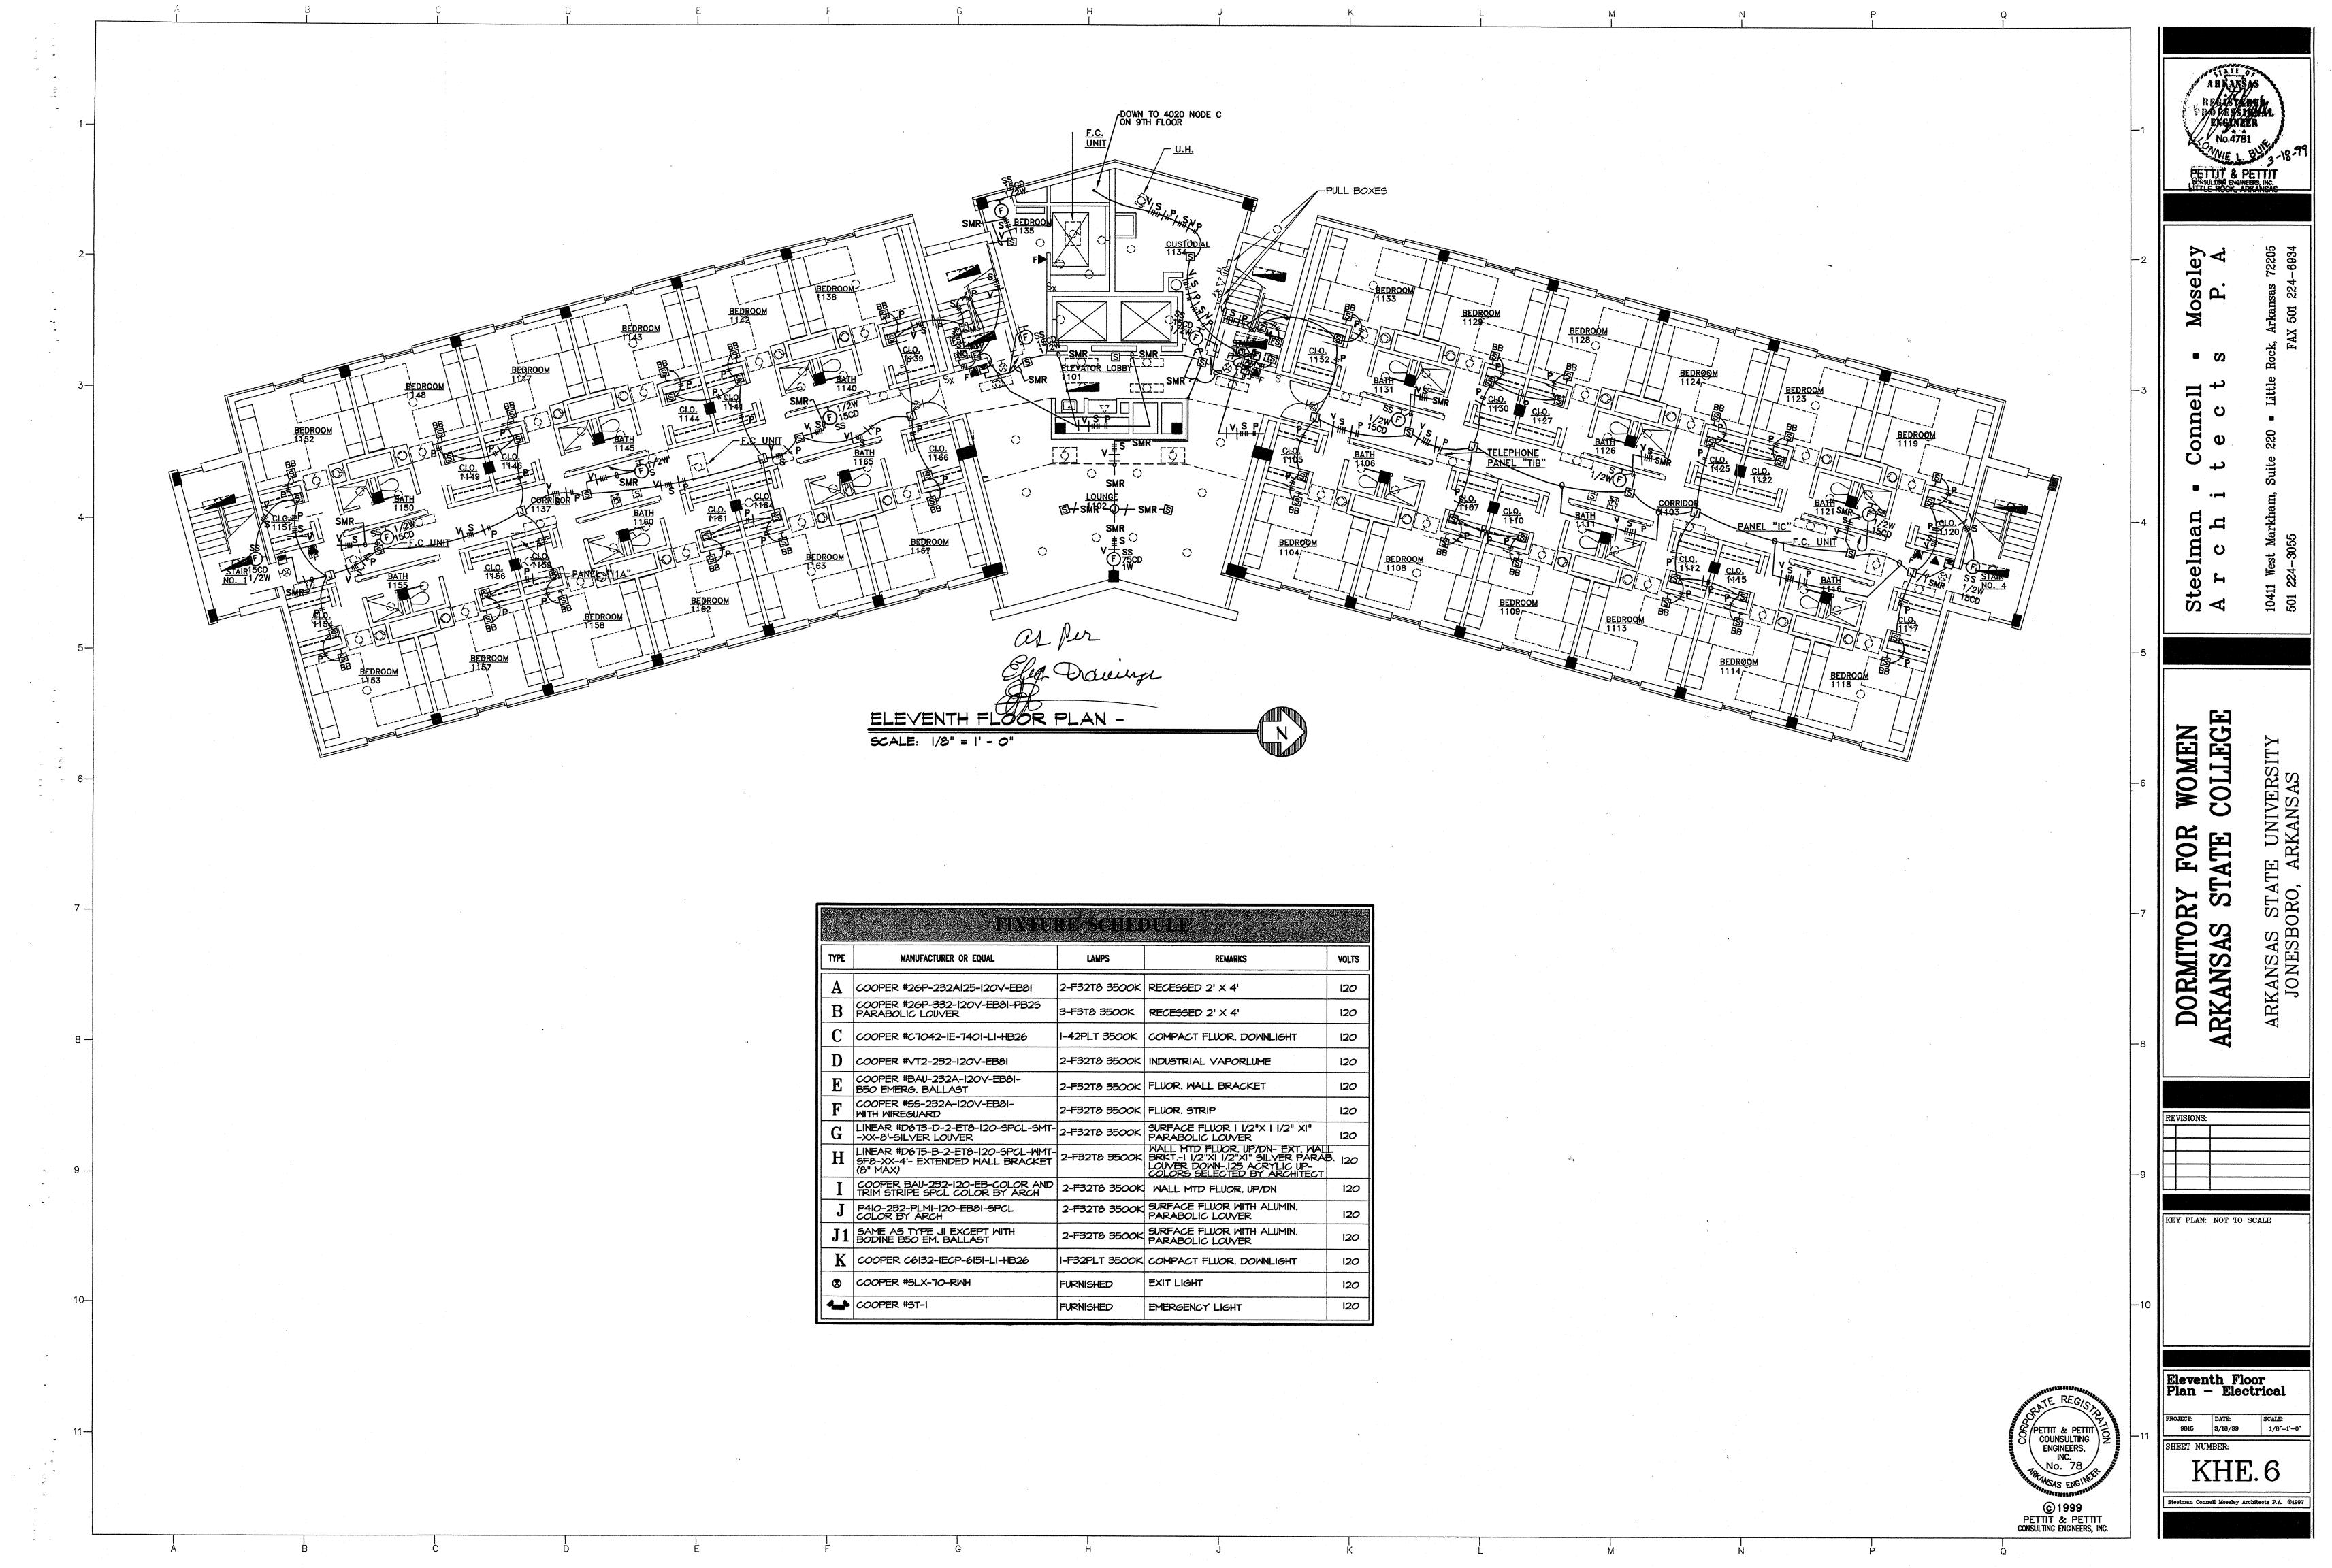

<b>10</b> 2 - 24	FIXED	RE SCHEI	DULE	
TYPE	MANUFACTURER OR EQUAL	LAMPS	REMARKS	VOLTS
Α	COOPER #26P-232A125-120V-EB81	2-F32T8 3500K	RECESSED 2' X 4'	120
B	COOPER #26P-332-120V-EB81-PB25 PARABOLIC LOUVER	3-F3T8 3500K	RECESSED 2' X 4'	120
C	COOPER #C7042-IE-740I-LI-HB26	1-42PLT 3500K	COMPACT FLUOR. DOWNLIGHT	120
D	COOPER #VT2-232-120V-EB81	2-F32T8 3500K	INDUSTRIAL VAPORLUME	120
E	COOPER #BAU-232A-120V-EB81- B50 EMERG. BALLAST	2-F32T8 3500K	FLUOR. WALL BRACKET	120
F	COOPER #55-232A-120V-EB81- WITH WIREGUARD	2-F32T8 3500K		120
G	LINEAR #D673-D-2-ET8-120-SPCL-SMT- -XX-8'-SILVER LOUVER	2-F32T8 3500K	SURFACE FLUOR   1/2"X   1/2" XI" PARABOLIC LOUVER	120
Η	LINEAR #D675-B-2-ET8-I20-SPCL-WMT- SF8-XX-4'- EXTENDED WALL BRACKET (8" MAX)	2-F32T8 3500K	WALL MTD FLUOR. UP/DN- EXT. WAL BRKTI I/2"XI I/2"XI" SILVER PARA LOUVER DOWN125 ACRYLIC UP- COLORS SELECTED BY ARCHITECT	L 3. 120
Ι	COOPER BAU-232-120-EB-COLOR AND TRIM STRIPE SPCL COLOR BY ARCH		WALL MTD FLUOR, UP/DN	120
J	P410-232-PLMI-120-EB81-SPCL COLOR BY ARCH	2-F32T8 3500K	SURFACE FLUOR WITH ALUMIN. PARABOLIC LOUVER	120
J1	SAME AS TYPE JI EXCEPT WITH BODINE B50 EM. BALLAST	2-F32T8 3500K	SURFACE FLUOR WITH ALUMIN. PARABOLIC LOUVER	120
K	COOPER C6132-1ECP-6151-LI-HB26	I-F32PLT 3500K	COMPACT FLUOR. DOWNLIGHT	120
⊗	COOPER #SLX-70-RWH	FURNISHED	EXIT LIGHT	120
4	COOPER #ST-I	FURNISHED	EMERGENCY LIGHT	120

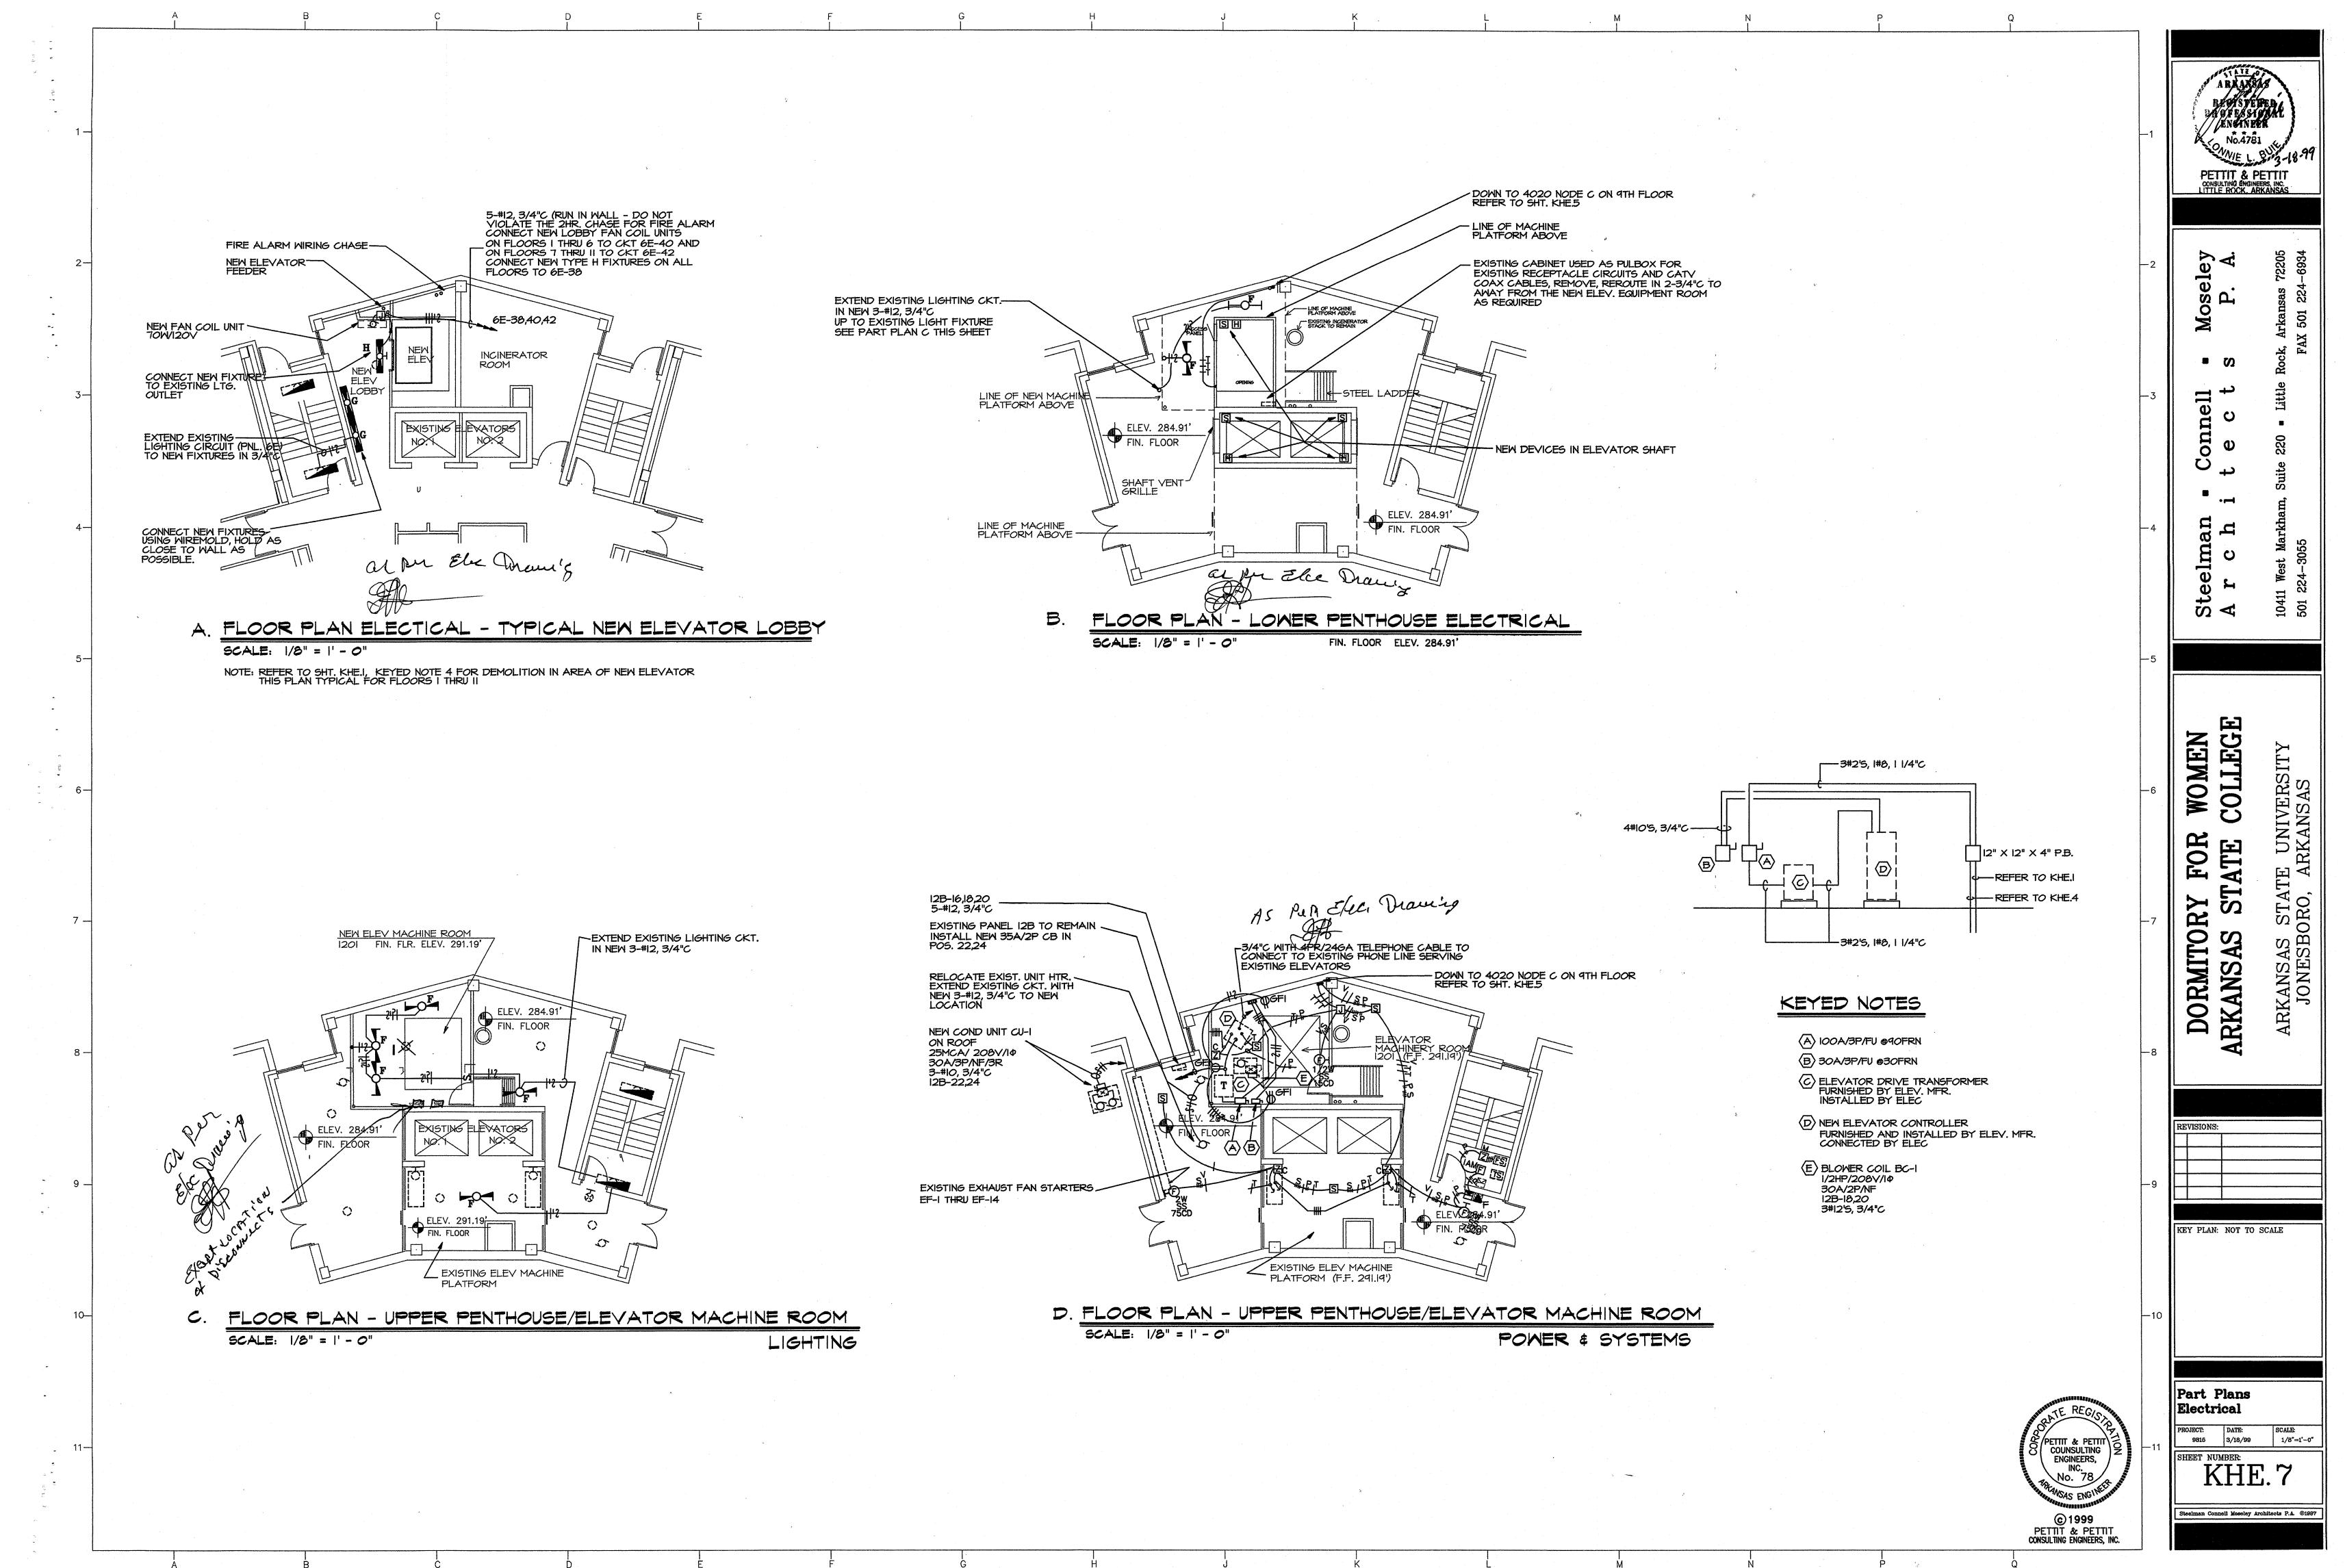

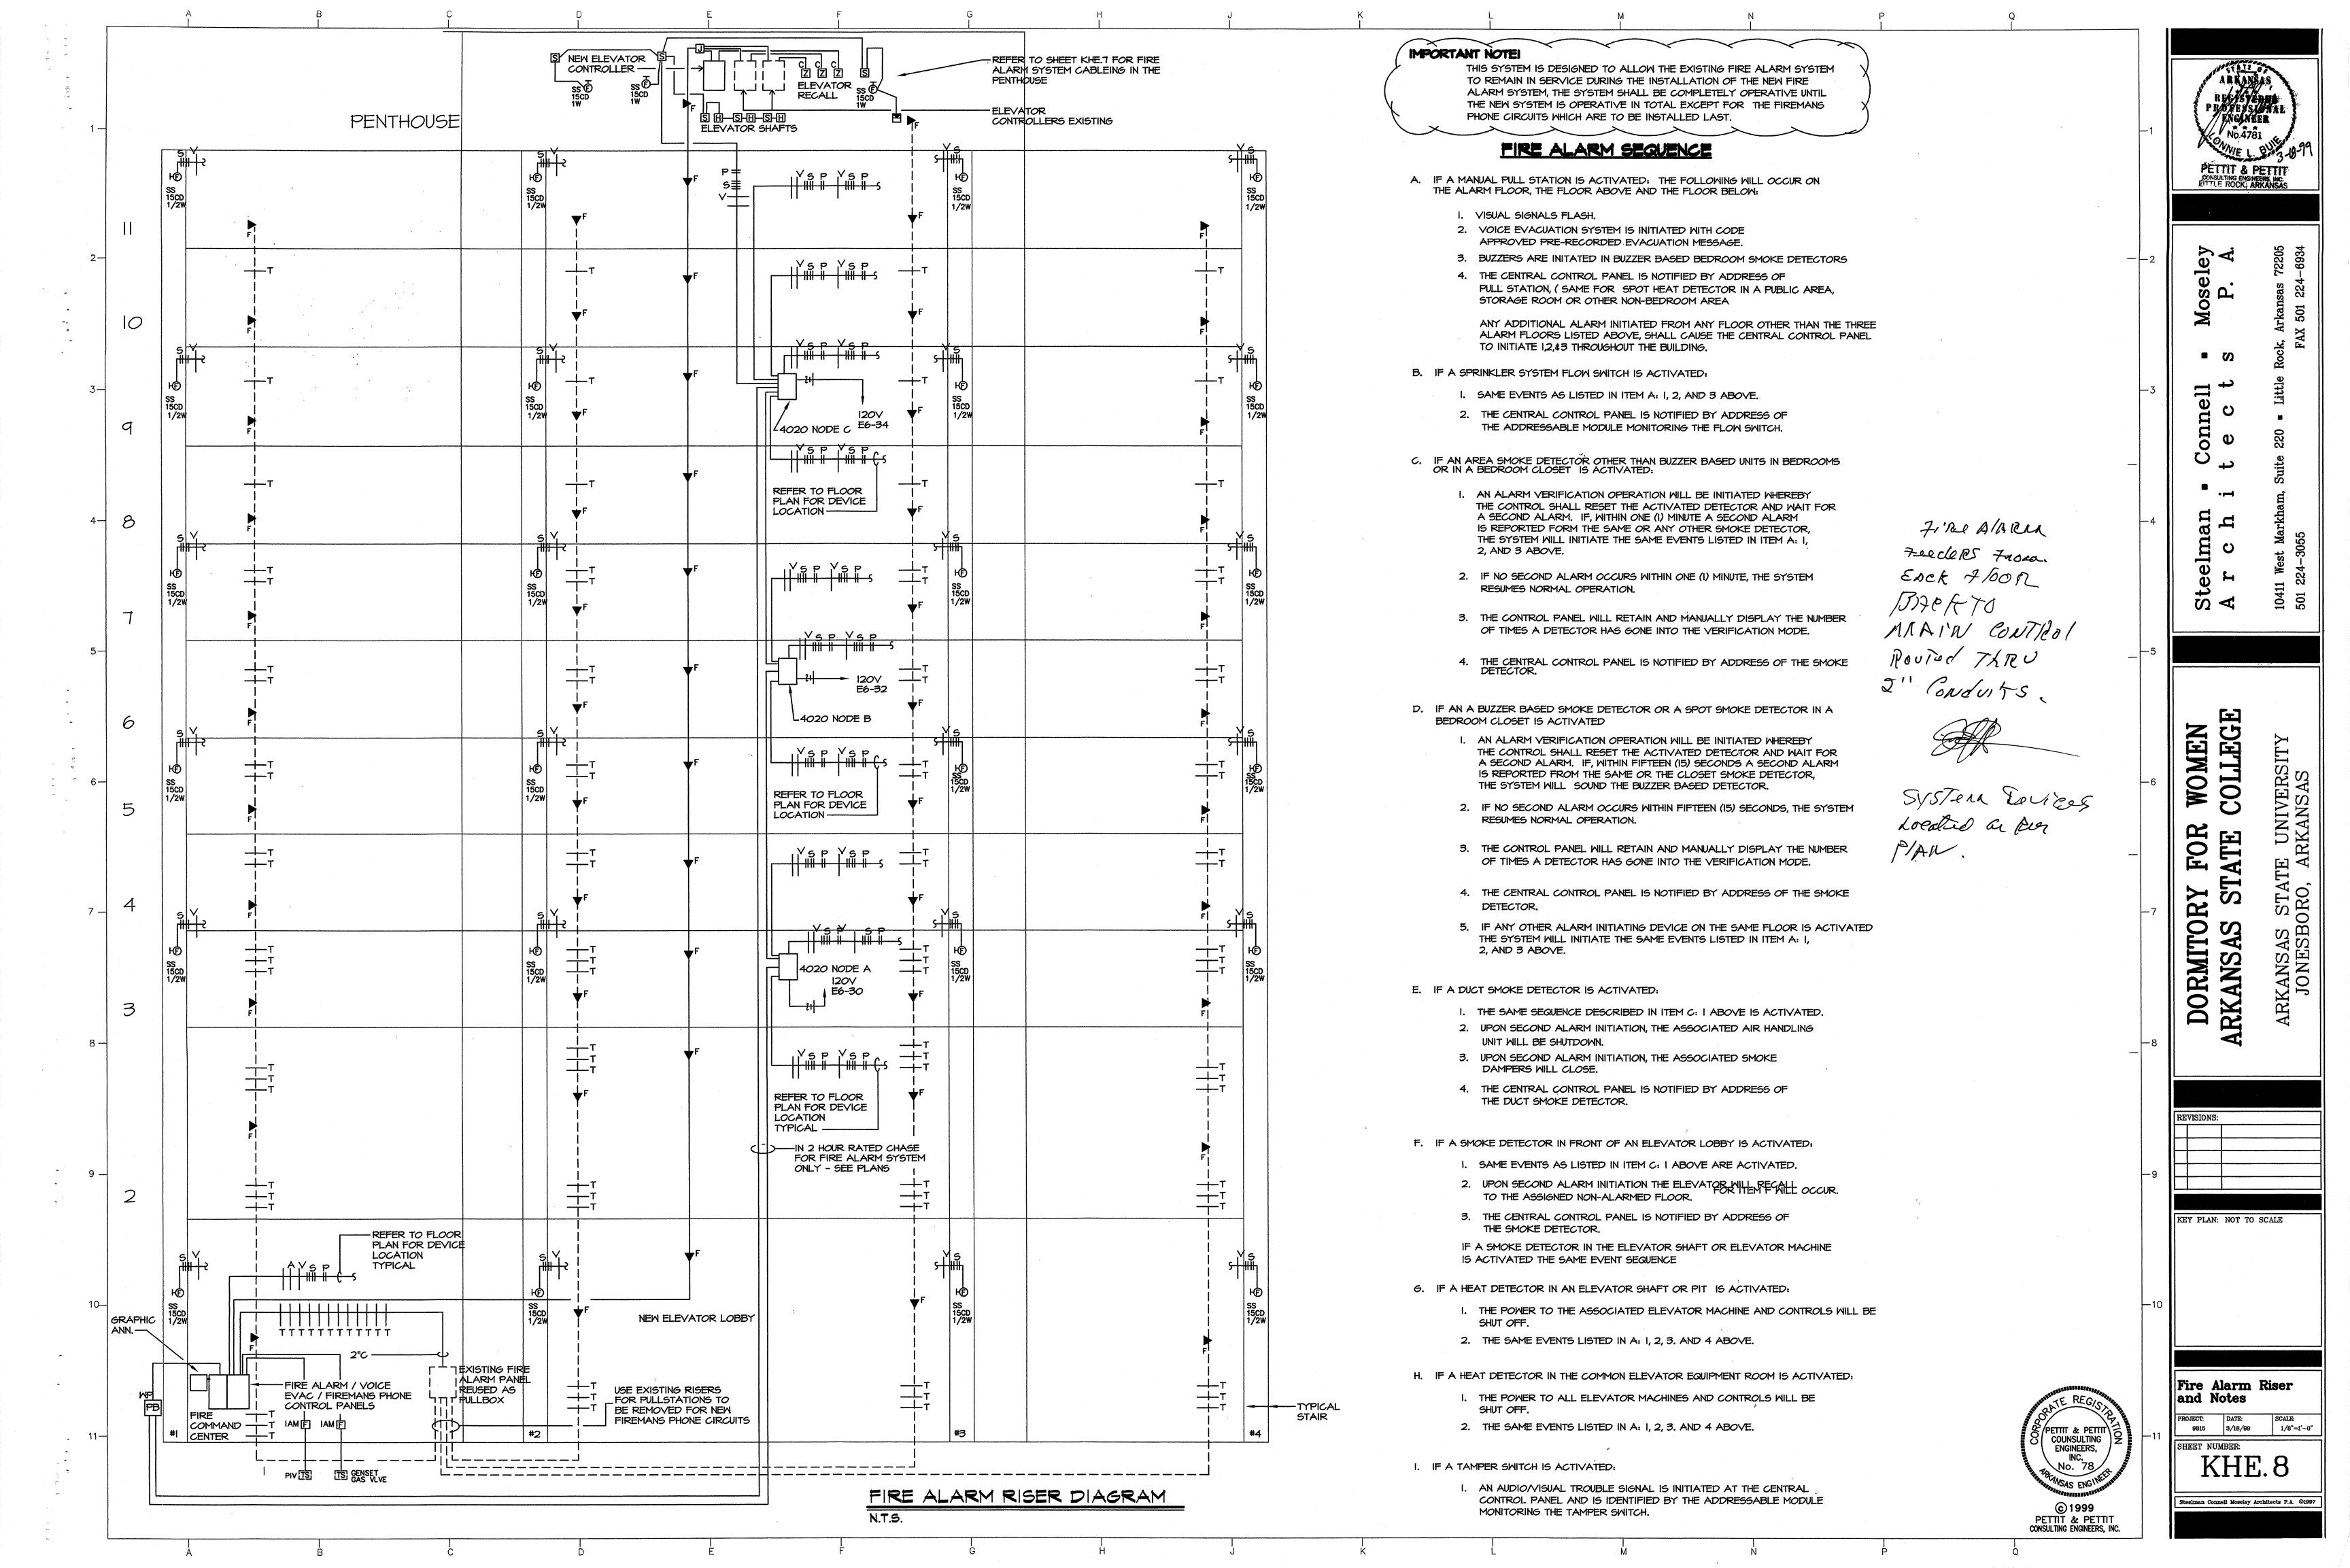

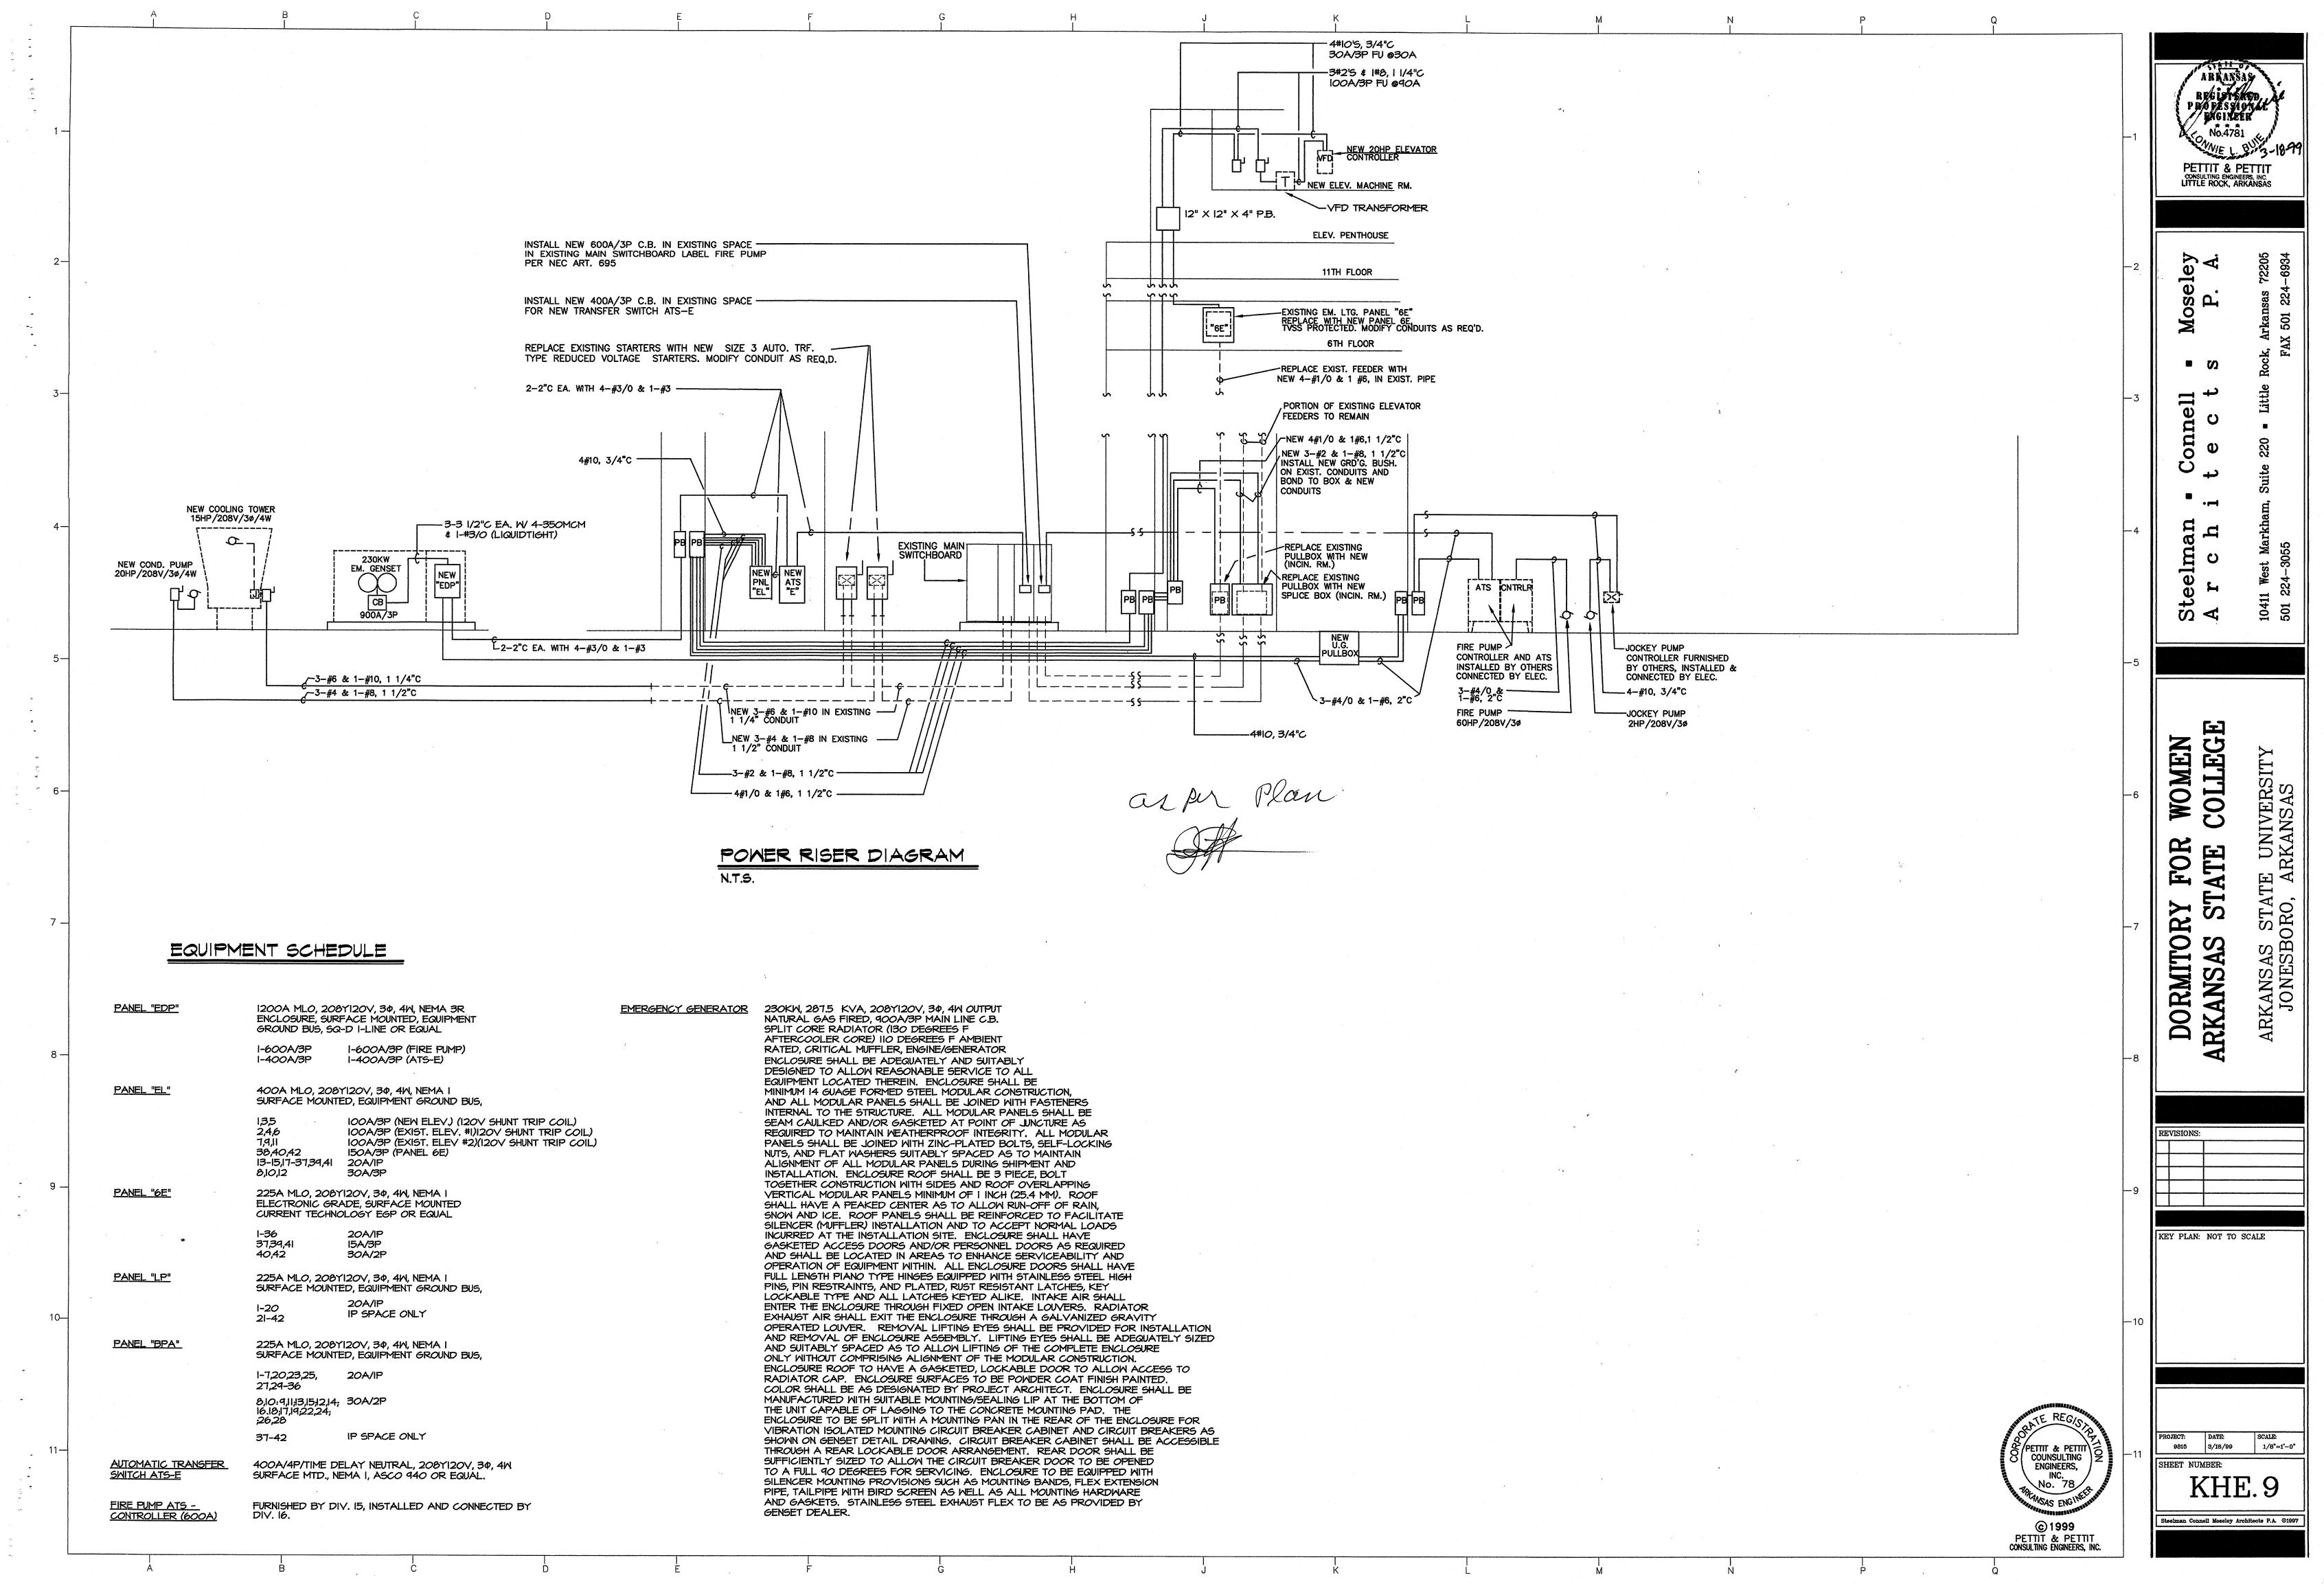

THIS CONTRACTOR SHALL BE RESPONSIBLE FOR ALL DEMOLITION IN AREAS OF RENOVATION. ALL WIRING DEVICES, LIGHT FIXTURES, WIRE AND CONDUIT SHALL BE REMOVED IN THESE AREAS AND STORED AS DIRECTED BY THE OWNER OR RELOCATED AS SHOWN ON THE NEW FLOOR PLAN. APPROPRIATE MEASURES SHALL BE TAKEN TO ASSURE CONTINUITY OF EXISTING CIRCUITS WHERE REQUIRED. SOME EXISTING MECH. EQUIPMENT, WIRING DEVICES, FIXTURES, ETC. MAY BE REQUIRED TO BE RECONNECTED TO NEW PANELBOARDS BASED ON EXISTING FIELD CONDITIONS. ALL POWER OUTAGES WHICH MAY RESULT SHALL BE COORDINATED WITH THE OWNER PRIOR TO THE WORK.

ENERAL DEMOLITION NOTES

ALL EXISTING BRANCH CIRCUITS NOT USED SHALL BE REMOVED BACK TO PANEL. THE CIRCUIT BREAKERS SHALL BE LABELED AS SPARE, AND EXISTING CONDUIT SHALL REMAIN FROM PANEL TO ABOVE ACCESSIBLE CEILING SPACE.

### KEYED DEMOLITION NOTES

1	REMOVE EXISTING LIGHT FIXTURE. TURN LIGHT FIXTURE OVER TO OWNER.
2	REMOVE EXISTING LIGHT FIXTURE. RELOCATE AS SHOWN ON NEW FLOOR PLAN.
3	EXISTING WIRING DEVICE TO REMAIN. MAINTAIN CONTINUITY OF EXISTING CIRCU
4	REMOVE EXISTING WIRING DEVICE, WIRE AND CONDUIT.
5	REMOVE ELECTRICAL CONNECTION TO EXISTING UNIT HEATER. INSTALL J-BOX AND EXTEND EXISTING CIRCUIT TO NEW LOCATION OF HEATER.
6	REMOVE EXISTING MOTOR CONTROL SWITCH. RELOCATE AS SHOWN ON NEW PLAN. EXTEND EXISTING CIRCUIT TO NEW SWITCH LOCATION.
7	REMOVE EXISTING CIRCUIT BREAKER ENCLOSURE AND ASSOCIATED BRANCH CIRCUITS.
8	REMOVE EXISTING SPEAKER AND RELOCATE AS SHOWN ON NEW PLAN. EXTEND EXISTING CIRCUIT TO NEW LOCATION.
9	REMOVE EXISTING WIRING DEVICE. INSTALL BLANK COVERPLATE.


NOTES:


\*


10-


11.


1. INSTALL SURFACE RACEWAY AND MATCHING DEVICE BOX EQUAL TO WIREMOLD #V700. PAINT TO MATCH WALL.

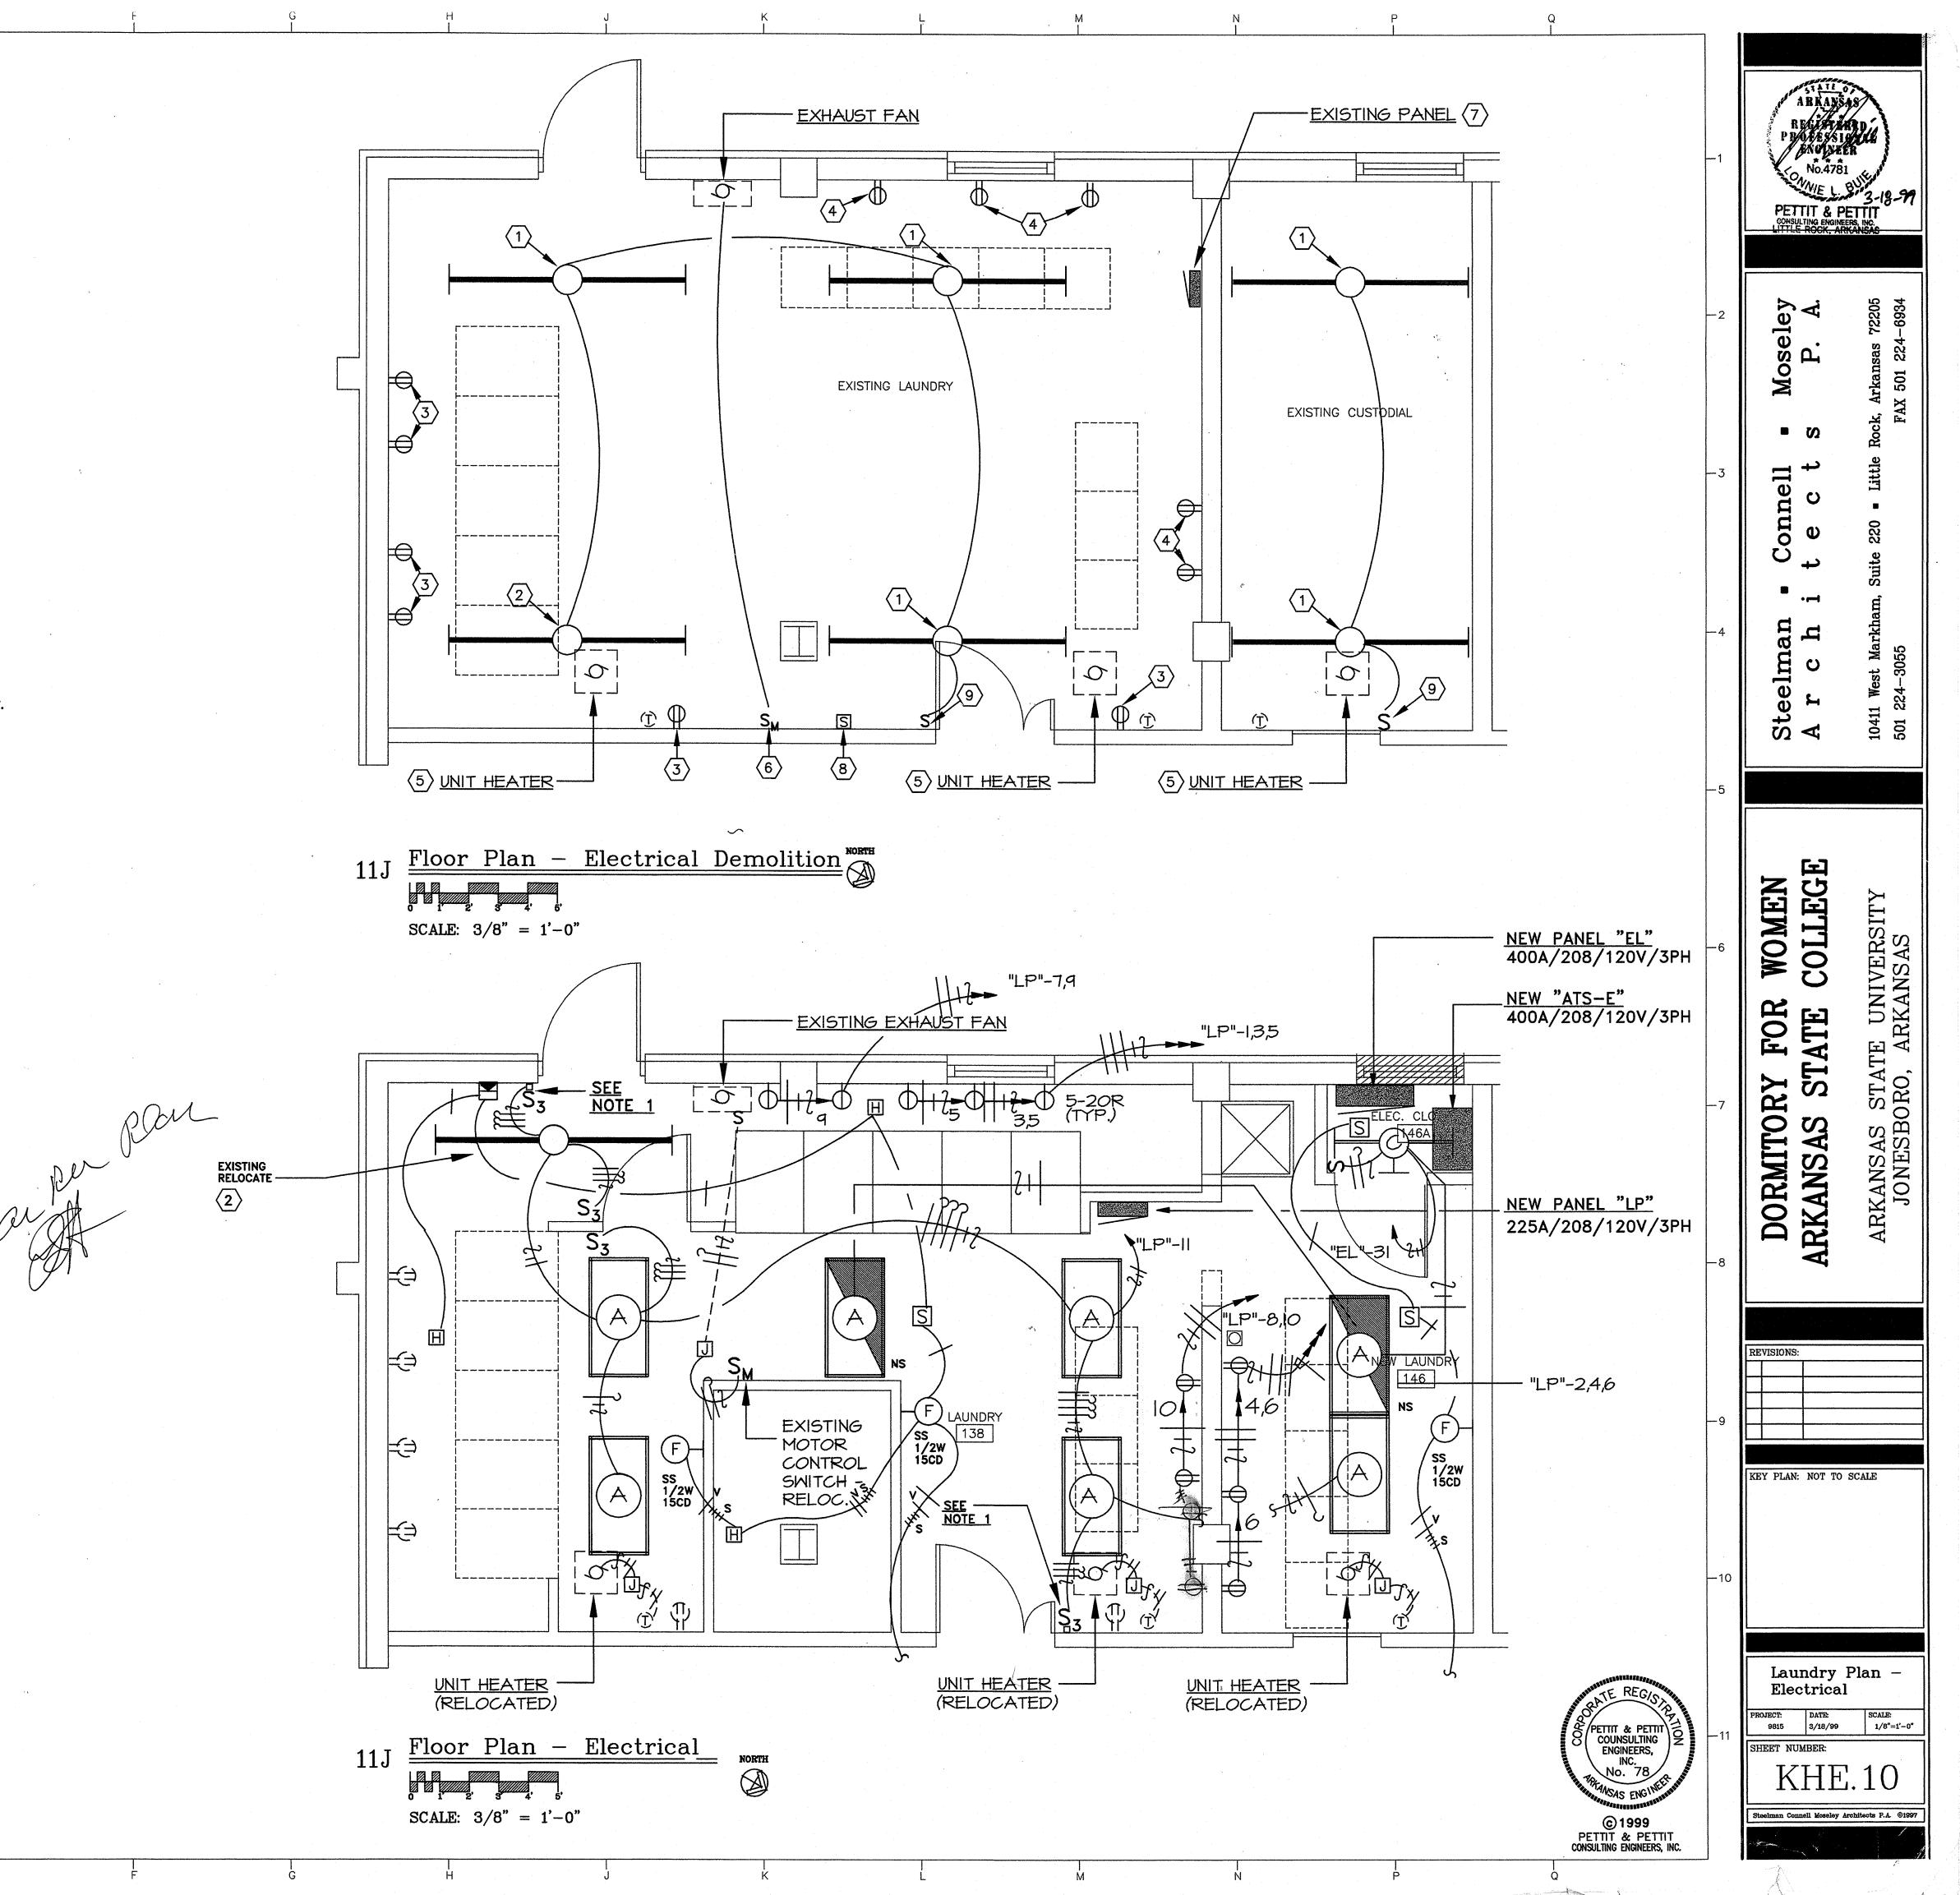


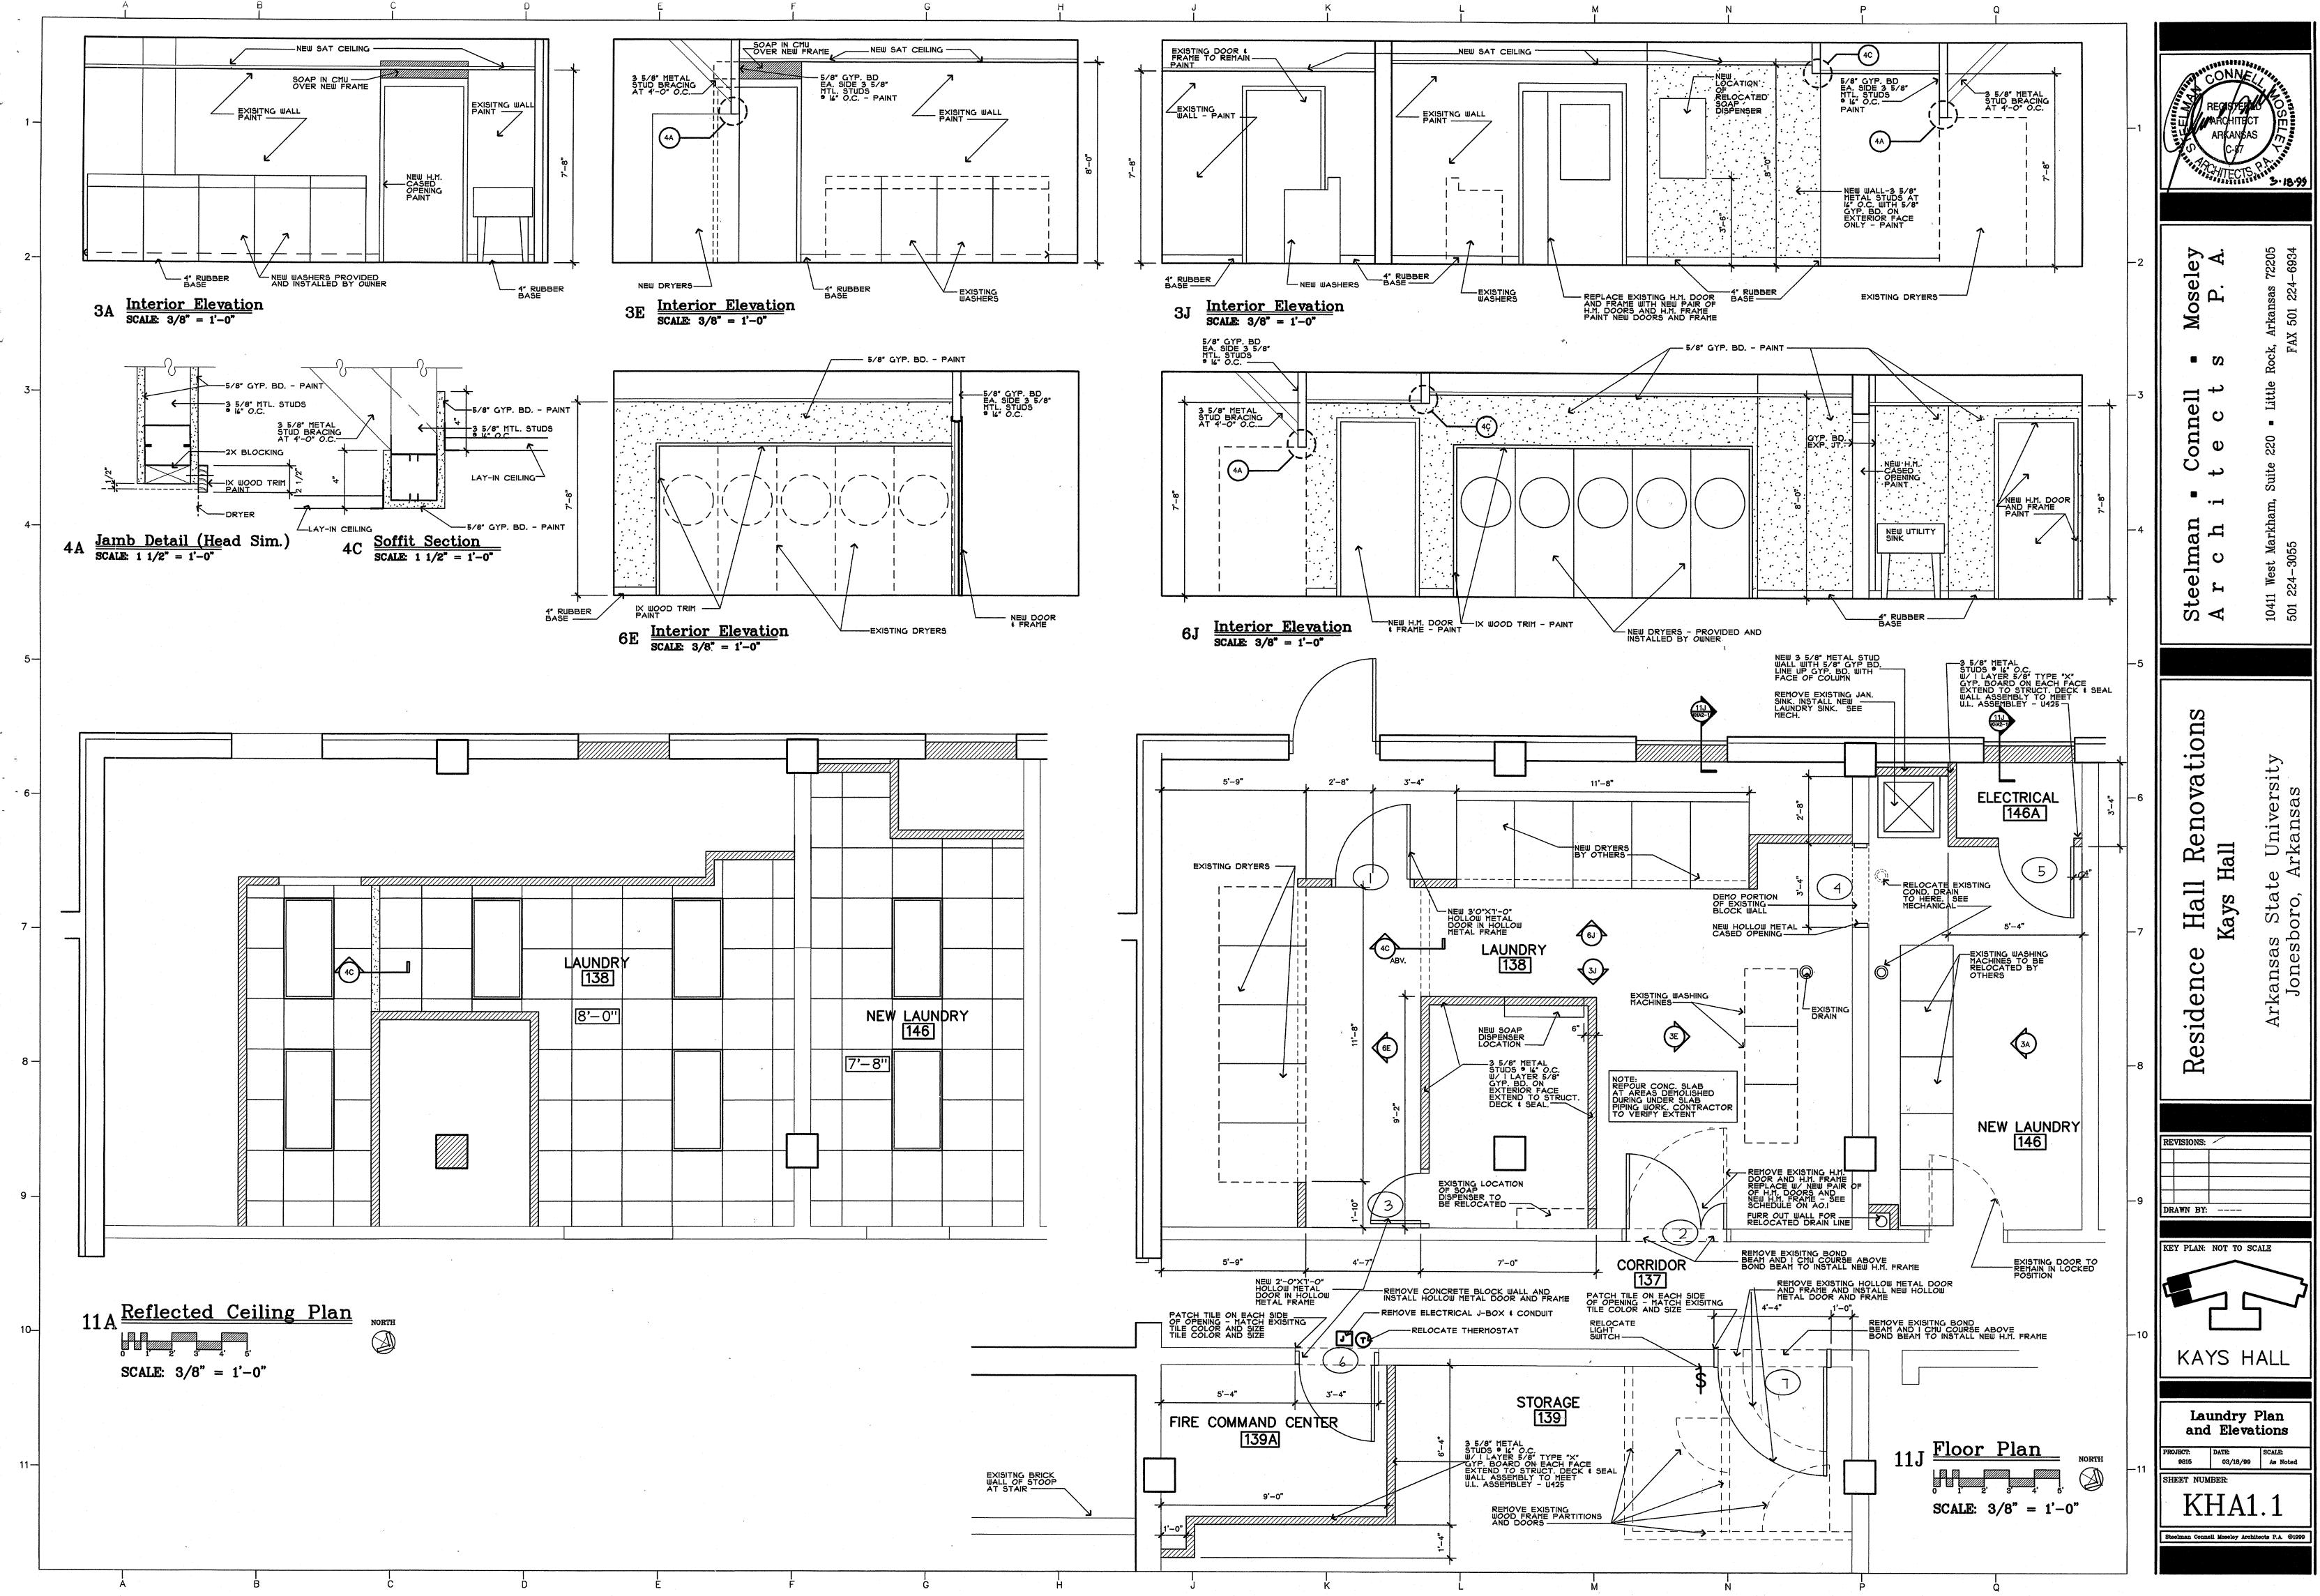


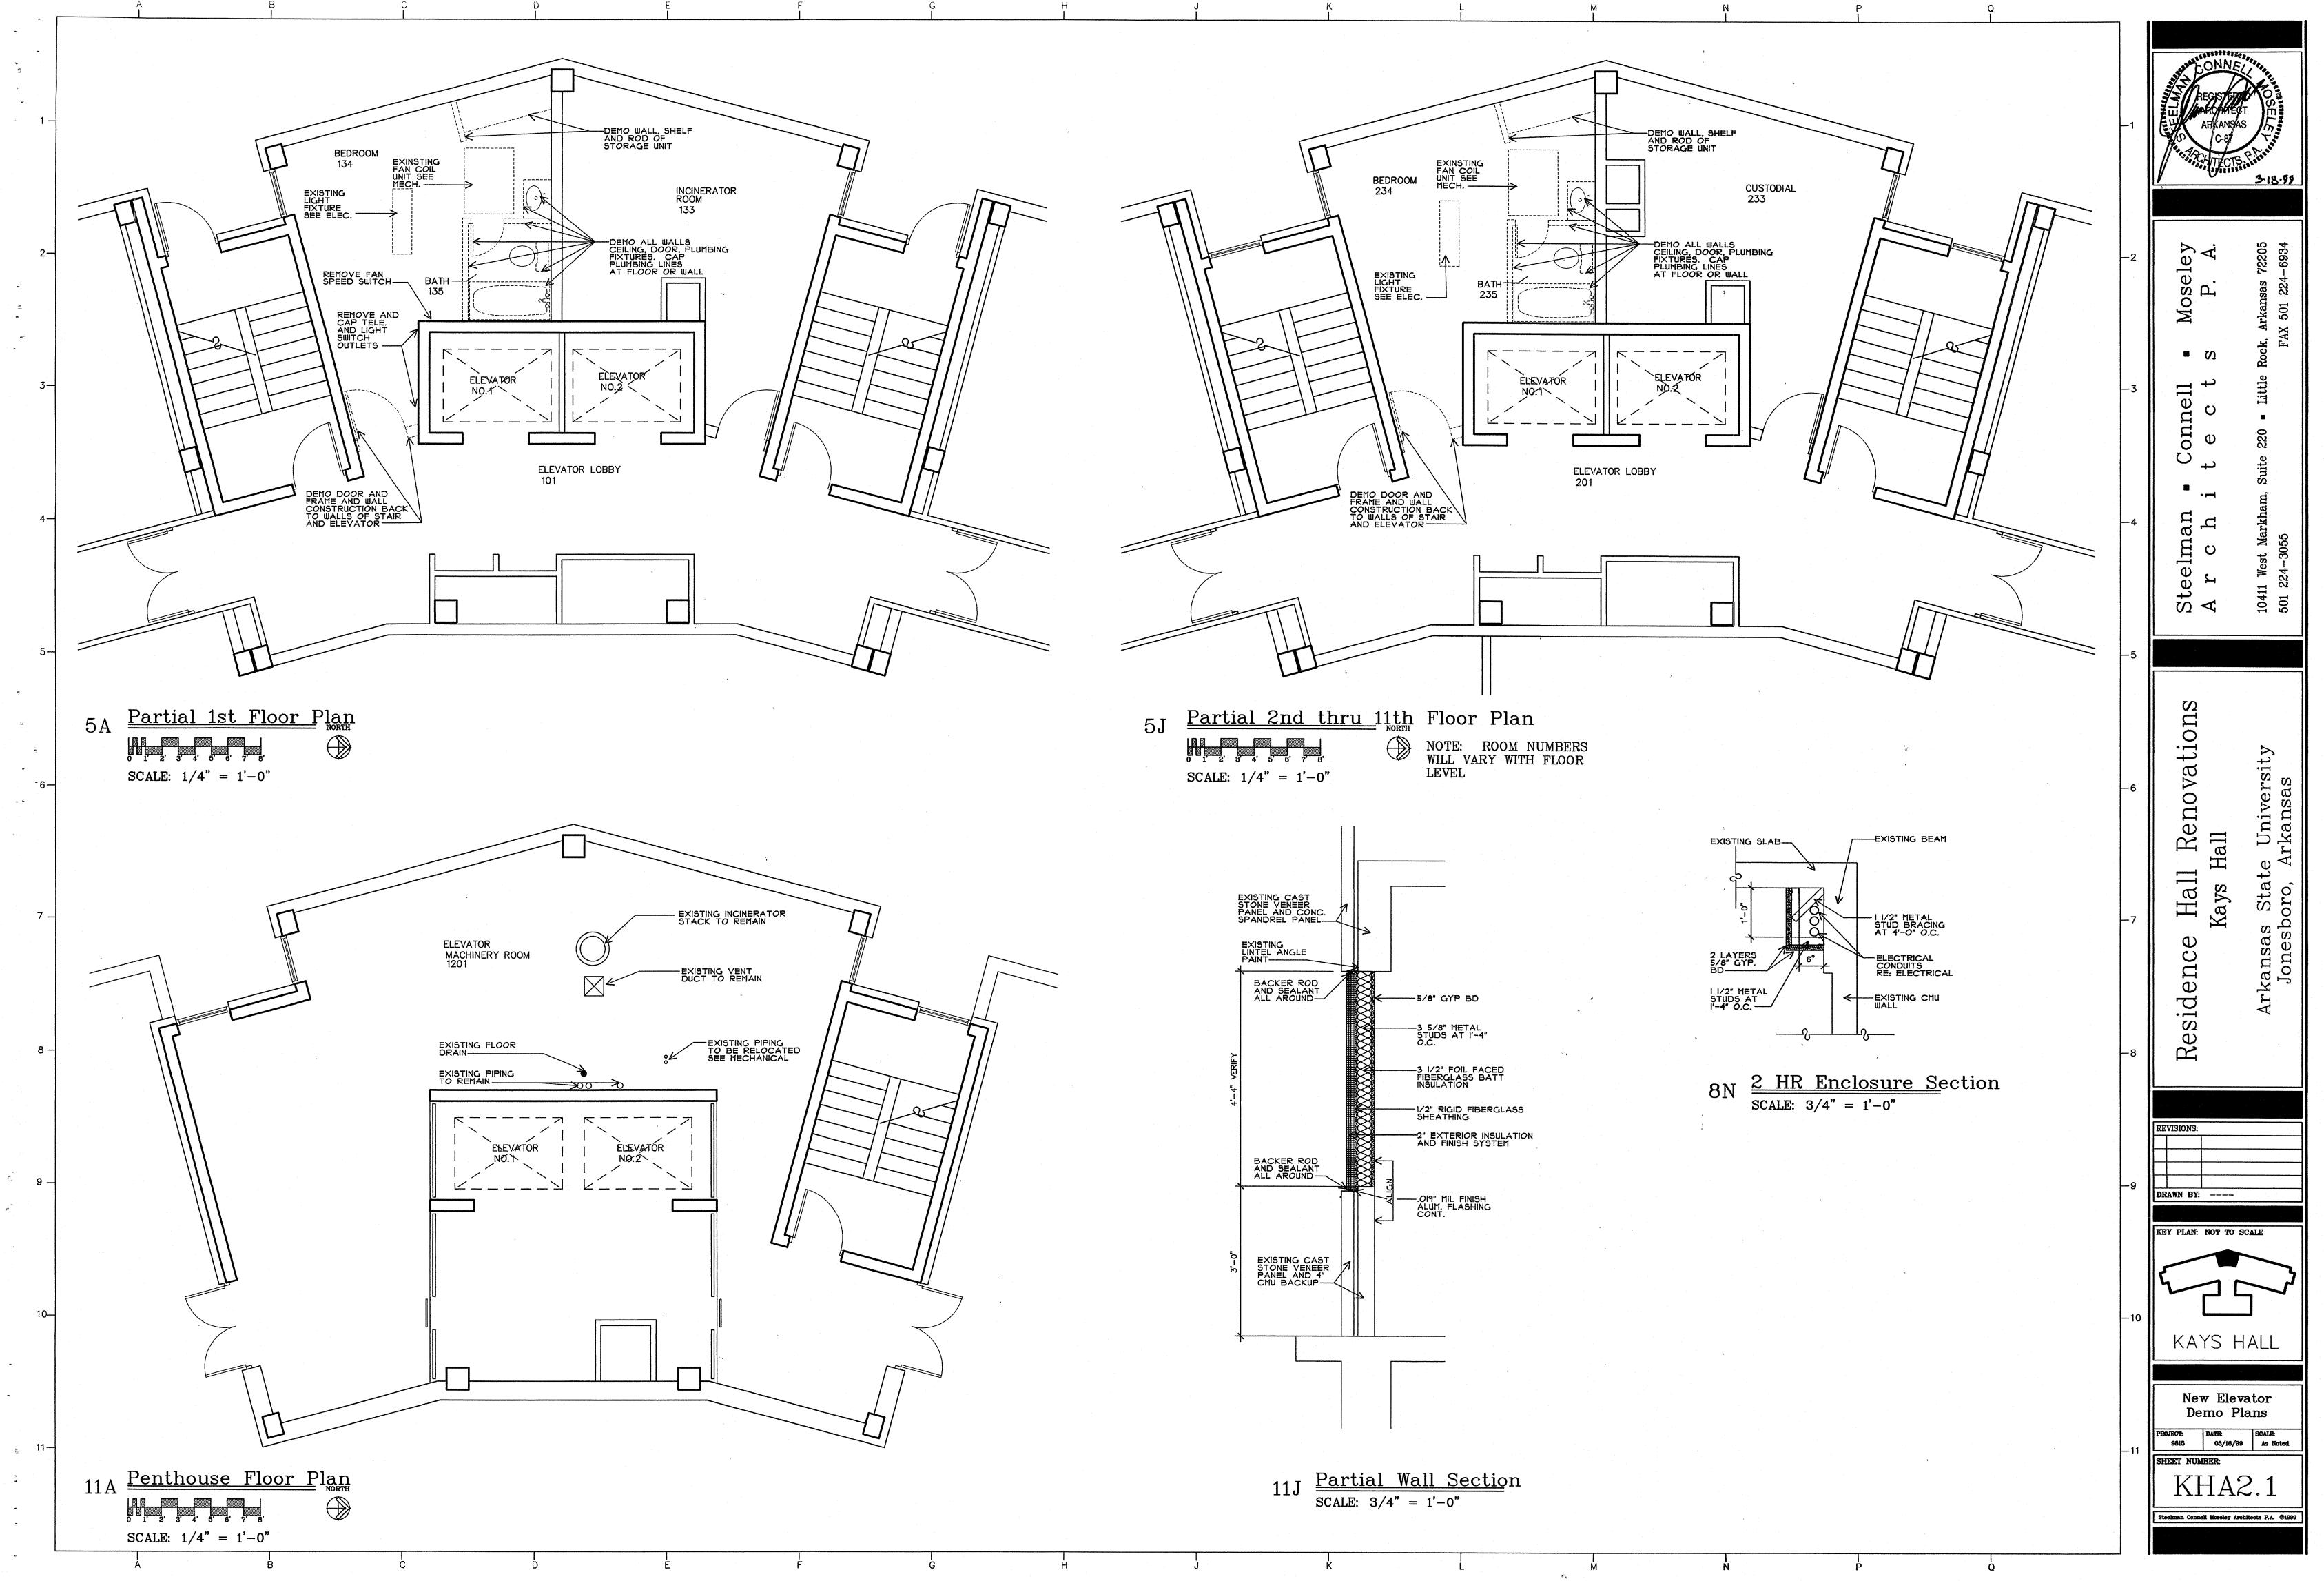


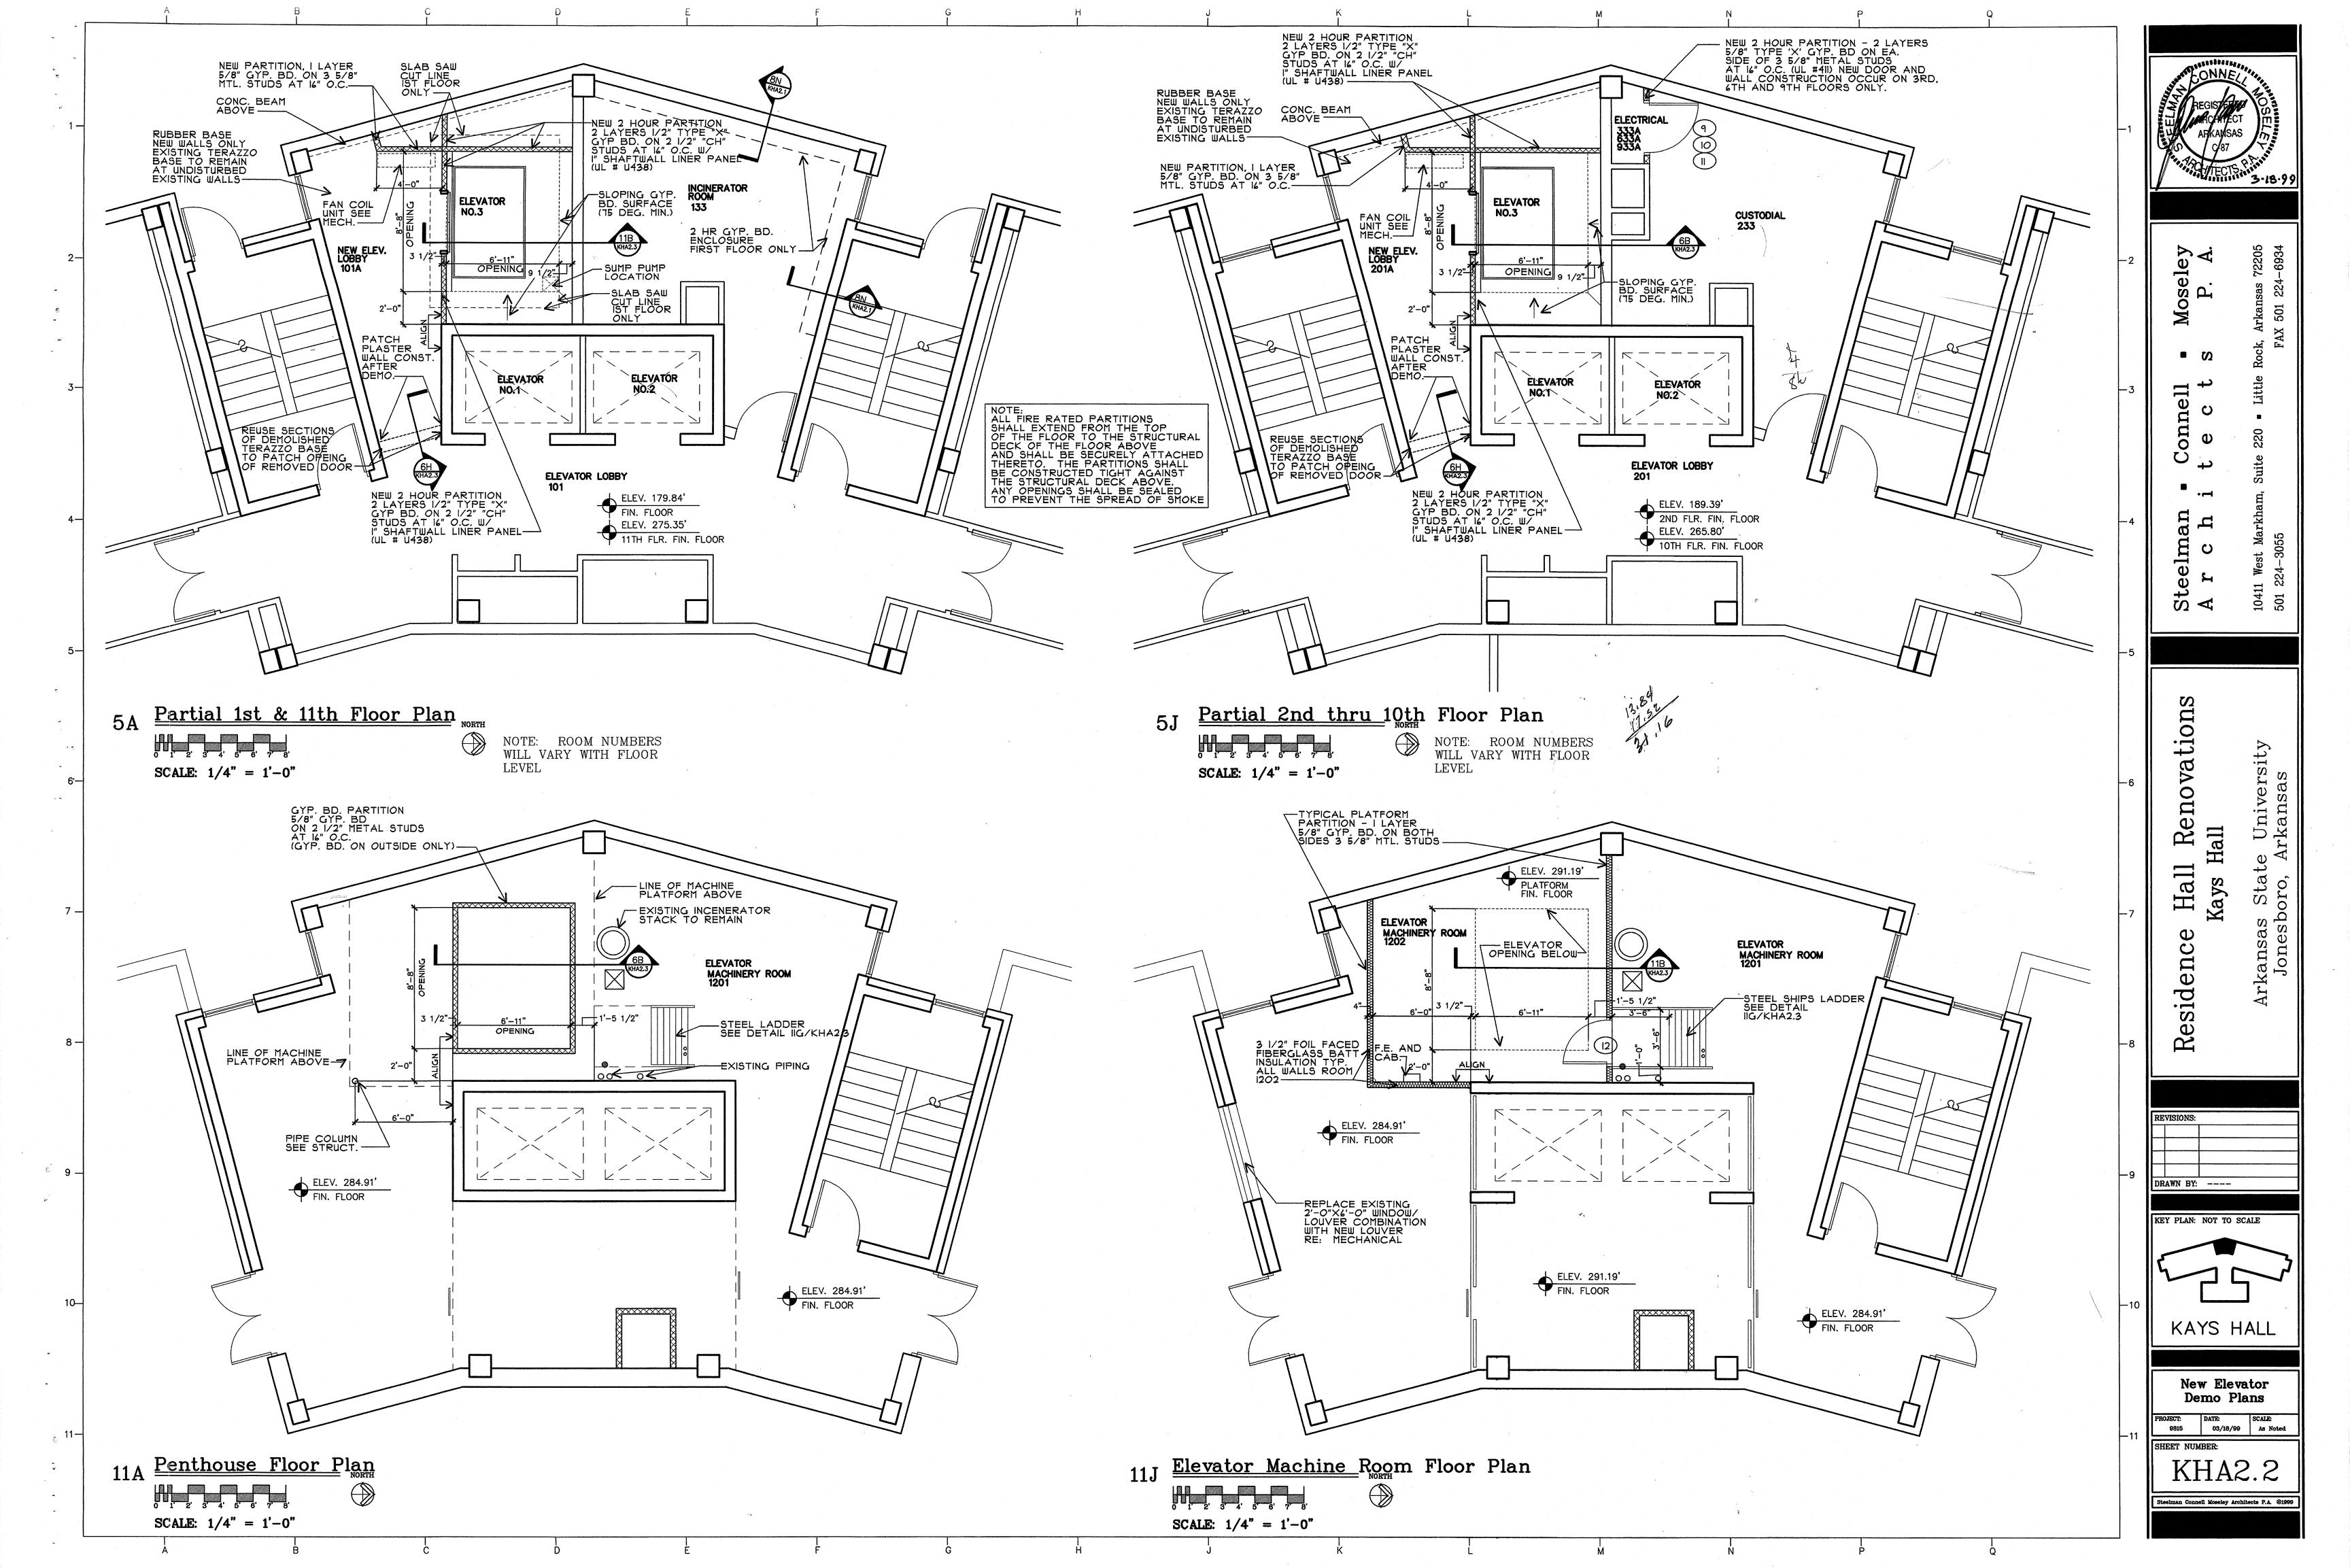


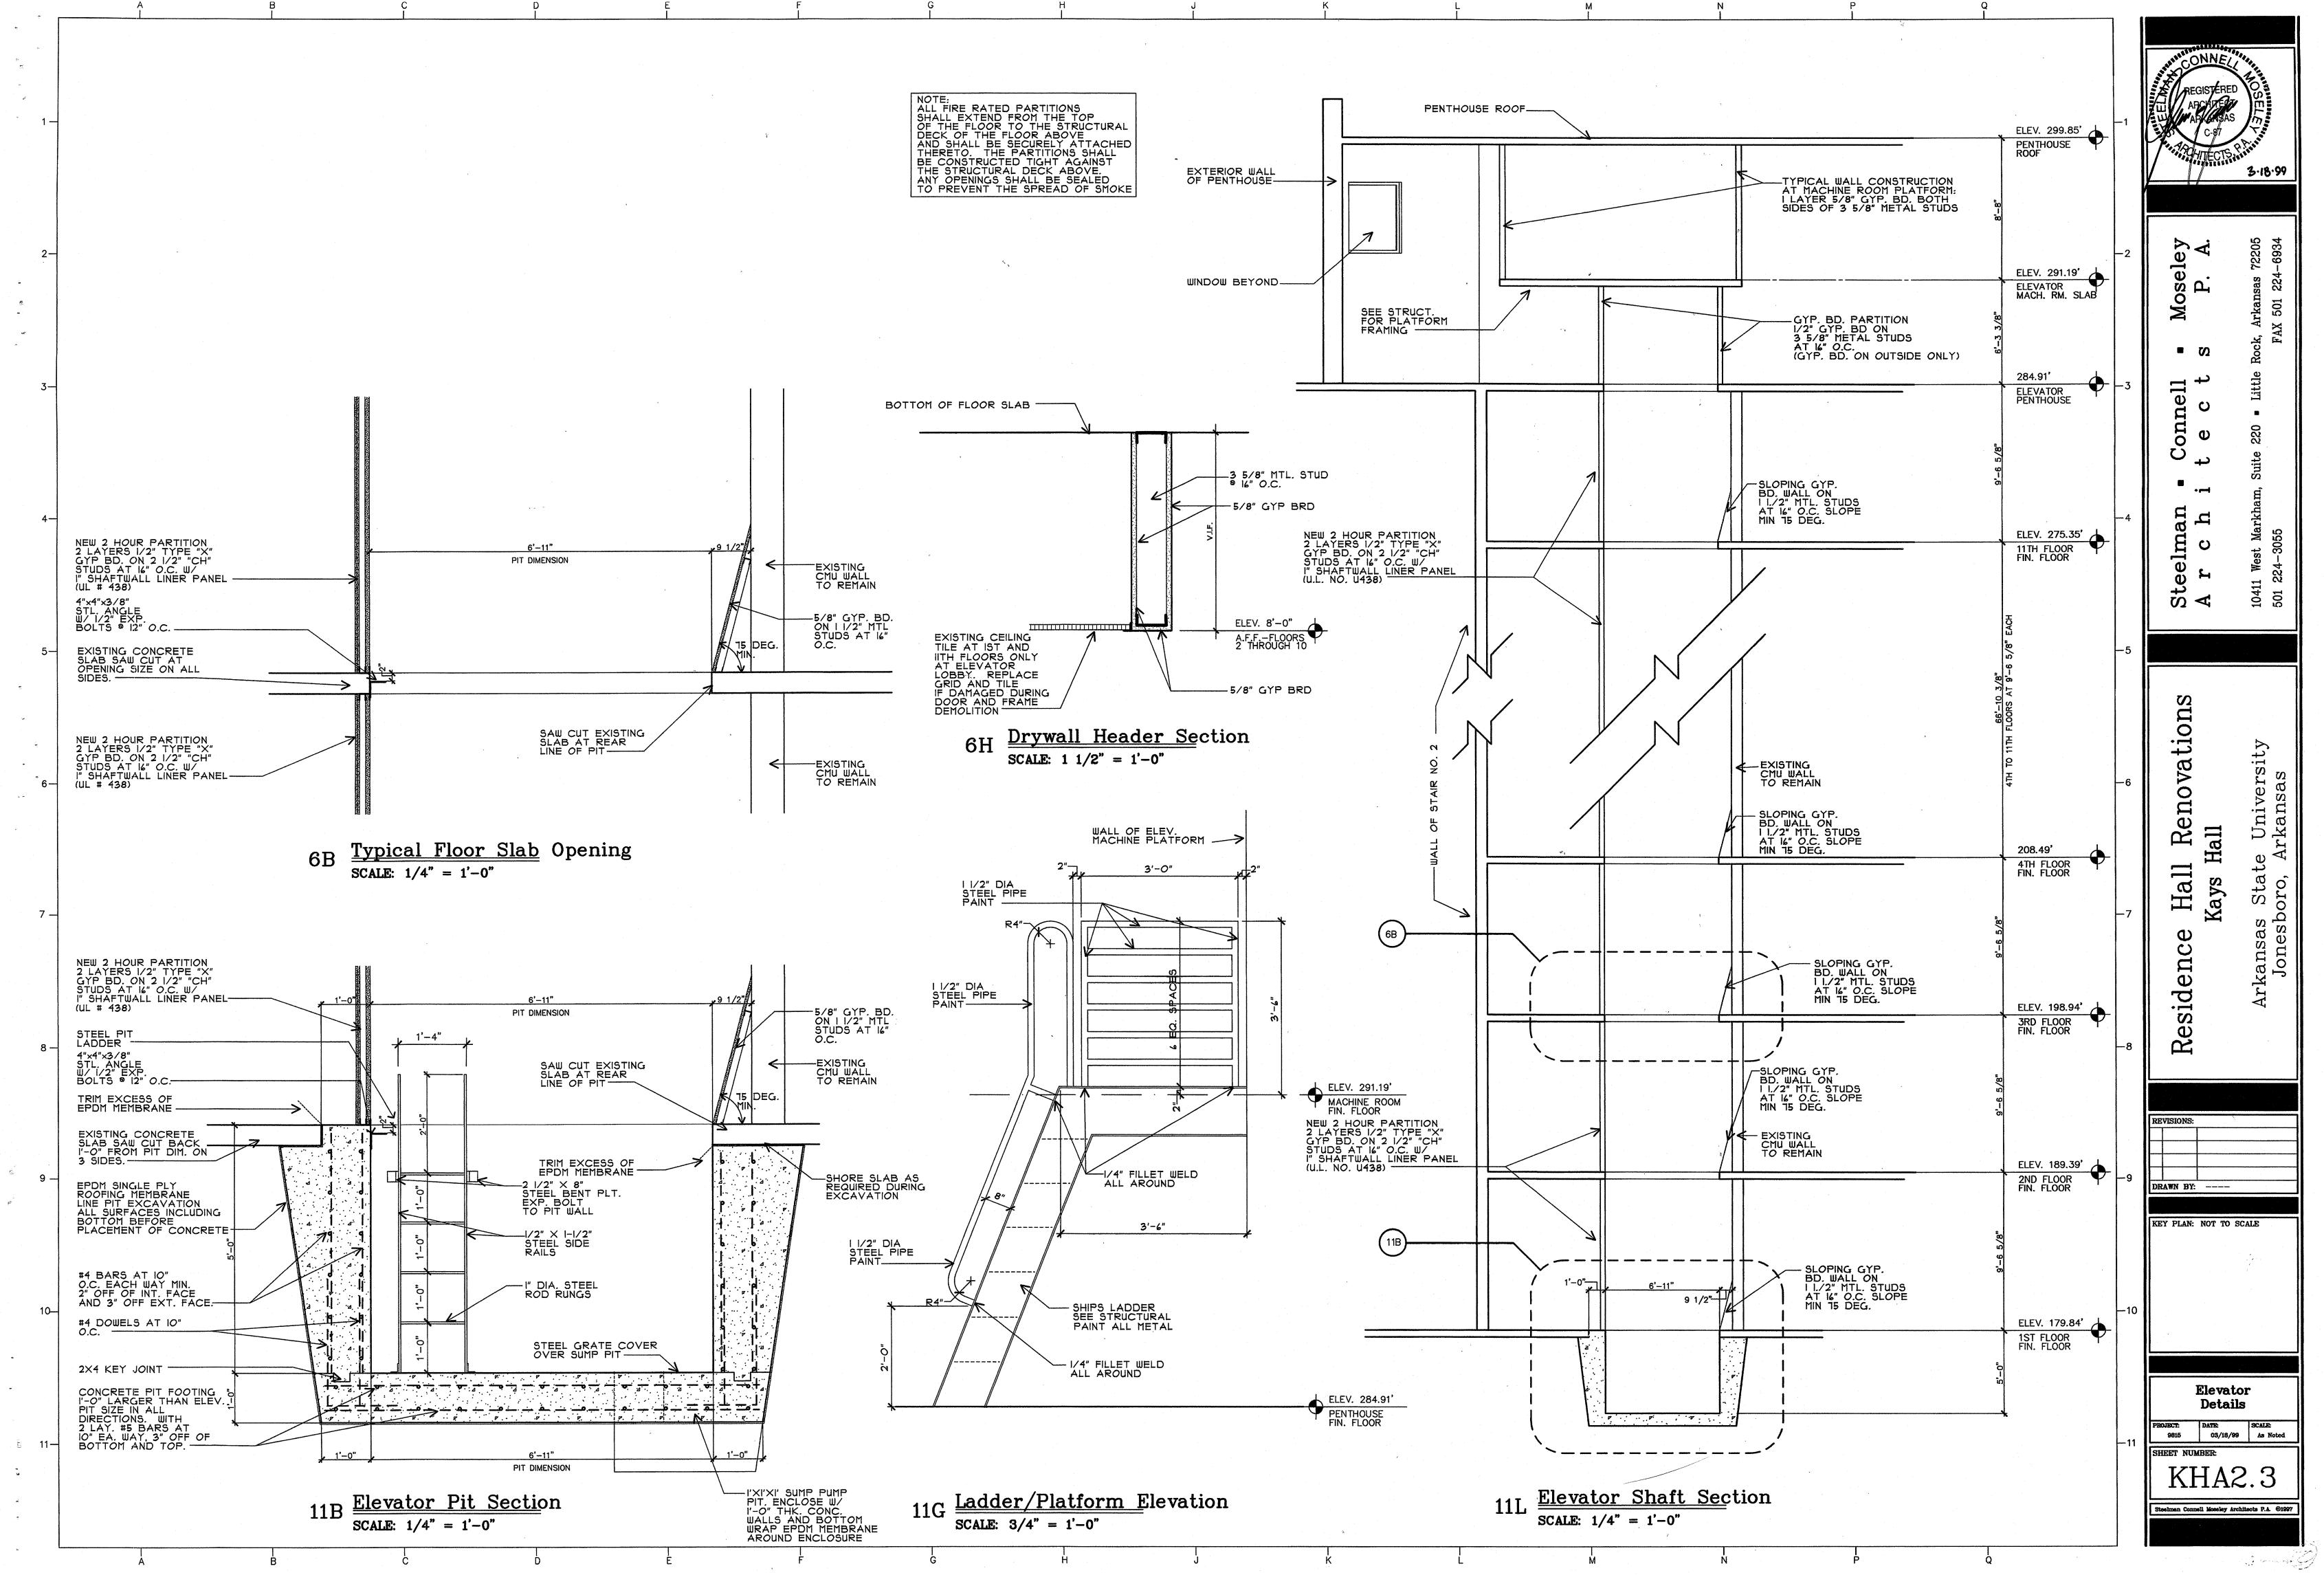


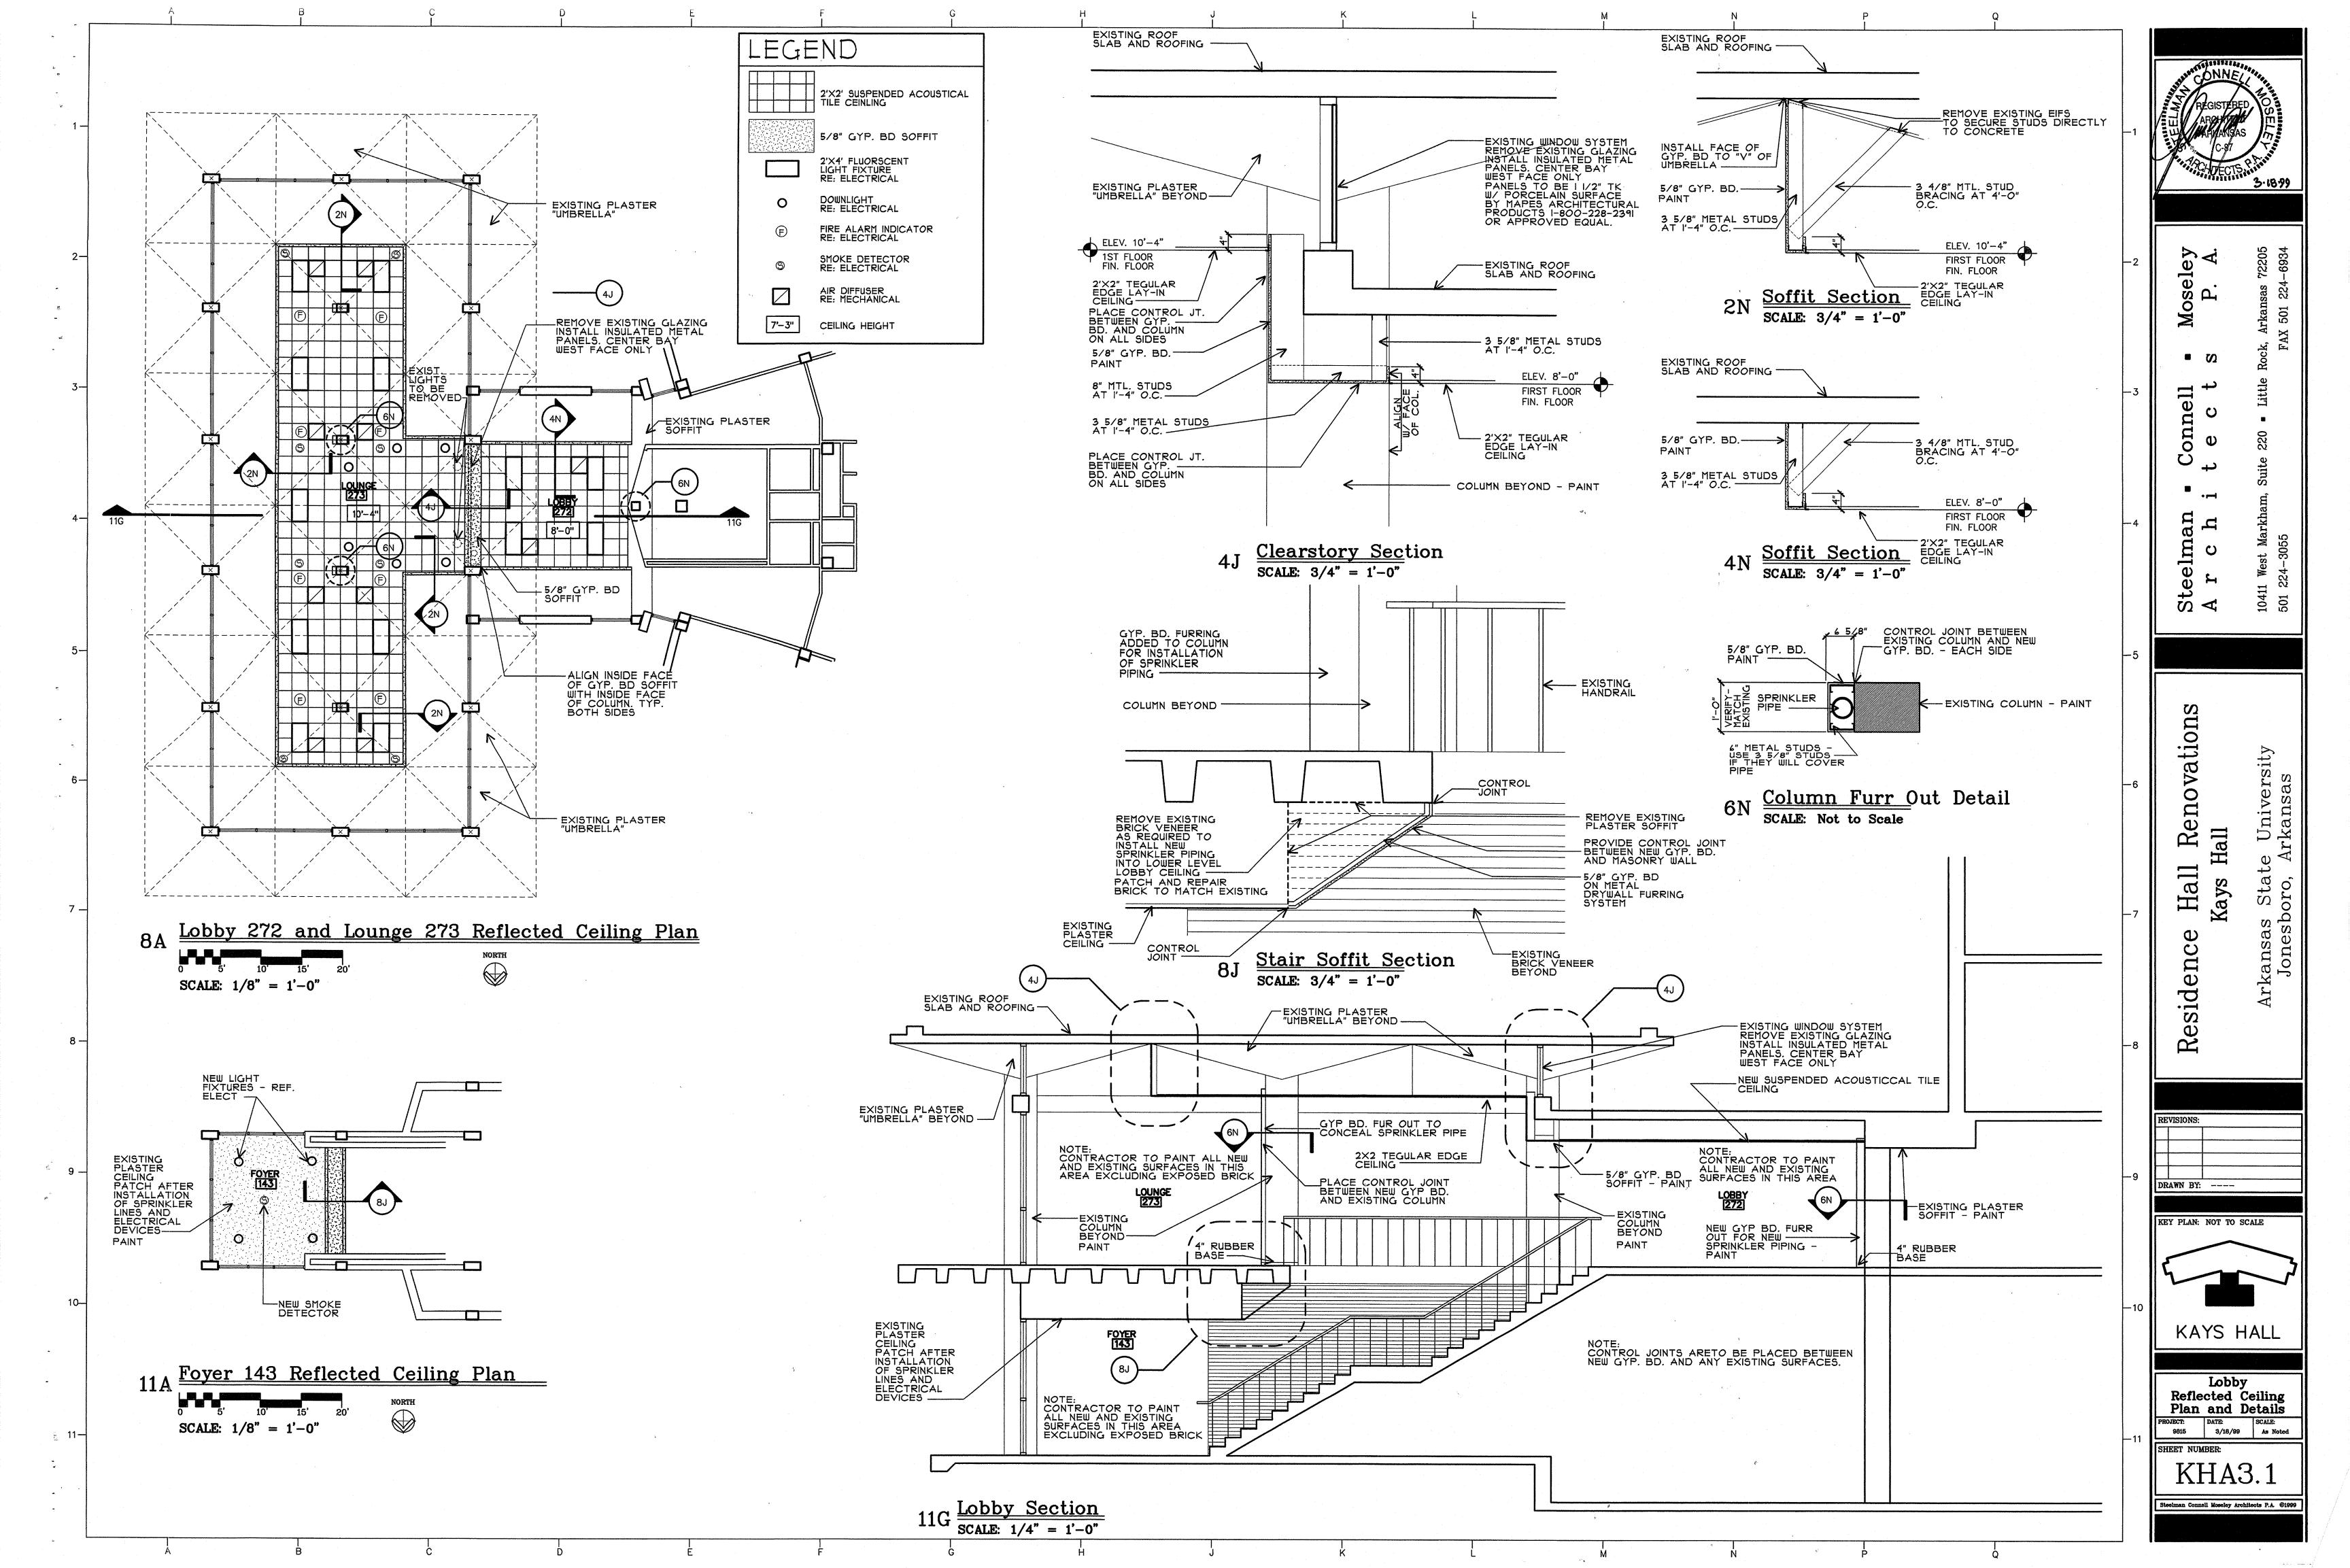


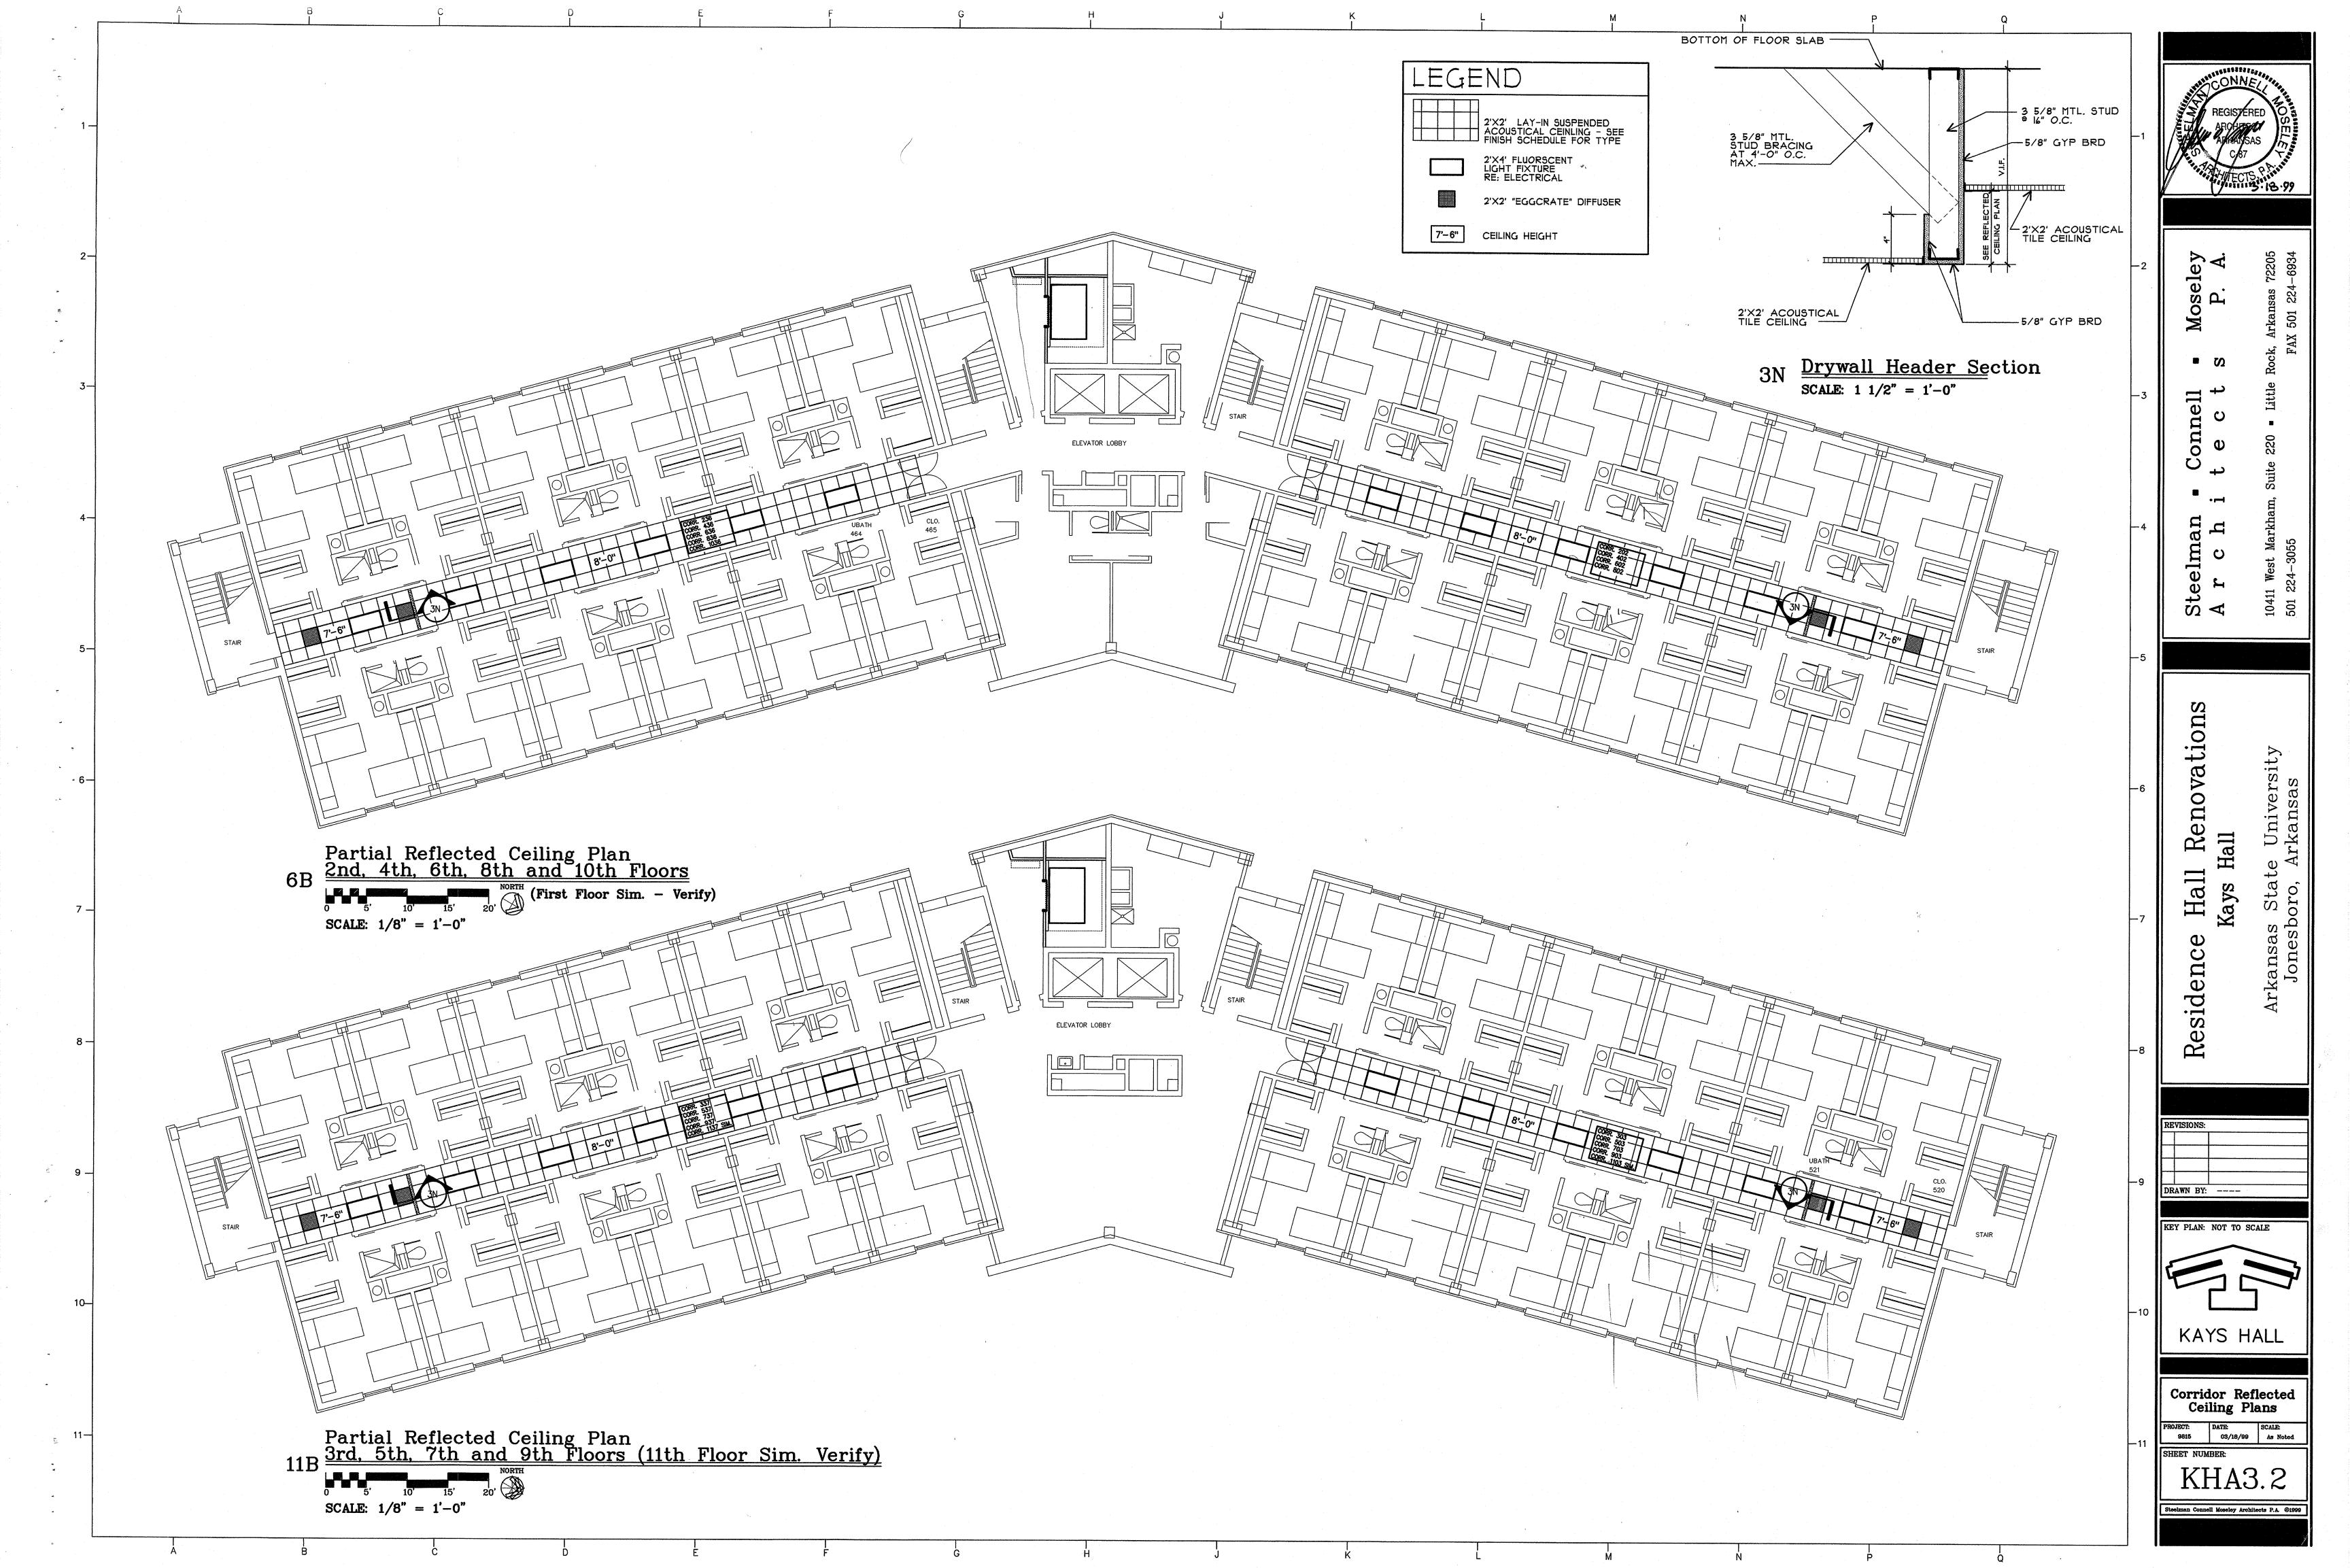


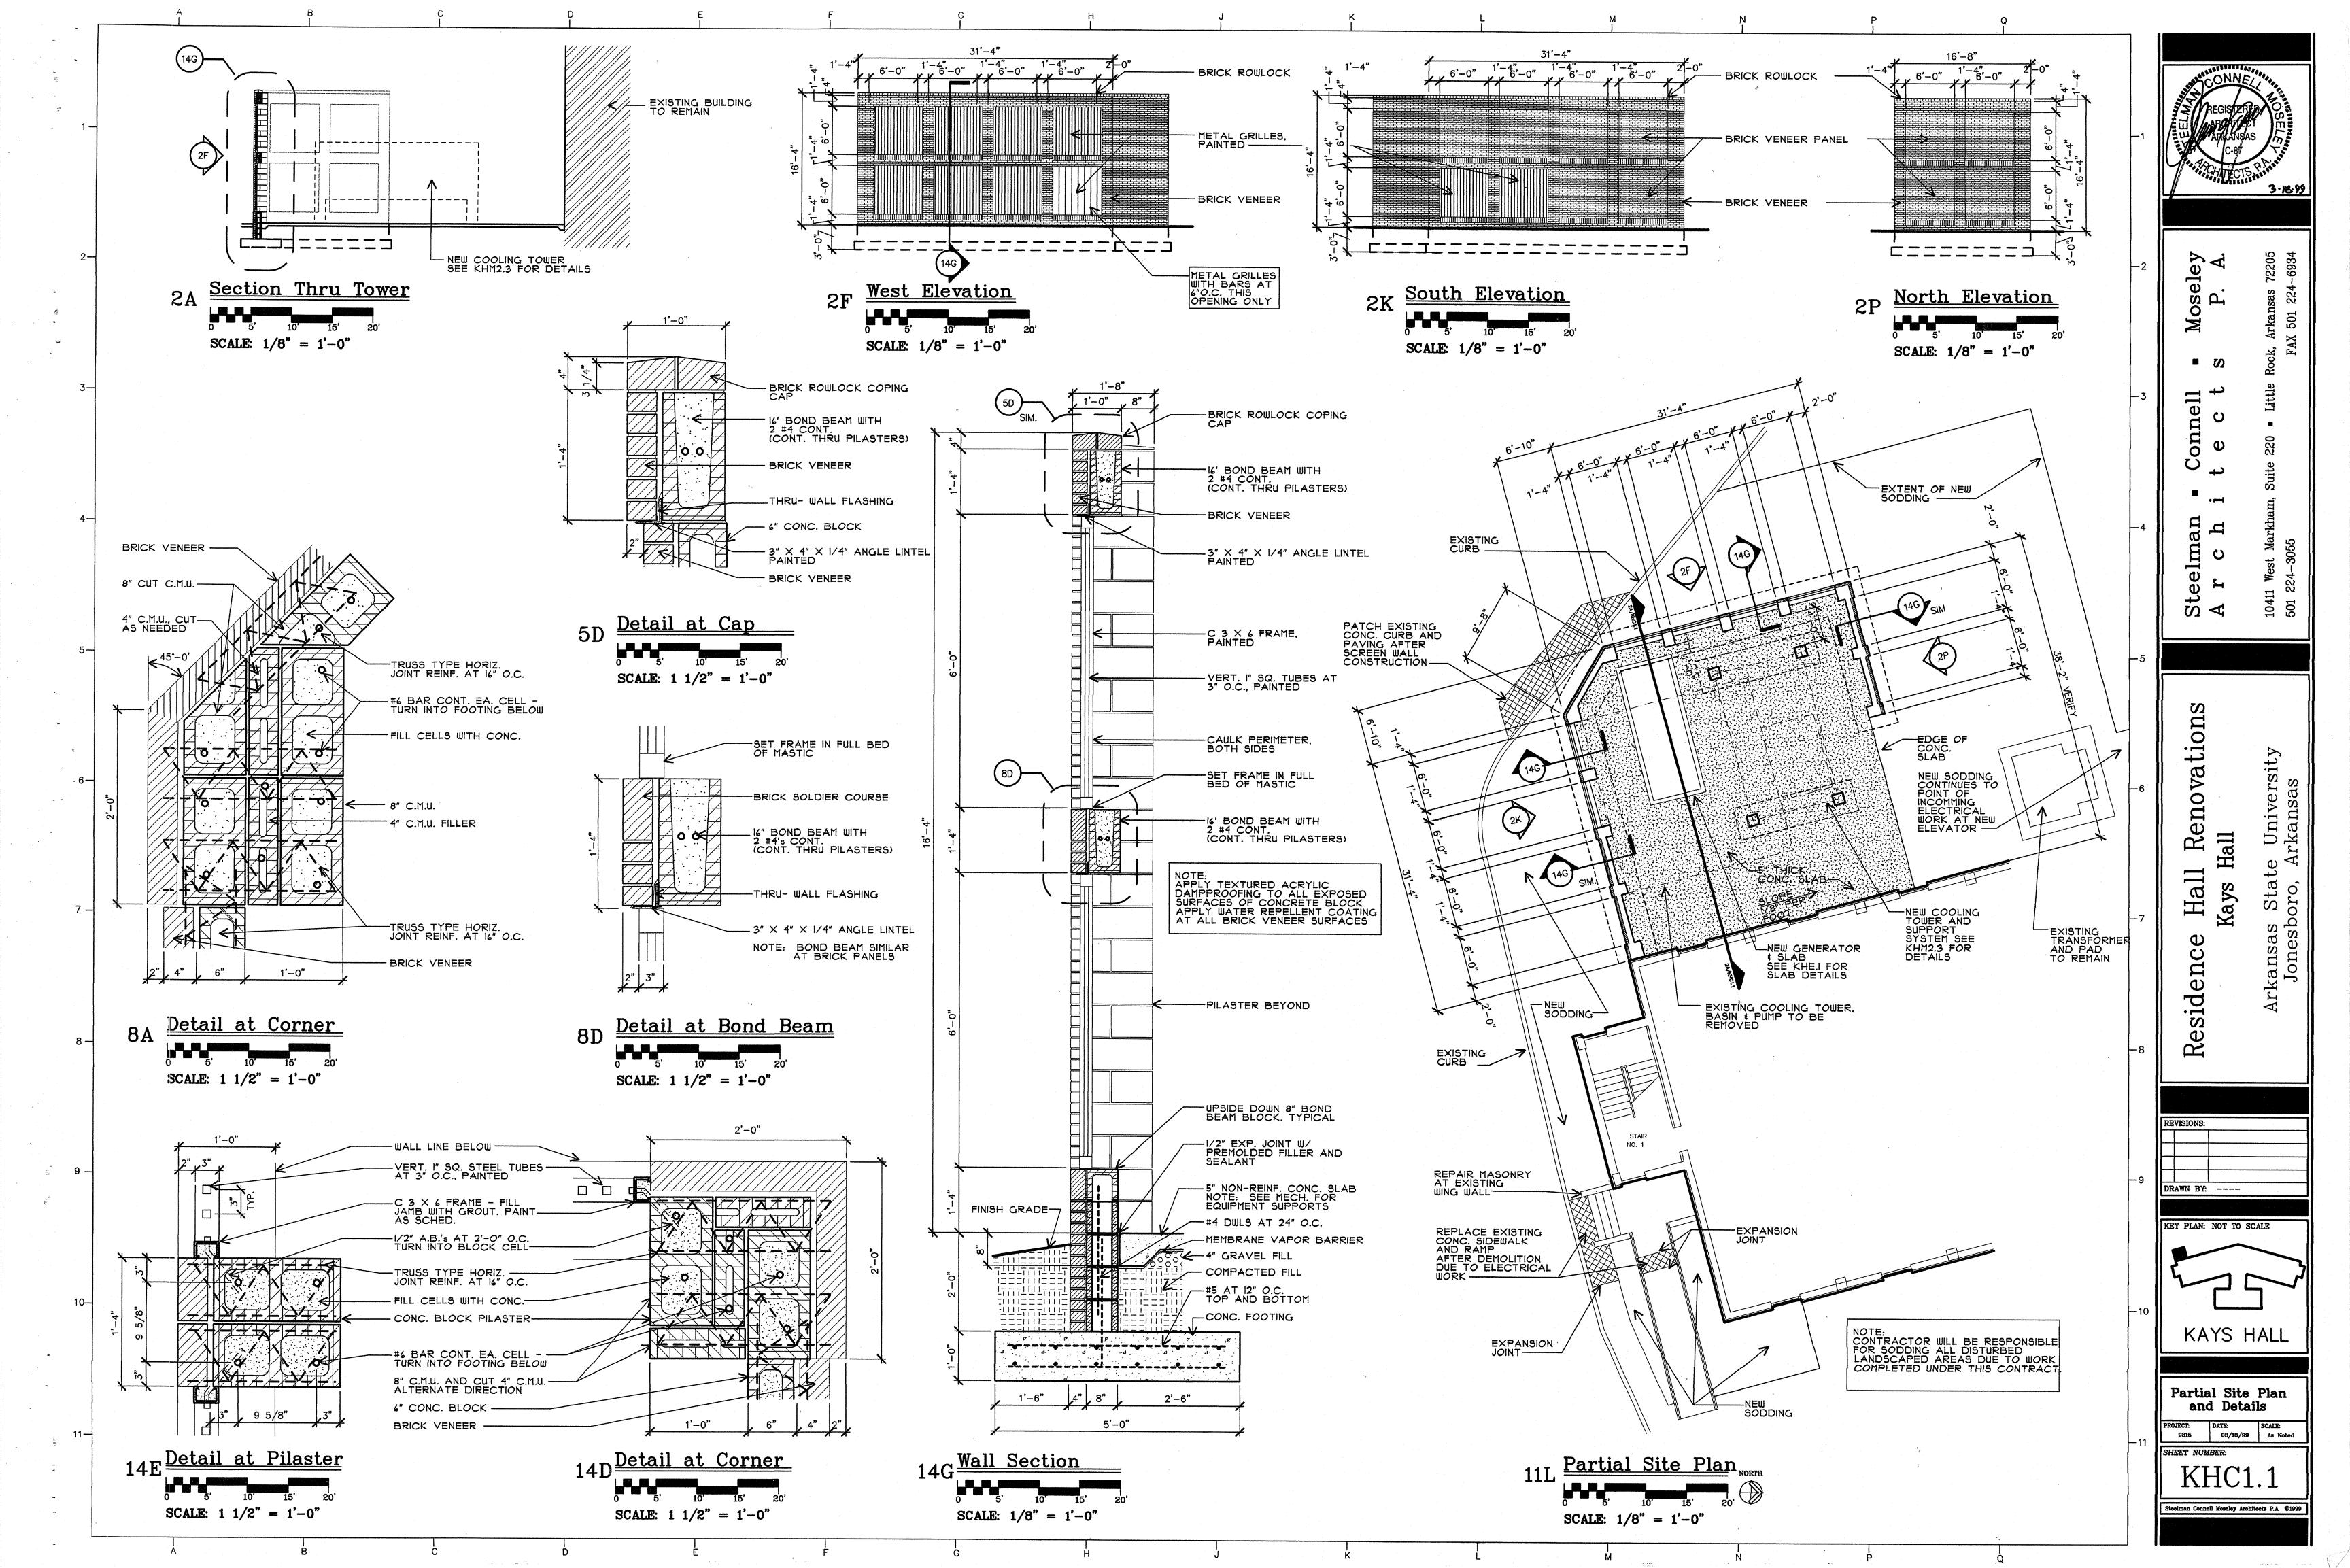


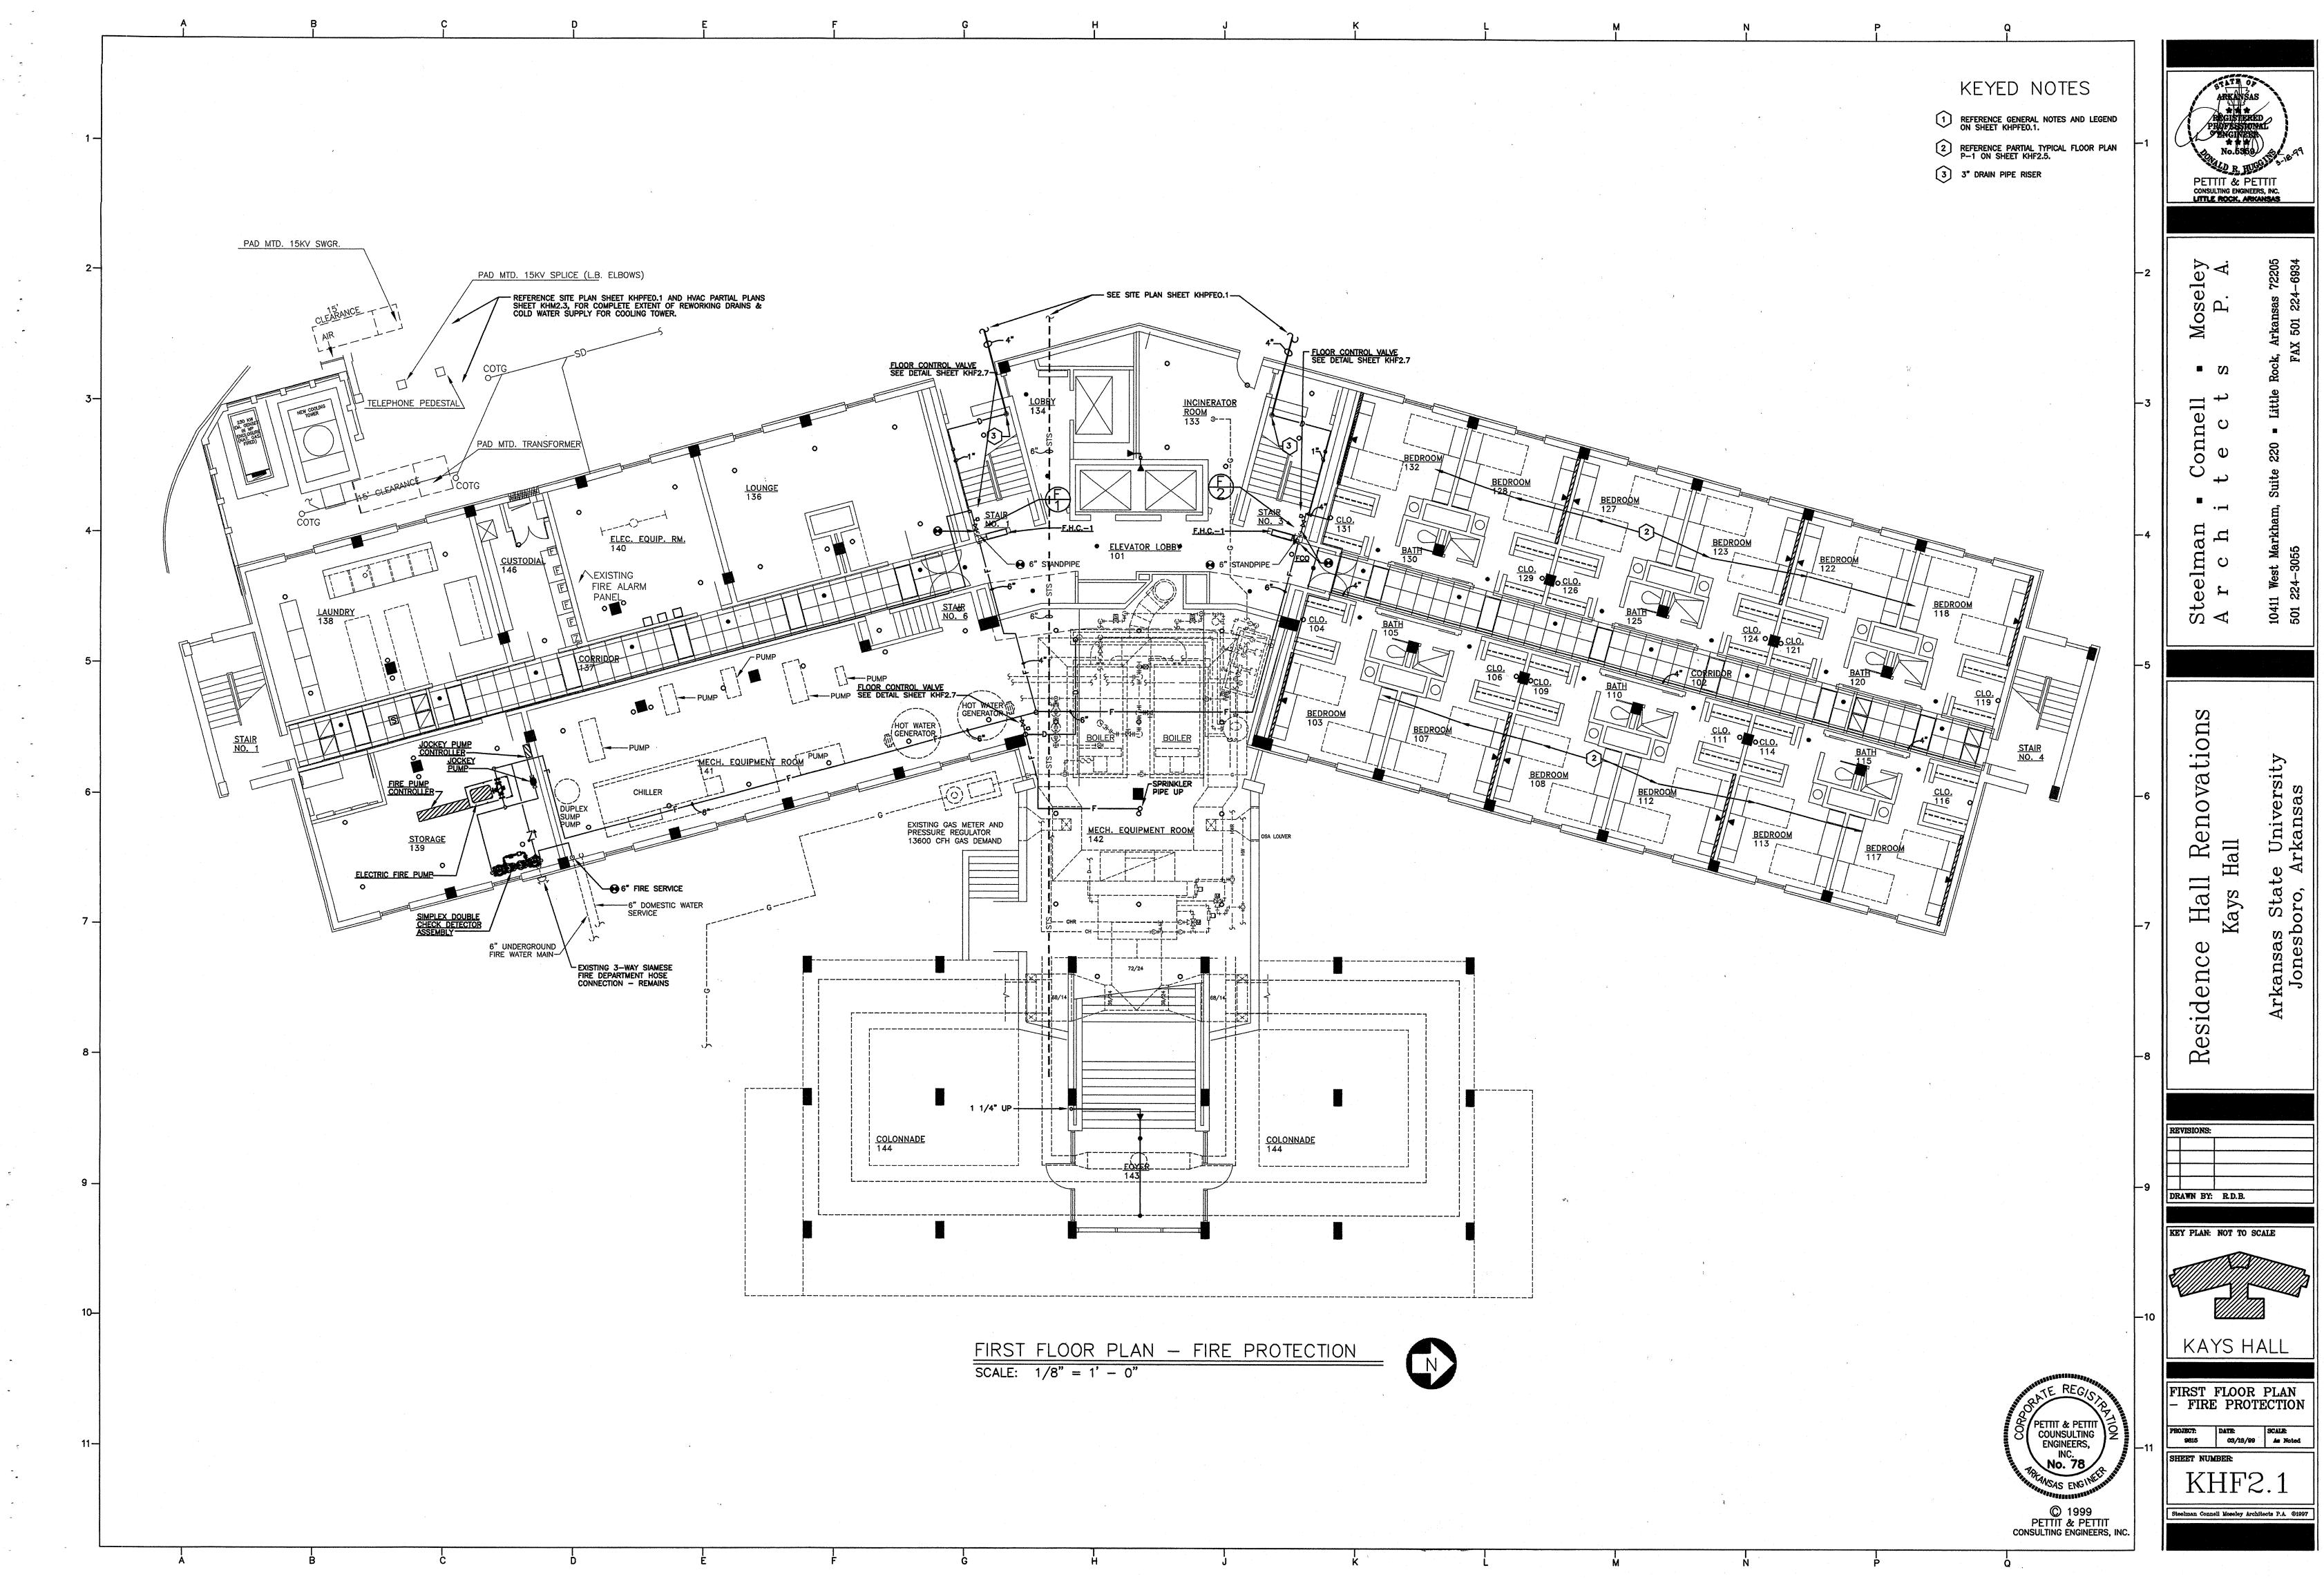


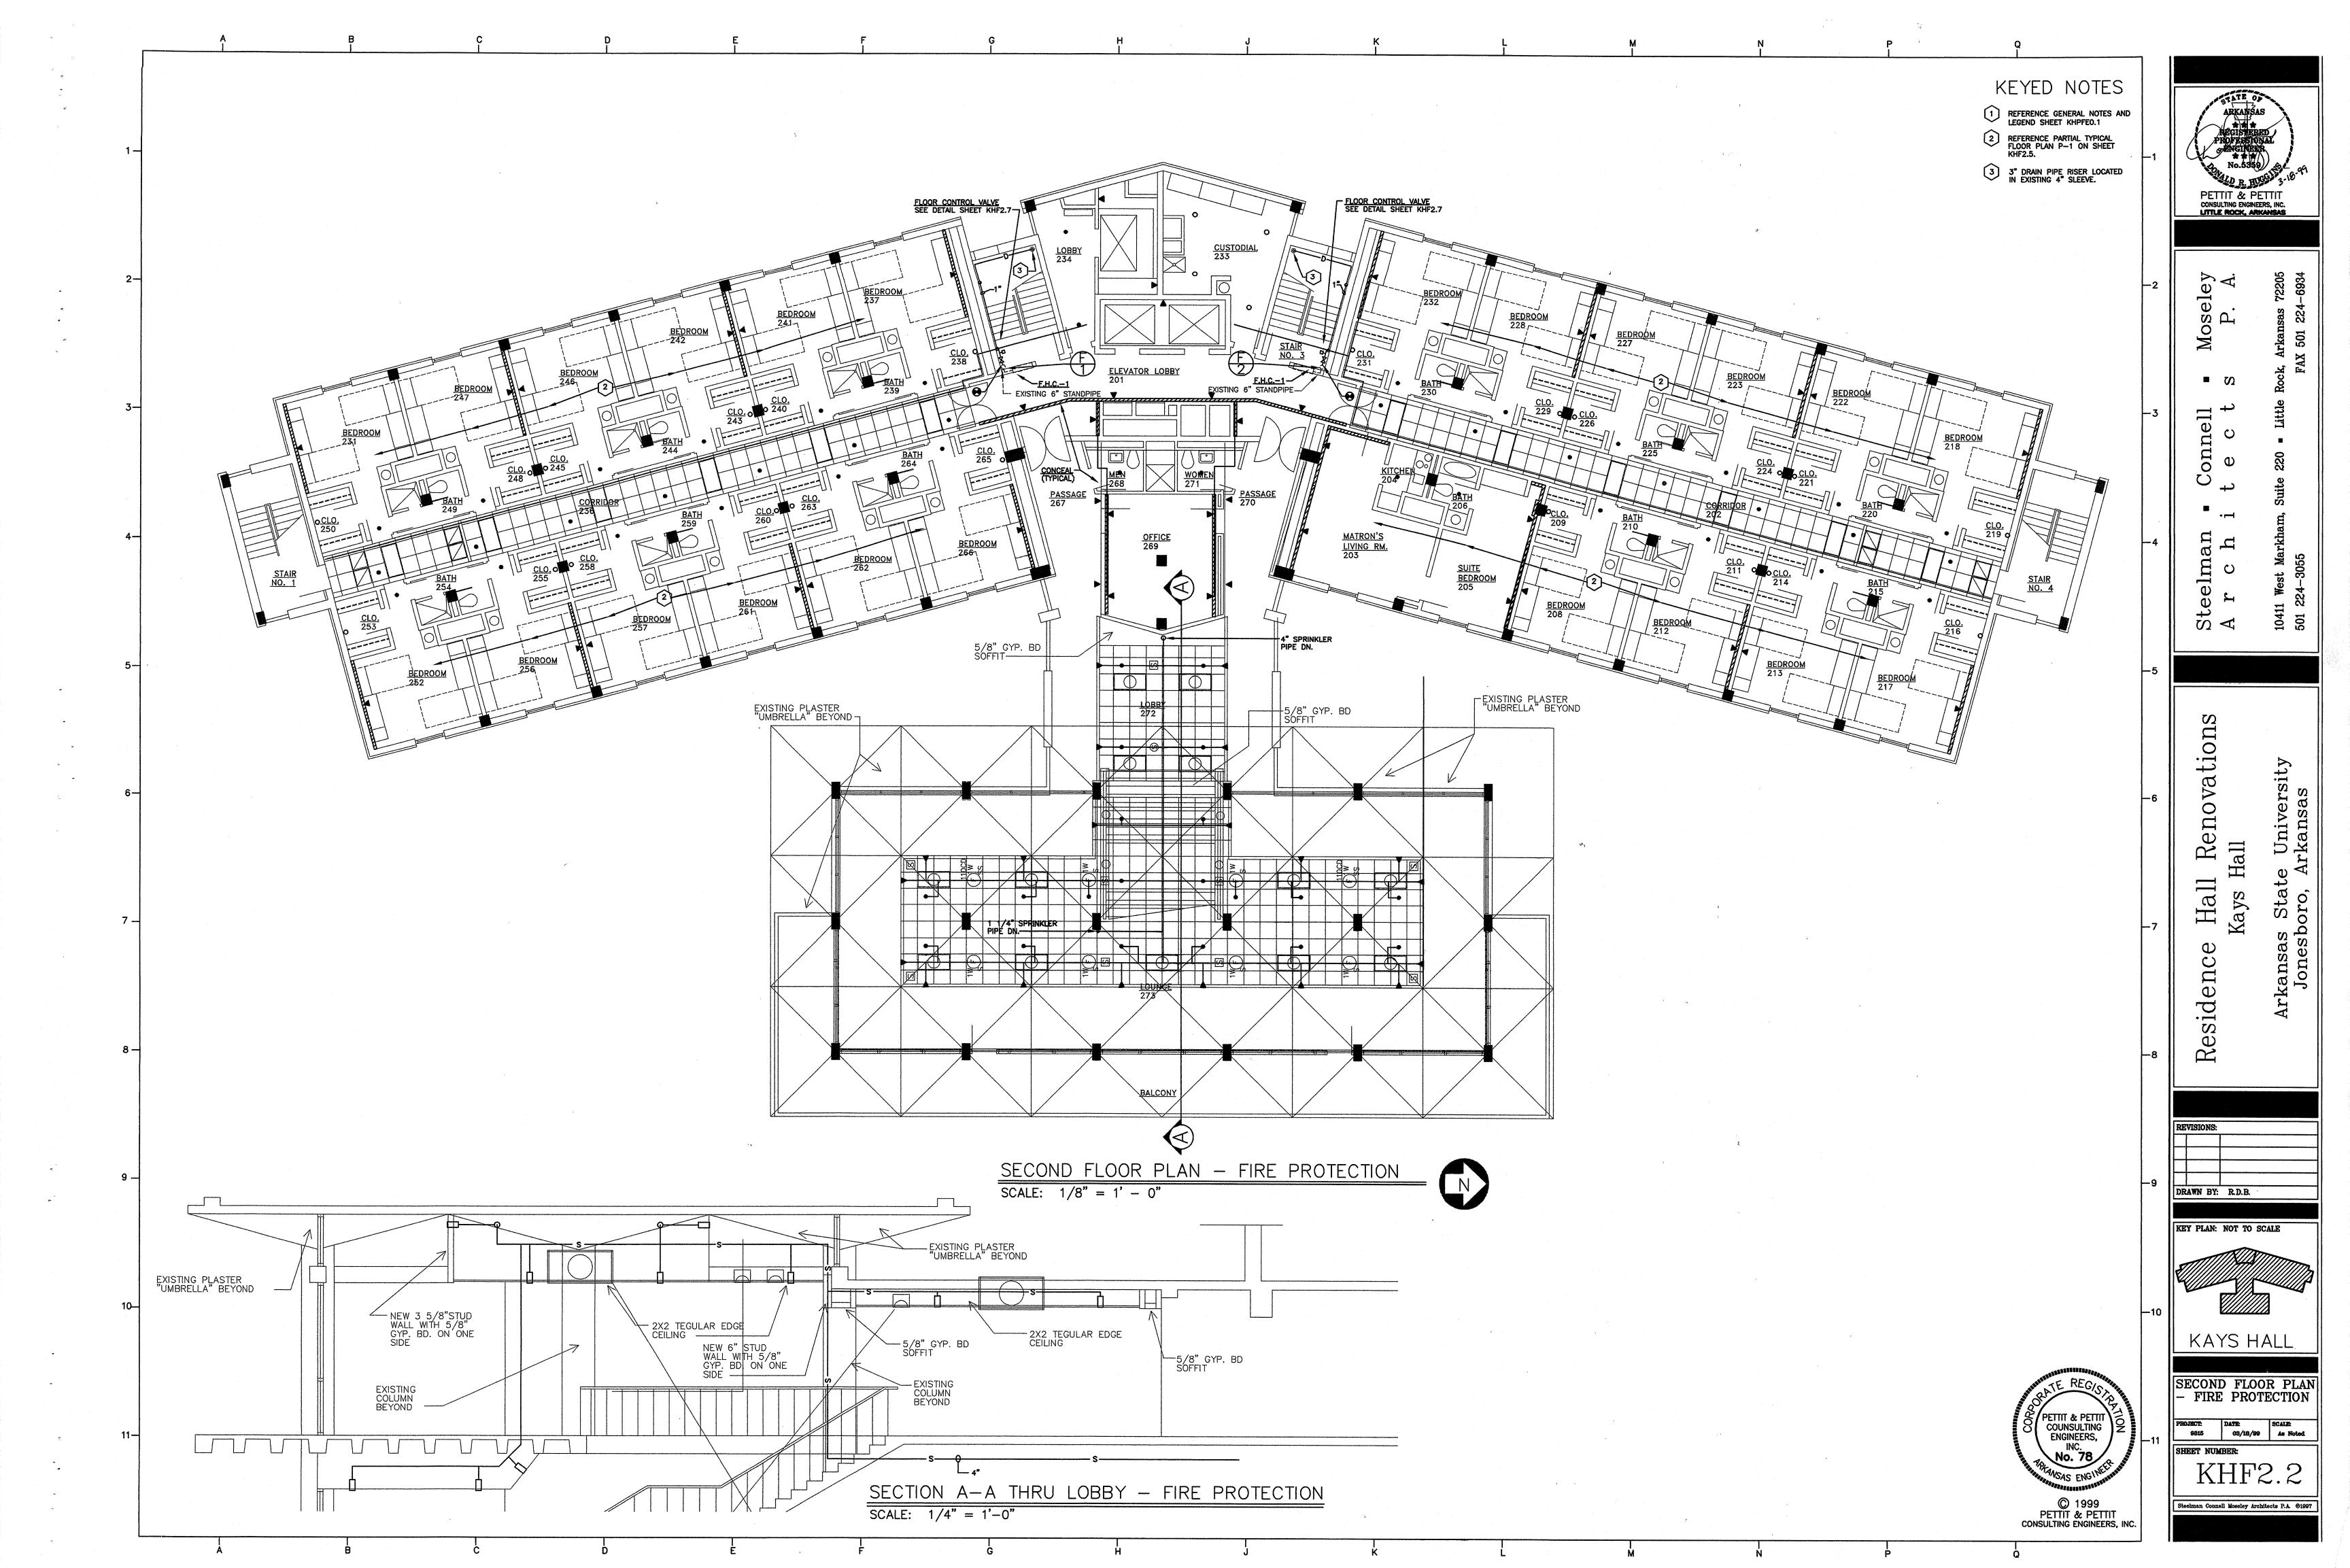


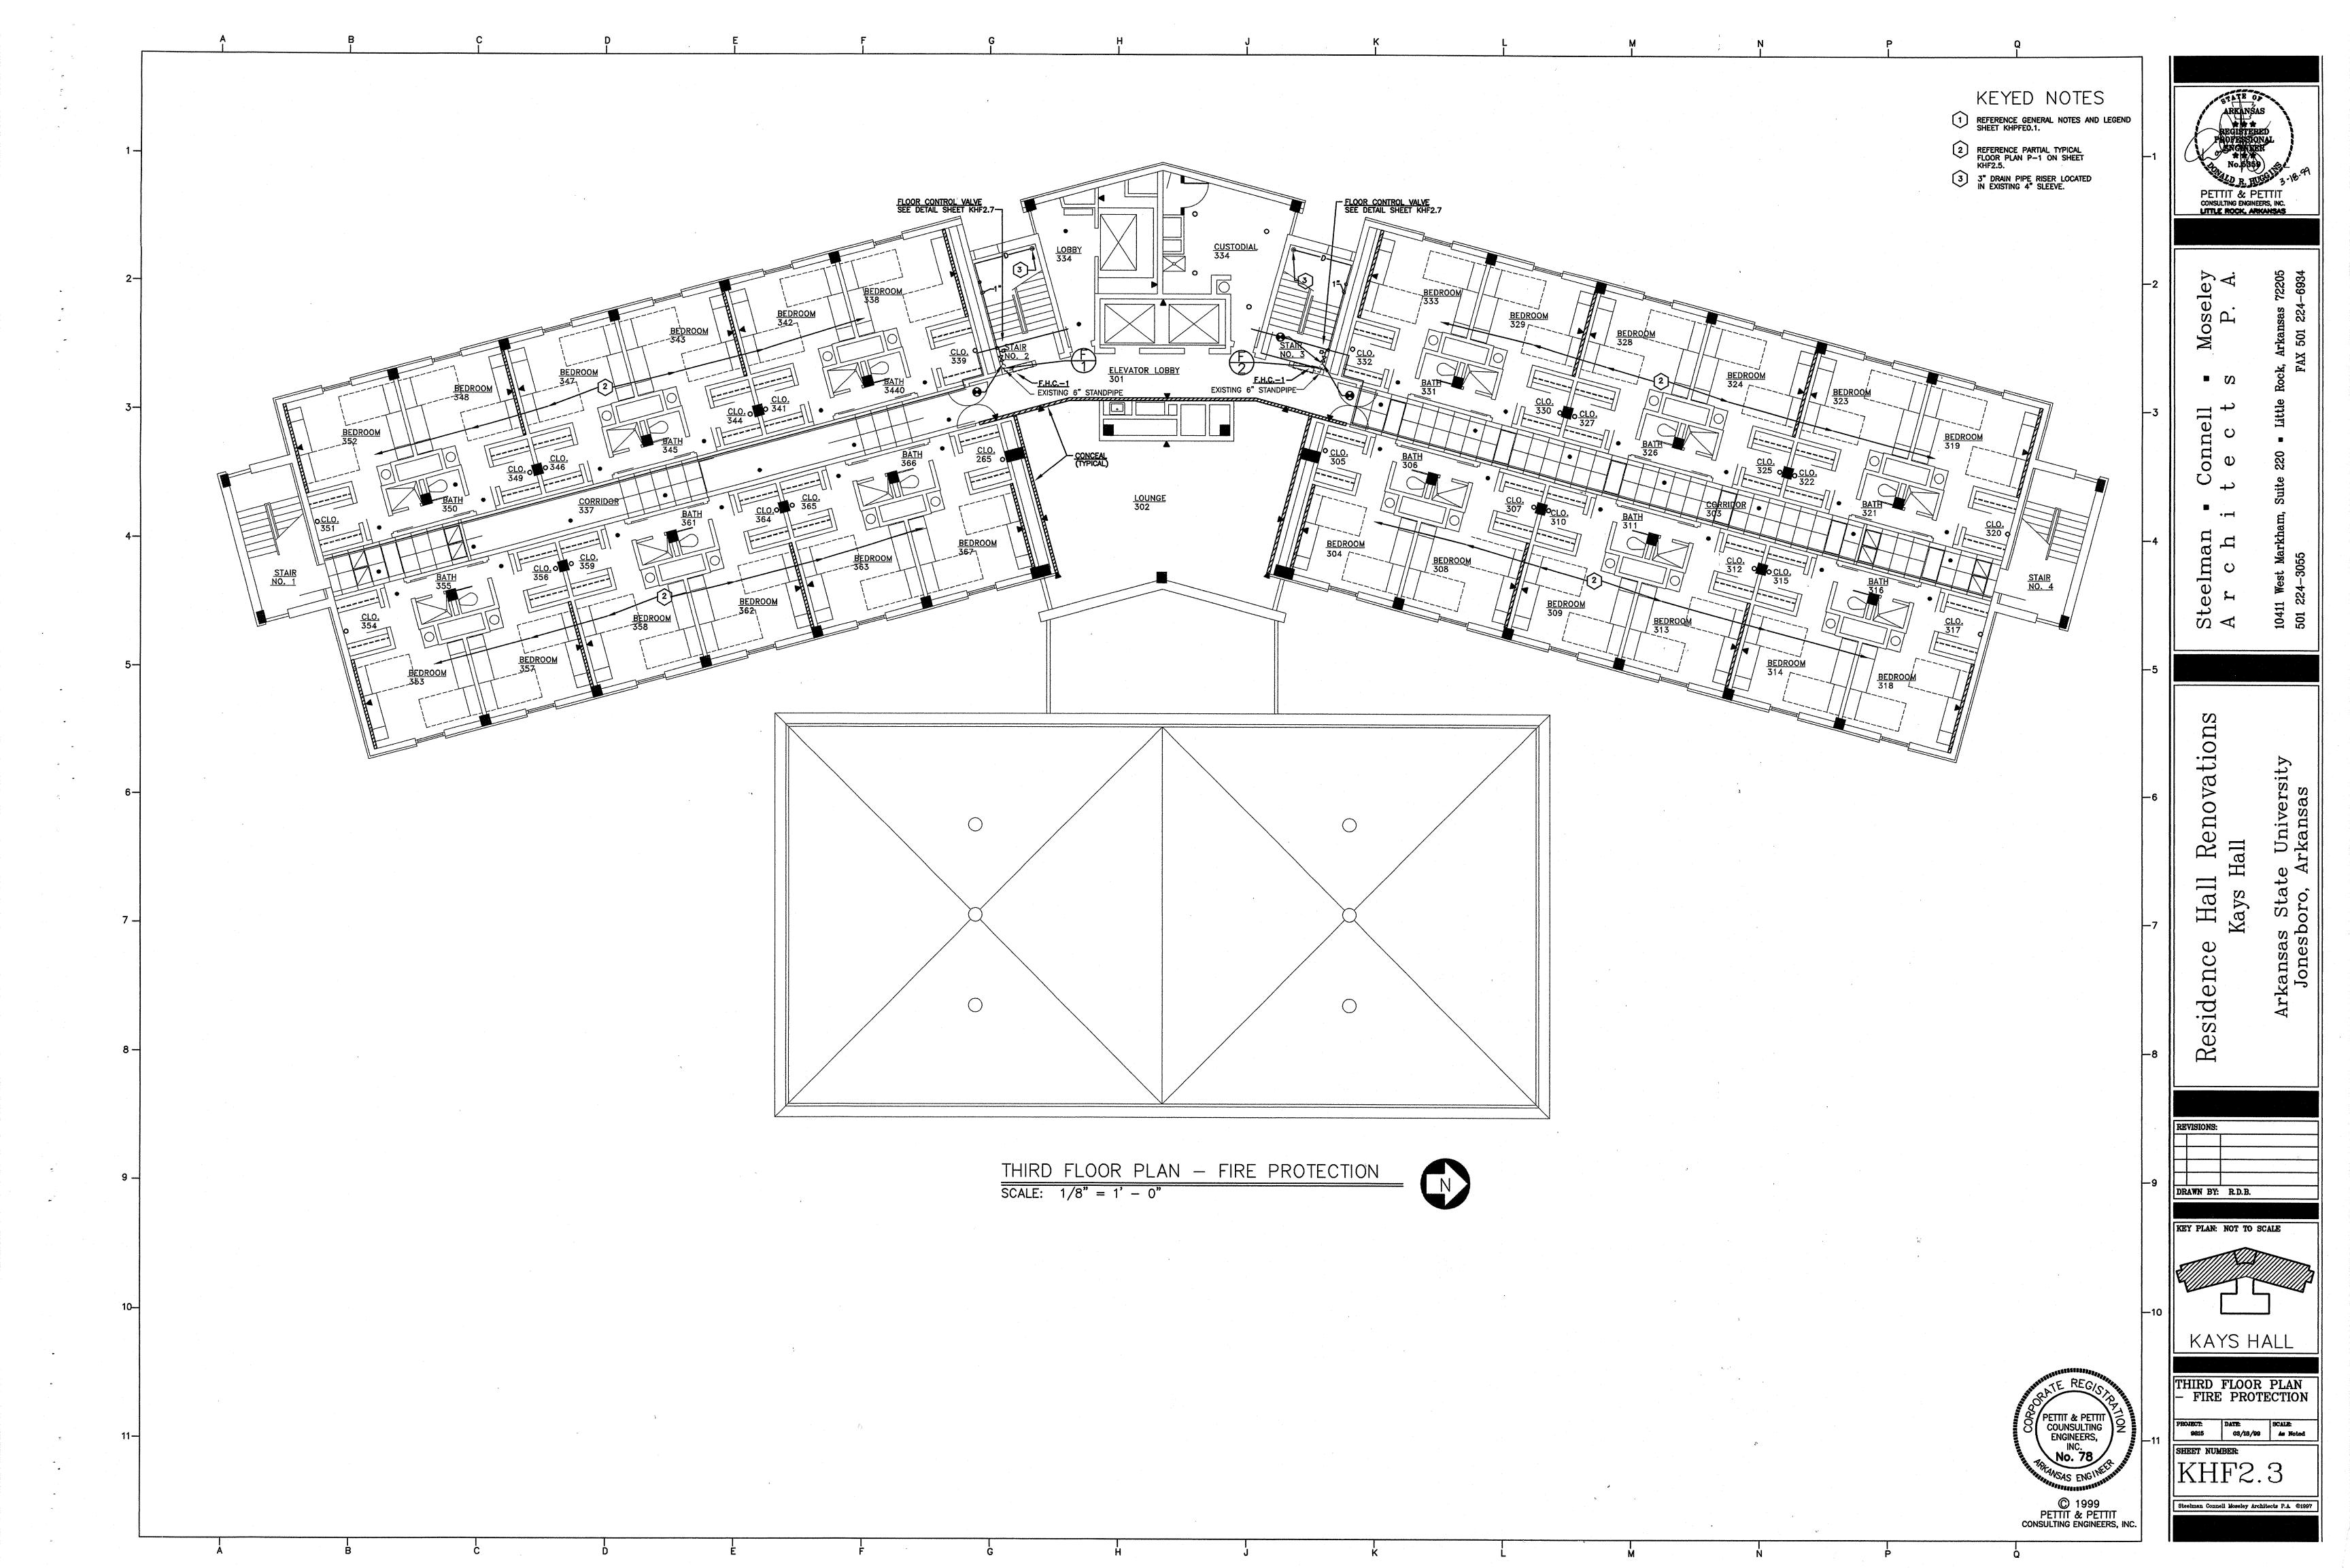


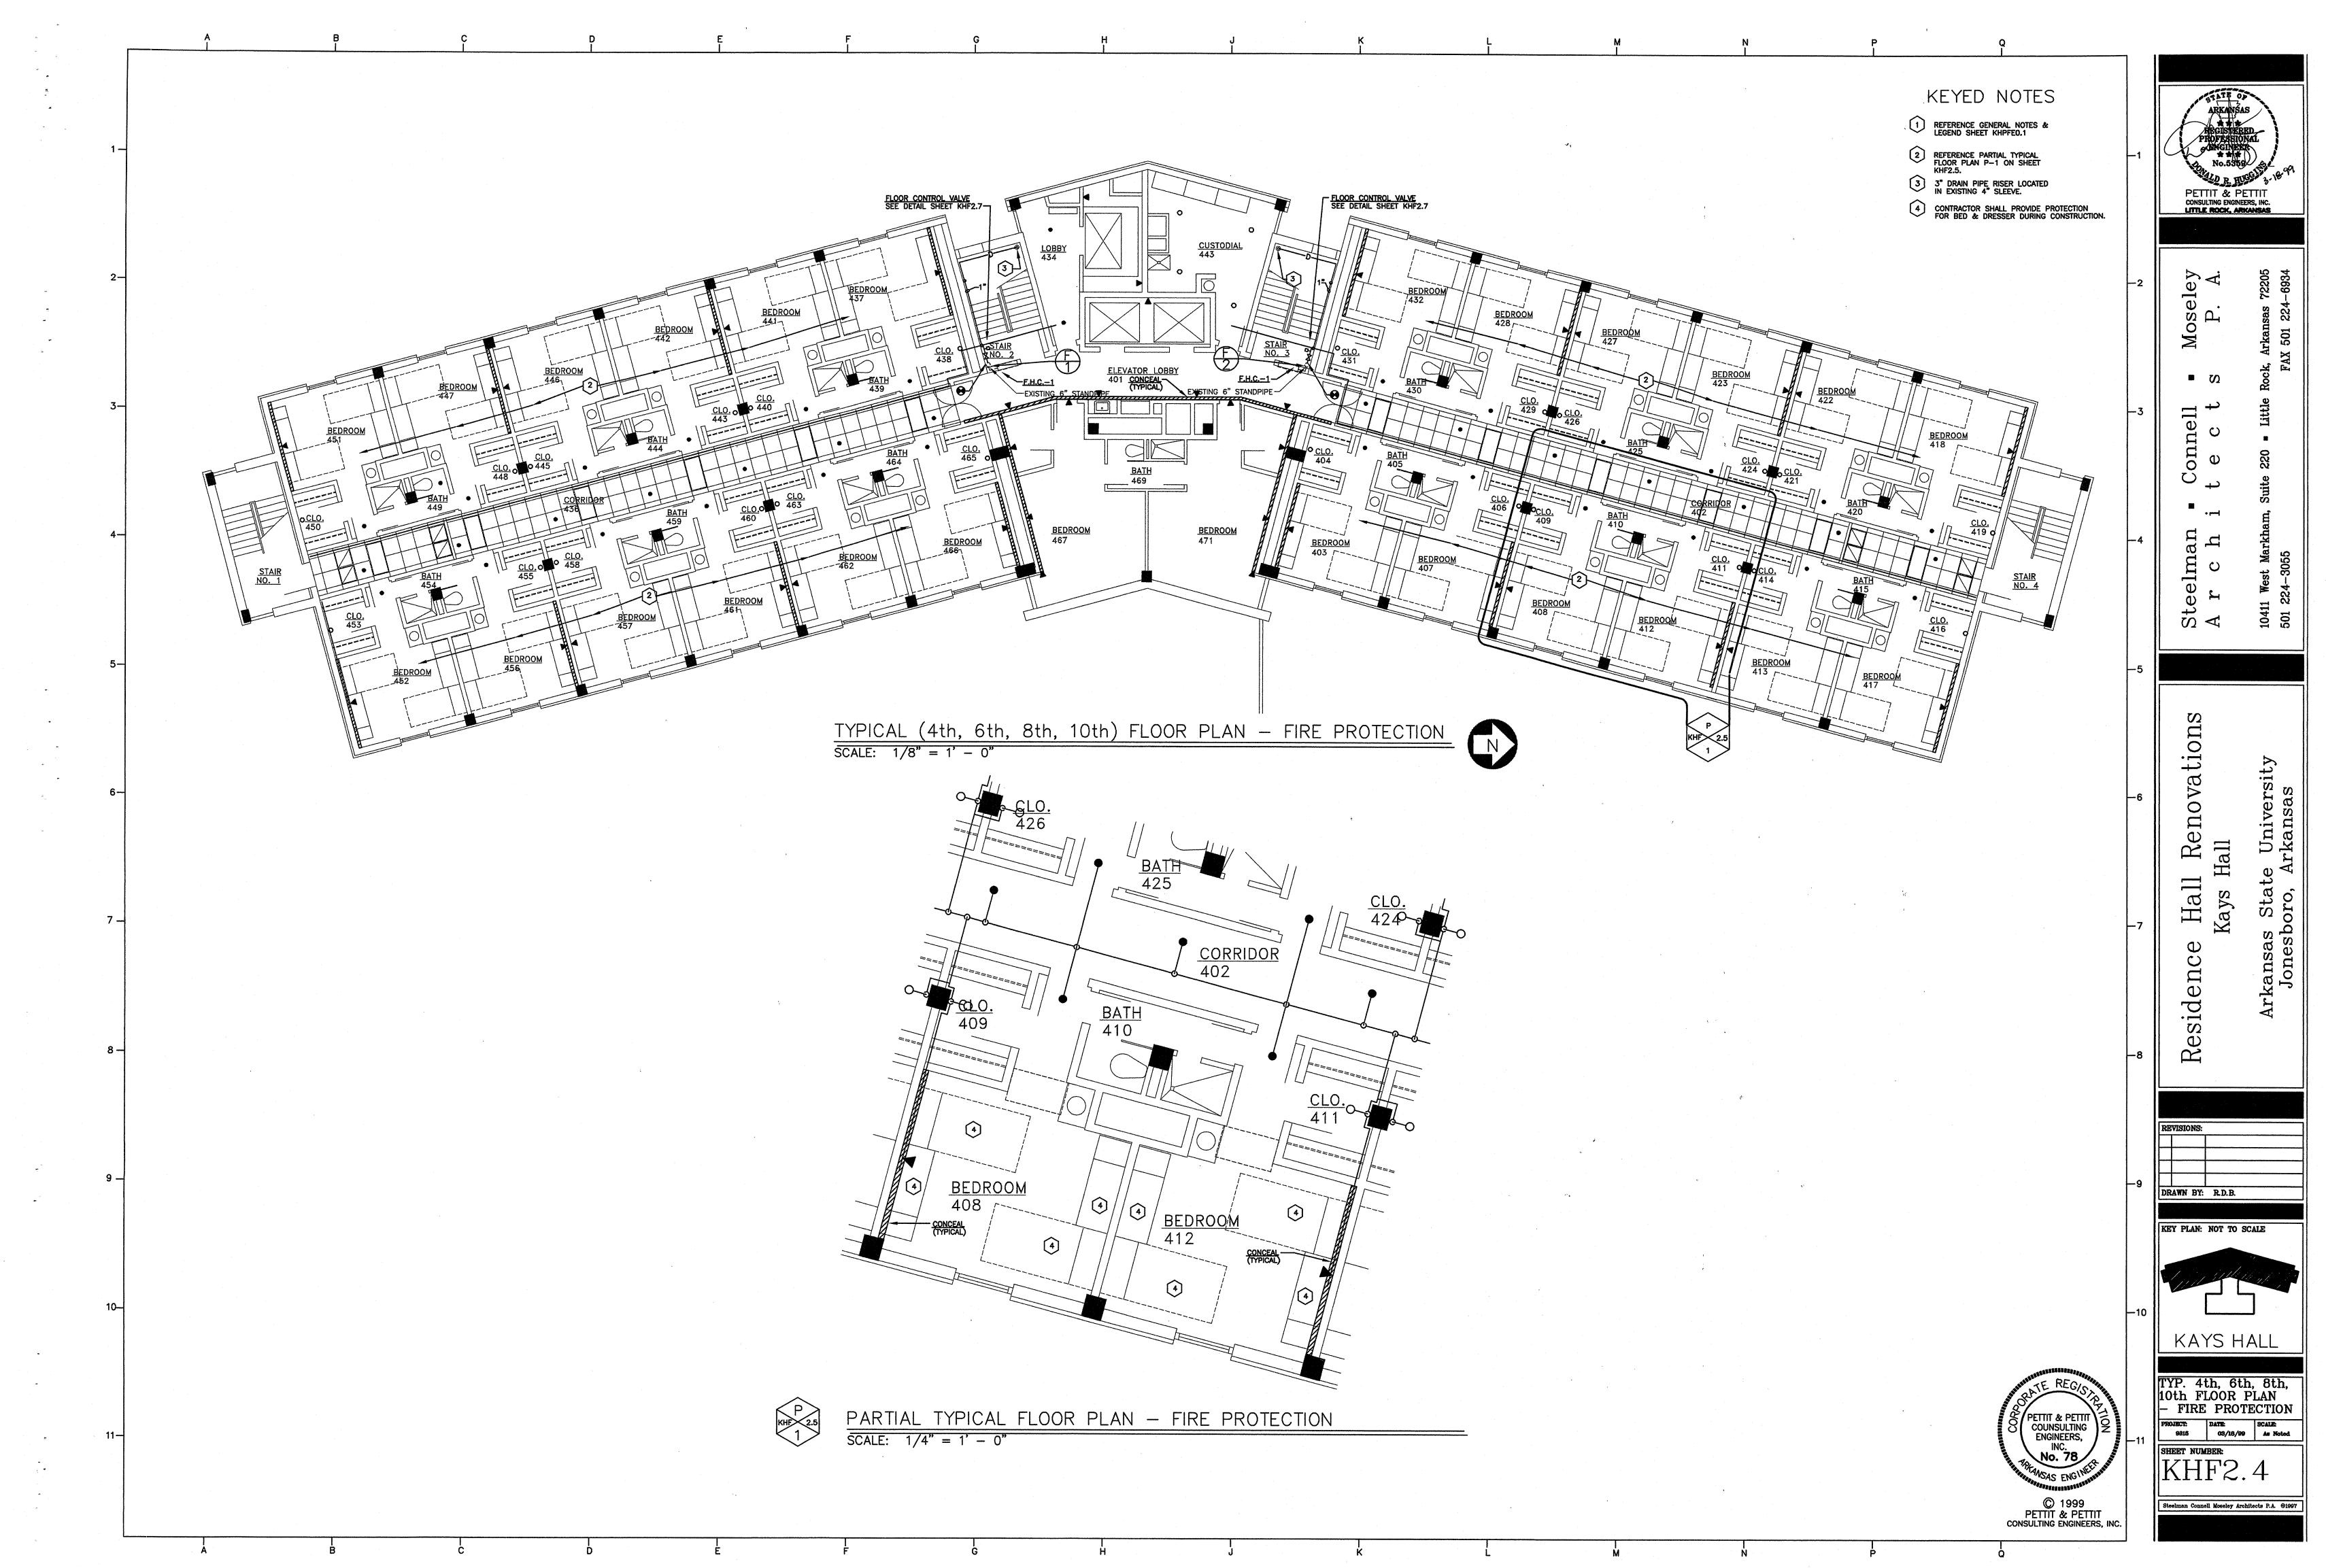


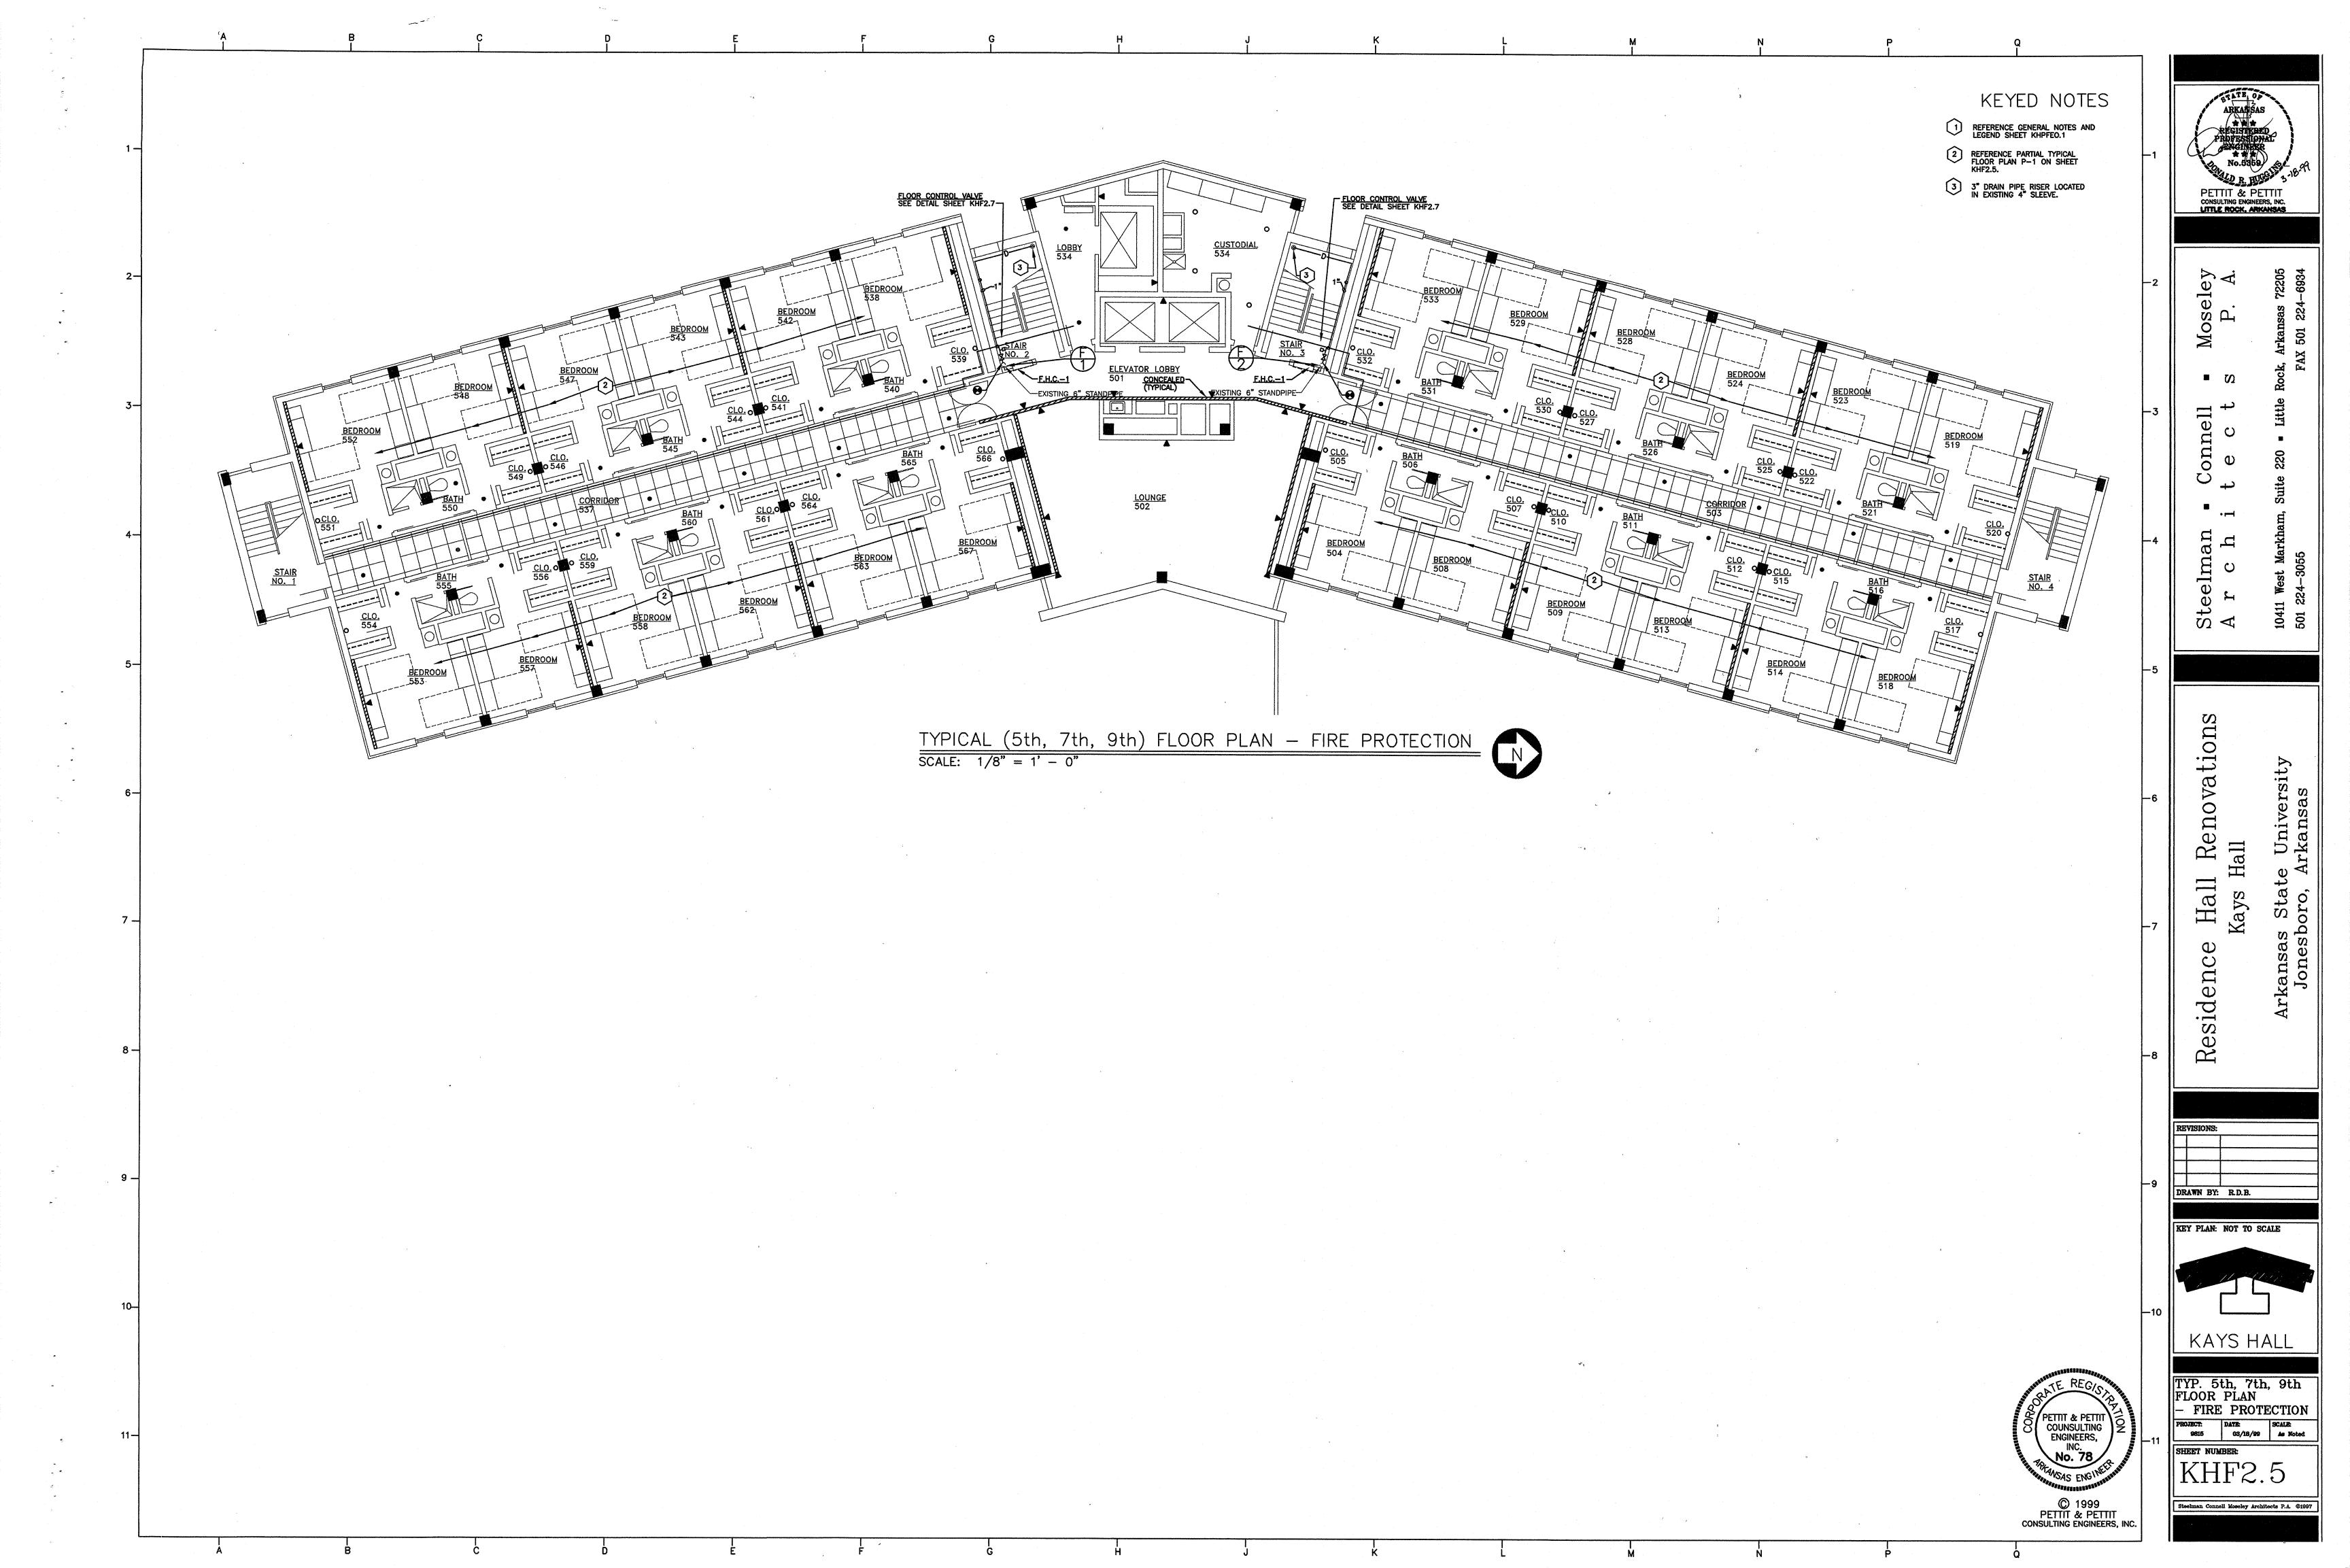


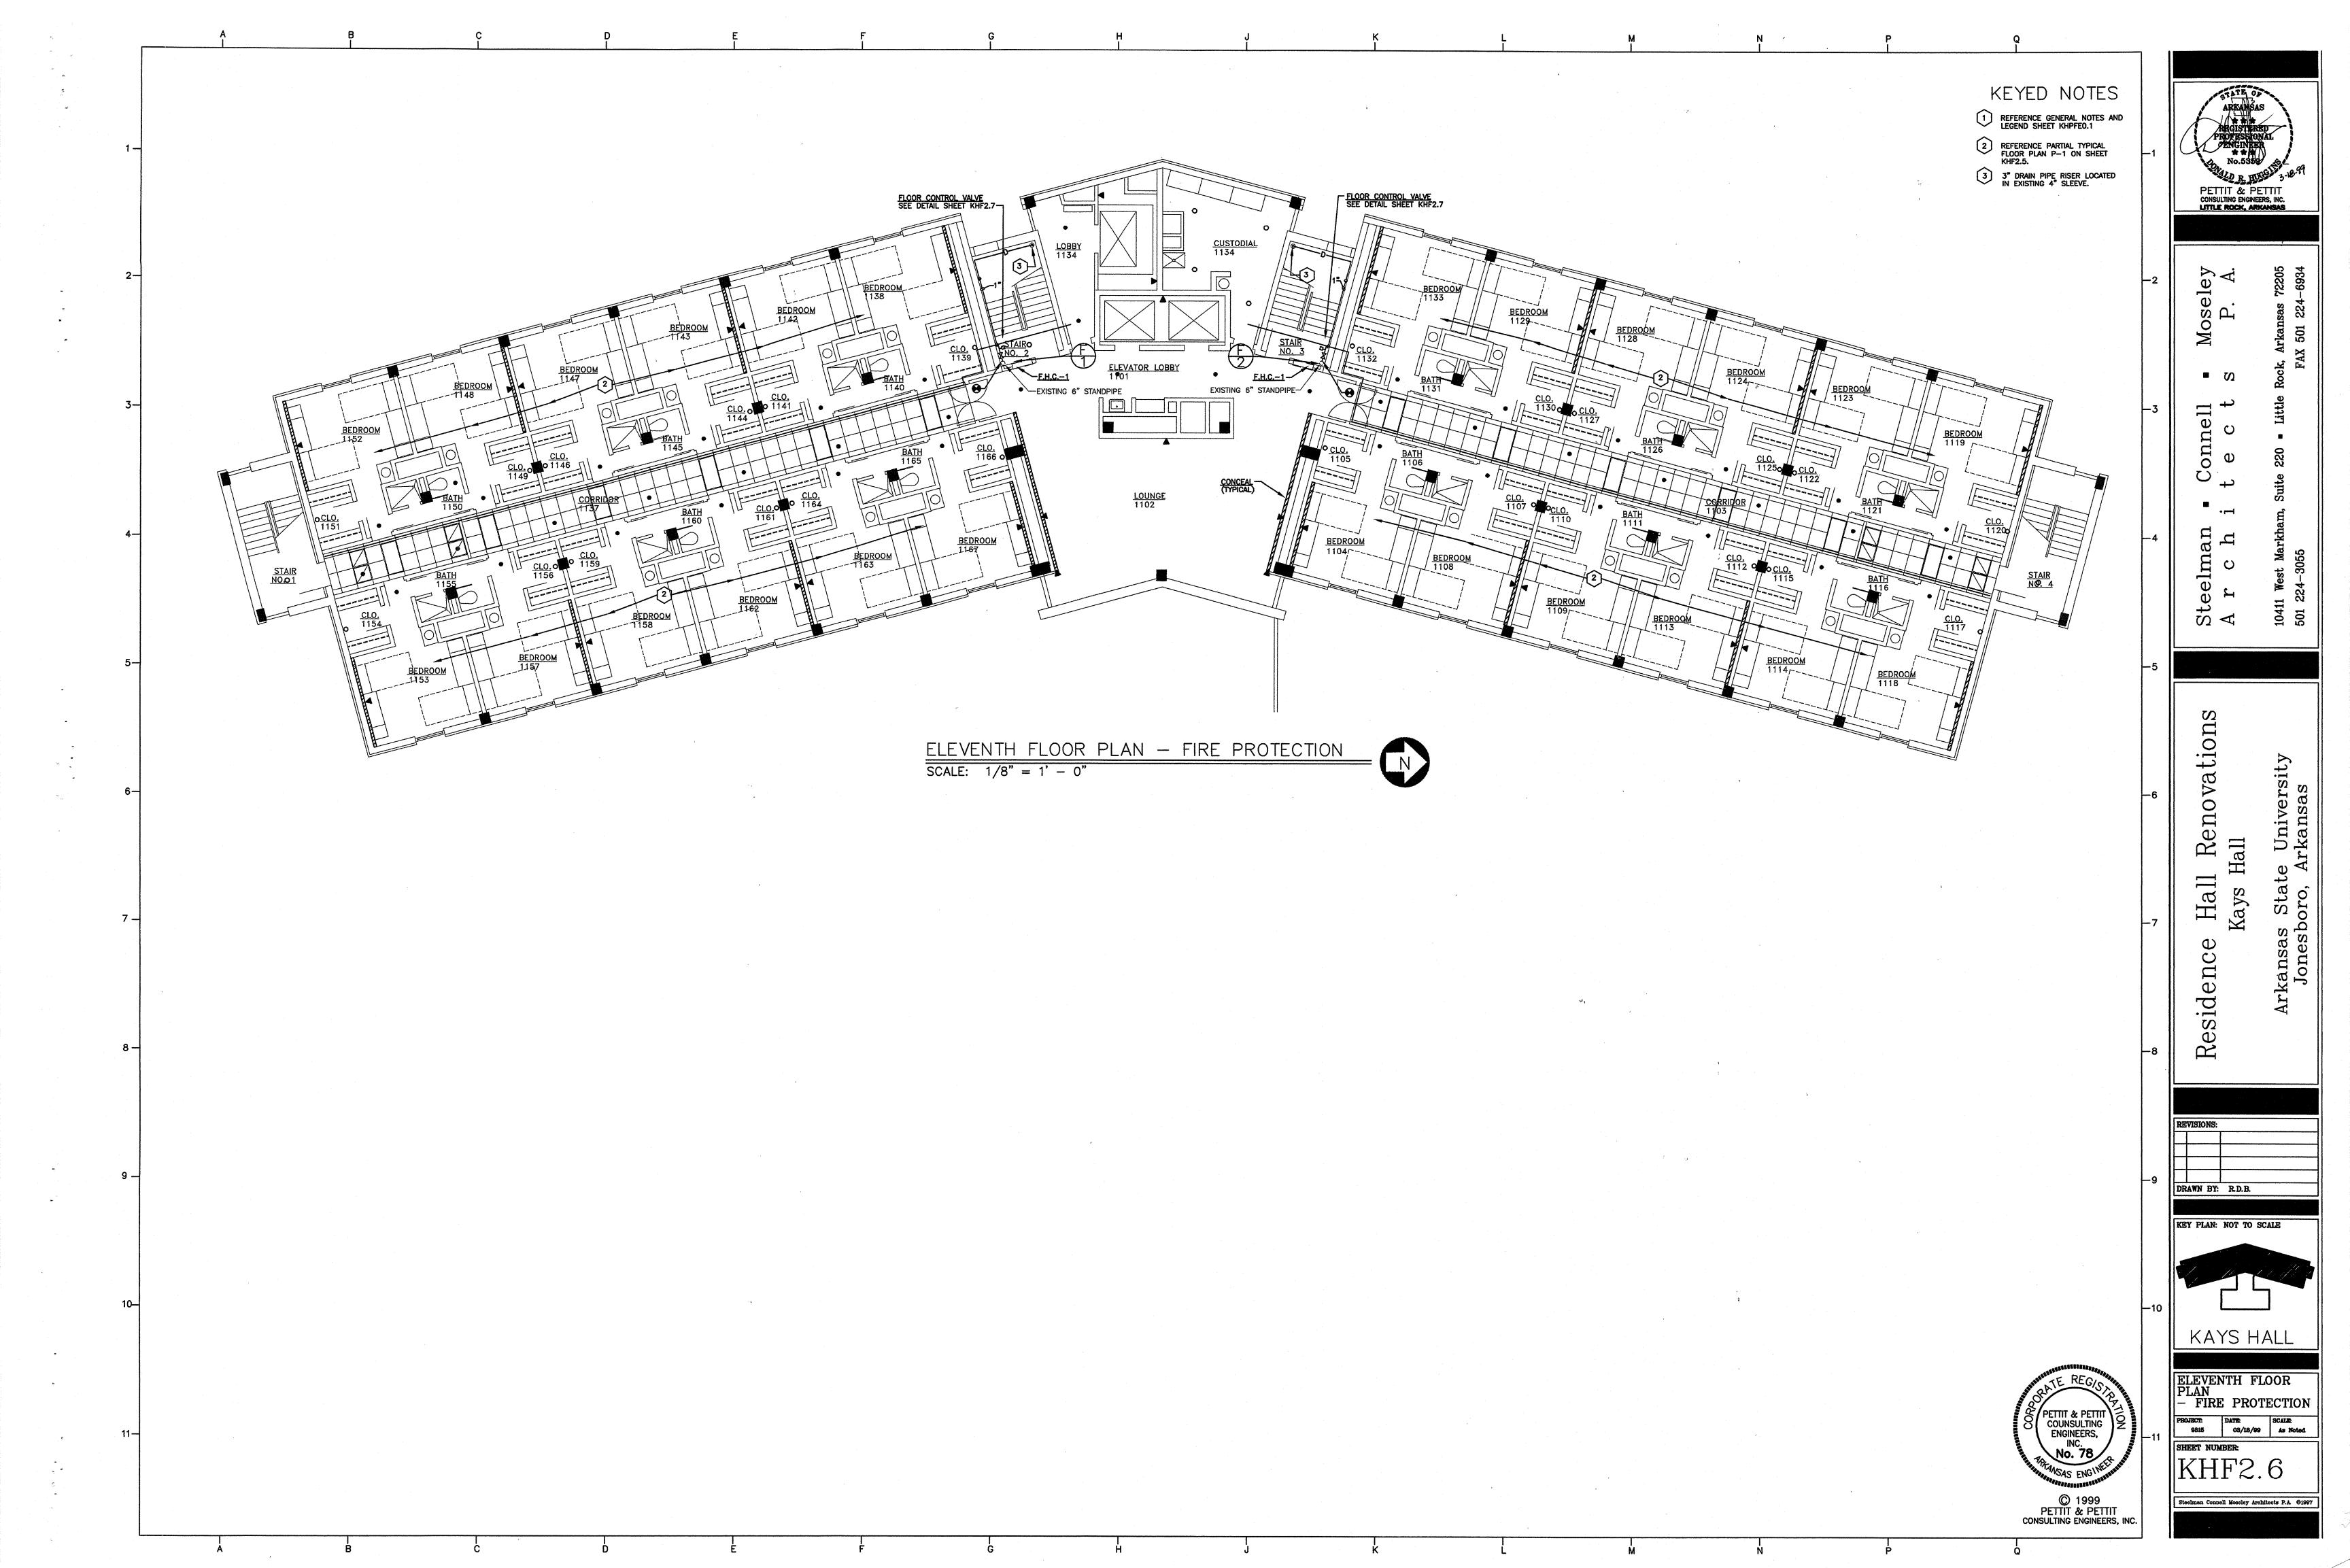


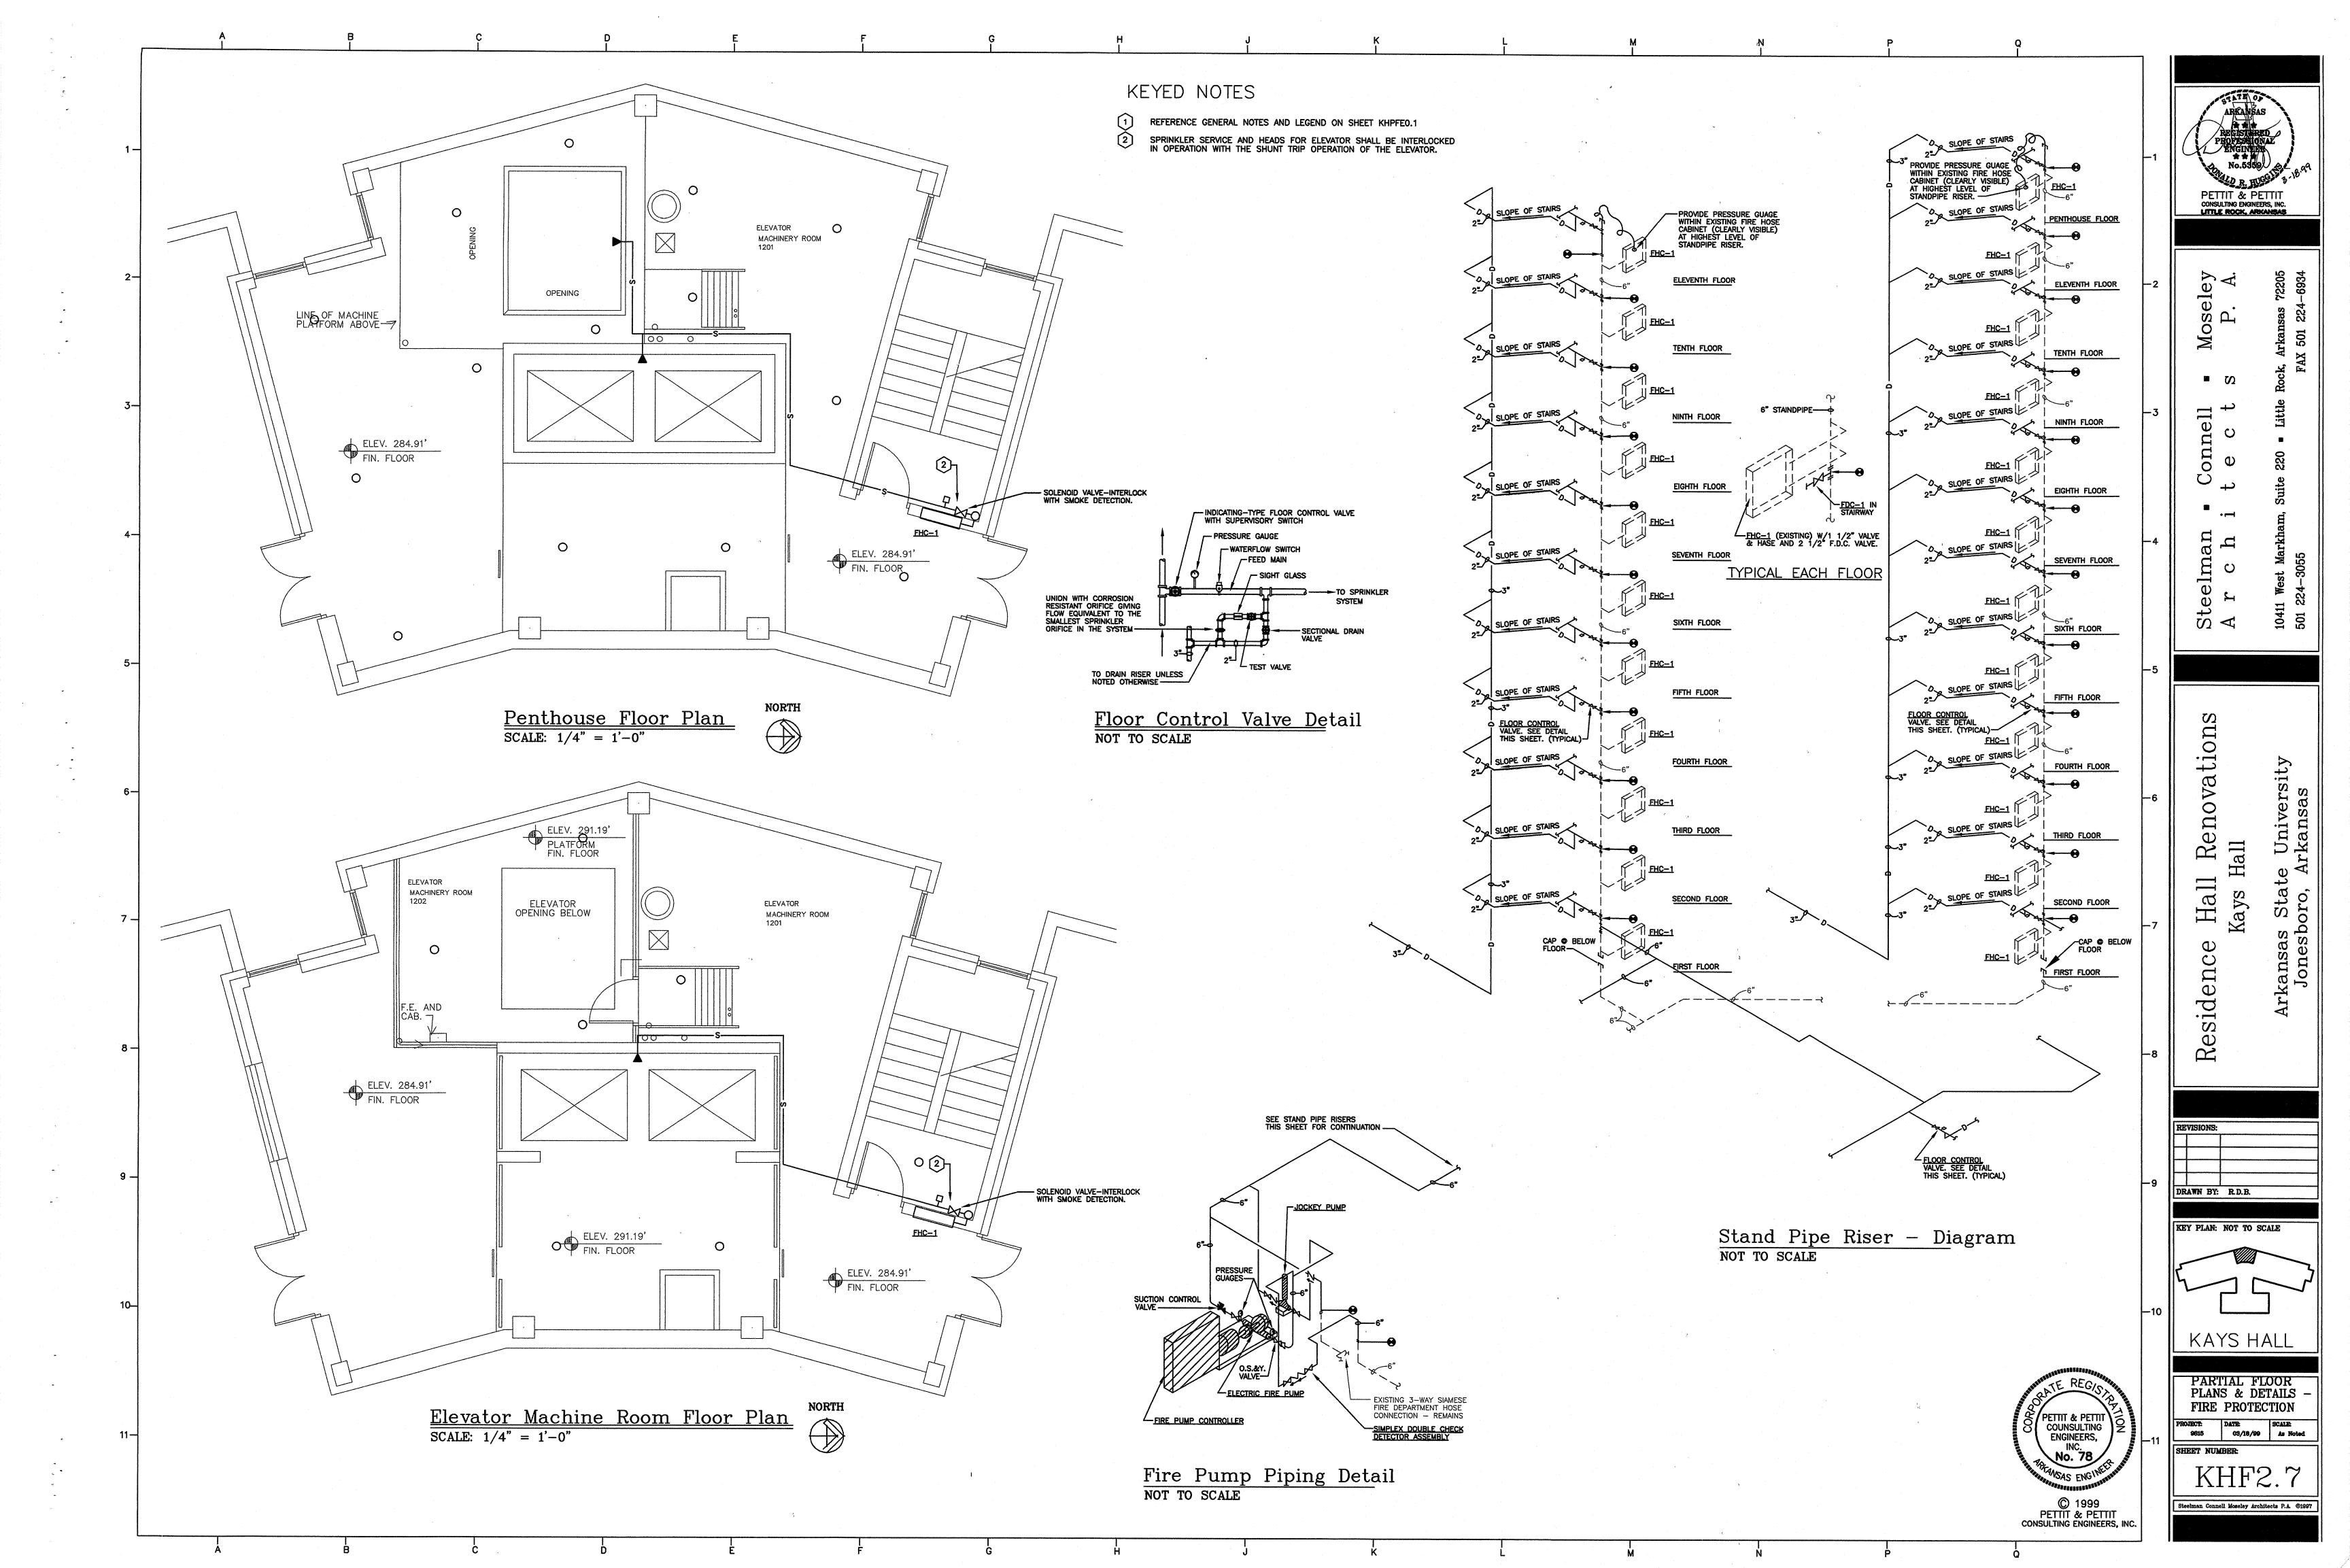


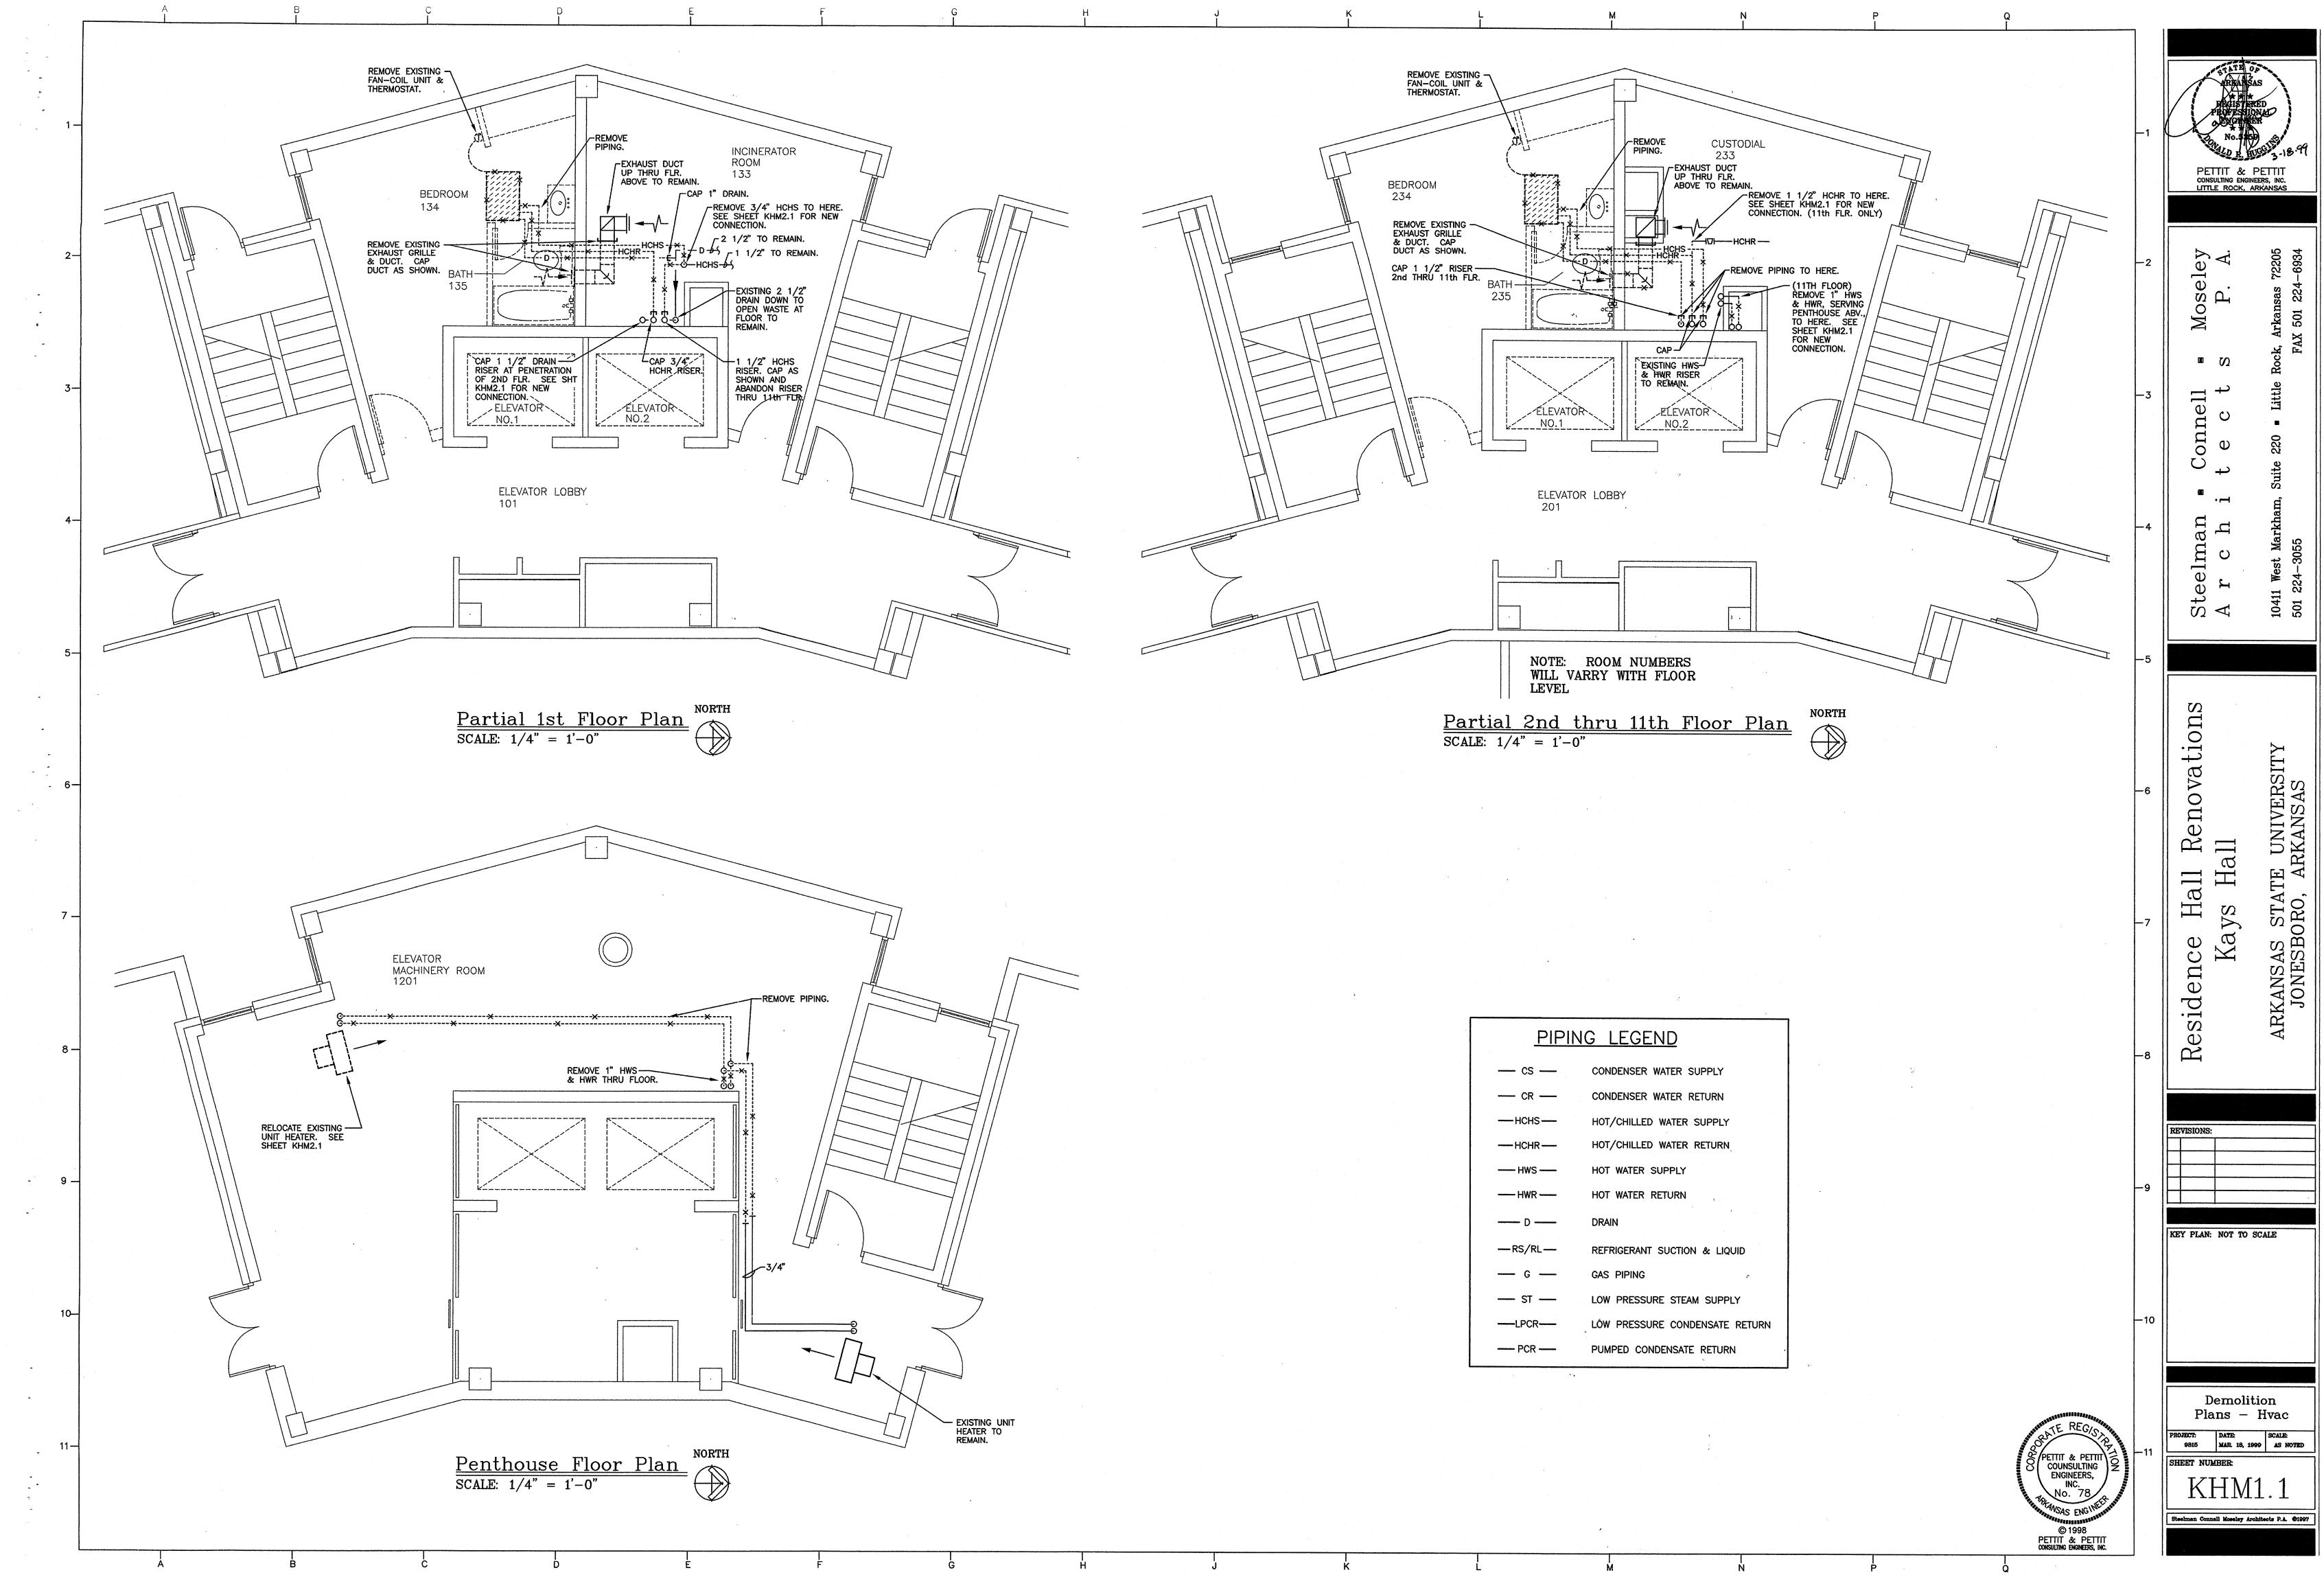

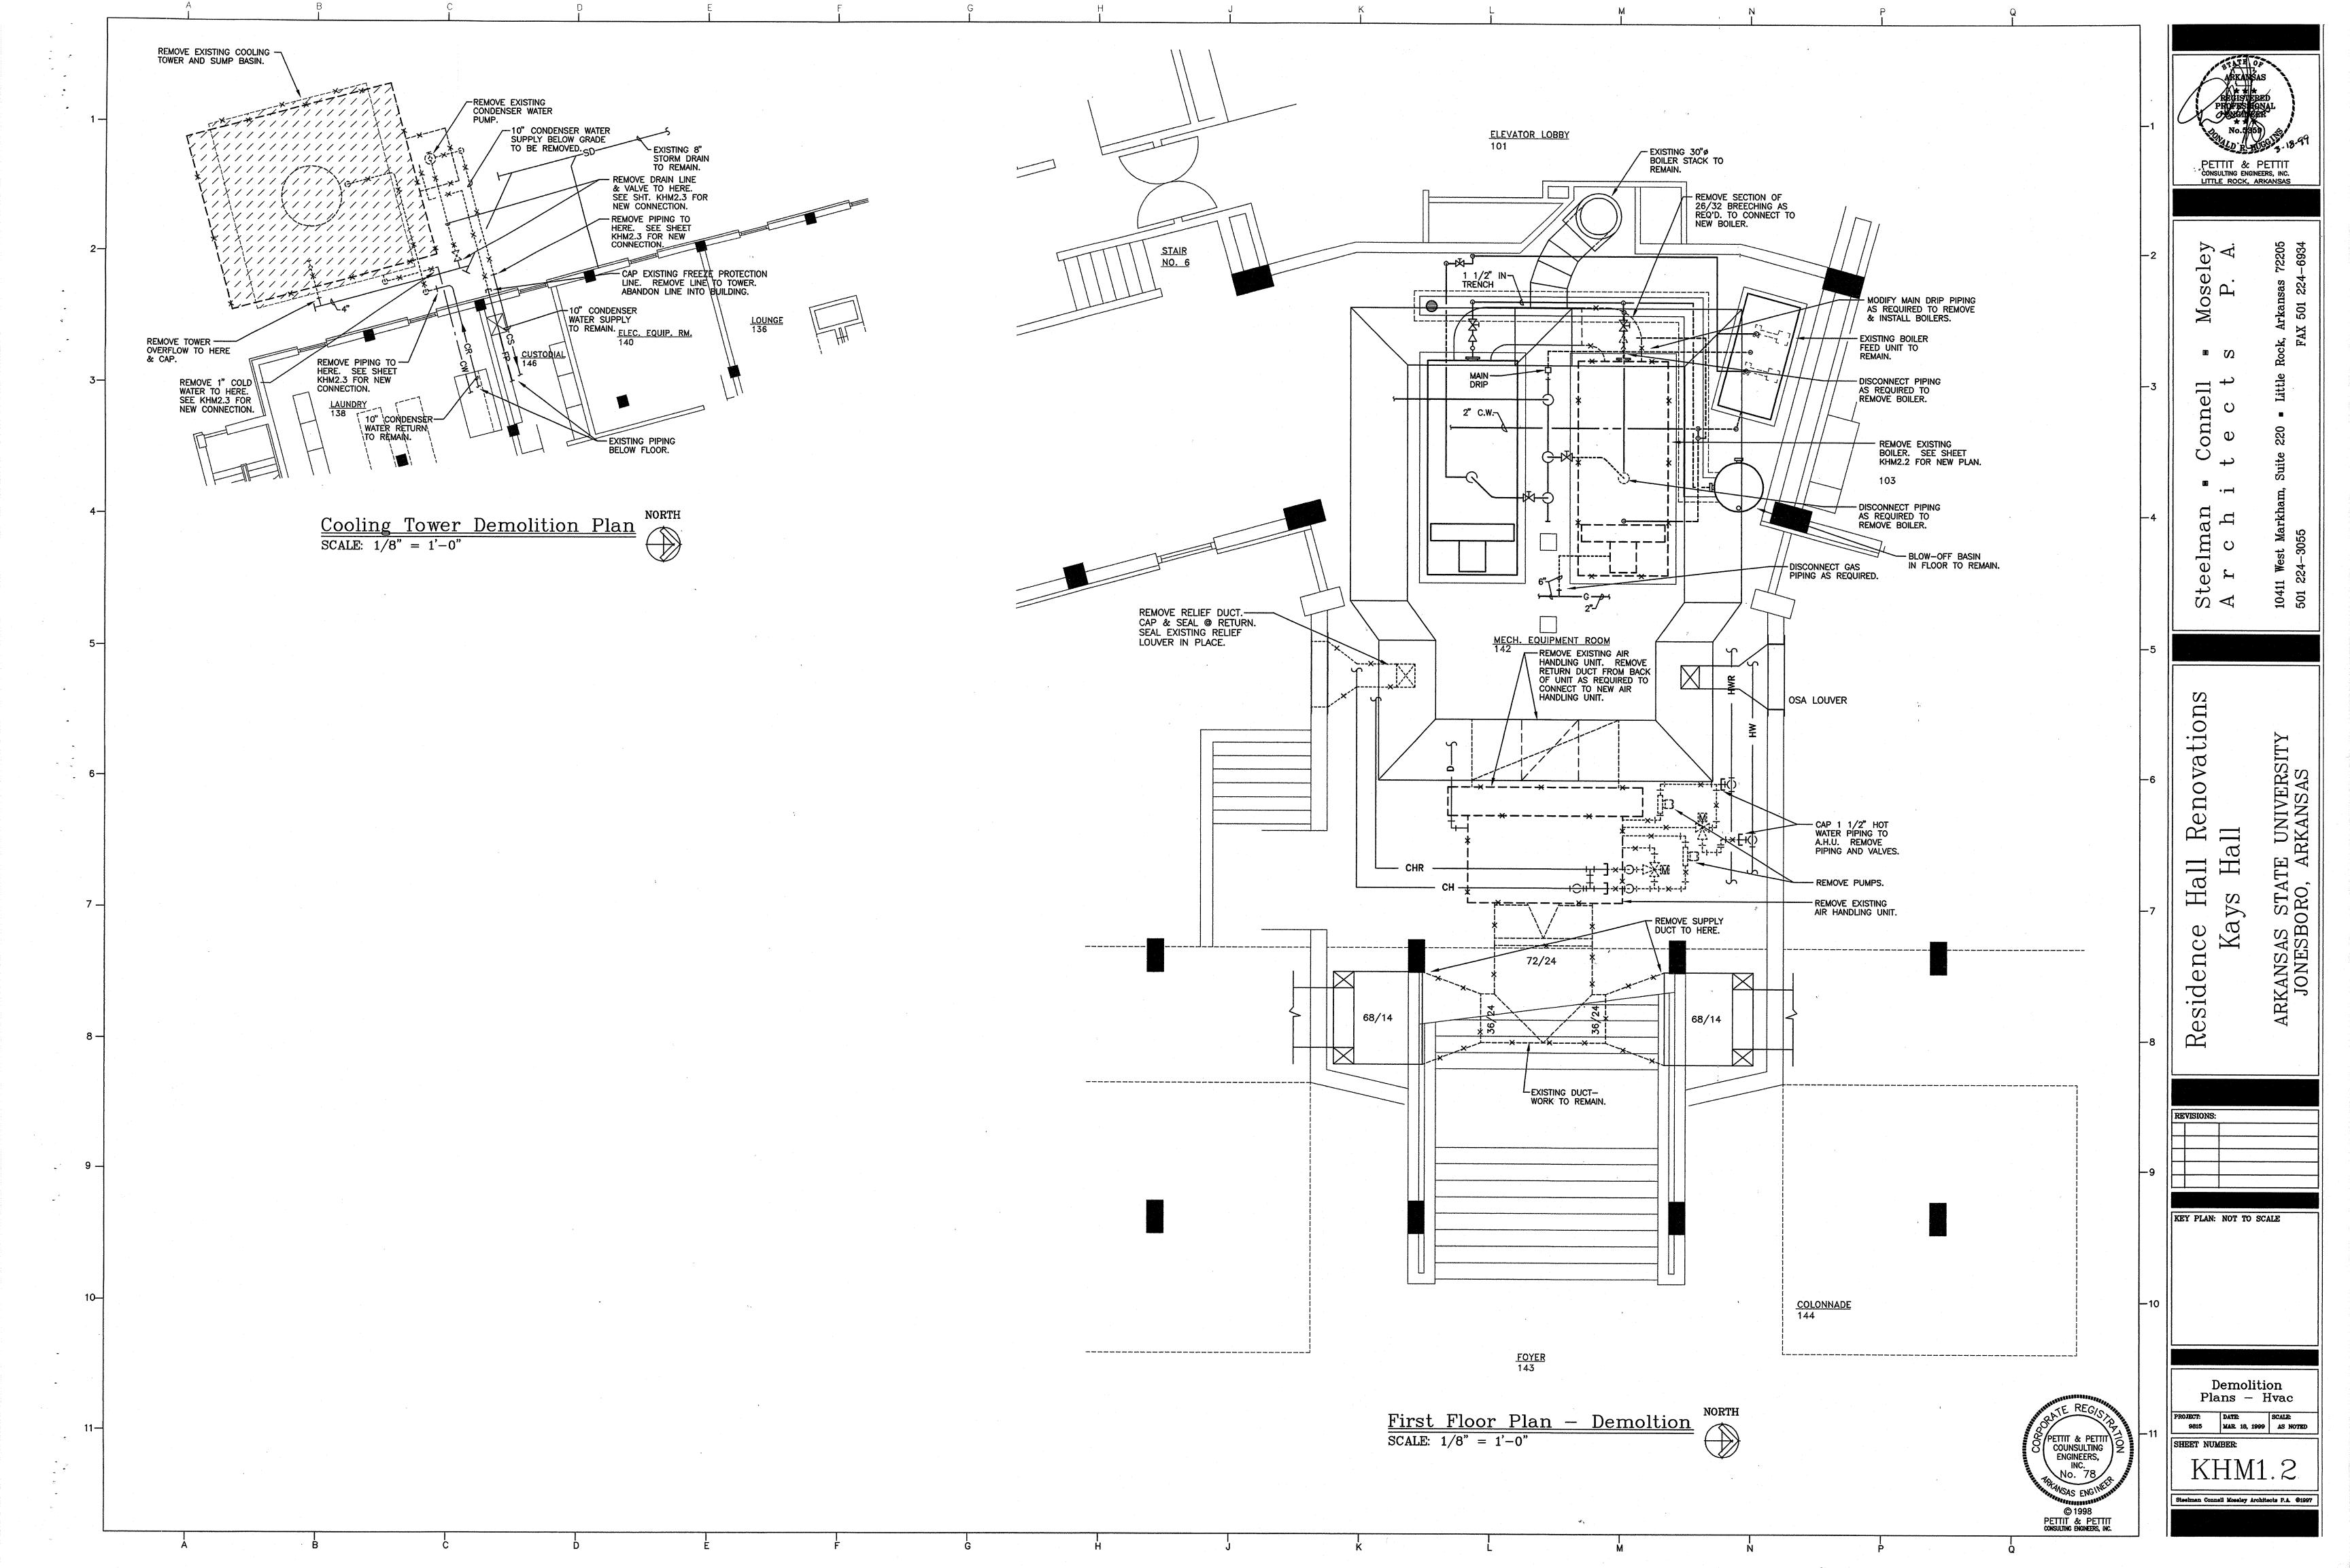

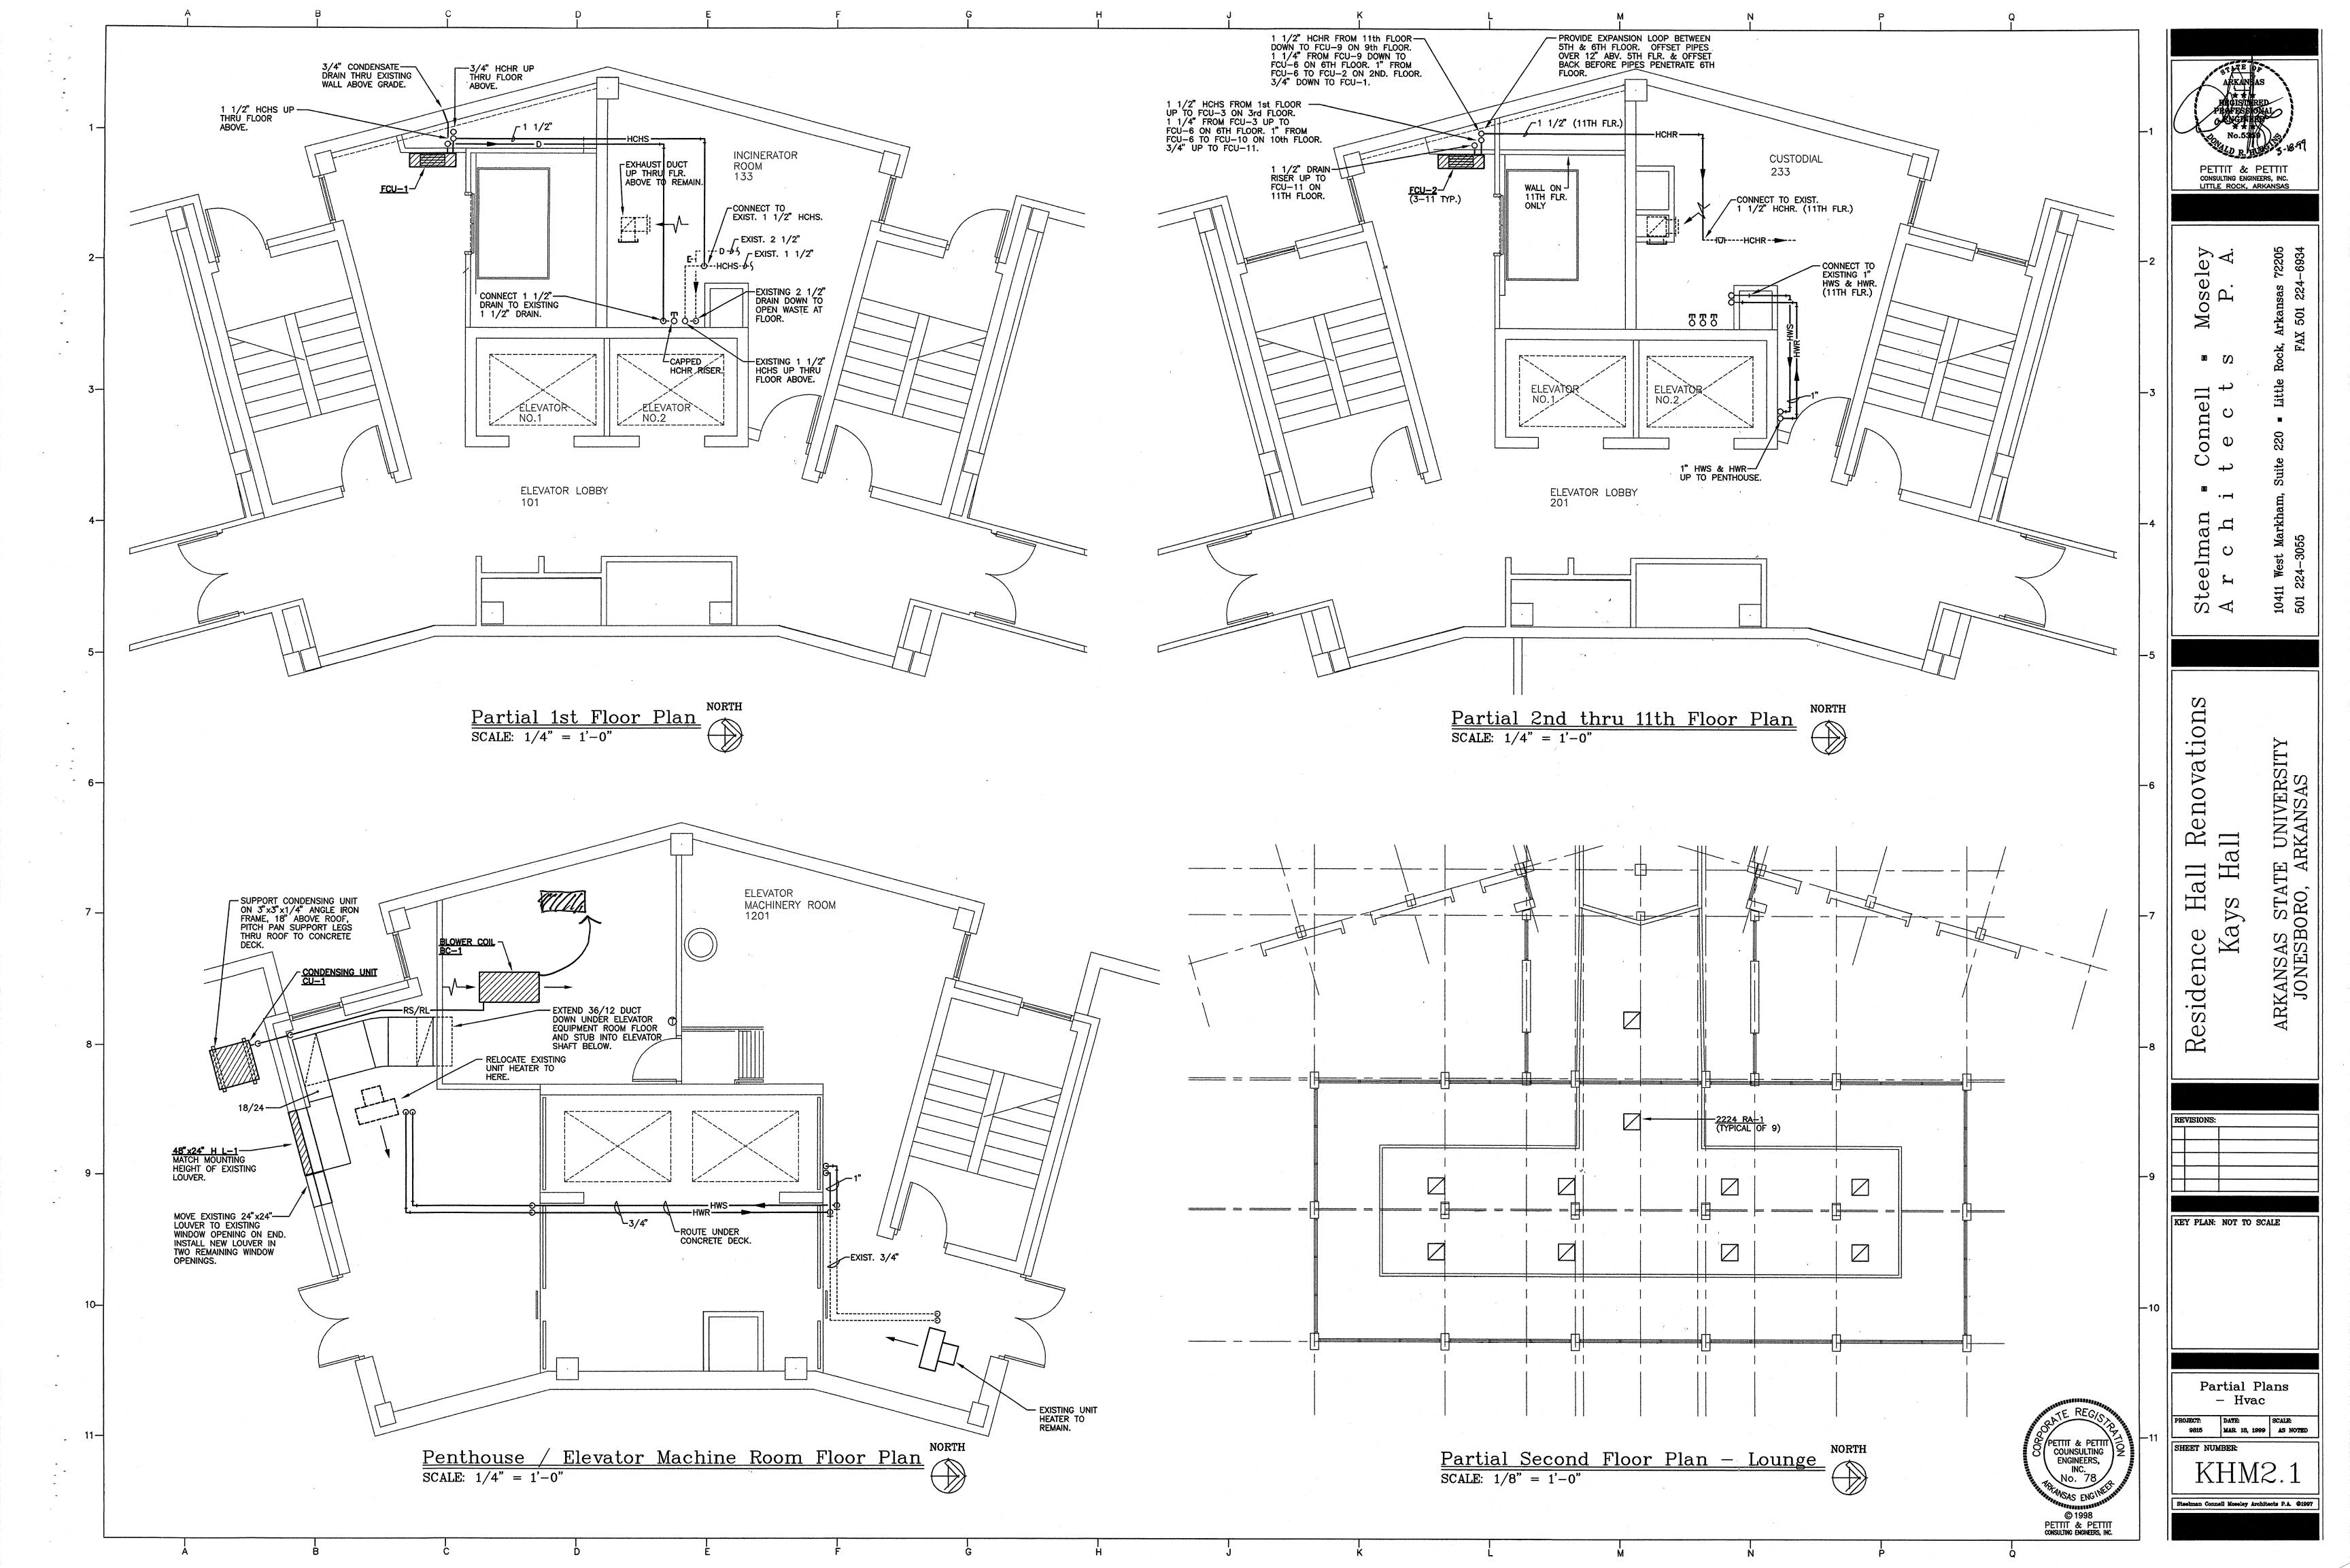

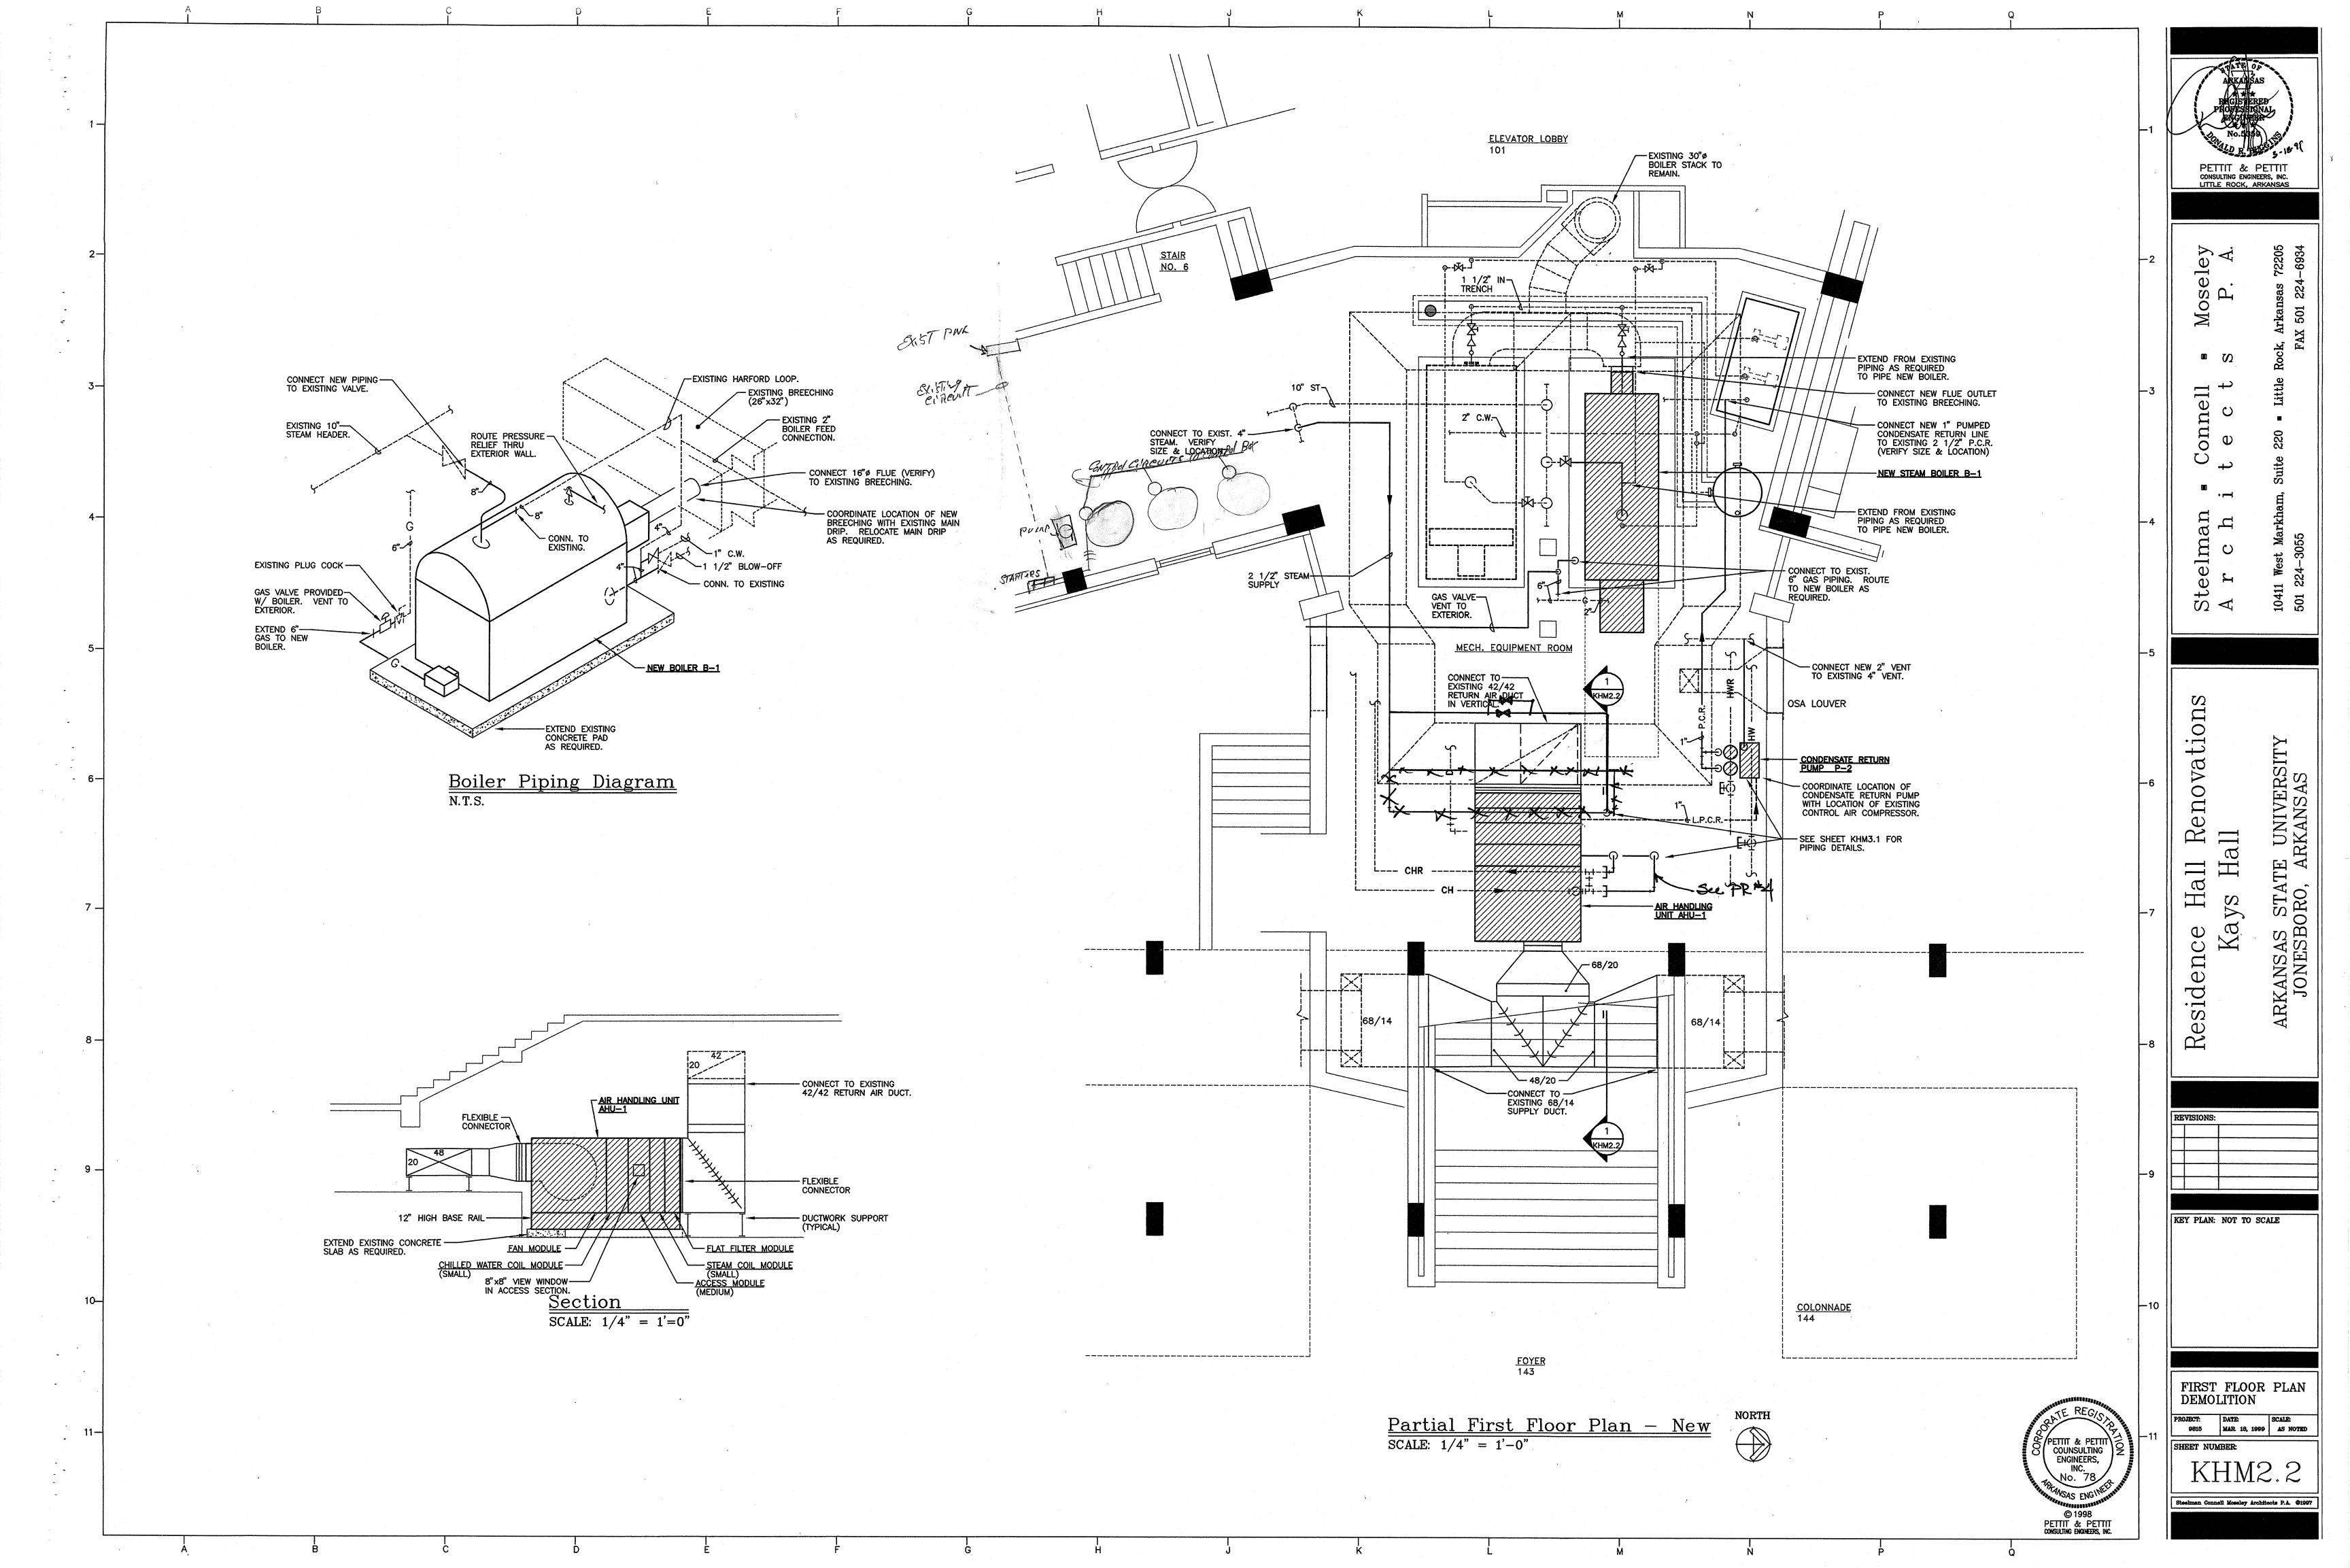

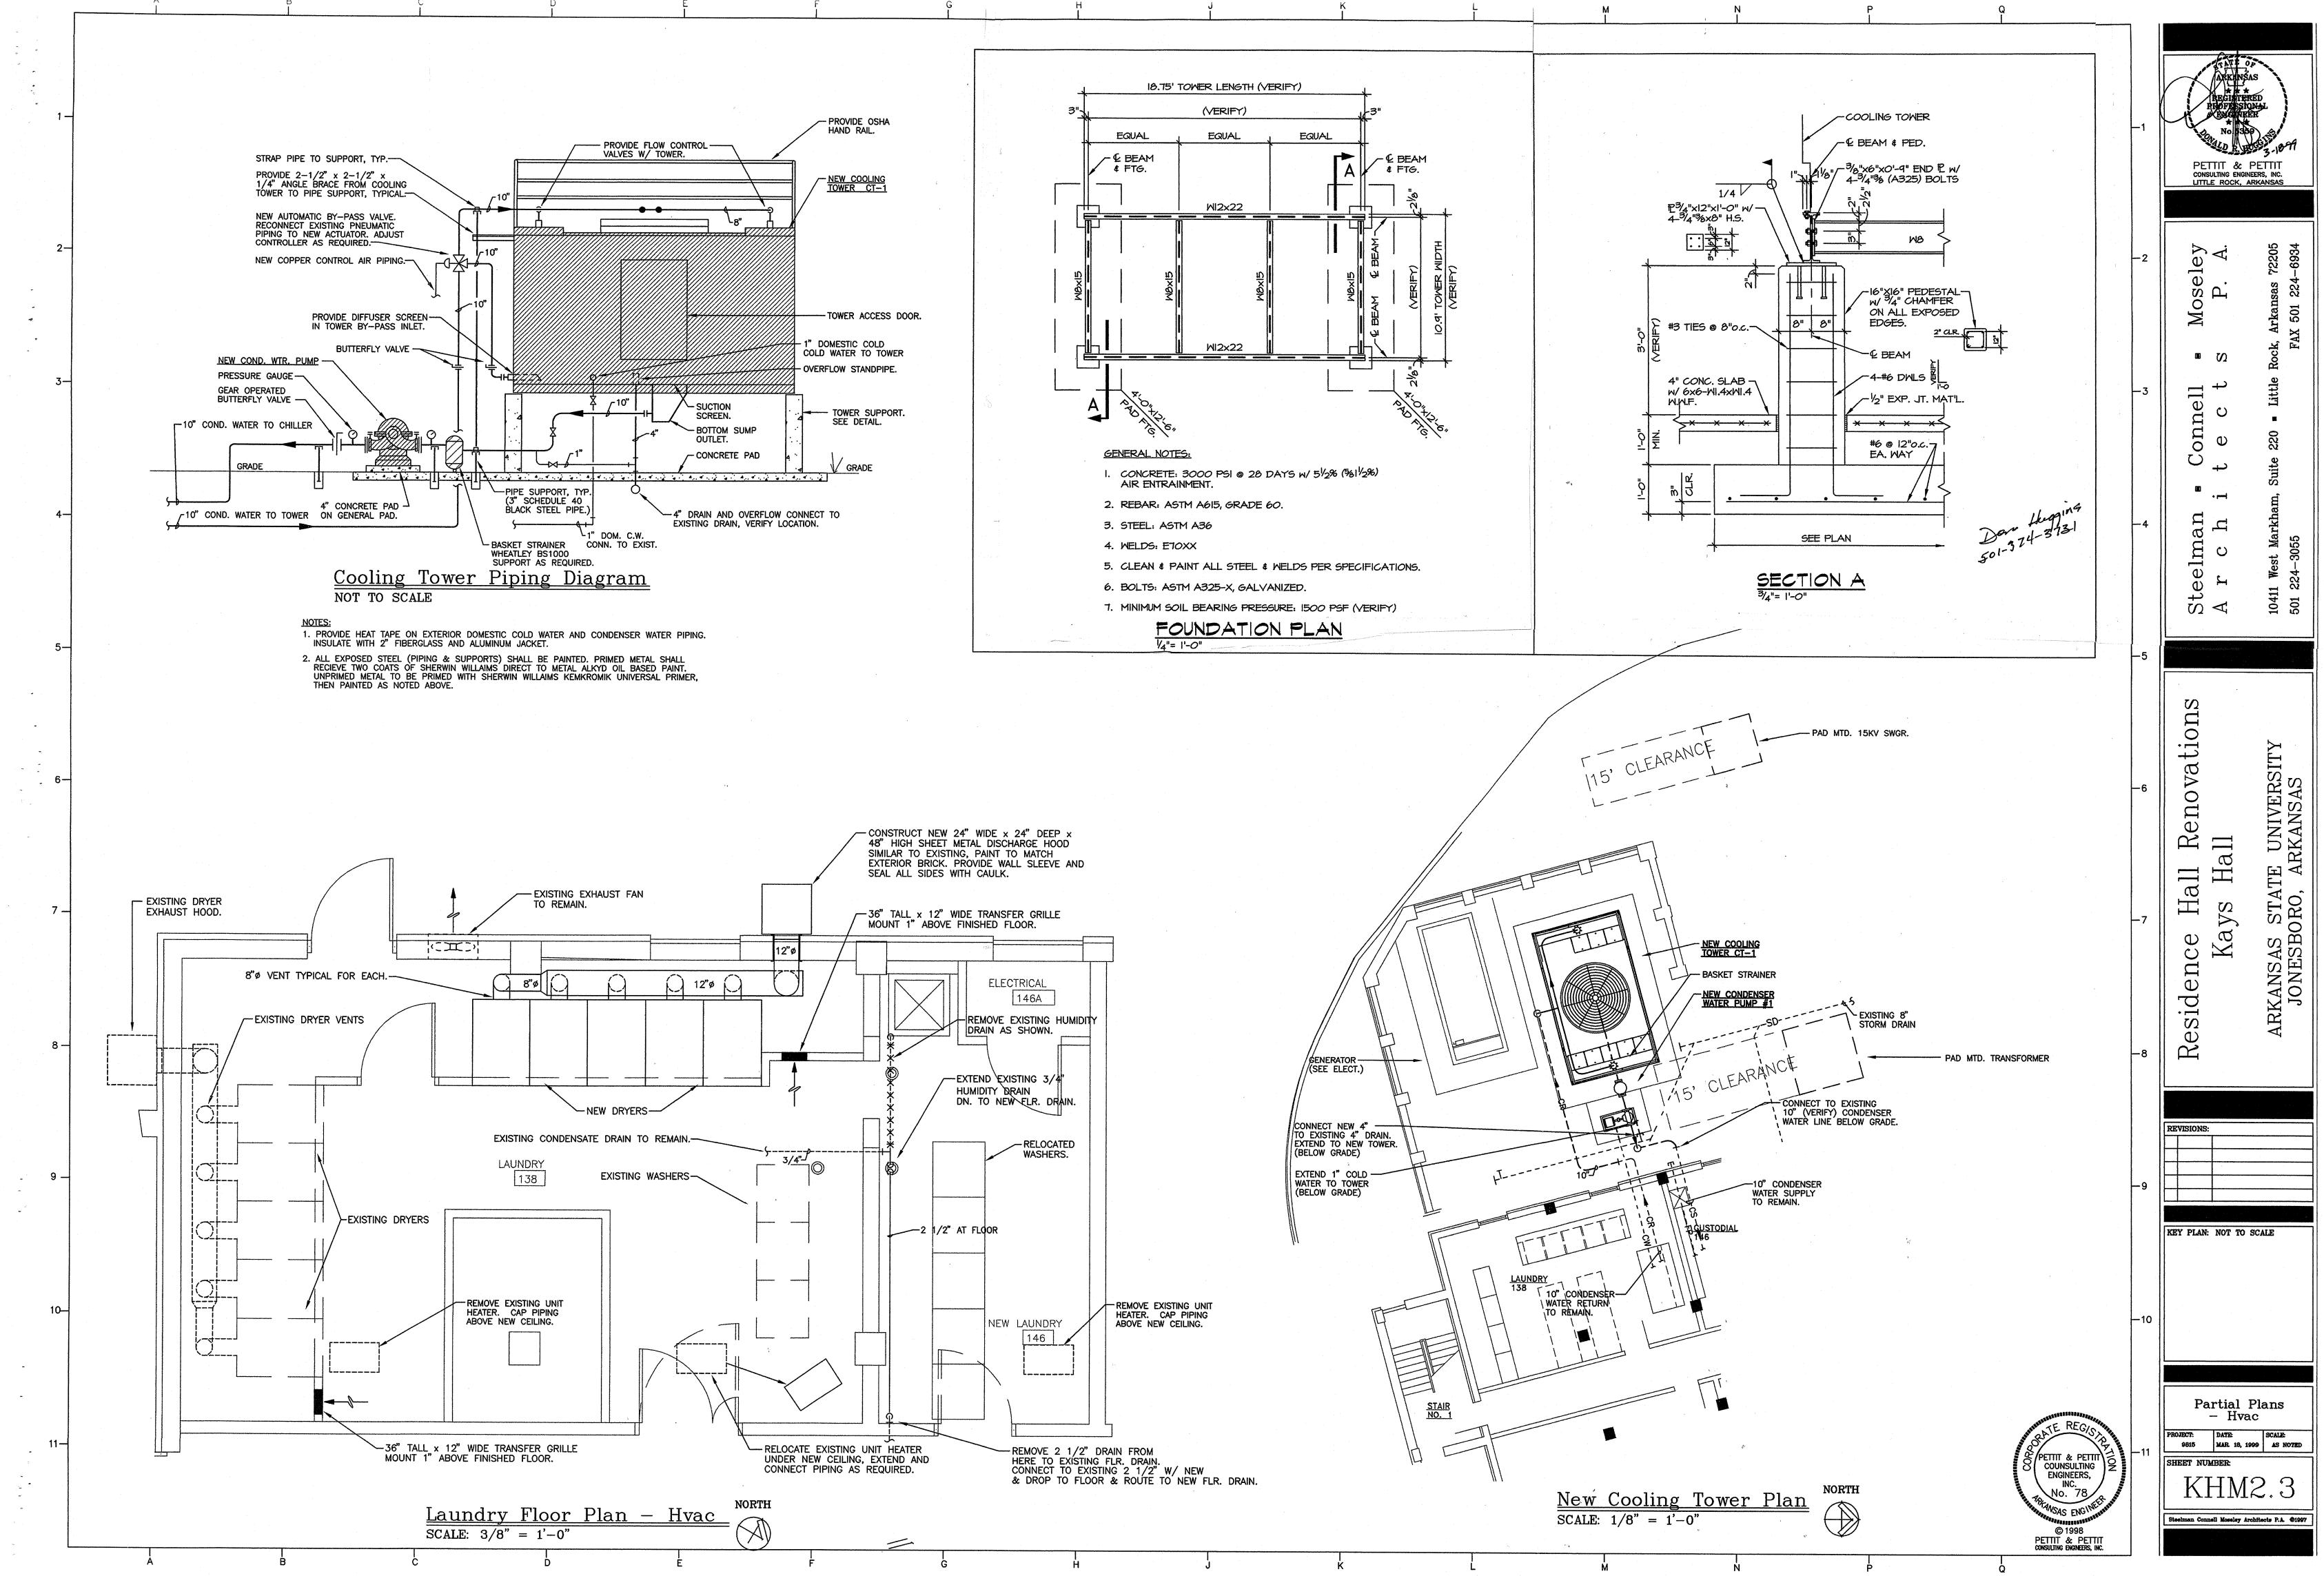

	AIR HAN	DLING	UNIT S	SCH	EDU	LE		·····		• ••••••••••••••••••••••••••••••••••••		
DESIG.	MFR/MDL	AREA	LOCAT.	TYPE	0	SA		FAN D	ATA			
		SERVED	LUCAI.		MIN	MAX	CFM	ESP/TSP	TYPE	DIA.	EAT	
AH1	TRANE MCC	LOUNGE	BASEMENT MECH. RM.	MCC HDT #25	1250	1250	12500	1.5" WG 3.6WG	FC	22.4"	80db 67wb	

	COOLING	G TOW	ER S	CHE	DUL							
DESIC	MFR/MDL	TYPE	GPM	STATIC LIFT	EWT	LWT	AMBIENT WET BULB TEMP.	ĸw	BASIN HE STEPS	EATER VOLT/PH	NO.	HP
CT-1	MARLEY / 5201	INDUCED DRAFT	922	12.23	95.0°	85.0°	80.0				1	15

		PUMP SC	HEDU	LE									
	DESIG.	MFR/MDL	OED\/EQ	LOCAT	TYPE	OPM	LIEAD			MOTOM	R DATA		D
Ľ	AEORA.		SERVES	LOCAT.	TYPE	GPM	HEAD	EFF.	BHP	HP	RPM	VOLT/PH	RE
· •	Cond. Water UMP #1	PACO / 5012	TOWER #1/ CHILLER #1	TOWER	HORIZ. SPLIT CASE	900	60'	76%	17	20	1750	208/3ø	PR
COI F	NDENSATE RETURN PUMP CP-3	PACO / TYPE KP MODEL 5012-8 5"x6"x12"	AHU-1 PREHEAT	MECH. ROOM	DUPLEX	3	20PSI			1/2	1750	120/1ø	PR

BOIL	ER (STEA	M)									
DESIGNATION	REFERENCE	LOCATION	TYPE	ENERGY NPUT	ENERGY OUTPUT	STEAM RATE	PRESSURE	FVEL	BLOWE	R MOTOR D	ATA
				MEH	MBH	LB8/HR	PSIG		<b>M</b> P	VOLTB	PH
B-1	KEWANEE MODEL M505-KG	MECHANICAL ROOM	PACKAGED STEAM	6313	5050	5204	15PSIG	NATURAL GAS	5.0	208	

	BLOWER	COIL	UNIT	SCH	IEDU	ILE	******				
DESIG.	MFR/MDL	TYPE	CFM	OSA	ESP	FAN	DRIVE		ELECTR	ICAL DATA	REMA
		TIFE		USA		DIA.		HP	FLA .	VOLT/PHASE	
BC1	TRANE / TWE036C	MULTI POSITION	1,200		.40"	10"	DIRECT	1/2	3.3	208 / 1ø	PRO

	CONDEN	ISING	UNIT AN	ID CO	IL SC	CHEC	ULE			
		CONDEN	SING UNIT		COME	BINED RA	TING	ELECTRICA	NL.	DEMAR
DESig.	MFR/MDL	TYPE	OSA AMBIENT	SERVES	TOTAL	SENS	SST	VOLTS/PHASE	MCA	REMAR
CU1	TRANE / TTP036C	AIR COOLED	95	BC-1	35.2 MBH	23.6 MBH		208 / 1ø	25	

## FANCOIL UNIT SCHEDULE

FCU-1 TRANE / TWO-PIPE AND AND AND AND AND TH(MBH) BAT EWT LWT GPM WPD MBH WATTS VOLT/PHASE	DEN MARKO	'OR	MC			ЖL	ATER CO	EATING V	Н	•			ER COIL	LED WAT	CHIL					TYPE	MFR/MDL	DESIG.
FCU1 THRU TRANE / TWO-PIPE // VERTICAL 280 0" 80" D.B. 45" 55" 1.34 10.6" 6.5 4.9" 70" 180" 1.50" 1.30 7.4" IRON 120 (.14) PROVIDE INTEGRAL T. STAT. 1: FAN SPEED SWITCH	hemanks	LT/PHASE	\$ V	WATTS	MBH	WPD	GPM	LWT	EWT	EAT	SH(MBH)	TH(MBH)	WPD	GPM		EWT	EAT	ESP	CFM			
FCU-11 FCB 030 CABINET 20 67 W.B. 40 55 1.54 10.0 0.5 4.9 70 100 130 1.50 7.4 19.0 70 120 7 10 PROVIDE INTEGRAL 1-STAT & FAN SPEED SWITCH.	PROVIDE INTEGRAL T-STAT & FAN SPEED SWITCH.	120 / 1ø		70	19.0	7.4'	1.30	150°	180	70°	4.9	6.5		1.34	55*	45'	80° D.B. 67° W.B.	0"	280	VERTICAL	TRANE / FCB 030	FCU1 THRU FCU11

G

Н

\_

÷.

10-

11

- 6-

7

-

**`**27

\*\*

٠

	AIR DEVI	CE SC	HEDUL	E			5
DESIG.	MFR./MDL.	TYPE	FACE SIZE	FINISH	FREE AREA	ACCESS.	REMARKS
RA-1	TUTTLE & BAILEY / PR	PERF. FACE CEILING RETURN	AS NOTED	WHITE	51%		
- L-1	AMERICAN WRMNG. & VENT./ LE-33	INTAKE LOUVER	AS NOTED	PRIME COAT			

<b>I</b>	DUCTWORK	LEGEND	
	CEILING DIFFUSER		EXTRACTOR
	RETURN AIR GRILLE (RA)		MANUAL DAMPER
D	EXHAUST REGISTER (ER)		FIRE DAMPER AND ACCESS DOOR (SMOKE DAMPER S.D. SIMILAR)
624 CD-1 100 CFM	SIZE — DESIGNATION CUBIC FEET PER MINUTE	φ	DIAMETER
	FLEXIBLE DUCT CONNECTOR	Ŧ₅	THERMOSTAT (WITH UNIT NUMBER)
	TURNING VANES	$\begin{pmatrix} 1 \\ M-1 \end{pmatrix}$	)
	Splitter Damper (tee)	DETAIL 2 M-2 SECTION	TOP NUMBER REFERS TO THE DETAIL > NUMBER. BOTTOM NUMBER REFERS TO THE SHEET WHERE DETAIL IS SHOWN


.


													ī			ï
								· ·					·····			
<u>,</u>	<del>te mante e te na antene tene</del> n.							· ·								
			CHIL		TER COIL						QTEA	M COIL				T
LAT	MEH Total	MBH SENS.	EWT	LWT	GPM	W.P.D.	ROW/FIN	EAT	LAT	STEAM PRESS.	STEAM STEAM LB8/HR	MBH	ROW/FIN	FACE VELOCITY	APD	BH
53db 52.6wb	544.5	372.4	45	55	109	10.9	8 ROW 106FPF	60	100	5	564	542.2	1 ROW 64FPF			11.
	<b>.</b>	L			-	<u></u>	<b>.</b>		- <b>I</b>		1					<b>I</b>
FAN D	ATA															
SPEE	EDS VOI	LT/PH	REMARKS	·						CO	NTROL VALVE		BA	ALANCING VALV YPICAL)	Æ	
1	20	08/3ø	REFER TO P PROVIDE ACC	CESS DOOF	ANUAL; RWAY PLATF( 	DRM				MAN	ual air ven			NON (TYP)		
														HCHR		
														)LATION VALVE (PICAL)		
REMAR	KS													HCHS		
PROVIDE	osha drive	GUARD.	*********	****===,							DRAIN PAN					
PROVIDE	GP 15 GALL	.on cast 1	RON RECEIVE	r tank			*****									
					-											
1										1		NG DI				
						5					NT.S.					
ATA PHAGE	REMARKS	3: .										-	· ·			
3	GORDON PI/ CSD-1 AND SECONDARY LOW WATER TRIM. LEFT	ATT FULL M UL LISTED WATER CU CUTOFF, A HAND GAS	10DULATING F D, LIFTING EY 1TOFF M/M # ALARM SWITCH TRAIN	TRE BURNE ES, M/M # 51-5B2 W I, RIGHTHA	R ASSEMBL #150-M ATER FEEDE ND LOW WA	Y R, TER										
<u>_</u>										BY-P/	ass with		STEAM VALVE		•	×.
										GLOBE	ASS WITH			à c		
ARKS									GATE VALVE (TYP)		- AND - AND		$\square$	HEATIN	G	
	EANABLE FIL	LTER.							STRAINER I BLOW-DOW (TYP) F & T TRA	1	~~~ <u>w</u>	W 10		AIR FLOW		• • •
									UNION (TYF			N		LOW		
				<del></del>						*	A A		- DIRT POCKET	•		с. Ф.
ARKS					<u></u>						3	4	GLUDE VALVE		•	
										(3			<u>OIL</u> AGRAM			
	****										<u> </u>					
	<u></u>										1994 - 1994 - 1994 - 1994 - 1994 - 1994 - 1994 - 1994 - 1994 - 1994 - 1994 - 1994 - 1994 - 1994 - 1994 - 1994 -					· .


Κ


L


M

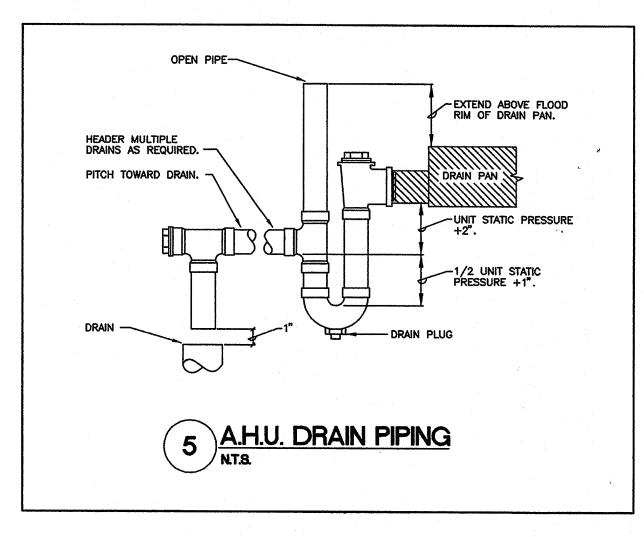


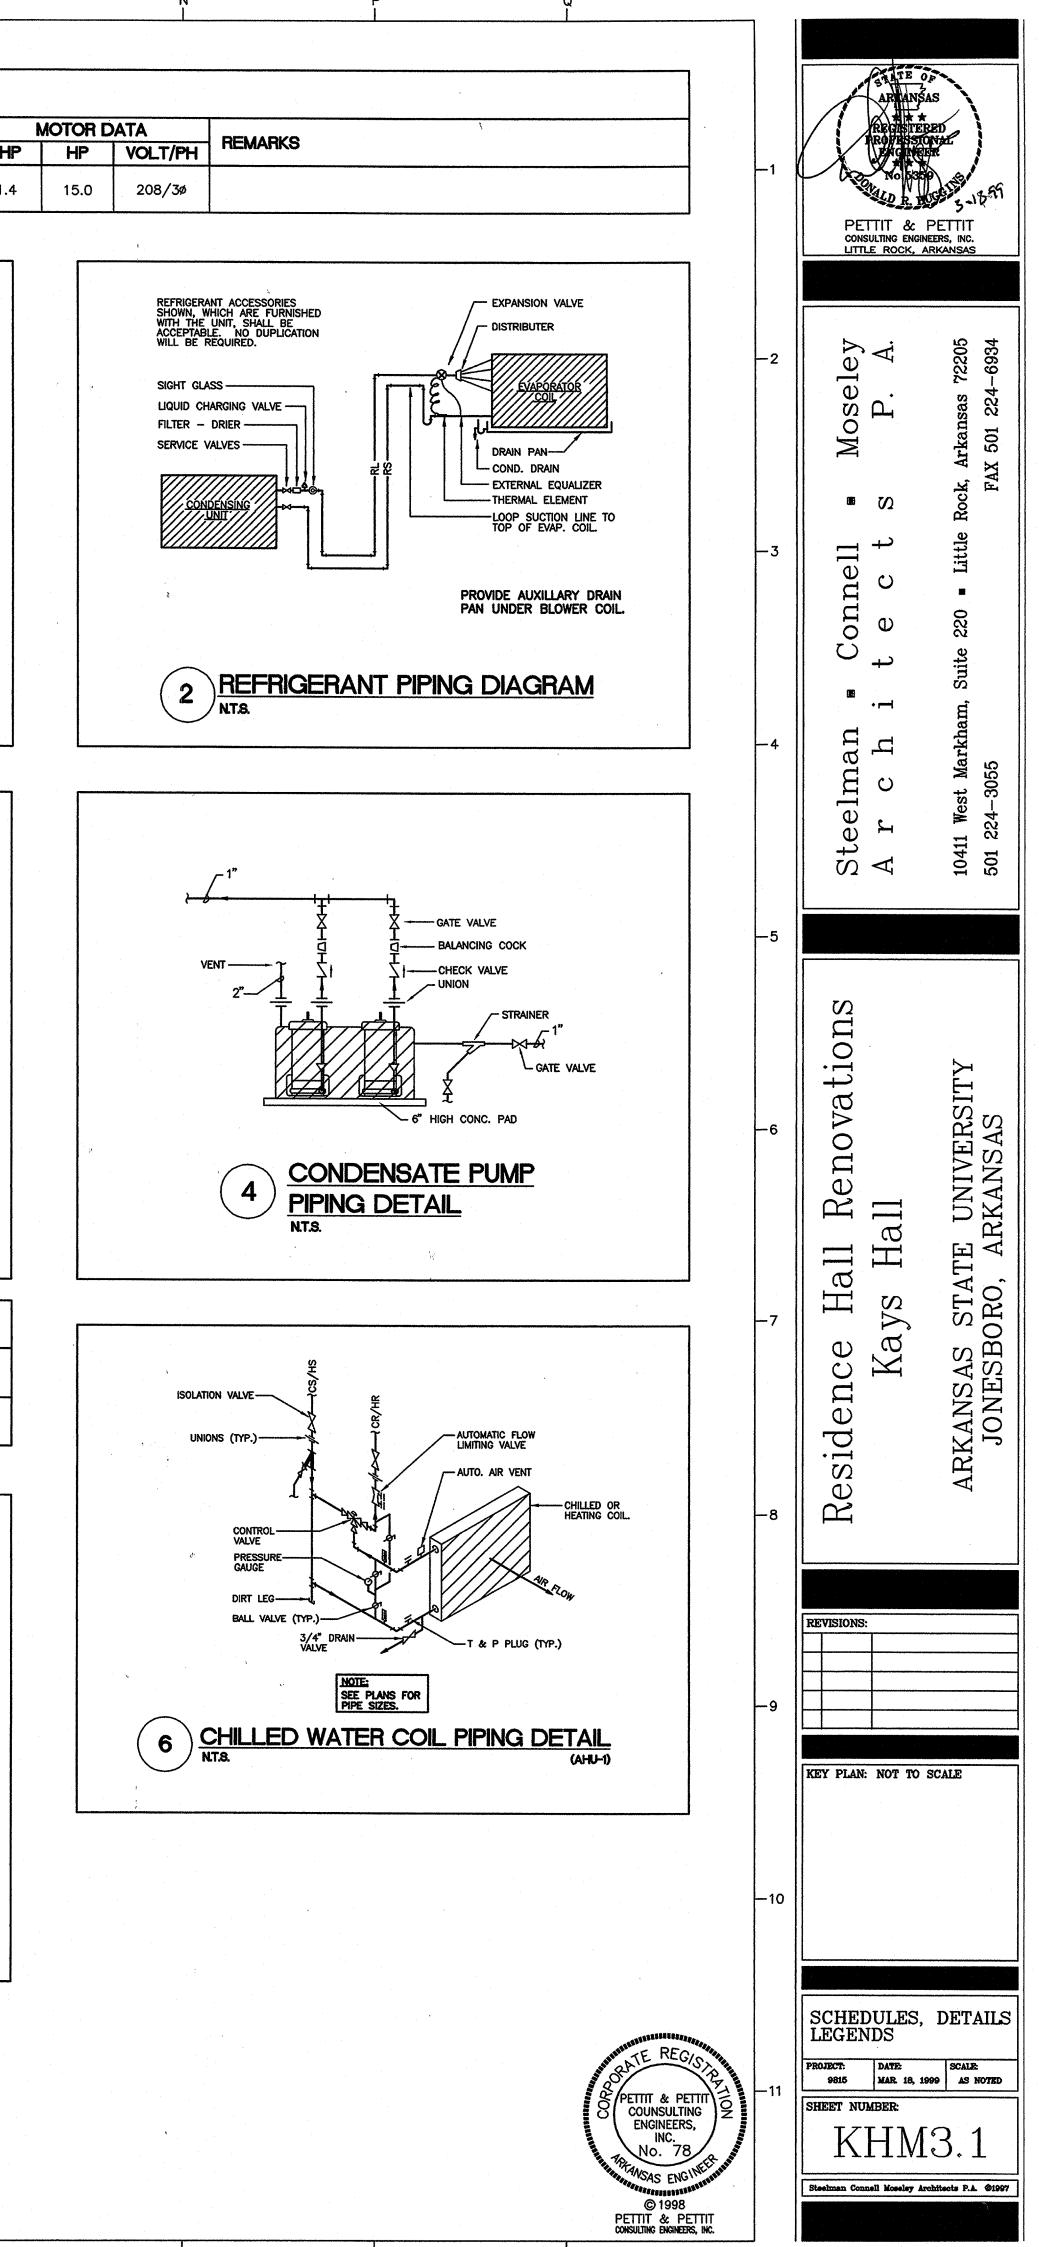

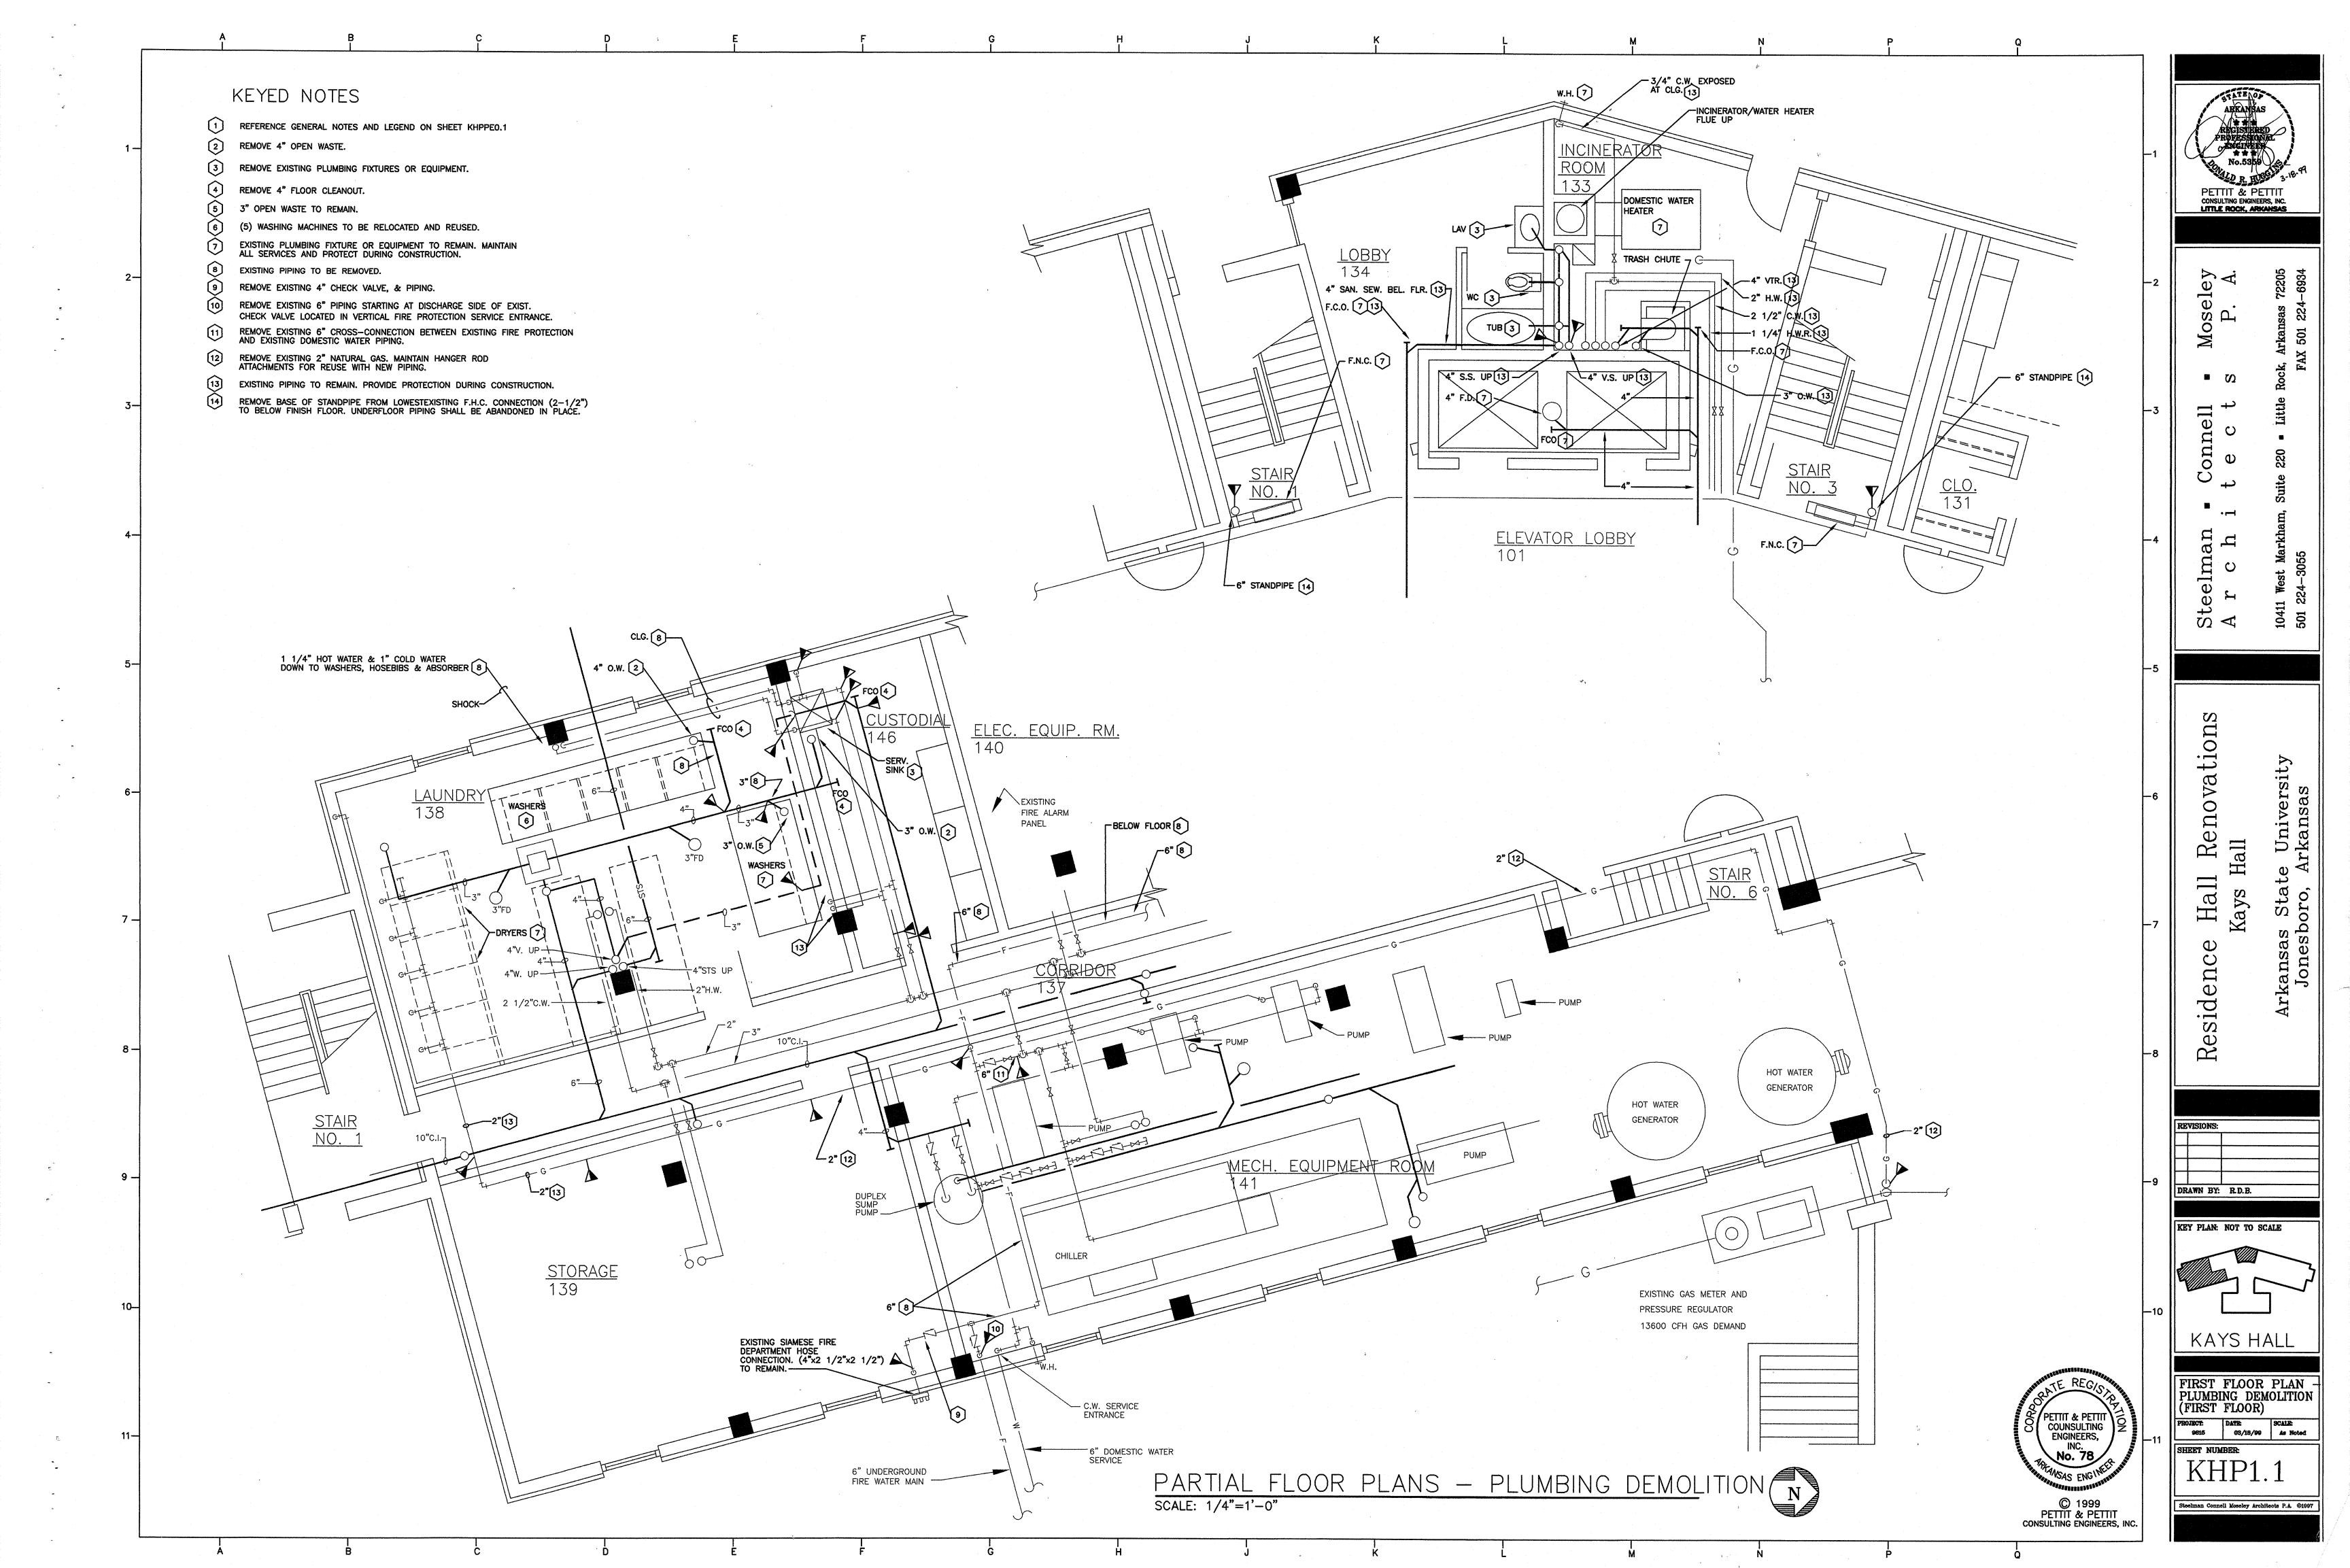

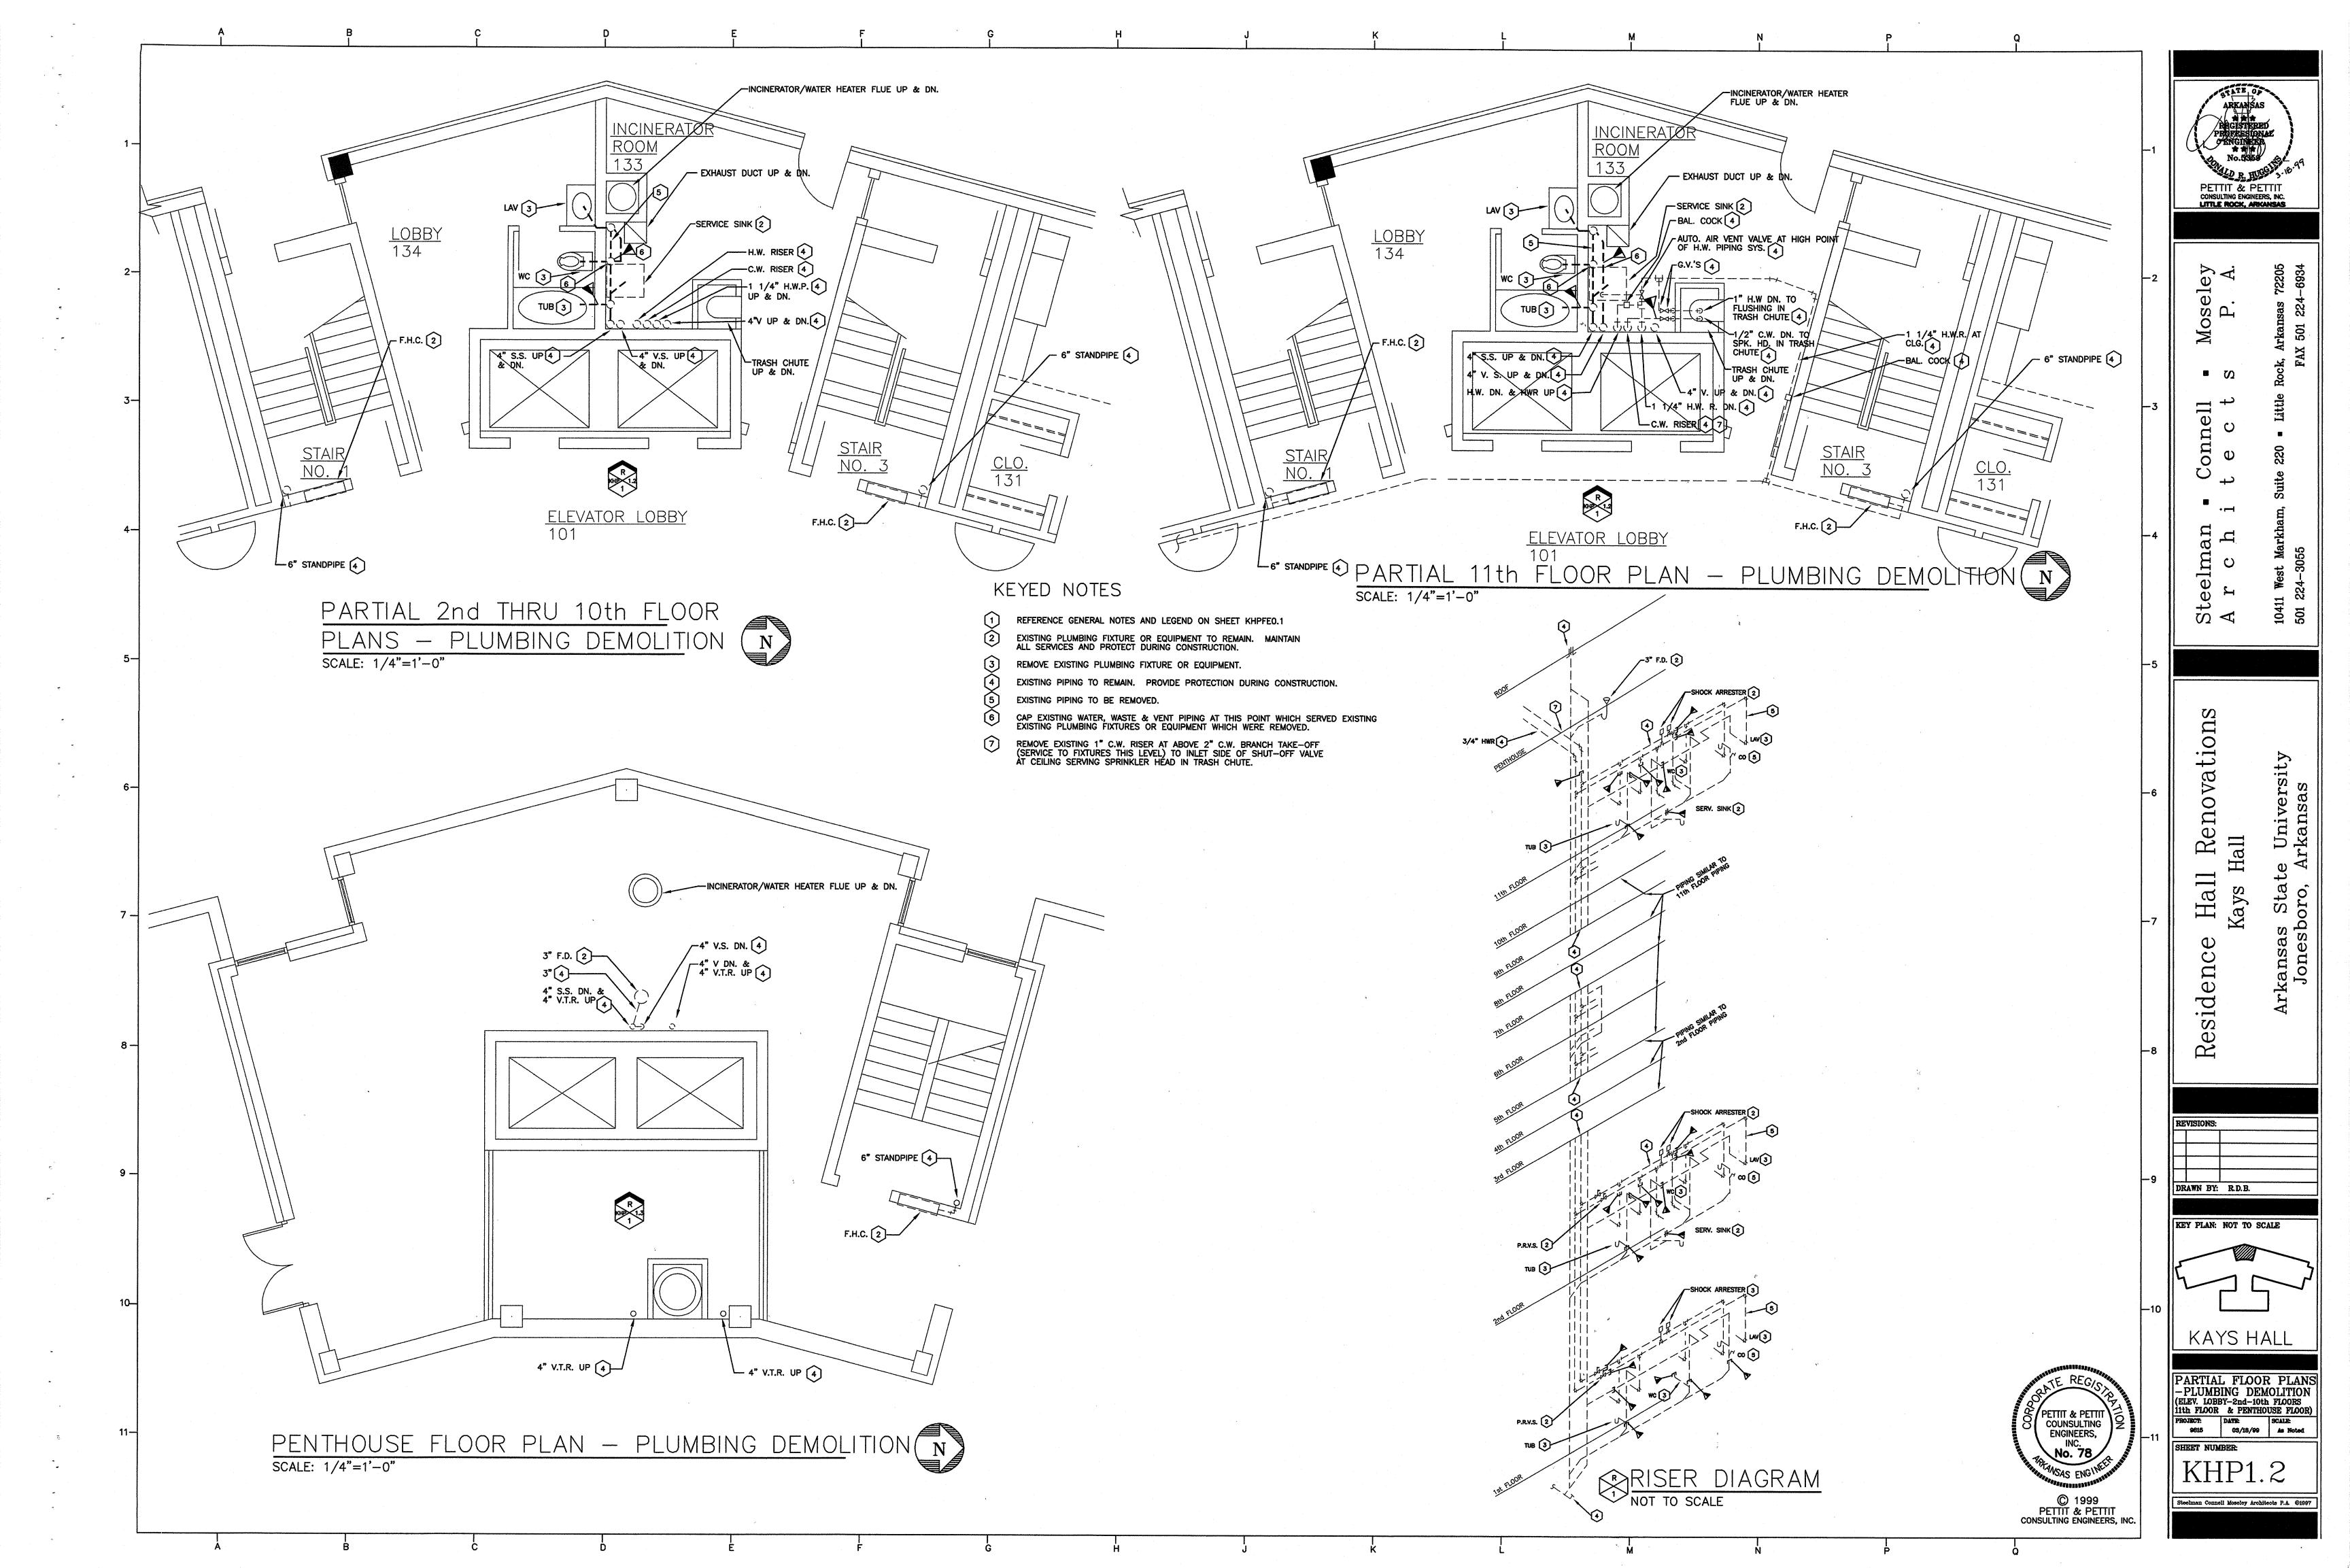


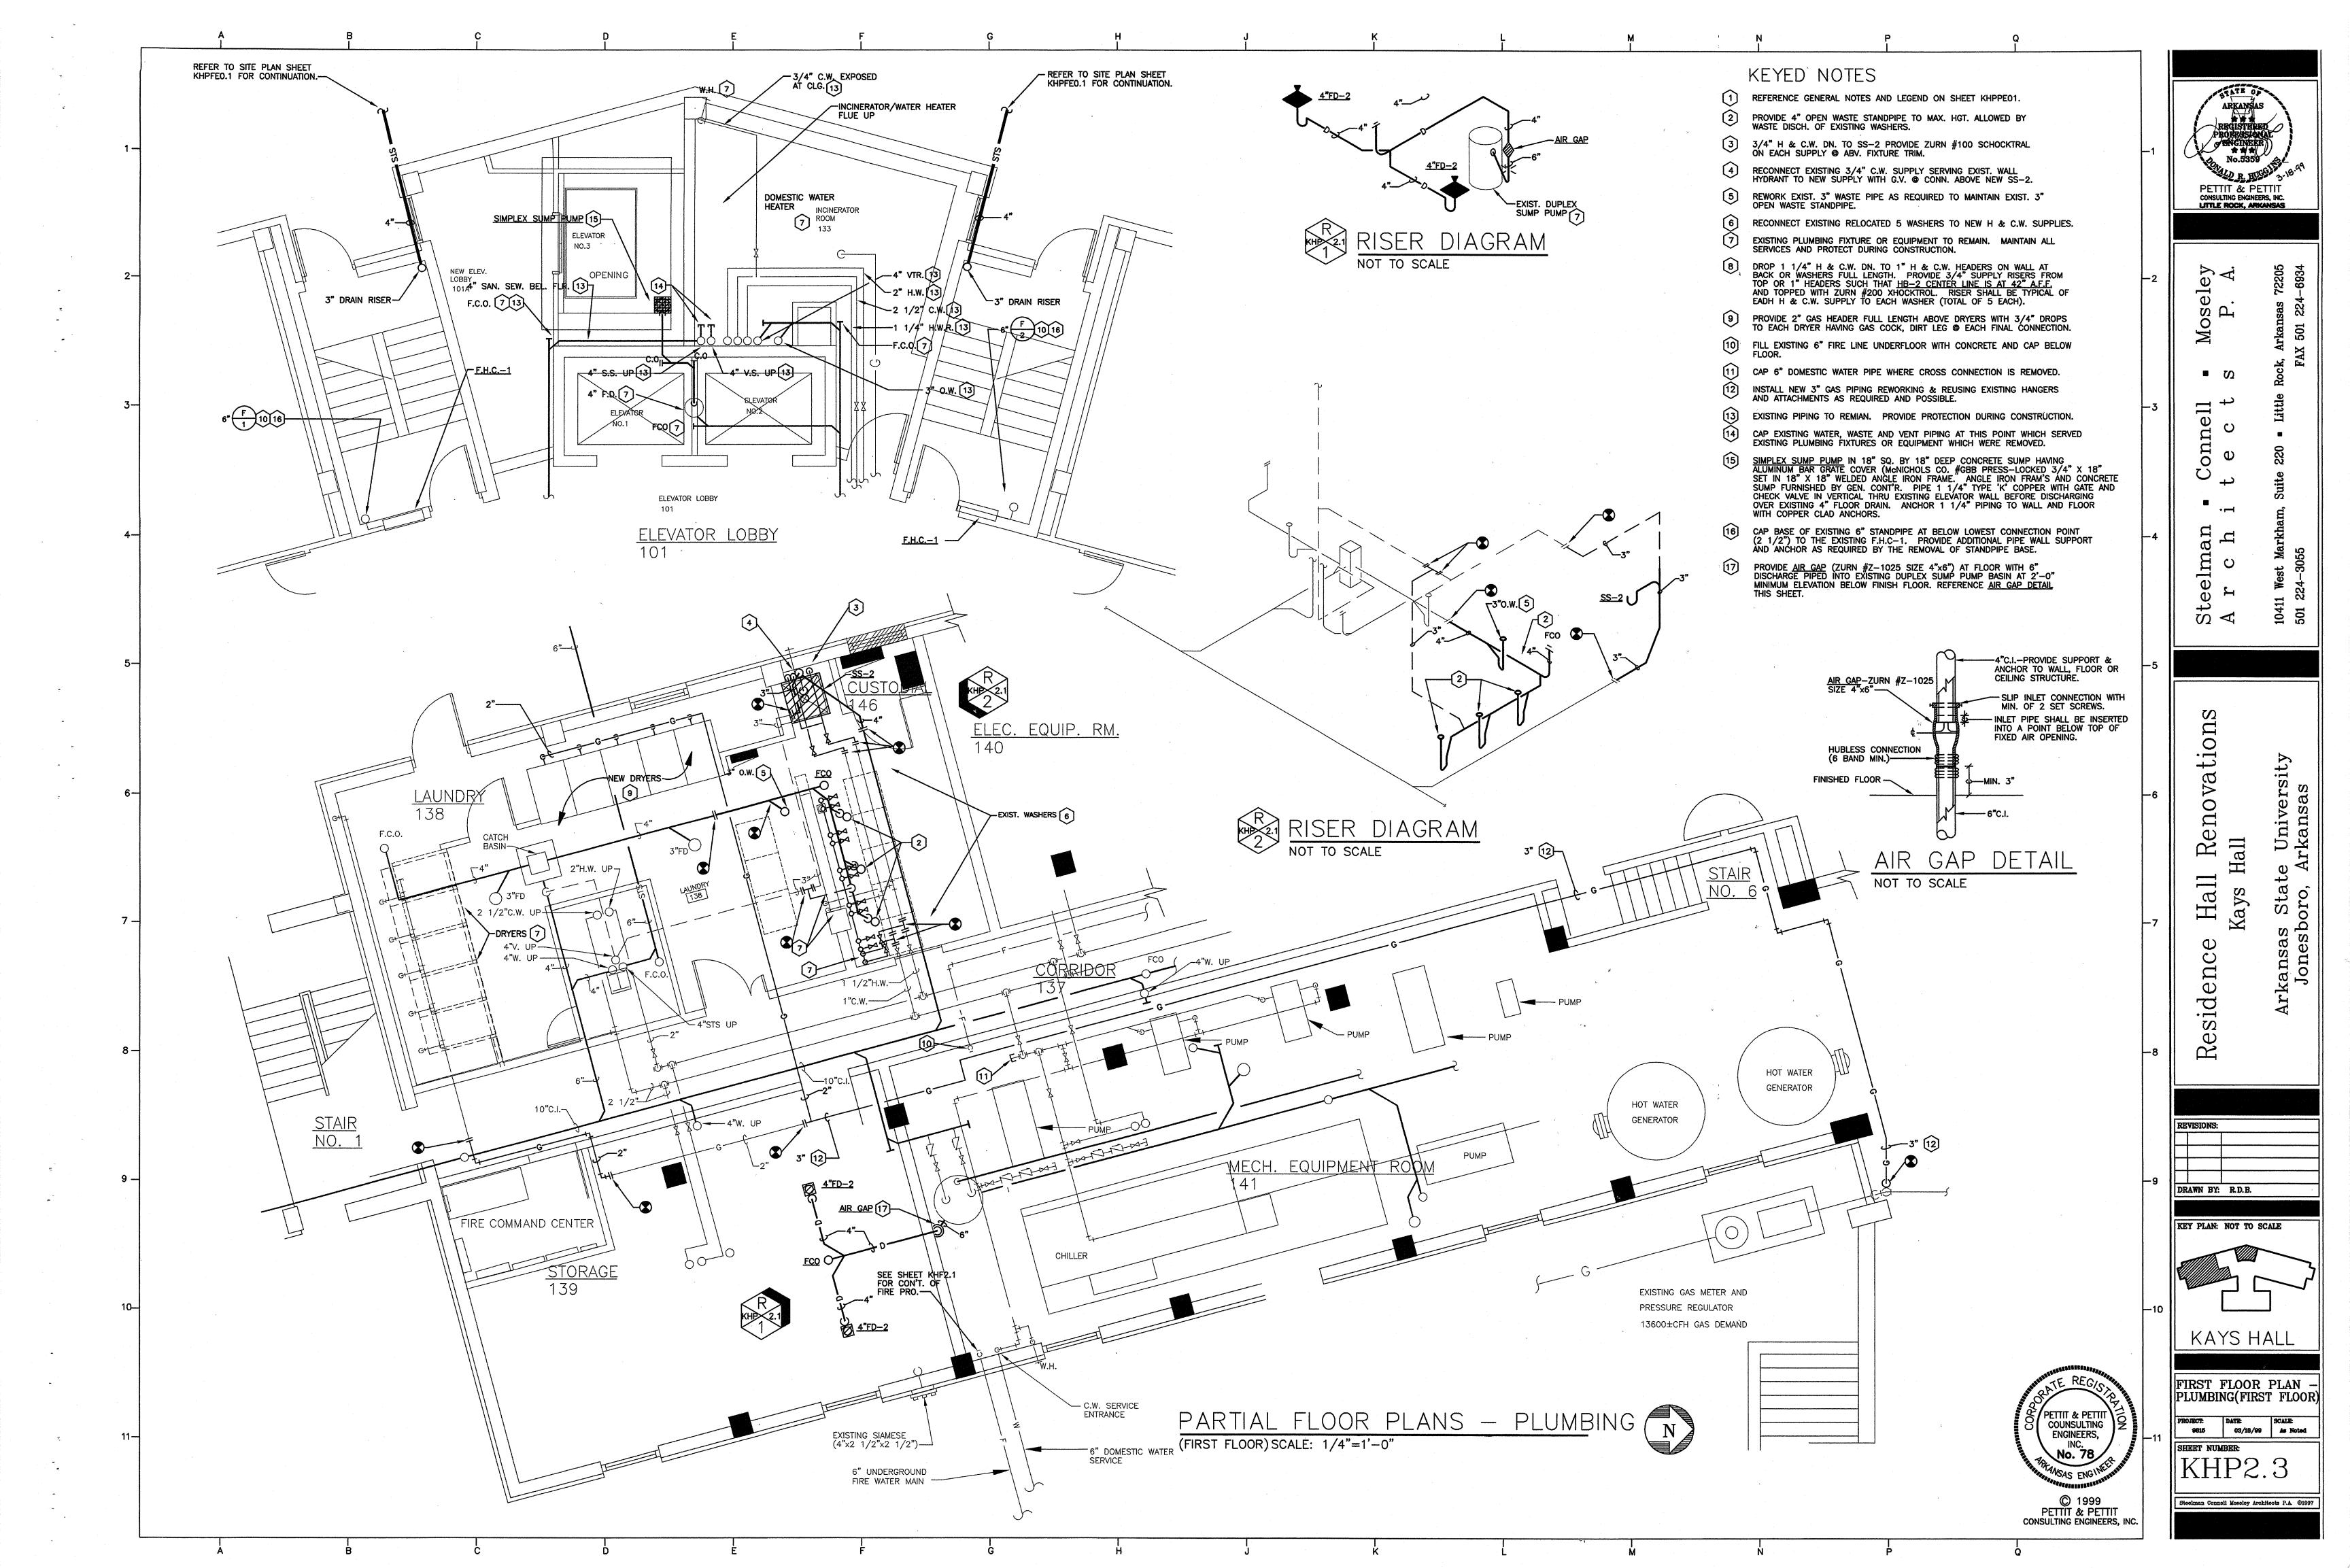

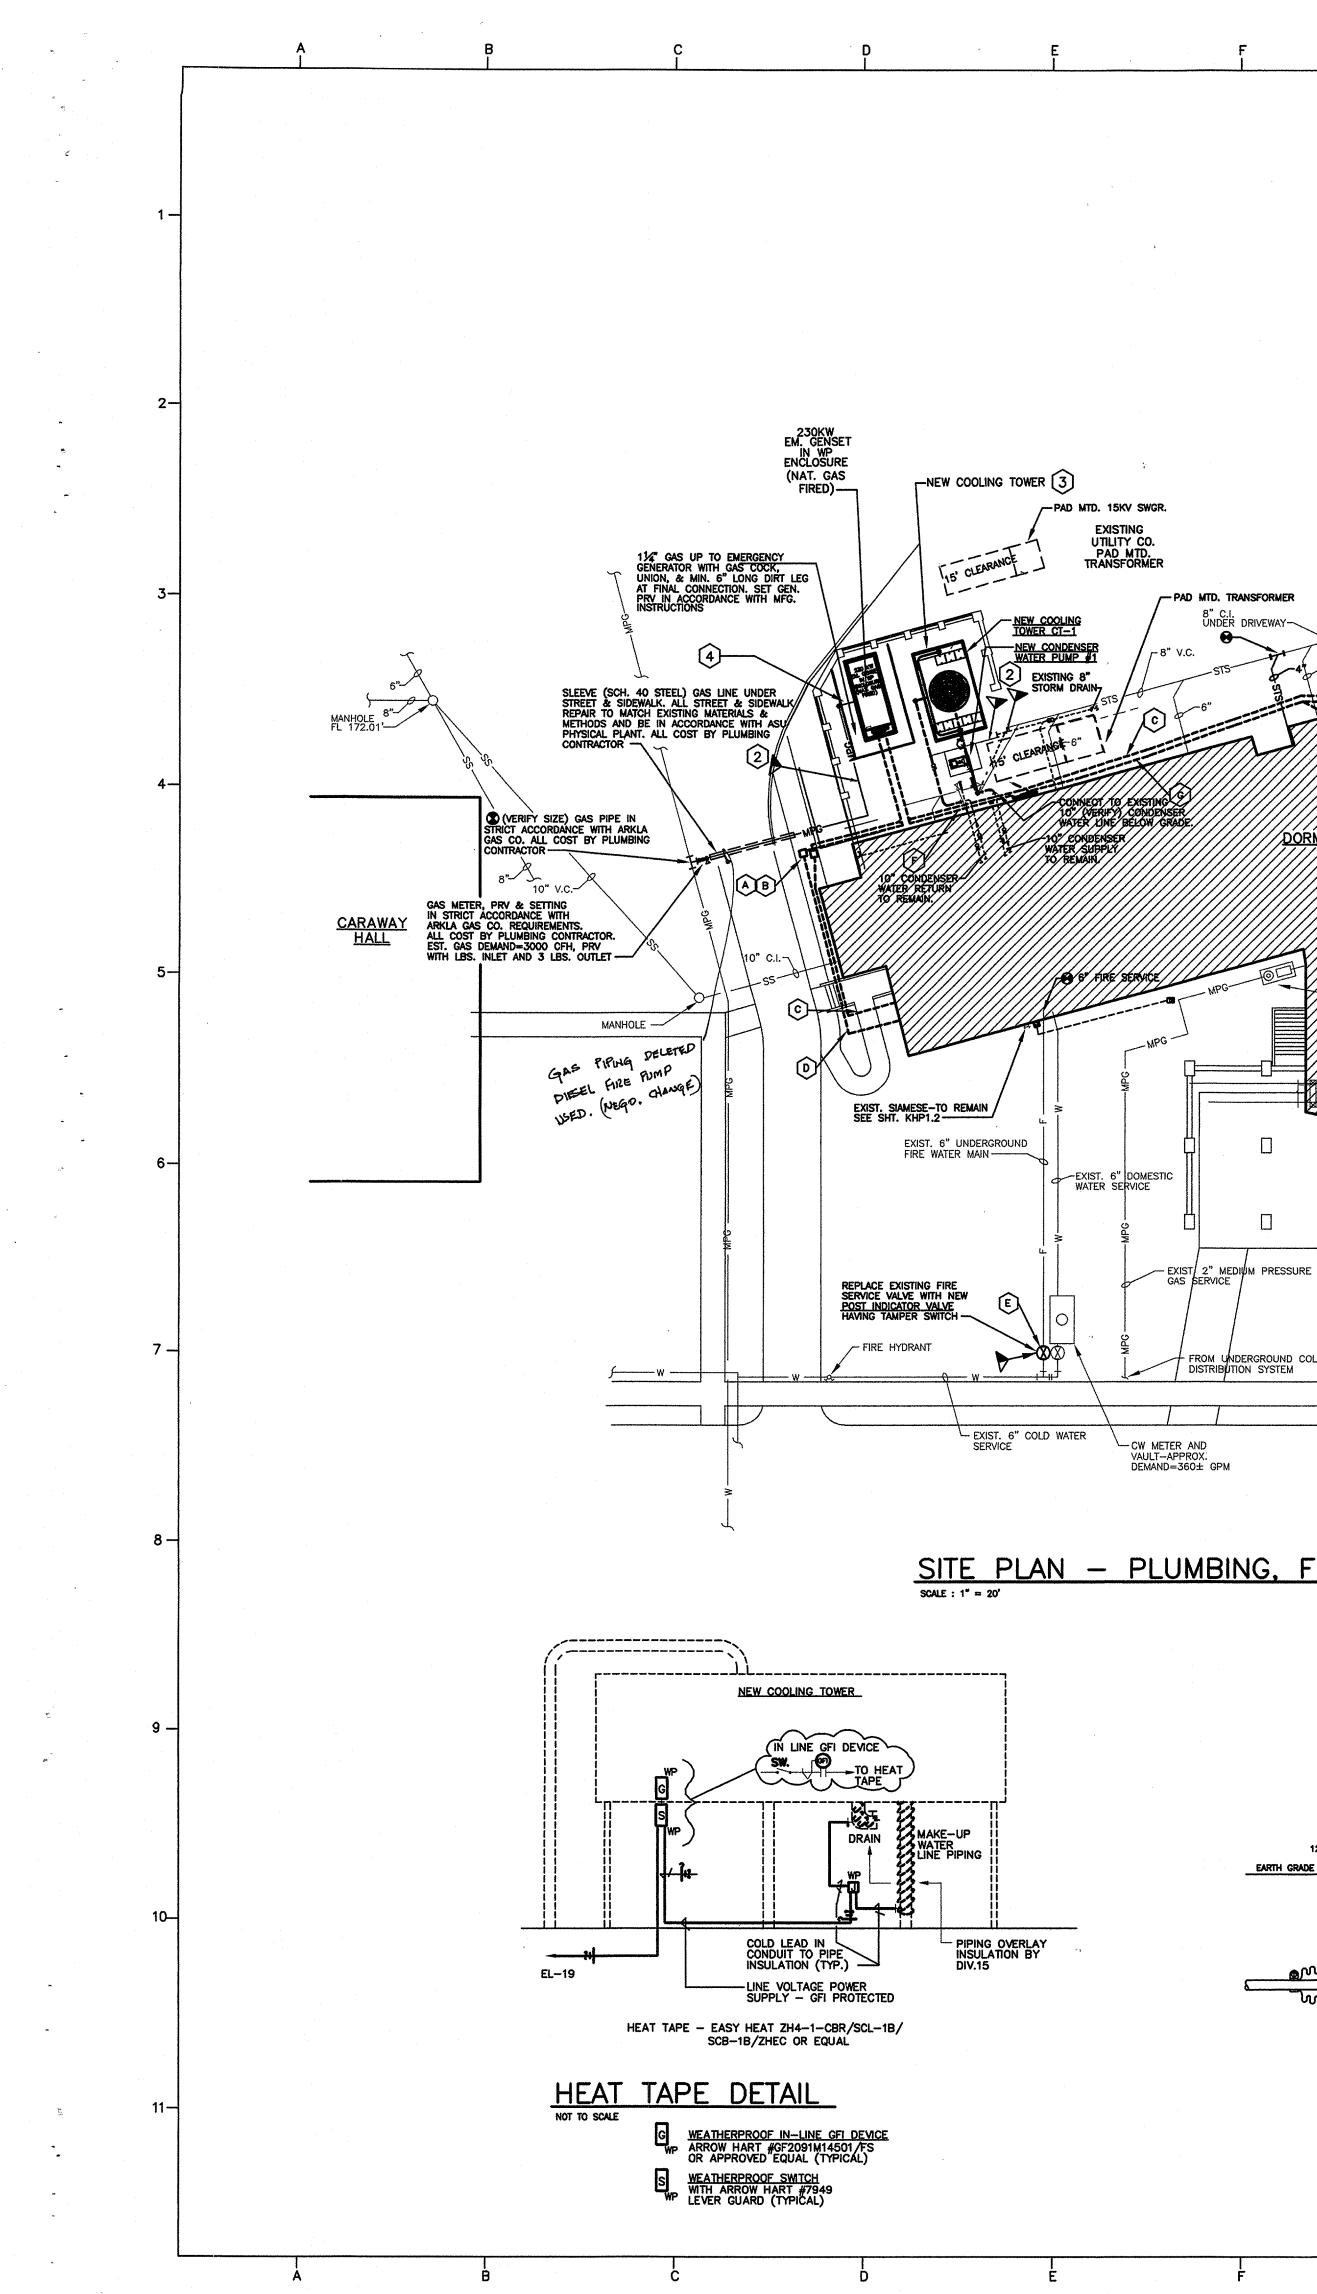


#### KEYED NO


- KEYED NOTES ELECTRICAL:
- B NEW U.G. PULLBOX FOR FIRE ALARM SYSTEM MAIN COMMUNICATIONS LINES (SEE SHT. KHE.1)
- C NEW U.G. FIRE ALARM SYSTEM MAIN COMMUNICATIONS LINES (SEE SHT. KHE.1)
- D NEW U.G. FIRE PUMP EMERGENCY POWER CIRCUIT (SEE SHT. KHE.1)
- E 2-#12, 3/4"C TO IAM IN FIRE PUMP ROOM (SEE SHT KHE.1) FOR DIV. 15 TAMPERSWITCH ON POST INDICATOR VALVE

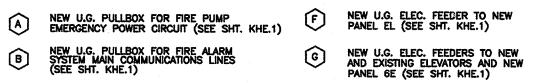

# - STORM DRAIN LINE INTO DITCH - PAD MTD. TRANSFORMER UNDER DRIVEWAY 8" C.I. UNDER DRIVEWAY ~10" V.C DORMITORY FOR WOMEN EXISTING GAS METER AND PRESSURE REGULATOR APPROX. 13600±CFH GAS DEMAND

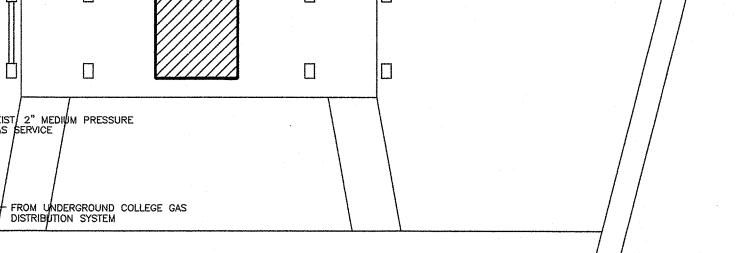


# SITE PLAN - PLUMBING, FIRE PROTECTION & ELECTRICAL

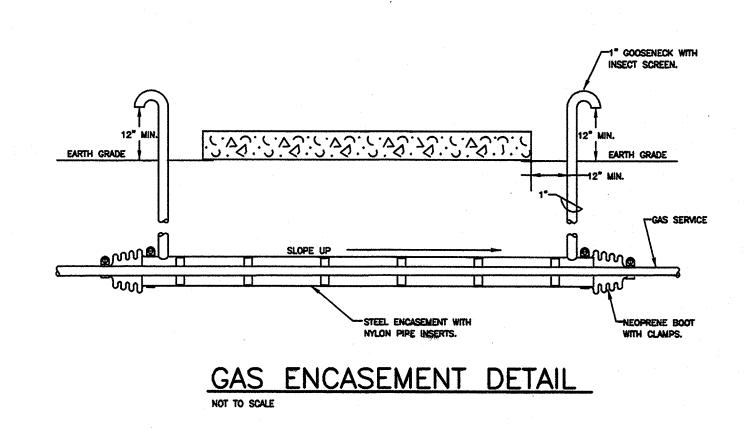


## PLUMBING AND FIRE PROTECTION. GENERAL NOTES


- 1. THE CONTRACTOR SHALL, <u>PRIOR TO THE START OF ANY WORK UNI</u> <u>THIS CONTRACT</u>, JOB SITE VERIFY SIZE, ELEVATION, LOCATION, ETC ANY EXISTING PIPING NOTED, SHOWN, OR IMPLIED, TO WHICH NEV PIPING IS RELATED OR CONNECTED.
- 2. HOT AND COLD WATER SUPPLIES TO FIXTURES SHALL BE AS FOLL UNLESS SHOWN OR NOTED OTHERWISE:
- ALL SUPPLIES TO FIXTURE SHALL BE PROVIDED WITH A HIGH EAR COUPLING EQUAL TO MUELLER NO. C-100HE (1/2", 3/4", OR 1 THE WALL (ANCHORED TO CROSS-MEMBER SUPPORT) BEFORE PI ENTERS ROOM SPACE TO ASSURE NO PIPE MOVEMENT WITHIN W CAVITY.
- 4. PROVIDE AIR CHAMBERS ON ALL HOT AND COLD WATER SUPPLIES, AND FOR EACH FIXTURE, THE SAME DIAMETER AS THE SUPPLY AN LONG. SEE GENERAL NOTE NO. 2.
- 5. ALL VENTS THROUGH ROOF SHALL BE PROVIDED WITH 6# LEAD FLASHING.
- 6. PROVIDE GAS COCK, UNION AND MIN. 6" LONG DIRT LEG AT FINAL CONNECTIONS TO EQUIPMENT.
- 7. ALL FLOOR DRAINS SHALL BE PROVIDED WITH DEEP-SEAL TYPE WITH NOT LESS THAN FOUR-INCH (4") WATER SEAL.
- 8. CUT WALLS, FLOORS, OR CEILINGS AS REQUIRED TO INSTALL NEW PIPING. ALL FURRING AND REPAIRING SHALL BE BY THE GENER CONTRACTOR. COORDINATE REQUIREMENTS WITH THE GENERAL CONTRACTOR.
- 9. REWORK EXISTING WATER, SANITARY, AND VENT PIPING AS REQUIR INSTALL NEW PLUMBING FIXTURES.
- 10. WHERE EXISTING FIXTURES AND EQUIPMENT ARE REMOVED AND NO REPLACED, CAP ALL PIPING WITHIN WALLS, FLOORS, OR CEILING REQUIRED FOR CONCEALMENT.
- 11. REMOVE ALL EXPOSED EXISTING PIPING (INCLUDING ATTIC AND CRA WHICH IS DEEMED INOPREABLE AS A RESULT OF THIS CONTRACT SHOWN OR NOTED OTHERWISE.
- 12. EXISTING PIPE, TO WHICH NEW PIPE IS CONNECTED, SHALL BE ROL FLUSHED, AND CLEANED FROM POINT OF CONNECTION TO MAIN OUTSIDE BUILDING.
- 13. CLOSE COORDINATION AND COOPERATION SHALL BE MAINTAINED BETWEEN TRADES WITH REGARD TO PLUMBING, HVAC, AND ELECTR PLANS.

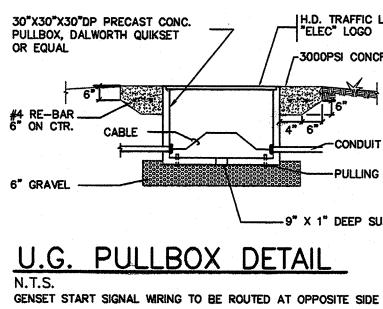


•

M 1	· · · · · · · · · · · · · · · · · · ·	N P	Q				
				SINII OF		STAFE OF	*
TES-I	PLUME	<u>BING &amp; FIRE F</u>	PROTECTION	ARKANSAS	5	ARKANŠAS	3
1 REFER	RENCE PLUMB	NG AND FIRE PROTECTION GENER	AL	PROPESSIONAL		PROFESSION	
NOTES	S & LEGEND	AS SHOWN ON THIS SHEET.		No.4781	—1	No.5859	
FOR (	COMPLETE EXT	DEMOLITION PLANS, SHEET KHM1.2 TENT OF DEMOLITION REQUIRED FOR	2, OR	NAVE LE BUILT	2	NALD R. HU	3-18-99
	ING COOLING	PARTIAL PLANS, SHEET KHM2.3, F	0P	PETTIT & PETTIT CONSULTING ENGINEERS, INC. LITTLE ROCK, ARKANSAS		PETTIT & PE Consulting Enginee LITTLE ROCK, ARK	
💛 сомр	LETE EXTENT	OF REWORKING DRAINS & COLD	WATER	LITTLE ROCK, ARKANSAS			
•		GAS TO EMERGENCY GENERATOR N AND 6" DIRT LEG.	WITH				
GAS (	COCK, UNION	AND 6" DIRT LEG.					<b>15</b>
	. · · · ·				-2	P. P	72205 -6934
						ы м Ч	
	te state and				ĸ	Mose P.	Arkansas X 501 224
						■ 02	Rock, FA
		ð.			-3	ell -	Little
	-			<b></b>		C U	
		PLUMBING				e	220
	FII	RE PROTECTIO	N LEGEND			L C	Suite
IDER	SYMBOL	DESCRIPTION	REMARKS				
C. OF W		COLD, HOT & HOT WATER RETURN PIPING				·	than
Lows,	<u>A_G_</u> <u>A_G_</u> <u>SS_STS_D_</u>	GAS, AIR & VACUUM PIPING INDIRECT DRAIN, STORM SEWER & SANITARY SEWER PIPING			-4	h	West Markham, 24—3055
	<u> </u>	FIRE PROTECTION & SPRINKLER PIPING	PIPING ABOVE FLOOR			teelm r c	st Ma -3055
		RECESSED AND CONCEALED SPRINKLER HEADS PENDANT, UPRIGHT & SIDEWALL SPRINKLER HEADS	UNLESS SHOWN OR NOTED OTHERWISE			r e	4.6
" SIZE) AT		VENT PIPING				A	10411 501 2
PE	SS	SANITARY SEWER (WASTE) PIPING STORM SEWER PIPING	-				
, то	D	Indirect drain piping	GRADE UNLESS SHOWN OR		-5		
ND 12"	W	DOMESTIC WATER PIPING	Noted otherwise				•
	X	designated piping (c.w., h.w.r. g.a.v, etc.) Shut-off valve	gate valve unless noted otherwise				
	[]	GAS COCK	UNLESS NOTED OTHERWISE			US	•
	II C.W.	UNION COLD WATER				[0]	
RAP	H.W	HOT WATER				ti	ity
	H.W.R.	HOT WATER RETURN GATE VALVE			-6	Renovations all	University kansas
	F.H.C.	FIRE HOSE CABINET					vers Isas
ED TO	P.R.V.	PRESSURE REDUCING VALVE CLEANOUT EXOPSED	Side of pipe rise or end of pipe run			l l	Univ kan
OT	C.O.T.G. 0	cleanout to grade	SEE DETAIL			Rt Hall	State U oro, Ark
AS	F.C.O. 0	FLOOR CLEANOUT					ate, /
AWL SPACE) UNLESS	V.T.R. O	vent thru roof	SEE GENERAL NOTES			Hall Kays	Sta
ODDED,		SHUT-OFF VALVE IN BOX FIRE PROTECTION SYSTEM	1		-7	Ke	$\circ$
		STANDPIPE RISER NUMBER				Ge	sa: les
RICAL	P 3	riser dugram Location sheet number				nc	ansas Sta Jonesboro,
		riser diagram number Partial, plan				esidenc	Arkansas Jonesł
		LOCATION SHEET NUMBER				sic	A
		PARTIAL PLAN NUMBER CONNECT TO EXISTING					
		START OR STOP POINT OF DEMOLITION			-8	L L L L	
	,						
		DRAIN SCHE					
	· · · · · · · · · · · · · · · · · · ·					REVISIONS:	
	SYMBOL	MANUFACTURER AND MODEL					
	FD-1	ZURN #ZN-415B HAVING 6"SQ. N.B. STR	AINER		9		
	FD-2	ZURN #ZN-415E HAVING 6"Ø N.B. STRAH	NER & INTEGRAL FUNNEL		-	DRAWN BY: R.D.B.	
LID WITH			******			KEY PLAN: NOT TO S	CALE
RETE							
•			с <sup>1</sup>			F W	
					—10		
EYES (4 TOTA	L) ,					KAYS H	
UMP							/ \ L L
			کم	TE REGIO		SITE PLAN –	
OF BOX			A STATE	RA LE UN REAL		PLUMBING, ELE & FIRE PROTEC	CTRICAL
			O O O O O O O O O O O O O O O O O O O	PETTIT & PETTIT COUNSULTING ENCINEERS		PROJECT: DATE:	SCALE
				ENGINEERS, INC.	-11	9615 03/18/99 SHEET NUMBER:	As Noted
			AT A A A A A A A A A A A A A A A A A A	PETTIT & PETTIT COUNSULTING ENGINEERS, INC. No. 78		KHPF	F.O. 1
				All the second s			
			CON	© 1999 PETTIT & PETTIT		Steelman Connell Moseley Arol	hiteots P.A. ©1997

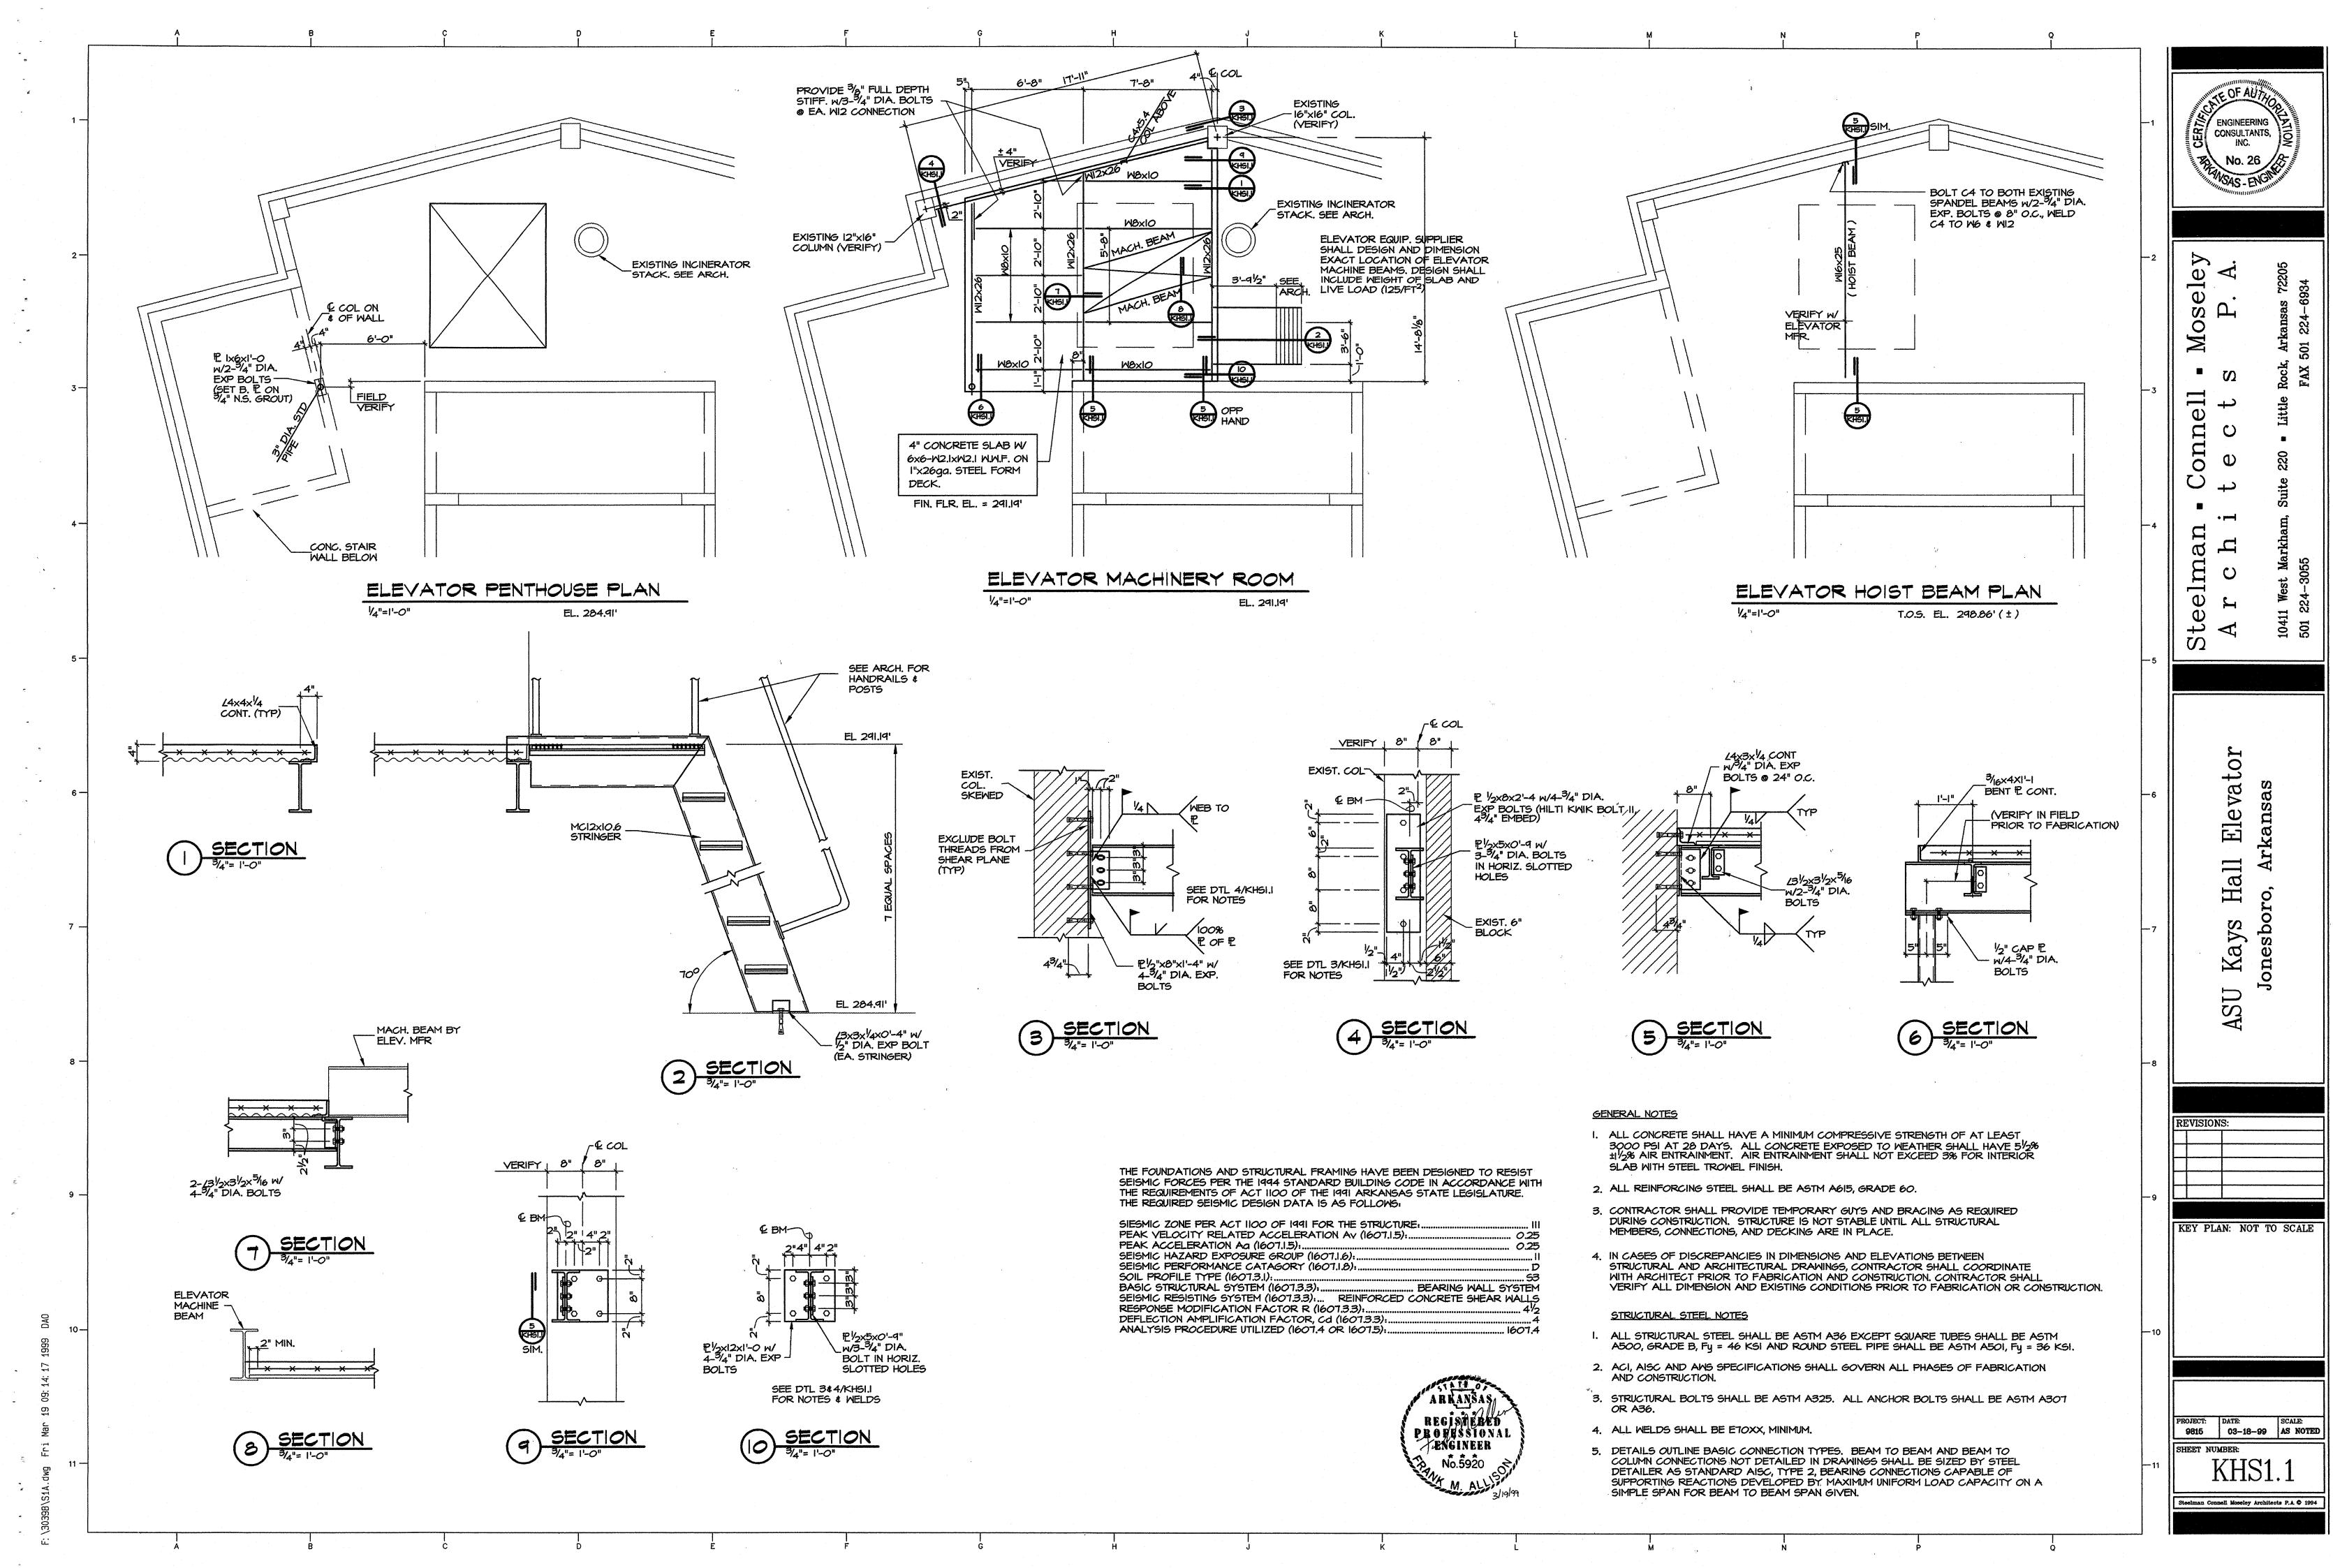

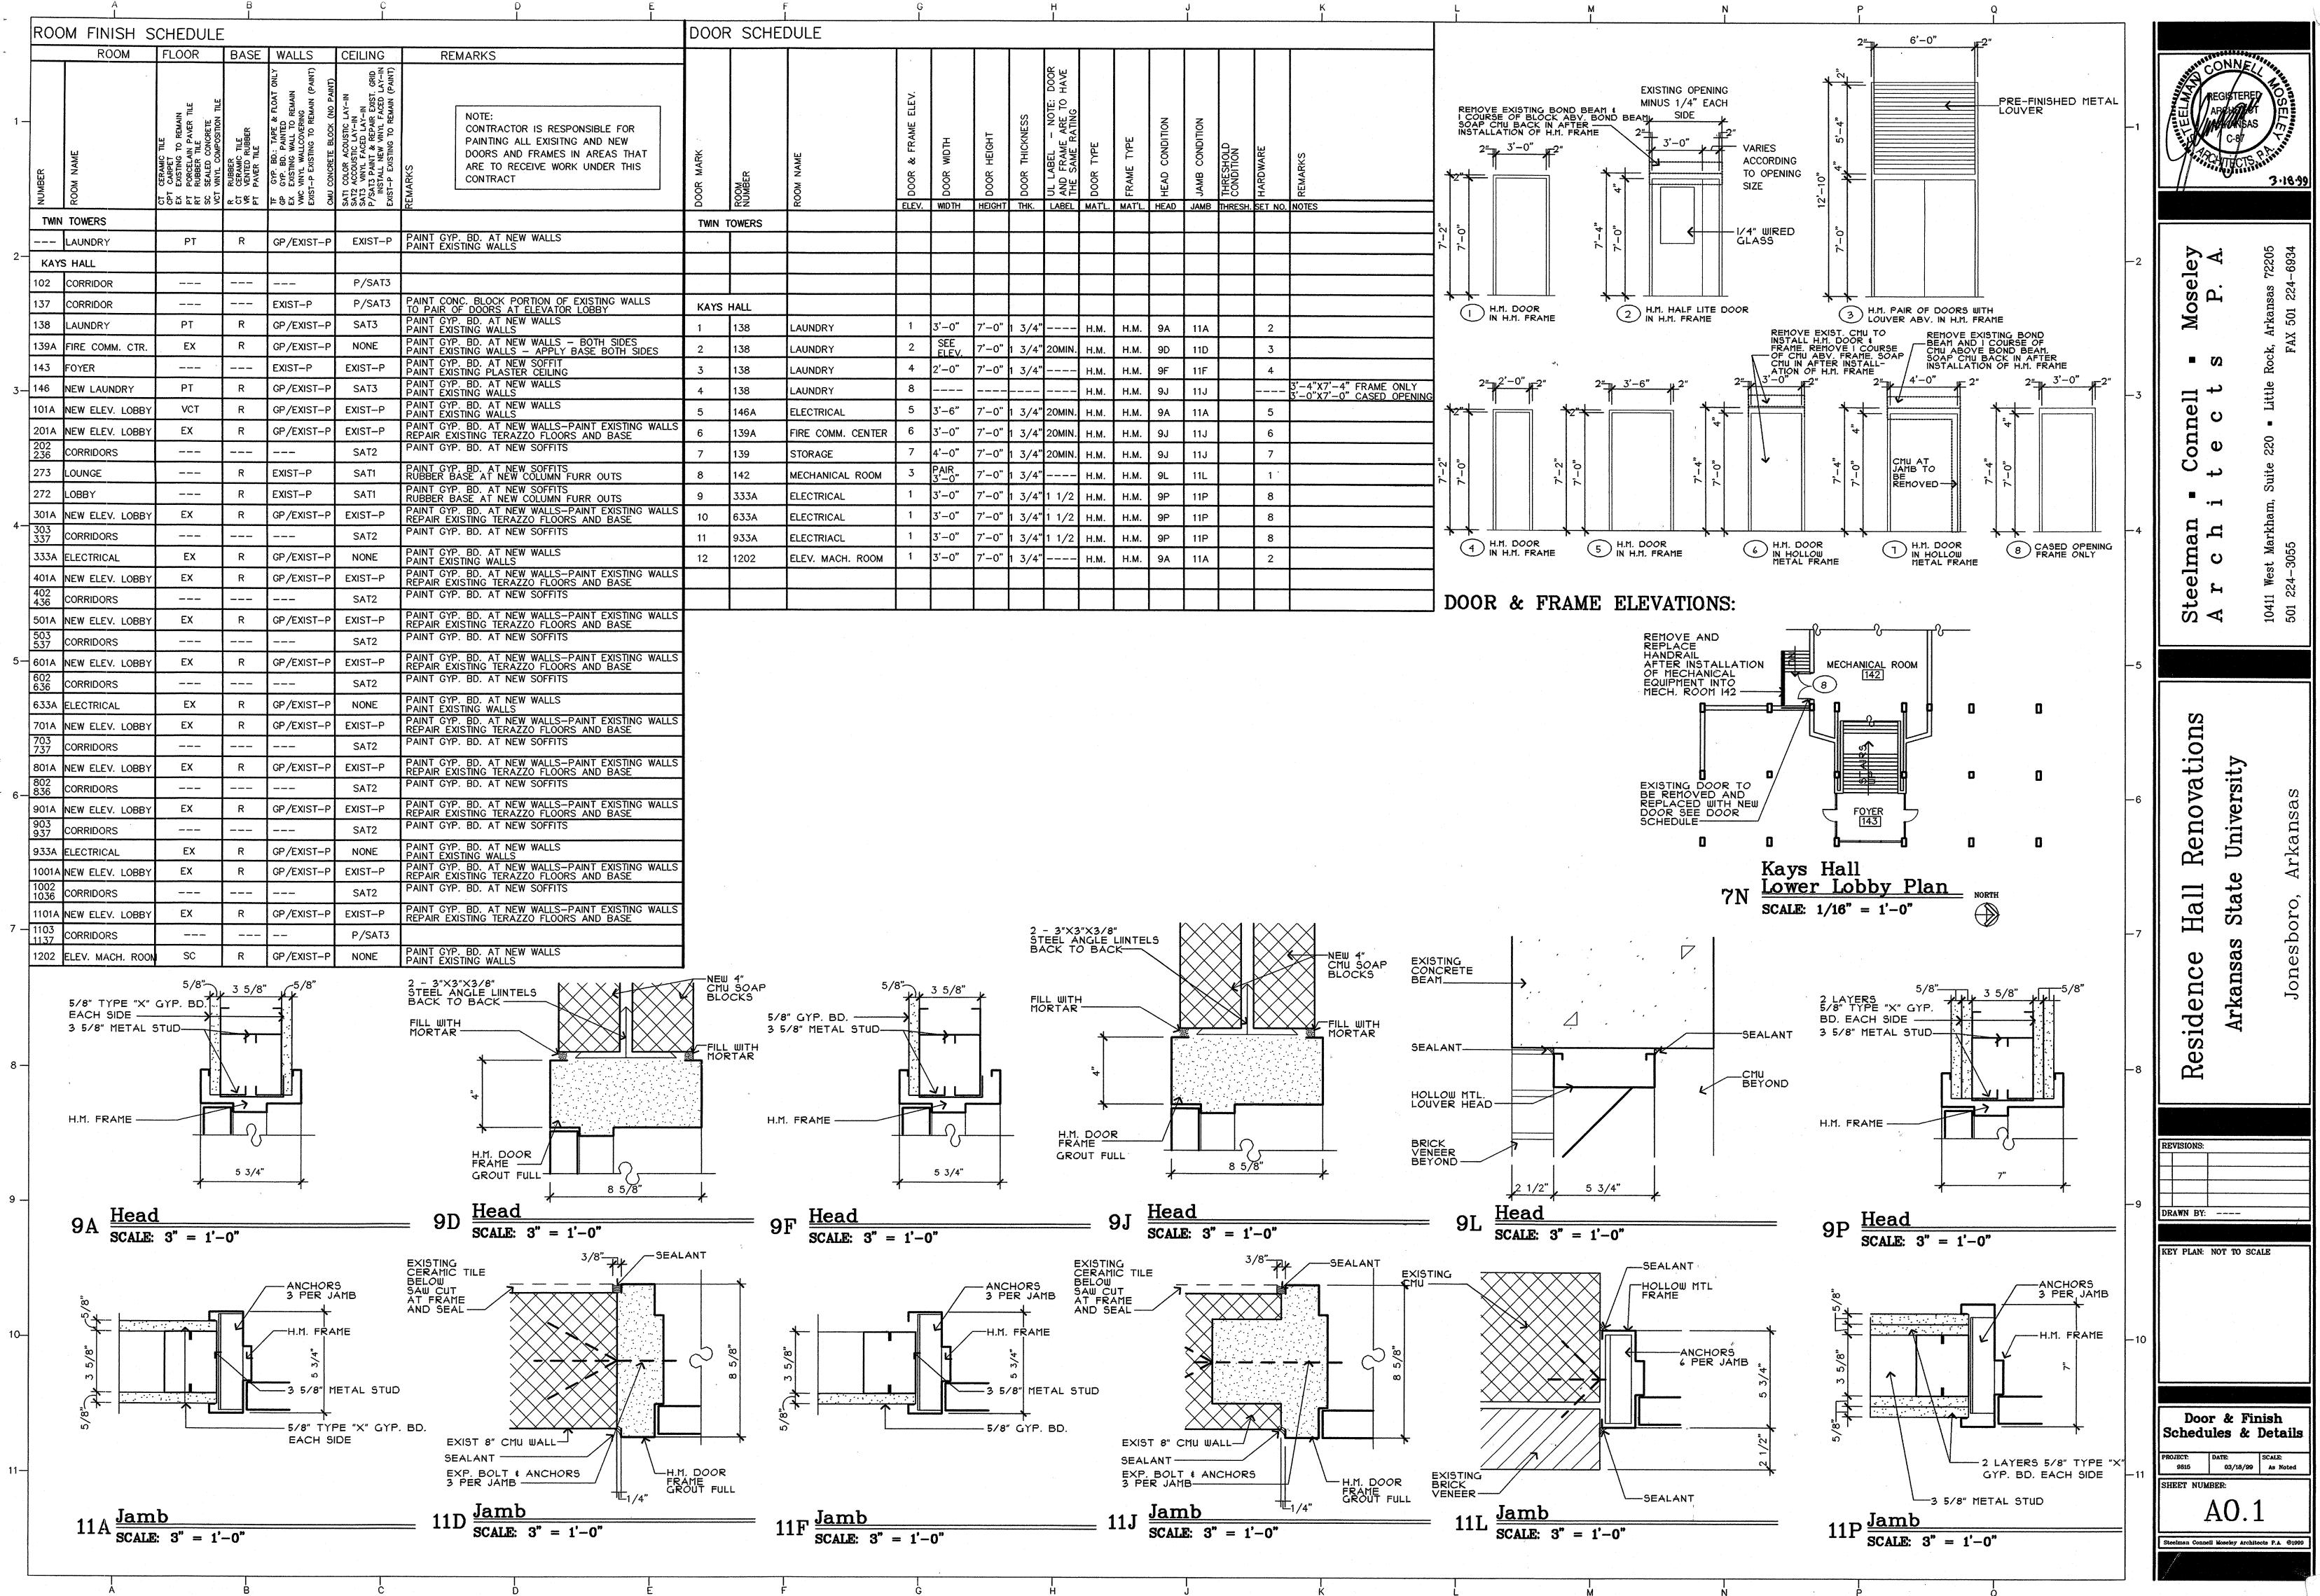

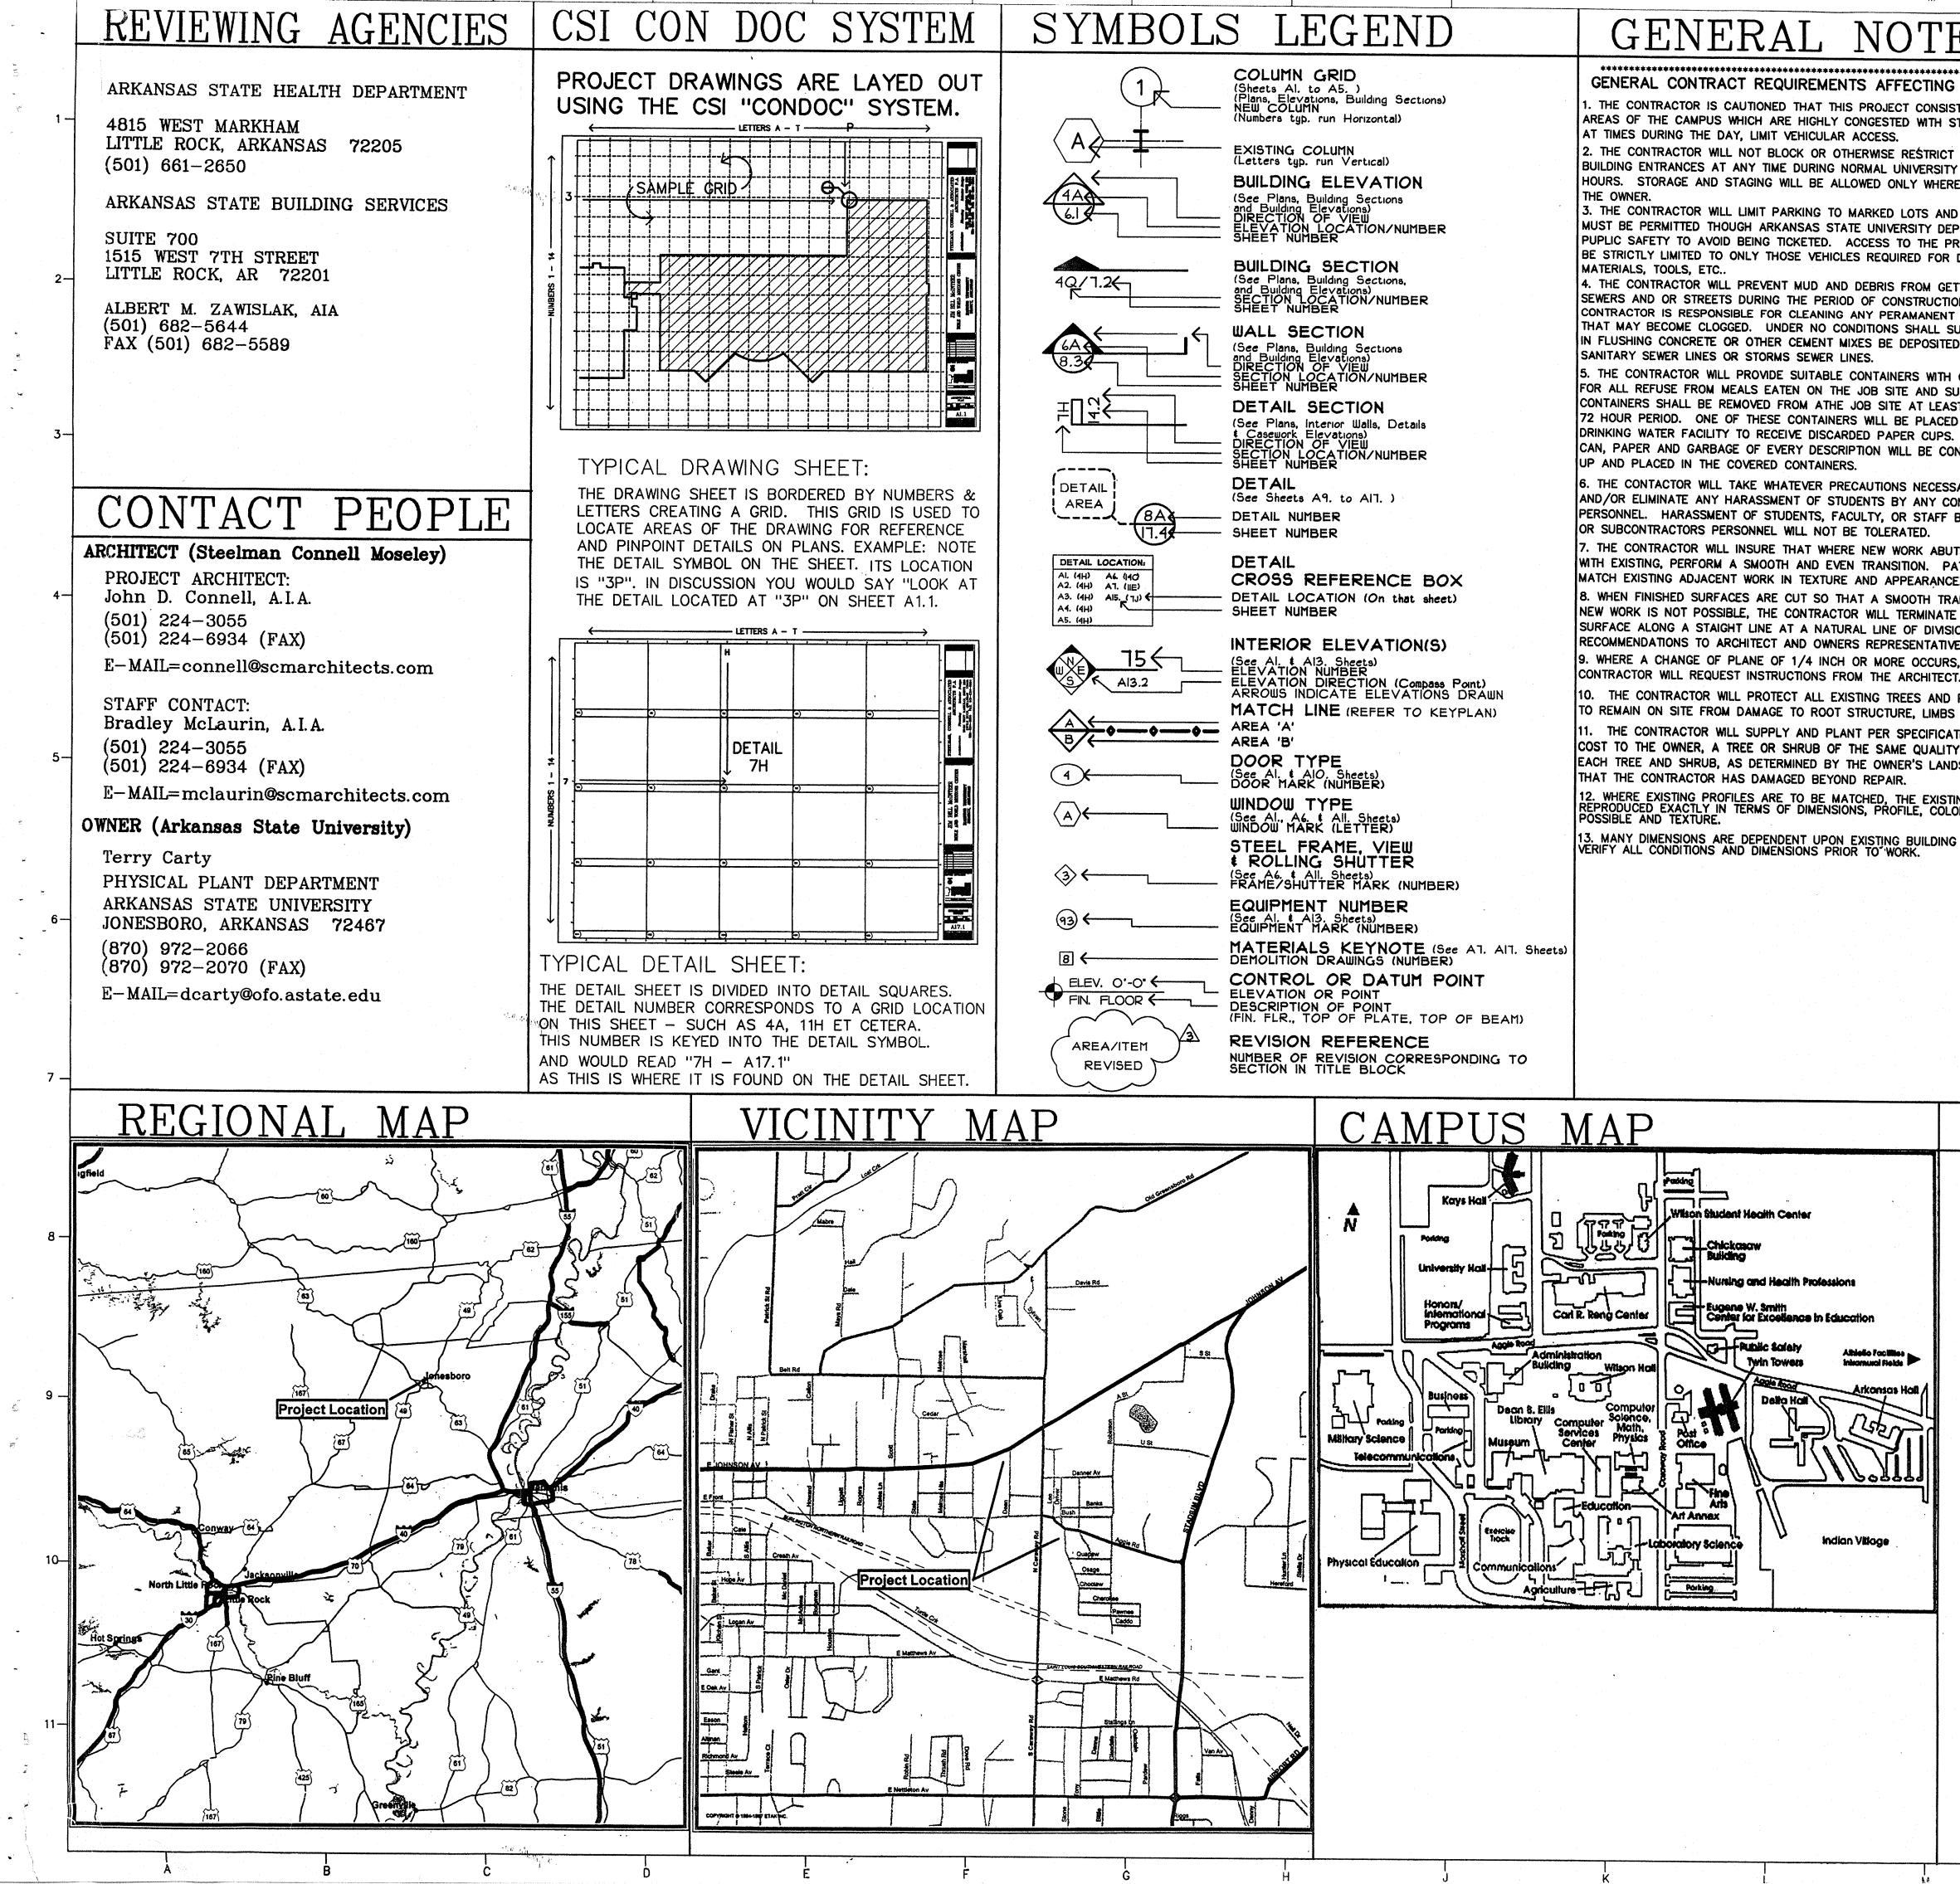

~

'ES	DRAWING INDEX		-INVITUALIZZ
NG ALL TRADES ISISTS OF WORKS IN H STUDENT TRAFFIC	GENERAL T1.1 COVER SHEET X1.1 GENERAL INFORMATION A0.1 DOOR & FINISH SCHEDULE & DETAILS		AEGISTERED OF
NCT ACCESS TO THE SITY OPERATING HERE INDICATED BY	TWIN TOWERS TTA2.1 LAUNDRY FLOOR PLANS & ELEVATIONS TTA2.2 LAUNDRY ELEVATIONS	<b>-1</b>	C-8 C-8 C-8 C-8 C-8 C-8 C-8 C-8 C-8 C-8
AND ALL VEHICLES DEPARTMENT OF PROJECT SITE WILL OR DELIVERY OF	PLUMBING TTP1.1 FIRST FLOOR PLAN-LAUNDRY ROOM-PLUMBING DEMOLITION TTP2.2 FIRST FLOOR PLAN-LAUNDRY ROOM-PLUMBING		<u></u>
GETTING INTO THE CTION. THE ENT PIPING IN PLACES L SUCH WATER USED ITED IN OR ABOUT	MECHANICAL TTM1.1 LAUNDRY PLAN-HVAC ELECTRICAL TTE.1 LAUNDRY DEMOLITION PLAN-ELECTRICAL TTE.2 LAUNDRY FLOOR PLAN-ELECTRICAL	-2	Moseley P. A. trkansas 72205 501 224-6934
ITH COVERS SUCH EAST ONCE IN EVERY CED BESIDE EACH PS. ALL BOTTLES, CONSTANTLY PICKED ESSARY TO PREVENT CONTRACTOR FF BY CONTRACTORS	KAYS HALL KHC1.1 PARTIAL SITE PLAN & DETAILS KHA1.1 LAUNDRY PLAN AND ELEVATIONS KHA2.1 NEW ELEVATOR DEMOLITION PLANS KHA2.2 NEW ELEVATOR FLOOR PLANS KHA2.3 ELEVATOR DETAILS KHA3.1 LOBBY REFLECTED CEILING PLAN		connell - e c t s 220 - Little Rock, A FAX
ABUTS OR ALIGNS PATCHED WORK TO INCE. TRANSITION WITH ATE EXISTING VISION AND MAKE VISION AND MAKE VIVE. URS, THE TECT. ND PLANT MATERIALS ABS AND BARK. ICATIONS AND AT NO ILITY & SPECIES FOR ANDSCAPE ARCHITECT	<ul> <li>KHPFE0.1 SITE PLAN-PLUMBING, FIRE PROTECTION, &amp; ELECTRICAL</li> <li>KHP1.1 PARTIAL FLOOR PLANS-PLUMBING DEMOLITION</li> <li>KHP1.2 PARTIAL FLOOR PLANS-PLUMBING DEMOLITION</li> <li>KHP2.3 PARTIAL FLOOR PLANS-PLUMBING</li> <li>FIRE PROTECTION</li> <li>KHF2.1 FIRST FLOOR PLAN - FIRE PROTECTION</li> <li>KHF2.2 SECOND FLOOR PLAN - FIRE PROTECTION</li> <li>KHF2.3 THIRD FLOOR PLAN - FIRE PROTECTION</li> <li>KHF2.4 TYPICAL (4TH, 6TH, 8TH, &amp; 10TH) FLOOR PLAN-FIRE PROTECTION</li> <li>KHF2.5 TYPICAL (5TH, 7TH, &amp; 9TH) FLOOR PLAN-FIRE PROTECTION</li> <li>KHF2.6 ELEVENTH FLOOR PLAN - FIRE PROTECTION</li> <li>KHF2.7 PARTIAL FLOOR PLANS &amp; DETAILS-FIRE PROTECTION</li> </ul>	-4	Steelman C C Steelman C C A r c h i t 10411 West Markham, Suite 501 224-3055
SISTING SHALL BE COLOR, MATERIAL IF	MECHANICAL KHM1.1 DEMOLITION PLANS - HVAC KHM1.2 DEMOLITION PLANS-HVAC KHM2.1 PARTIAL PLANS-HVAC KHM2.2 PARTIAL PLANS-HVAC KHM2.3 PARTIAL PLANS-HVAC KHM3.1 SCHEDULES & DETAILS-HVAC ELECTRICAL KHE.1 FIRST FLOOR PLAN-ELECTRICAL KHE.2 SECOND FLOOR PLAN-ELECTRICAL KHE.3 THIRD FLOOR PLAN-ELECTRICAL KHE.4 TYPICAL (4TH, 6TH, 8TH & 10TH) FLOOR PLAN-ELECTRICAL KHE.5 TYPICAL (5TH, 7TH, 9TH) FLOOR PLAN-ELECTRICAL KHE.6 ELEVENTH FLOOR PLAN-ELECTRICAL KHE.7 PARTIAL FLOOR PLANS-ELECTRICAL KHE.8 FIRE ALARM RISER DIAGRAM KHE.9 POWER RISER DIAGRAM KHE.10 LAUNDRY FLOOR PLANS-ELECTRICAL		Hall Renovations State University boro, Arkansas
		-8	Residence Arkansas <sup>Jones</sup>
			REVISIONS:
		—9	DRAWN BY:
		—10	KEY PLAN: NOT TO SCALE
		-11	GENERAL INFORMATION PROJECT: DATE SCALE 98102 DATE SCALE 05/18/09 1/8" - 1'-0" SHEET NUMBER:
			X1.1 Biselman Connell Moseley Architects P.A. @1999